

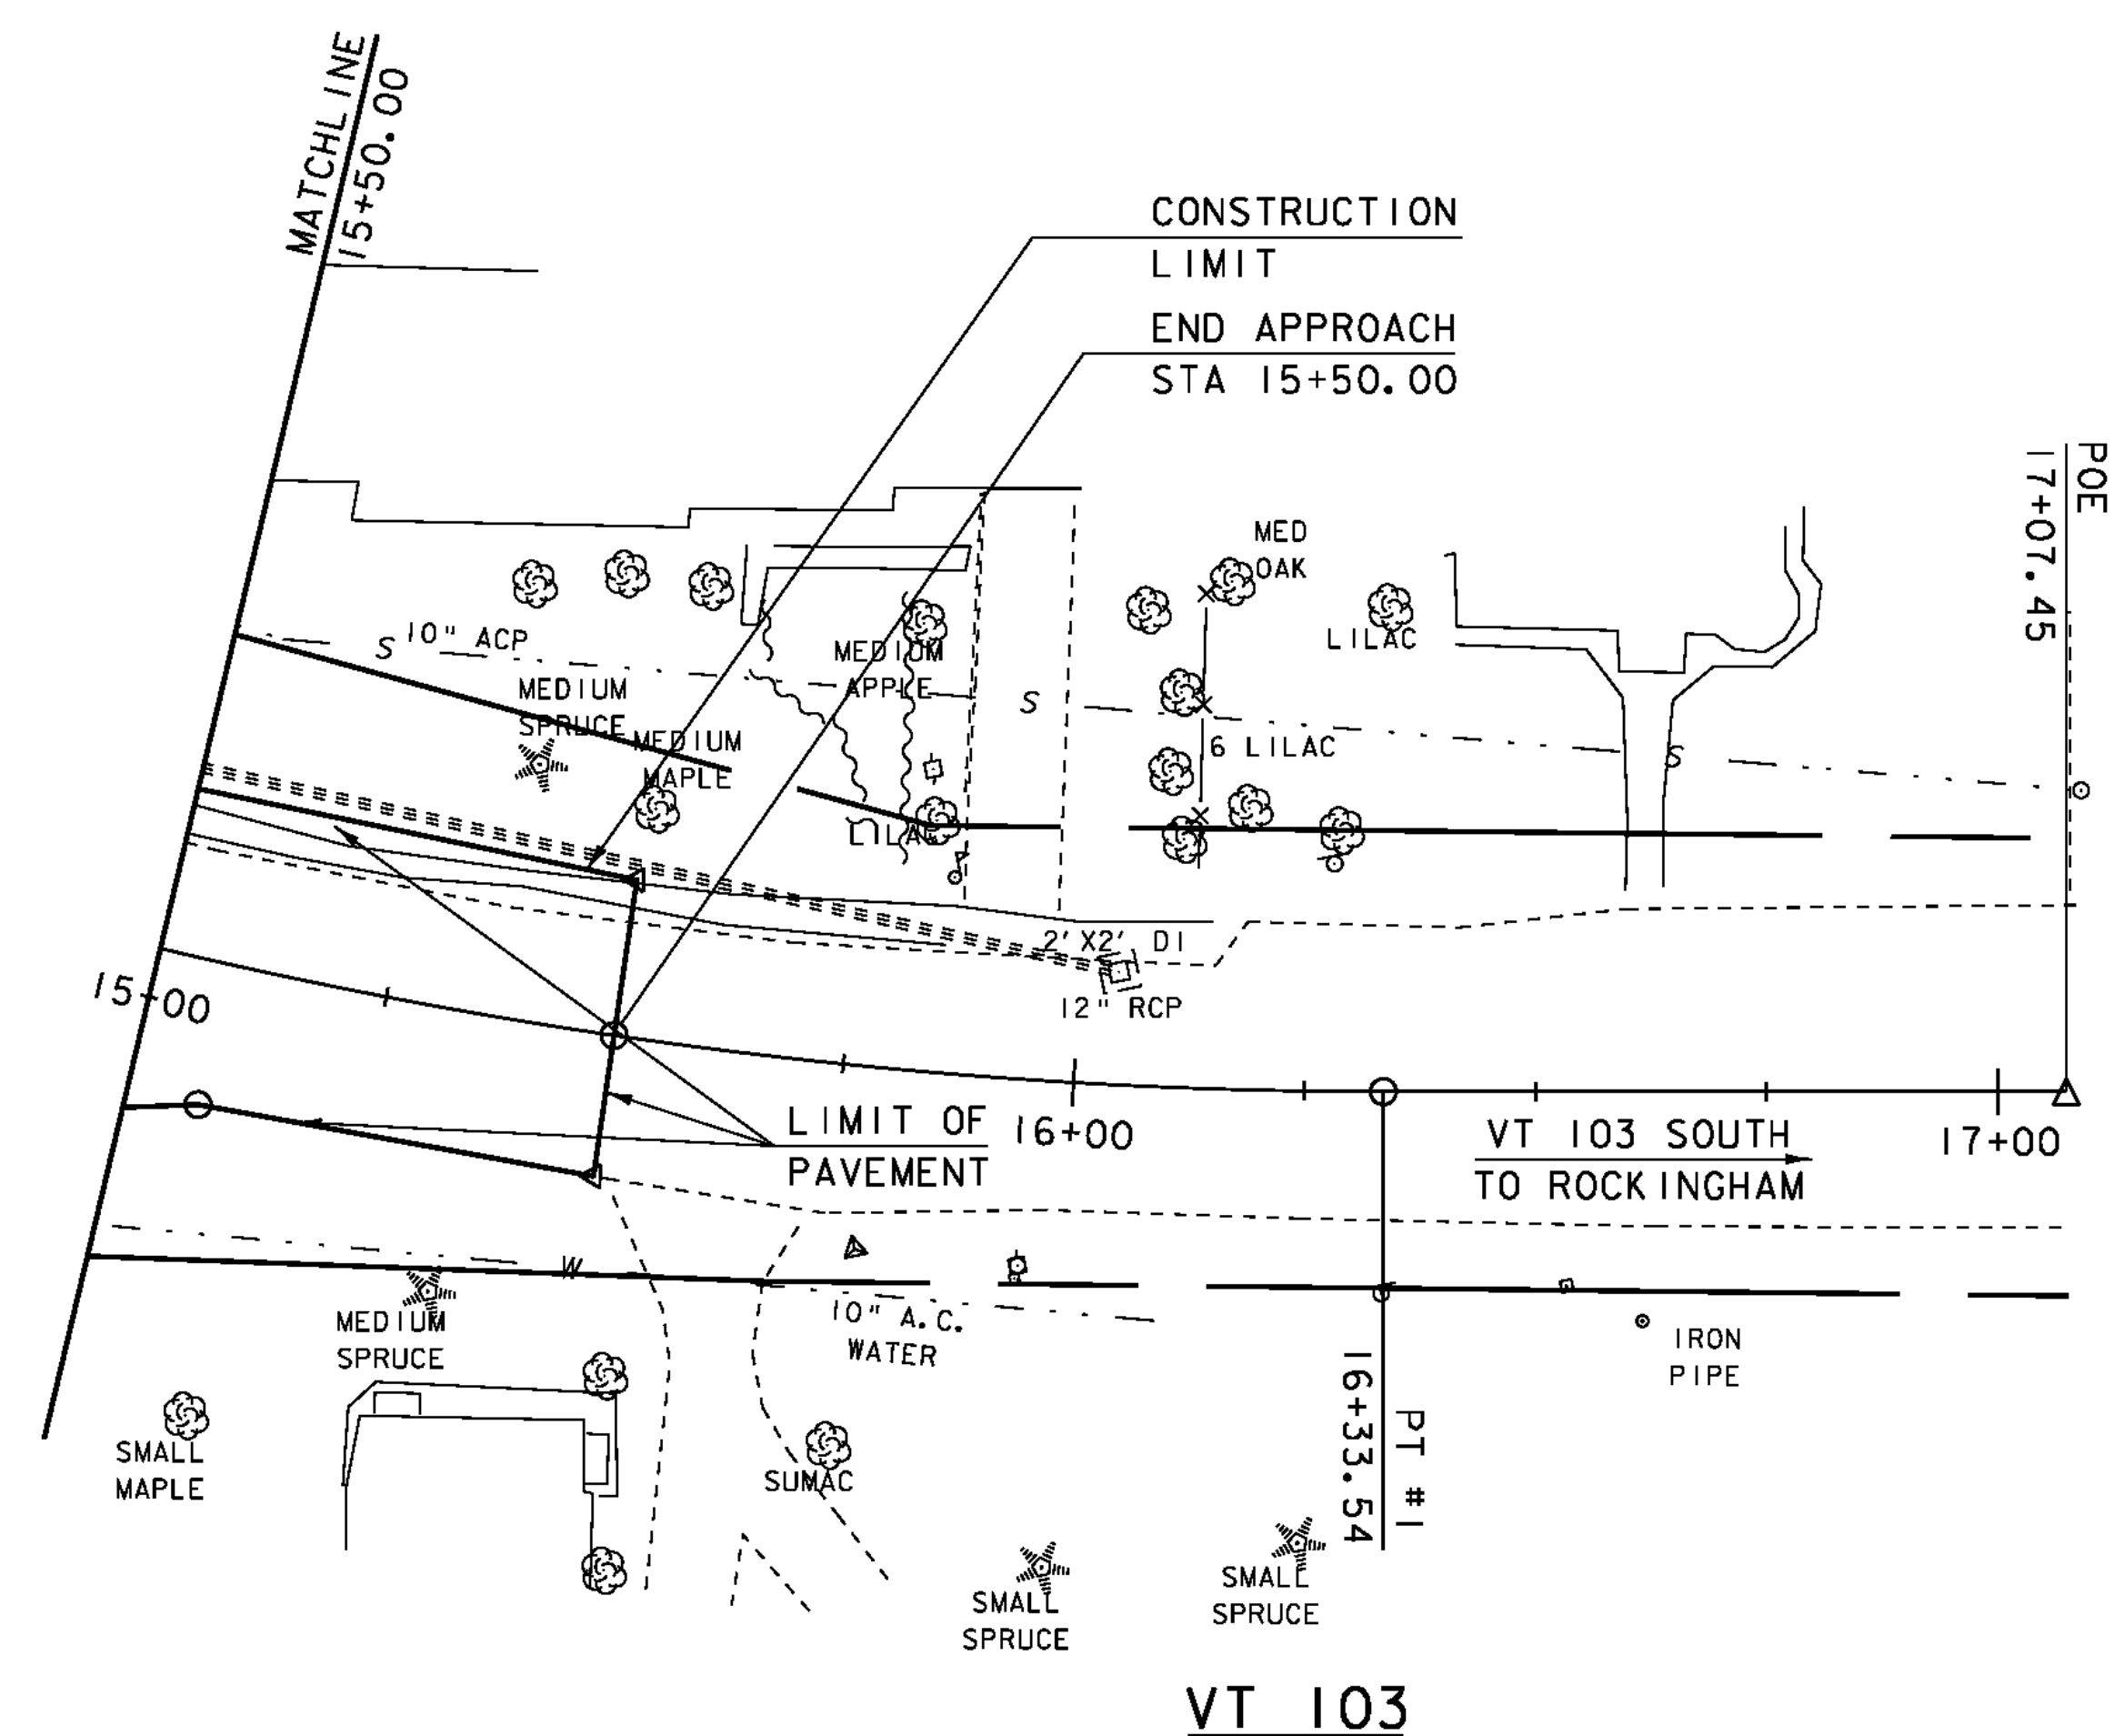
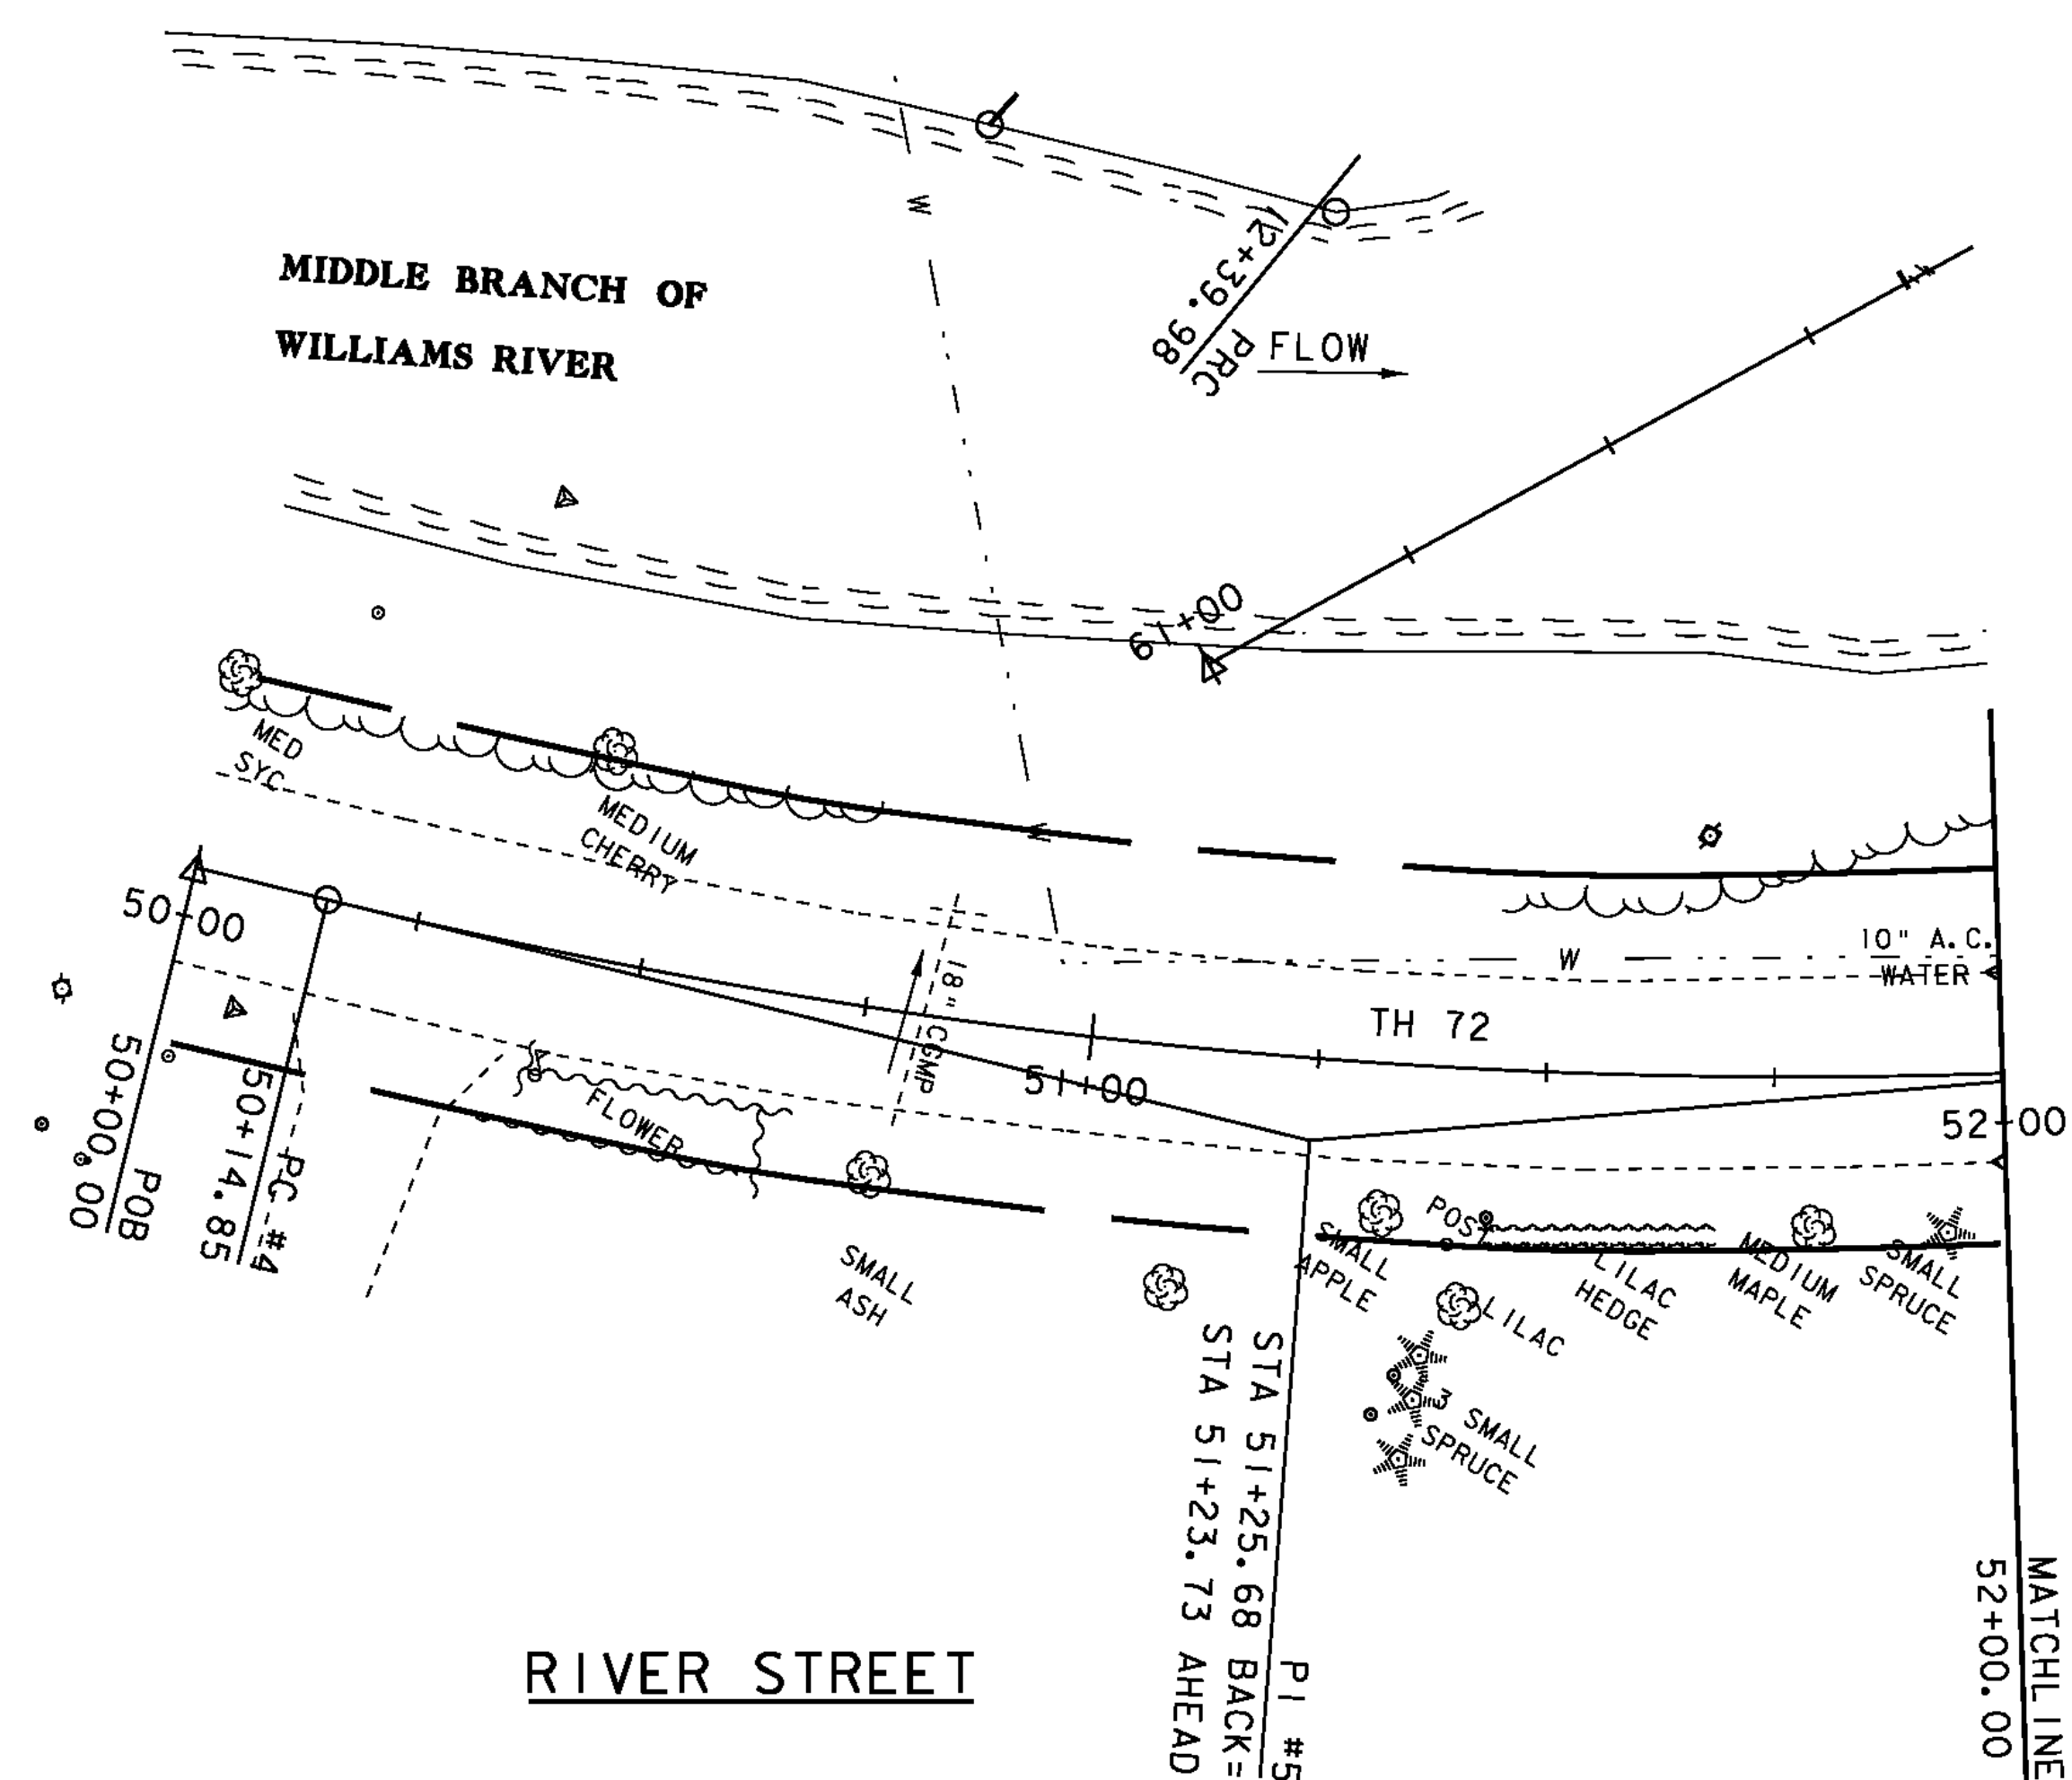


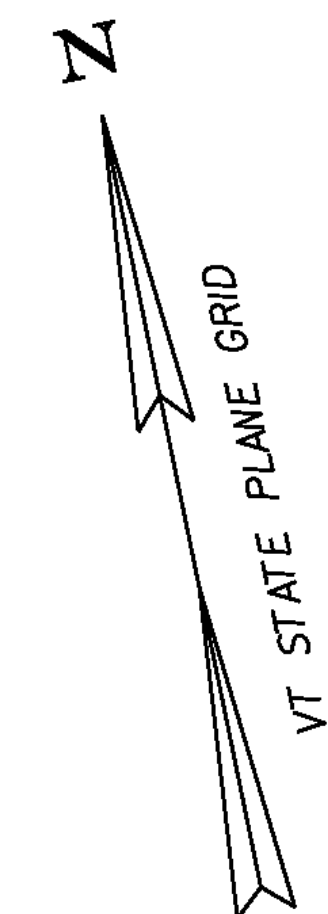

LAYOUT #2

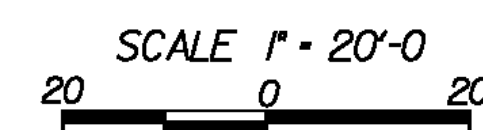

PROJECT NAME:	CHESTER
PROJECT NUMBER:	BRF 025-I(37)
FILE NAME:	95b168\s95b168bdr.dgn
PROJECT LEADER:	C.P.WILLIAMS
DESIGNED BY:	R.S.YOUNG
BRIDGE 9 LAYOUT SHEET #2	
PLOT DATE:	20-SEP-2010
DRAWN BY:	D.D.BEARD
CHECKED BY:	R.S.YOUNG
SHEET 68	OF 124