



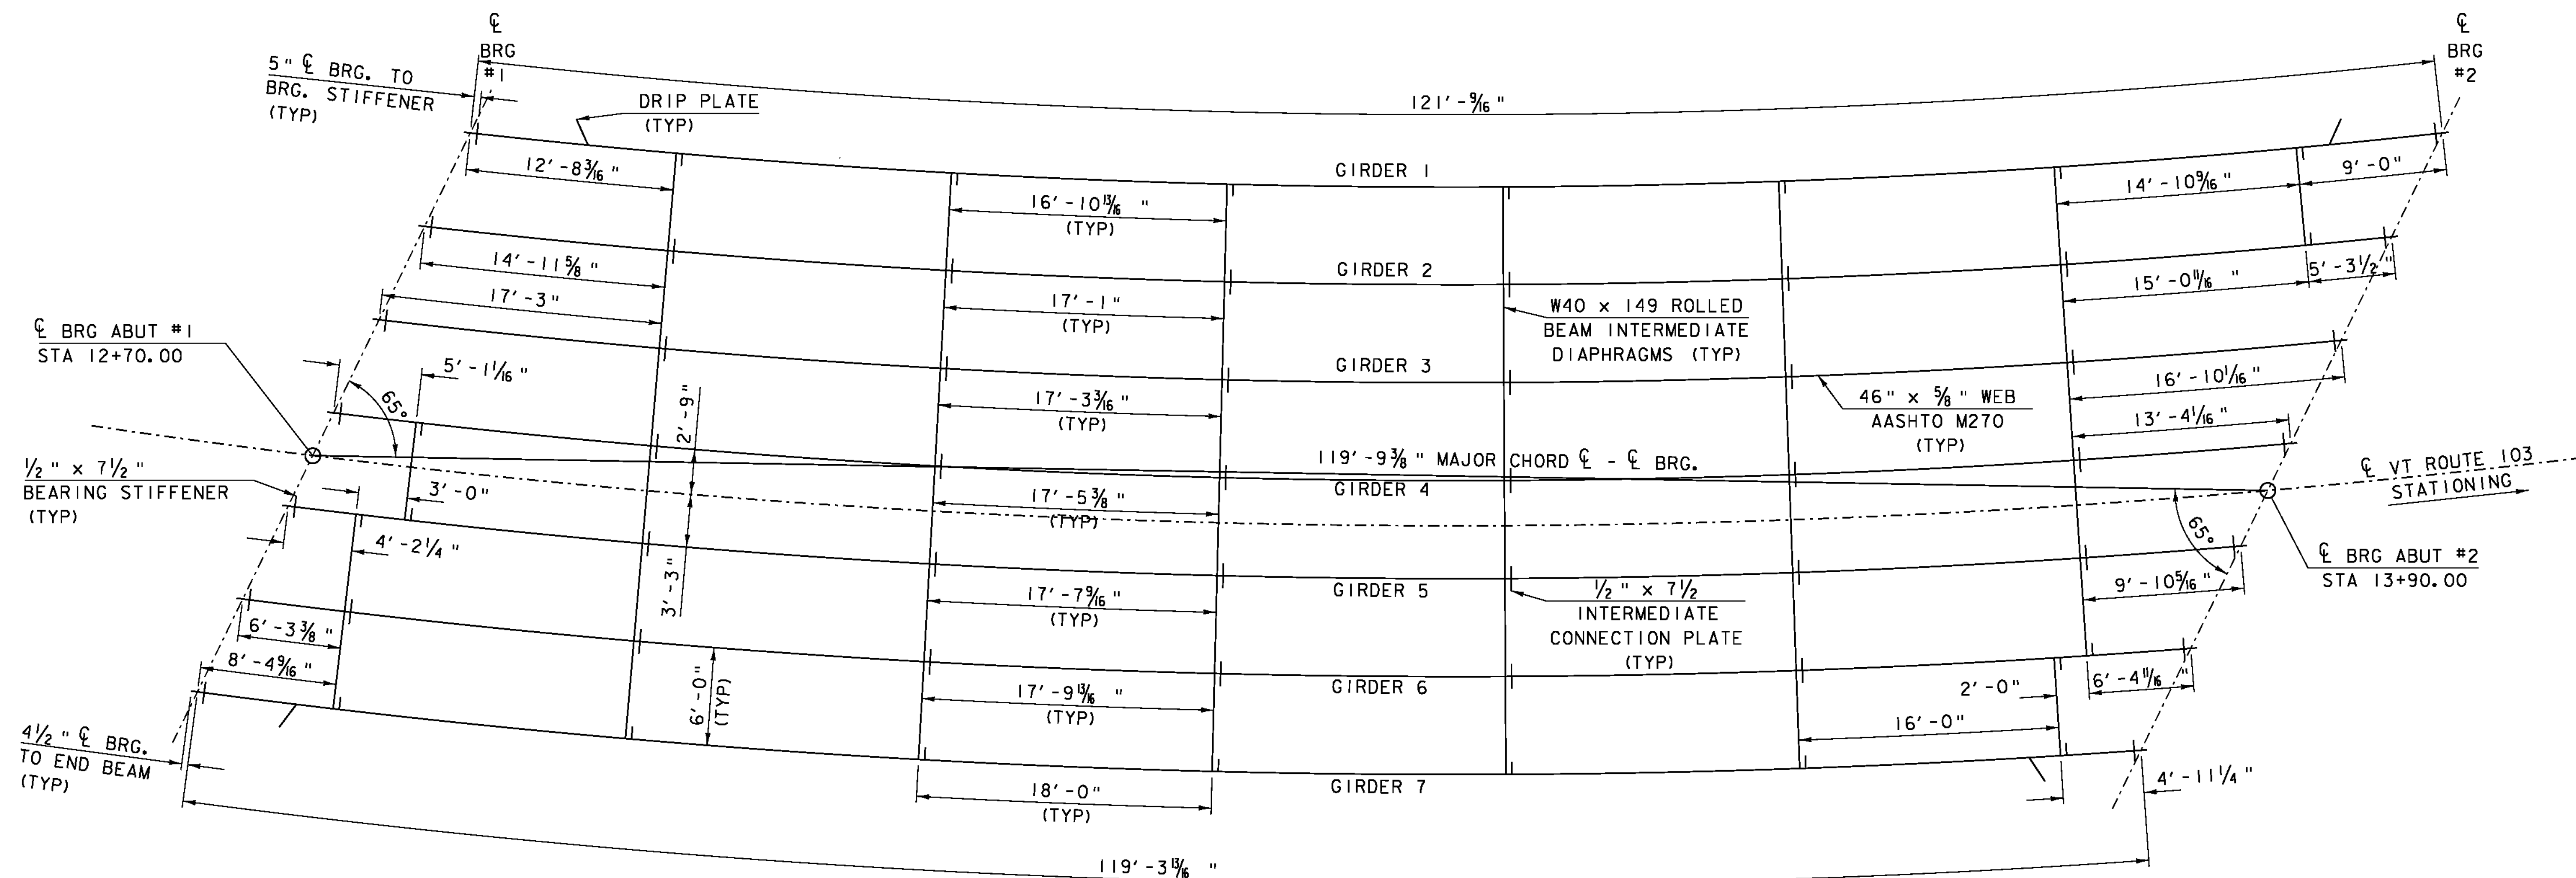

FRAMING PLAN

SCALE $\frac{3}{16}$ " = 1'-0"

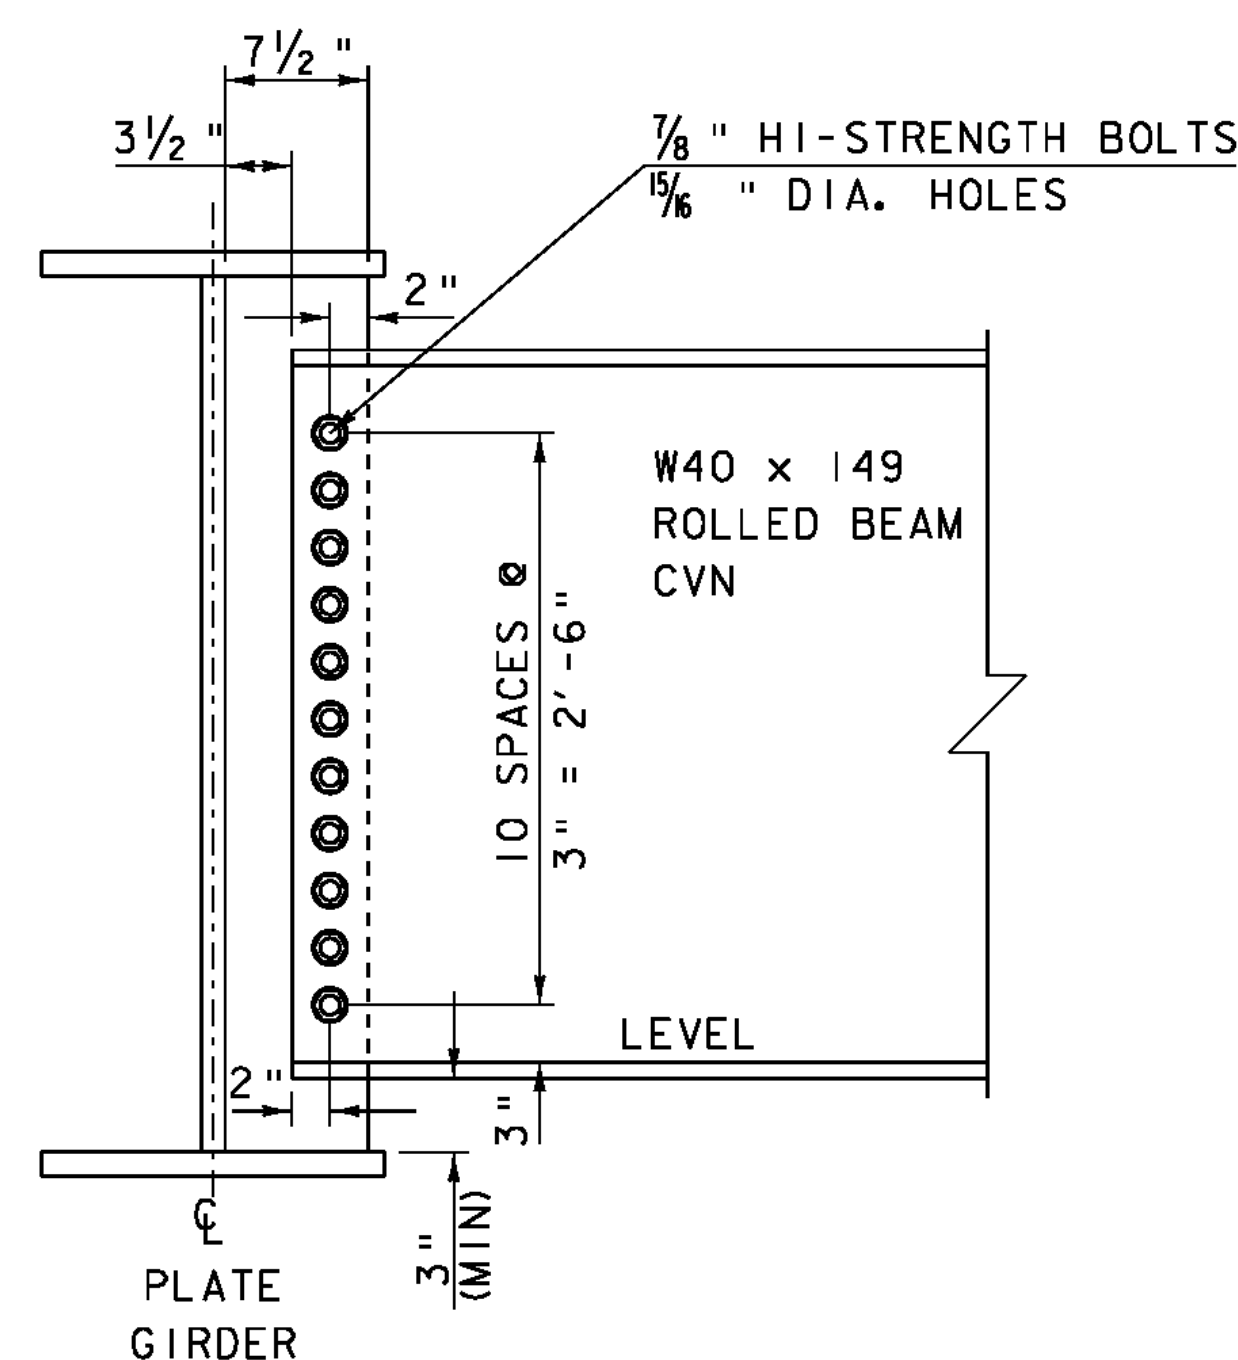

NOTE: CONTRACTOR MAY SUBMIT AN EQUIVALENT PLATE DIAPHRAGMS INSTEAD OF THE ROLLED BEAM

INTERMEDIATE DIAPHRAGM DETAIL

N. T. S.

NOTE: GIRDER 1 HAS A MAXIMUM SWEEP DISTANCE OF 3'-3 $\frac{3}{4}$ "
 GIRDER 2 HAS A MAXIMUM SWEEP DISTANCE OF 3'-3 $\frac{1}{8}$ "
 GIRDER 3 HAS A MAXIMUM SWEEP DISTANCE OF 3'-2 $\frac{1}{2}$ "
 GIRDER 4 HAS A MAXIMUM SWEEP DISTANCE OF 3'-1 $\frac{15}{16}$ "
 GIRDER 5 HAS A MAXIMUM SWEEP DISTANCE OF 3'-1 $\frac{3}{8}$ "
 GIRDER 6 HAS A MAXIMUM SWEEP DISTANCE OF 3'-0 $\frac{15}{16}$ "
 GIRDER 7 HAS A MAXIMUM SWEEP DISTANCE OF 3'-0 $\frac{1}{4}$ "
 FIELD SPLICING OF NEW STEEL CURVED GIRDERS WILL NOT BE ALLOWED

SCALE $\frac{3}{16}$ " = 1'-0"
 0 2 4 6 8

PROJECT NAME: CHESTER
 PROJECT NUMBER: BRF 025-1(37)

FILE NAME: Structures\s95bl68sup.dgn PLOT DATE: 20-SEP-2010
 PROJECT LEADER: C.P.WILLIAMS DRAWN BY: D.D.BEARD
 DESIGNED BY: E.R.CHARBONNEAU CHECKED BY: R.S.YOUNG
 BRIDGE 9 FRAMING PLAN SHEET 81 OF 124