


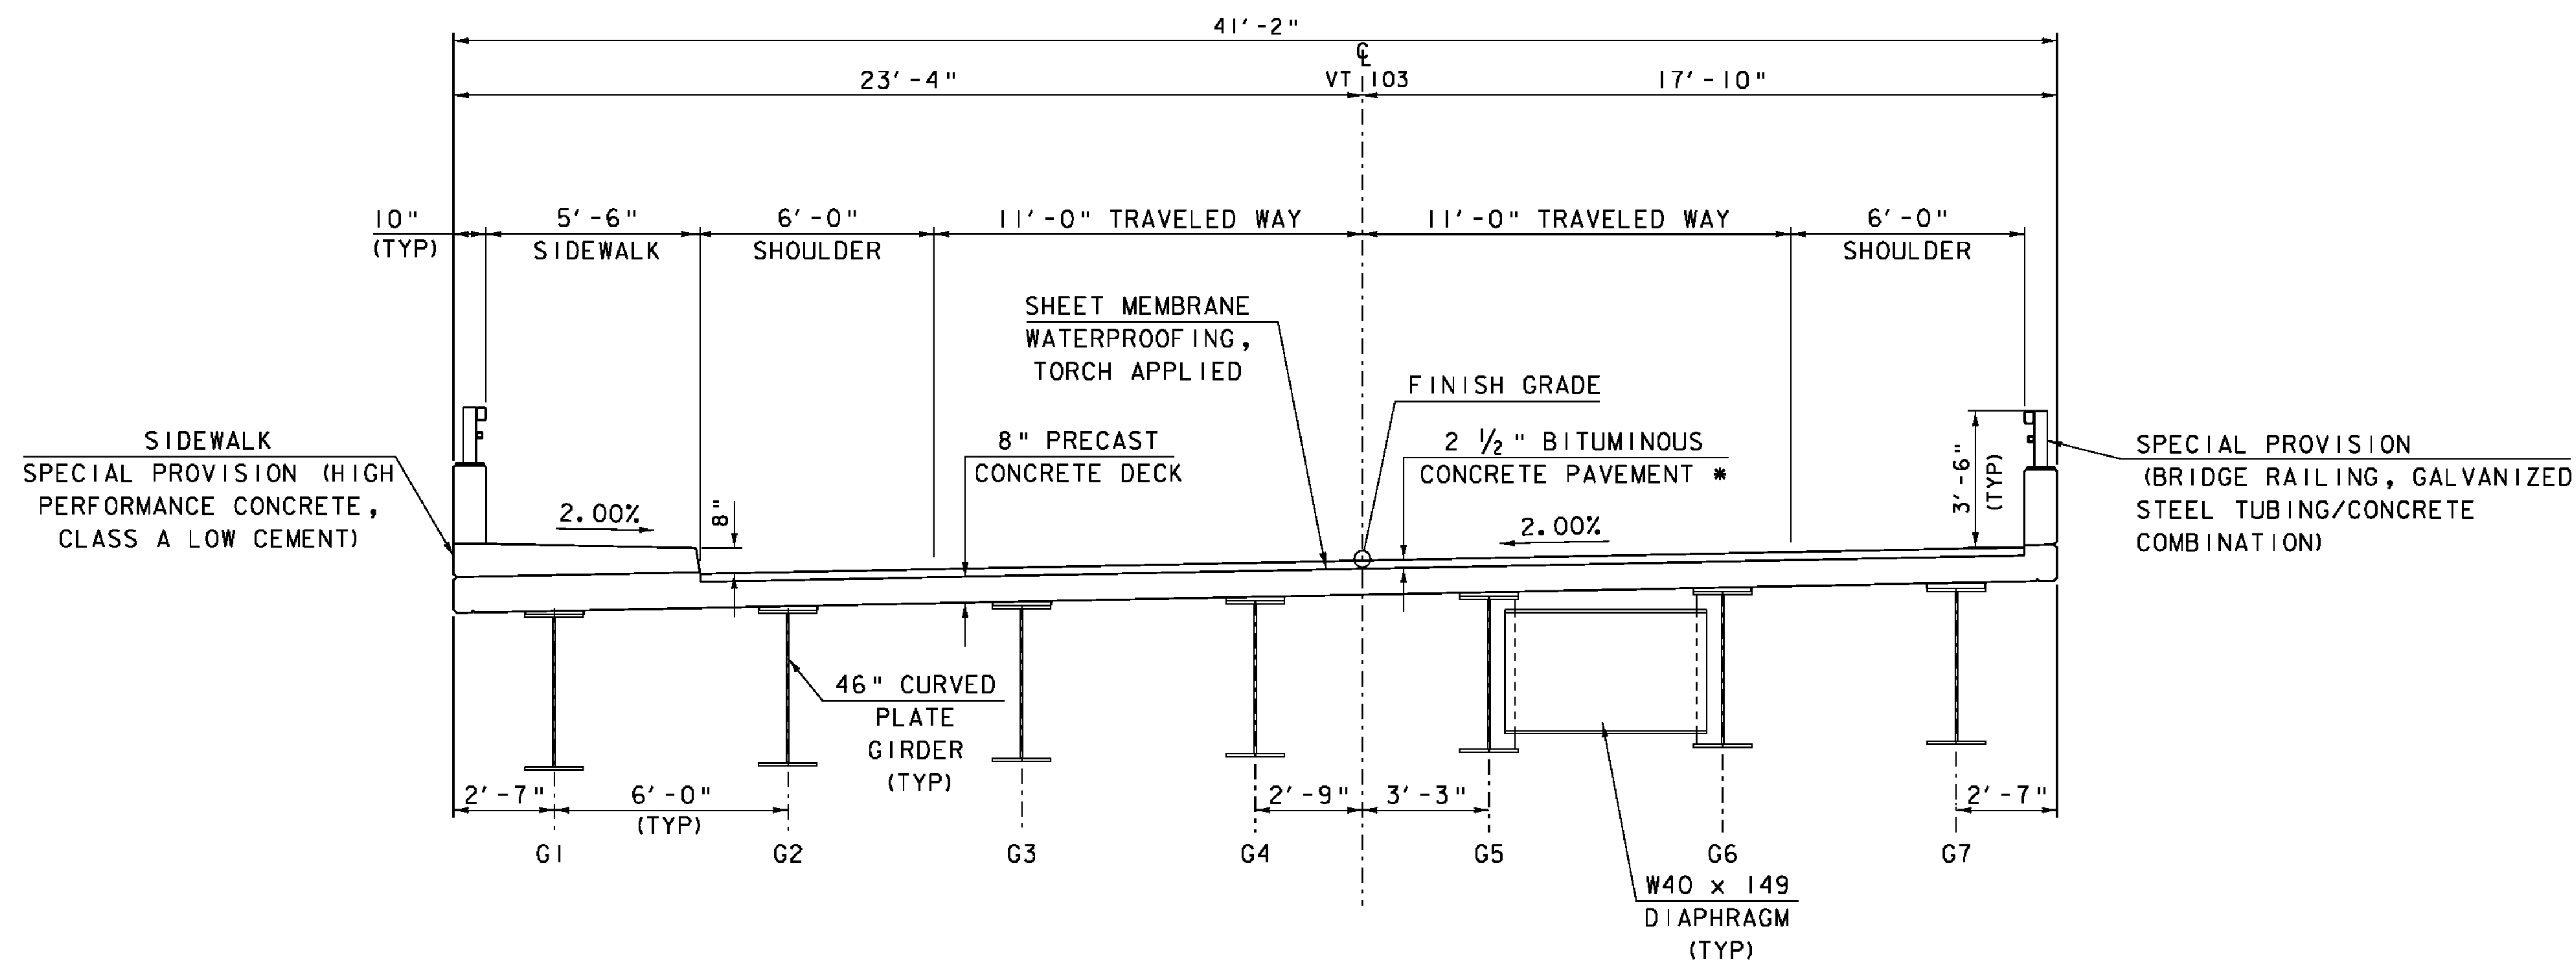


TYPICAL BRIDGE SECTION

SCALE 1" = 3'-0"


* 1 1/4" TYPE IV OVER
1 1/4" TYPE IV

NOTE: ALL TRANSVERSE
DIMENSIONS ARE RADIAL

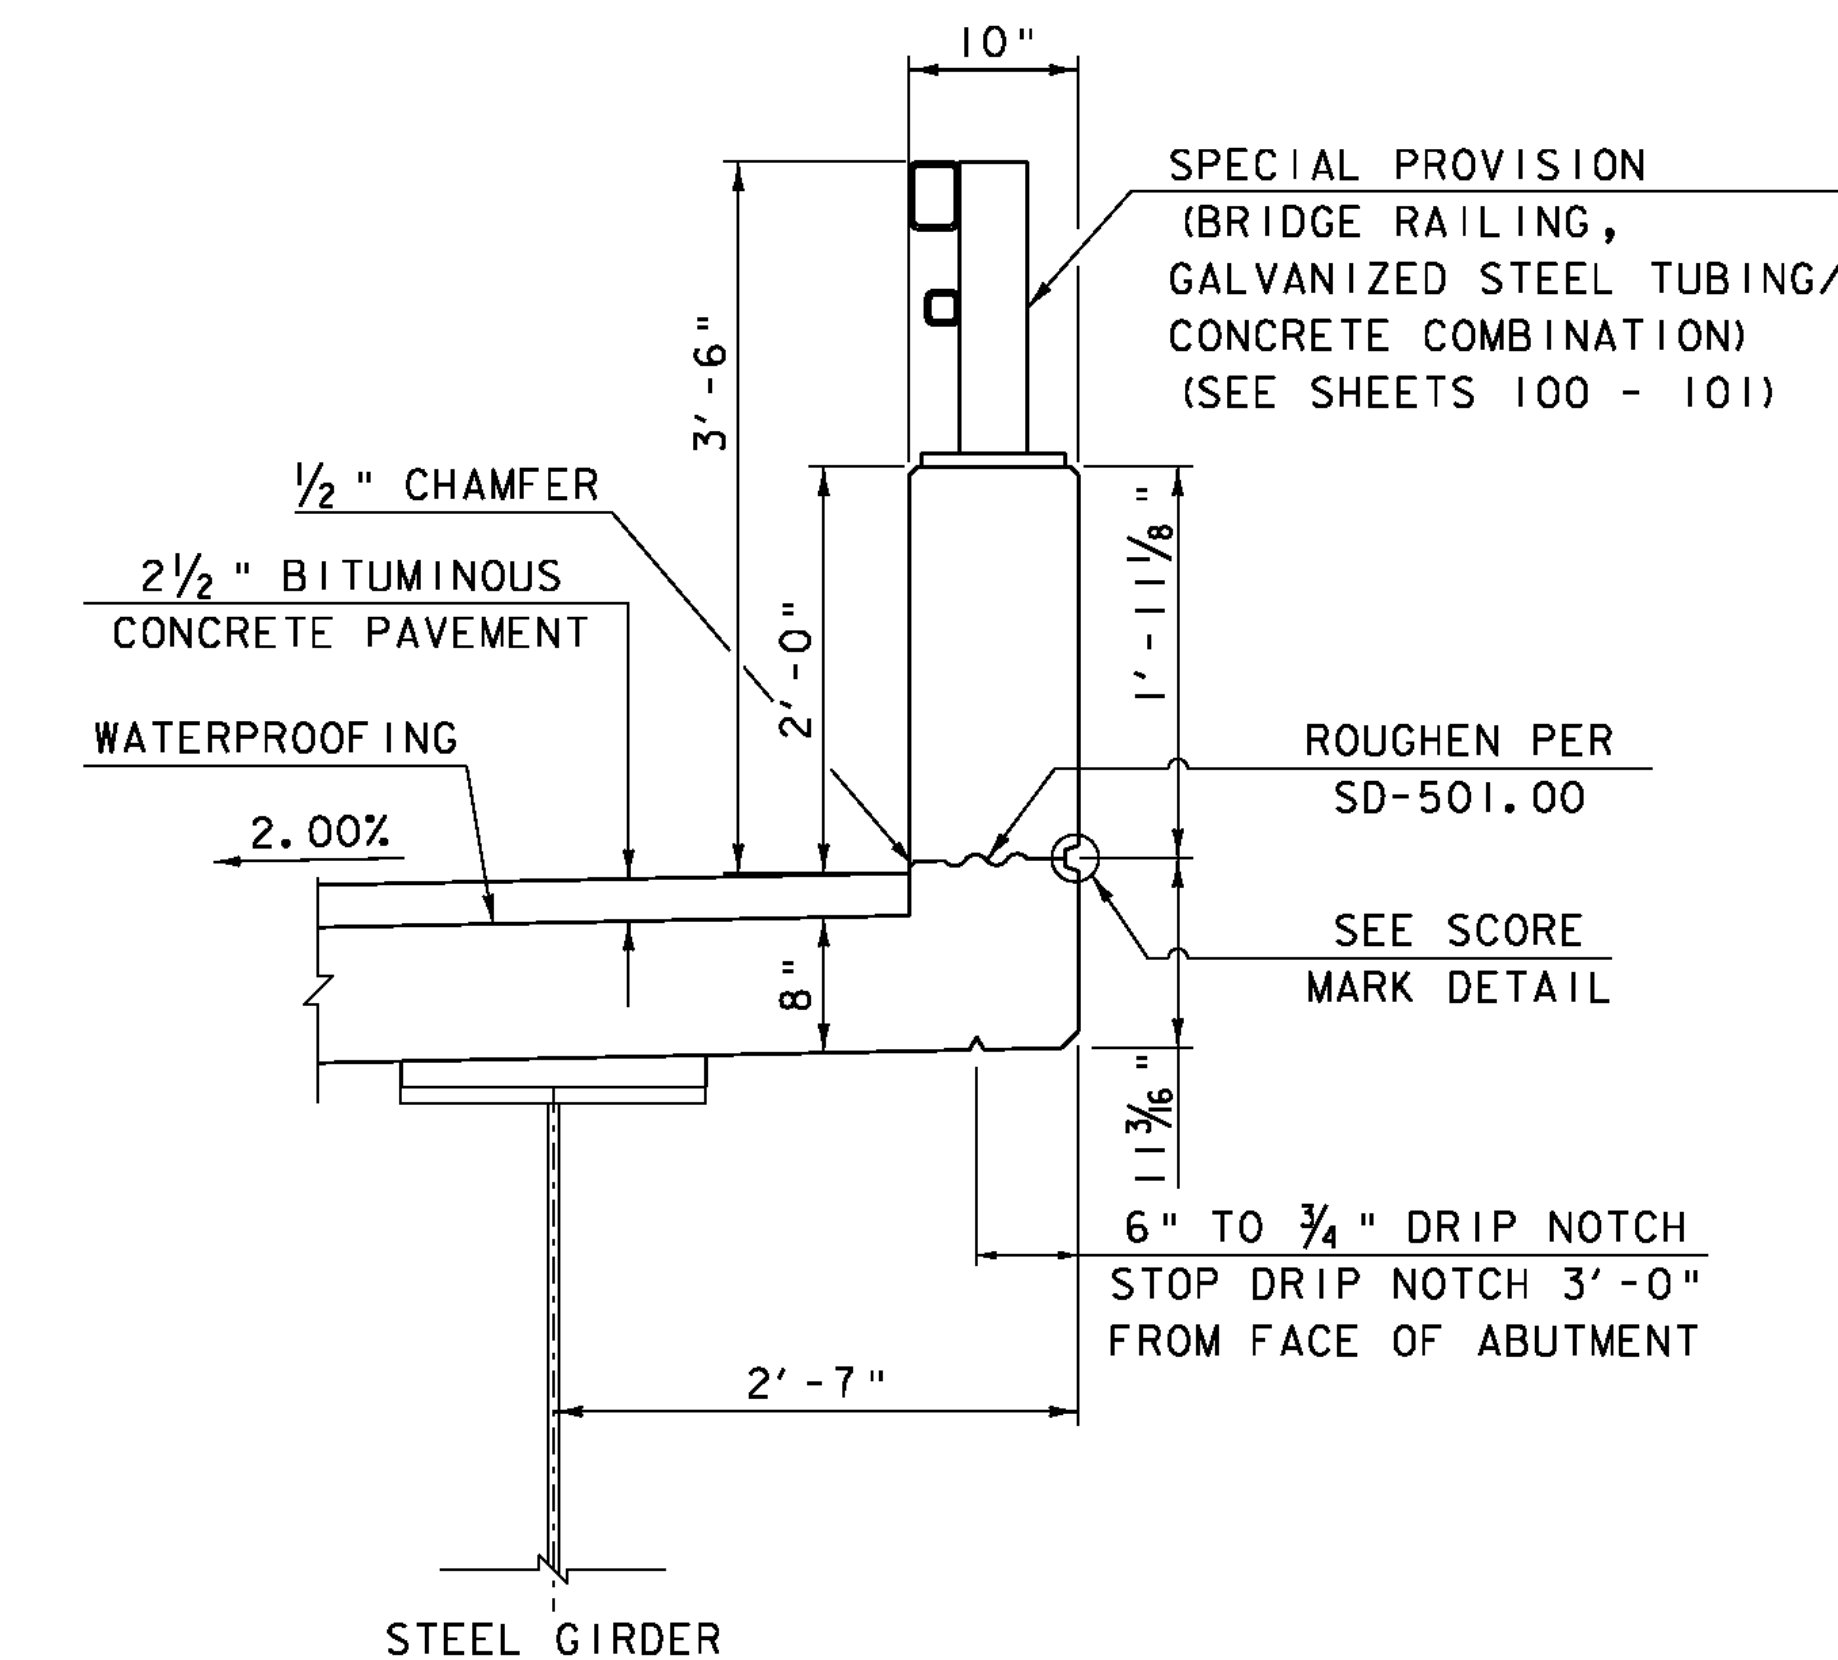

TYPICAL RAIL W/O SIDEWALK


N. T. S.

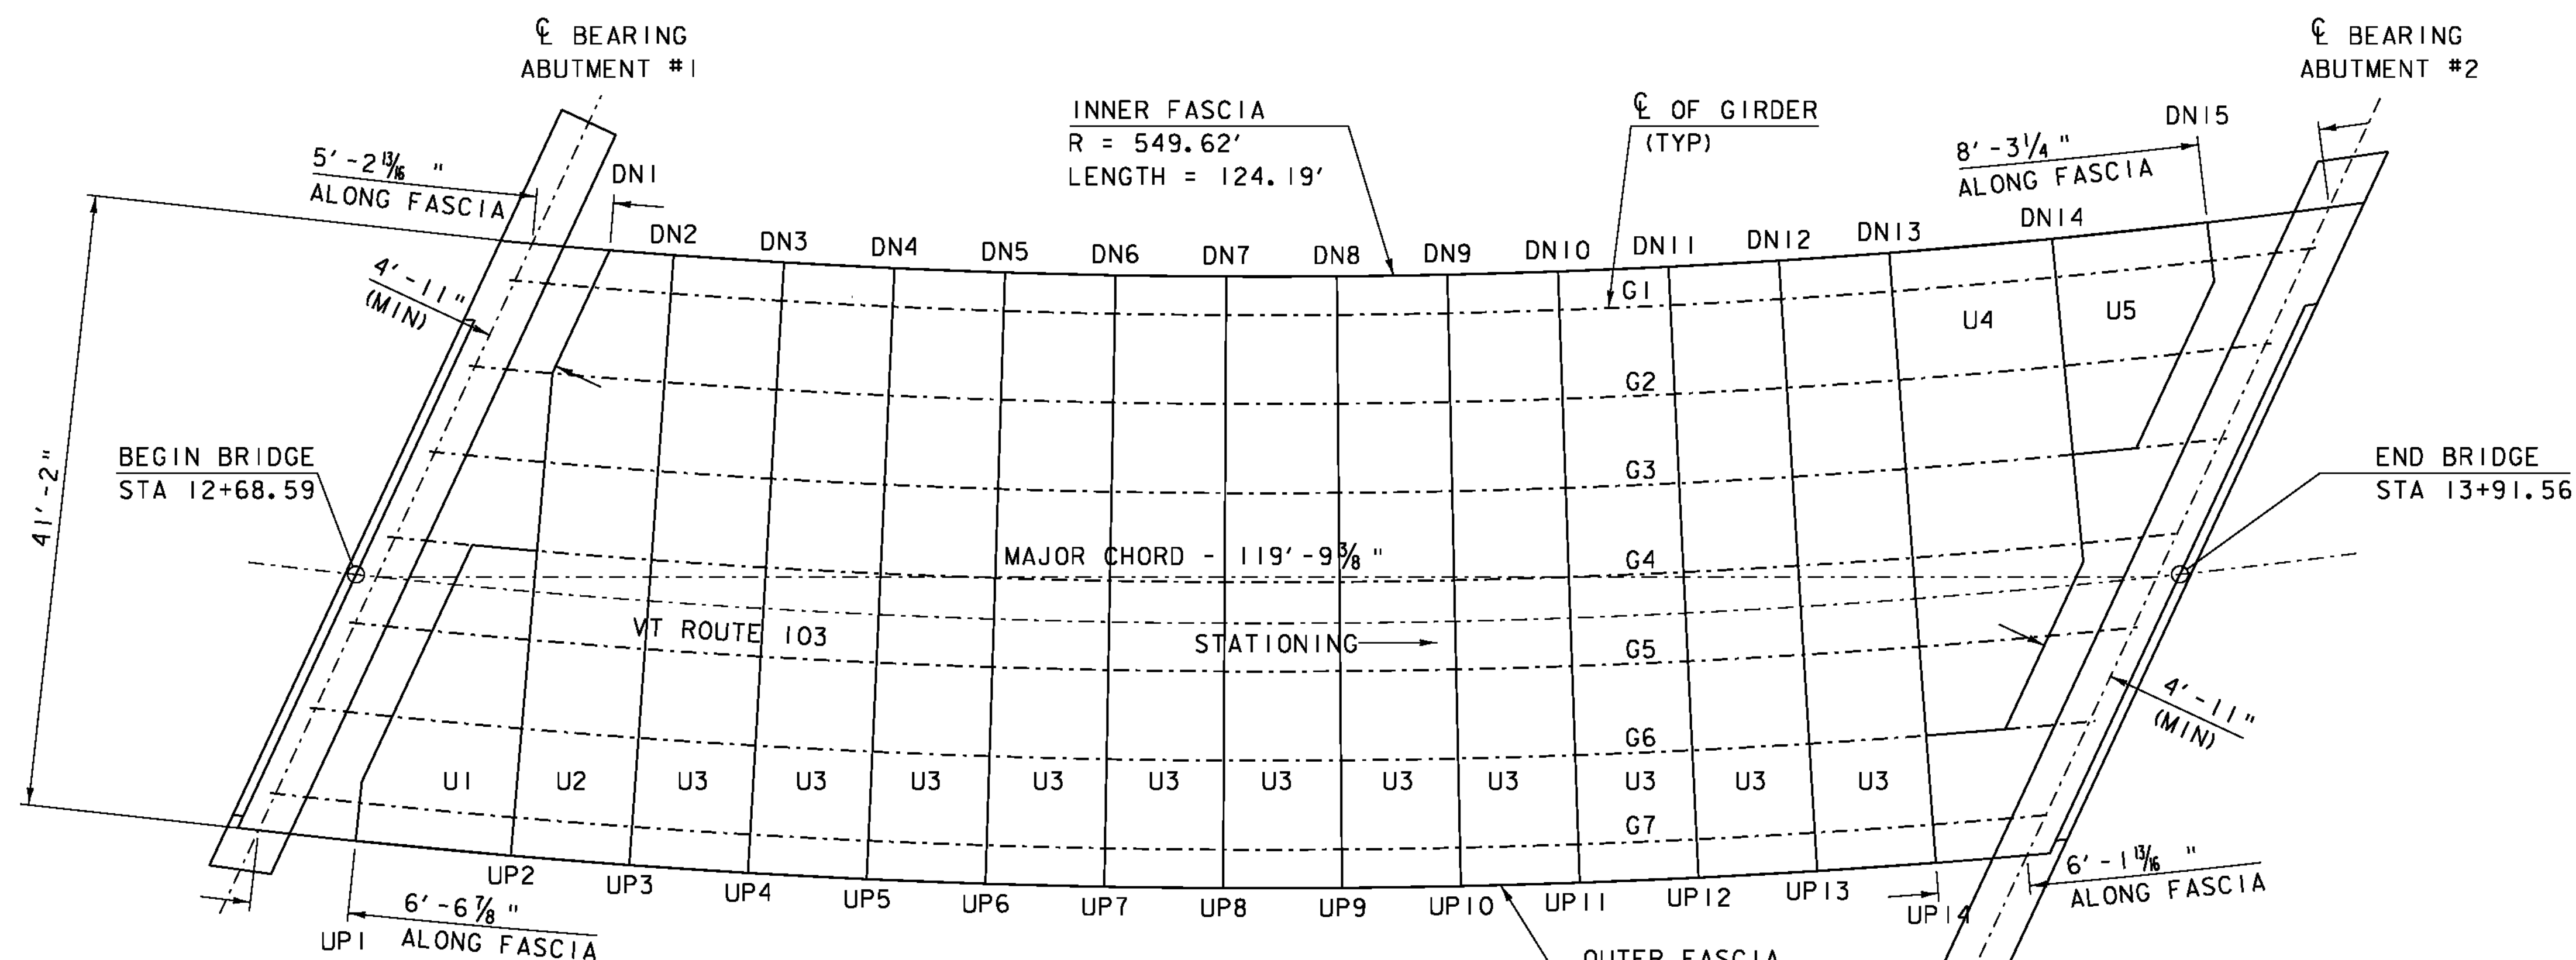

DECK LAYOUT

SCALE 1/8" = 1'-0"

10 2 4 6 8

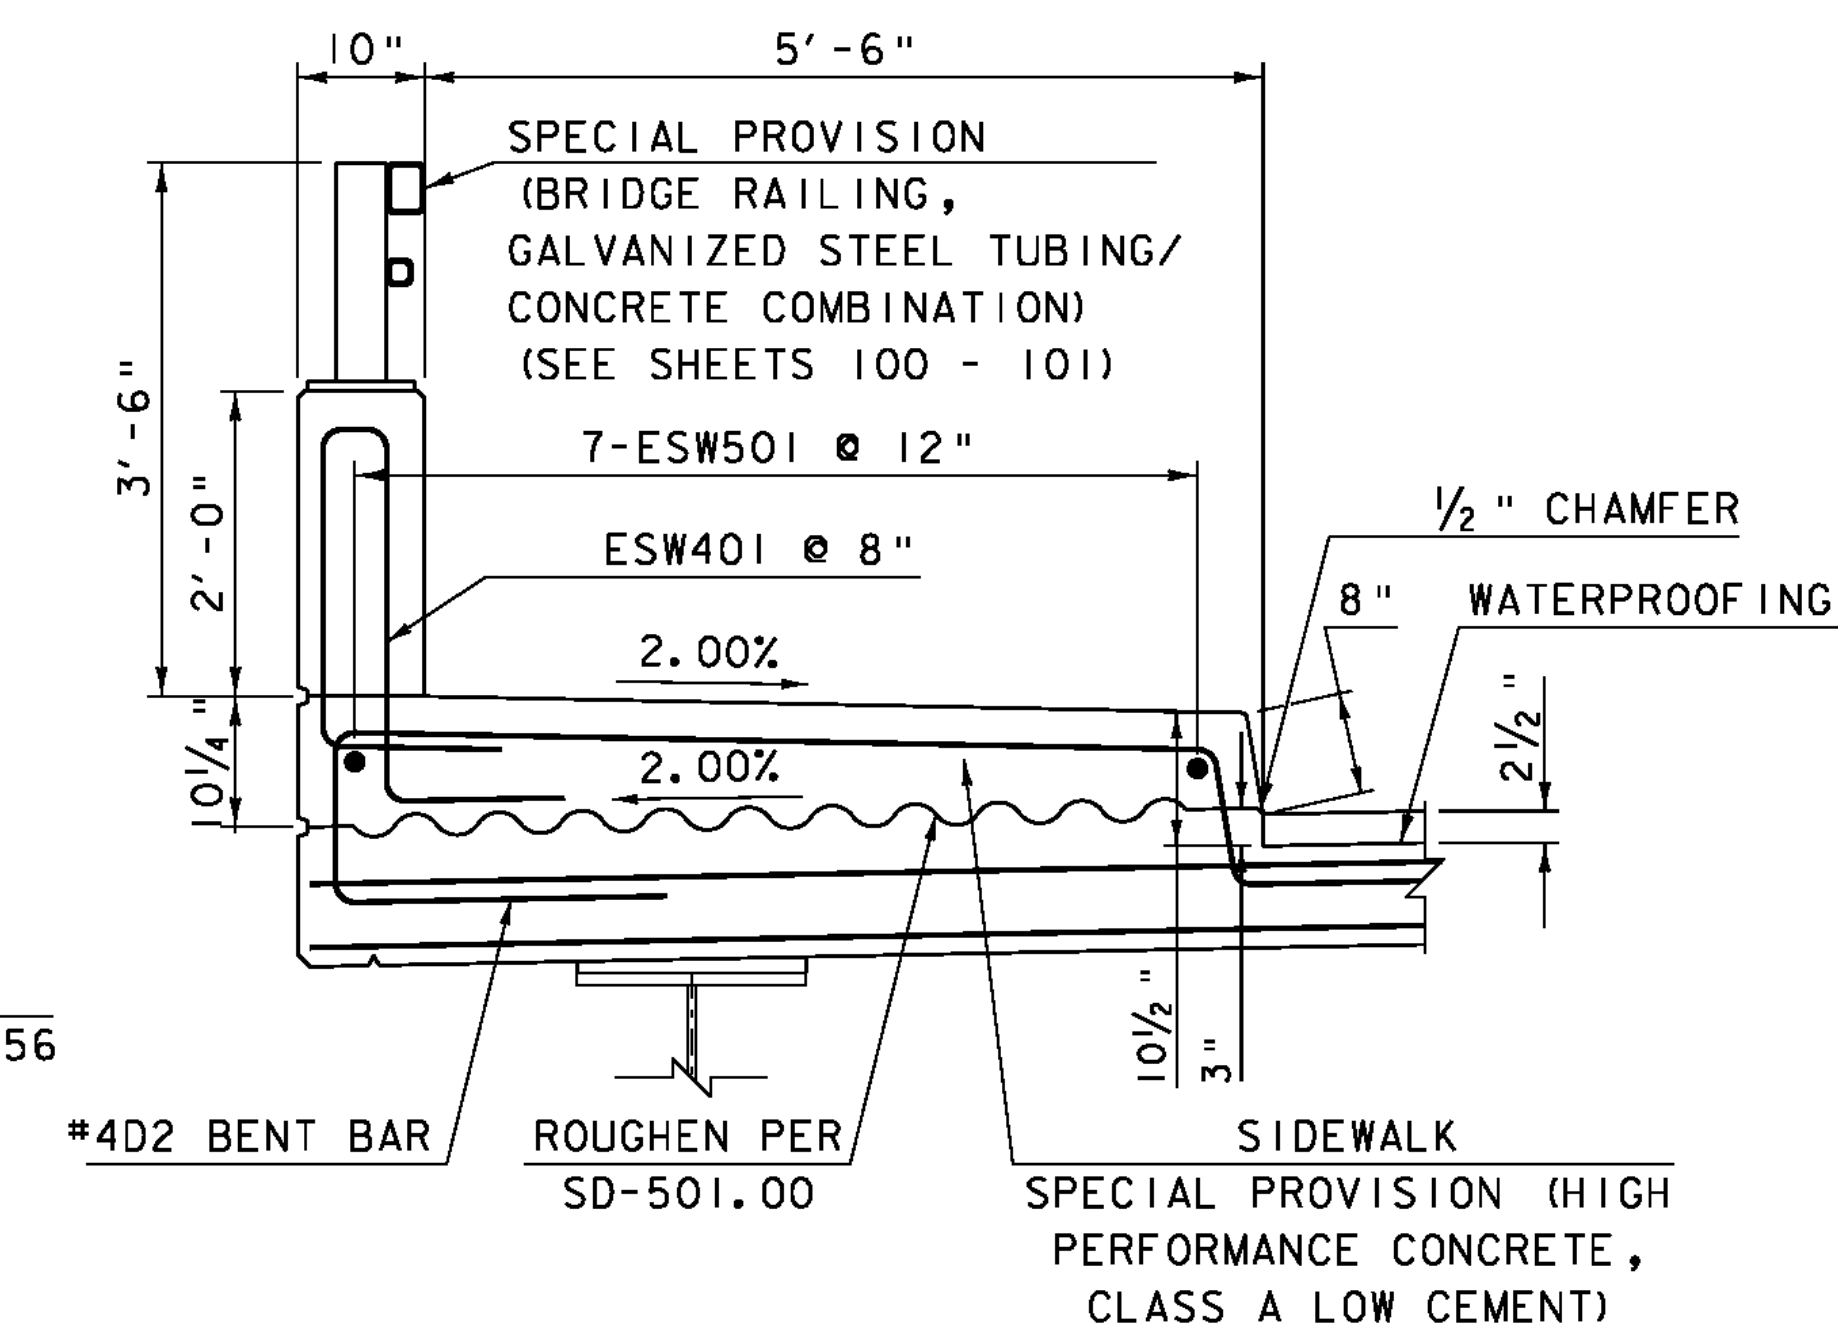

TYPICAL RAIL WITH SIDEWALK

N. T. S.

PROJECT NAME: CHESTER
PROJECT NUMBER: BRF 025-1(37)

FILE NAME: Structures\s95bl68sup.dgn
PROJECT LEADER: C.P.WILLIAMS
DESIGNED BY: E.R.CHARBONNEAU
BRIDGE 9 DECK LAYOUT DETAILS
PLOT DATE: 20-SEP-2010
DRAWN BY: D.D.BEARD
CHECKED BY: R.S.YOUNG
SHEET 86 OF 124