



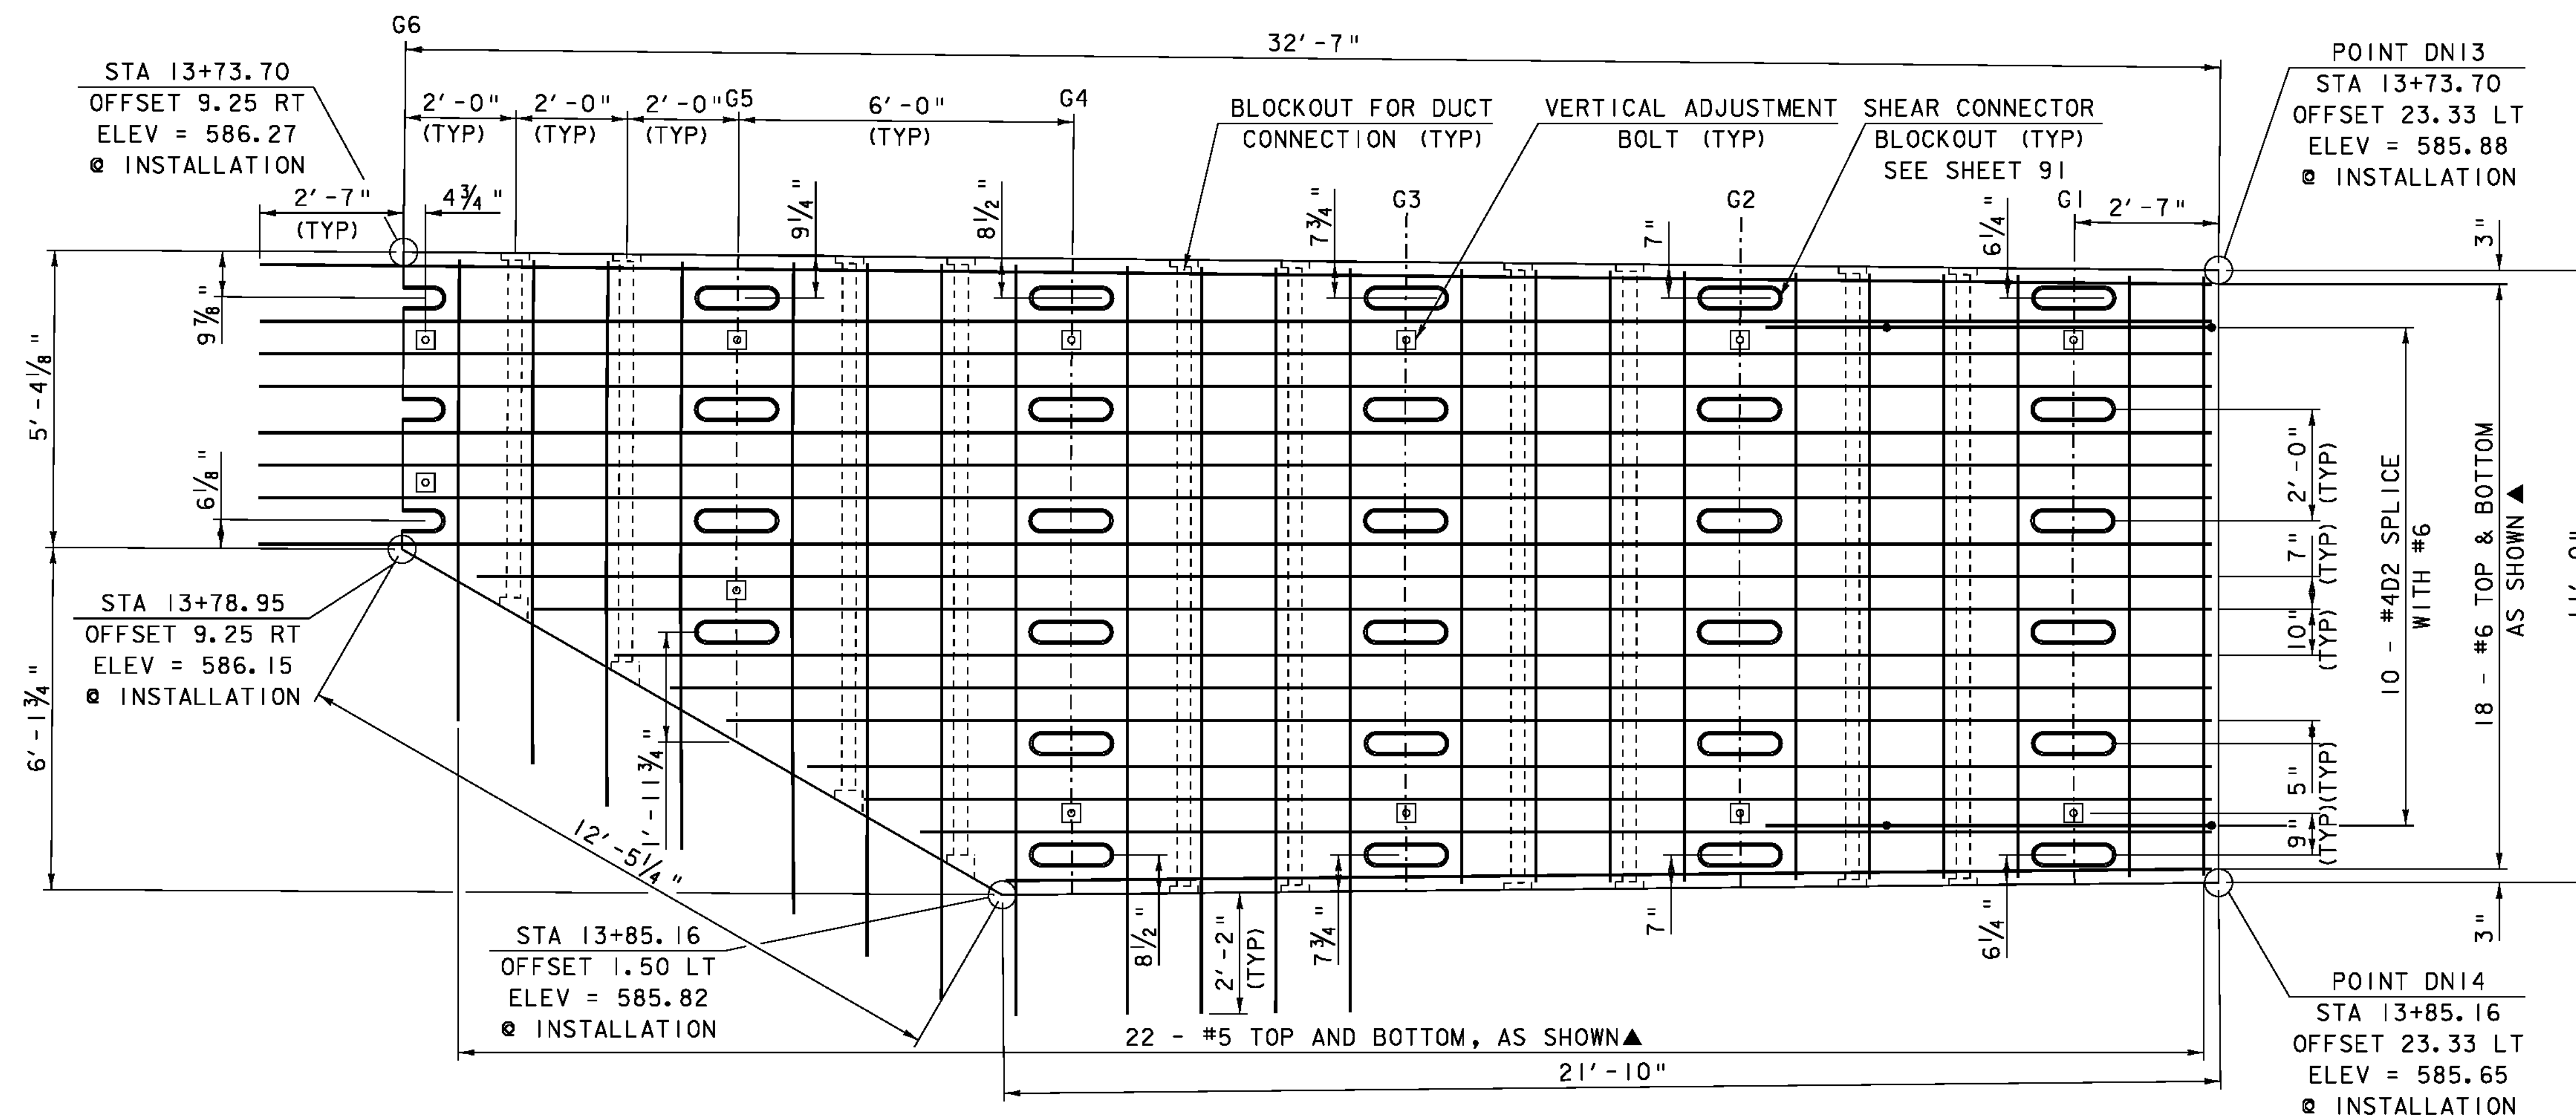


PRECAST SLAB U4 PLAN


SCALE $\frac{1}{2}$ " = 1'-0"
FLOW

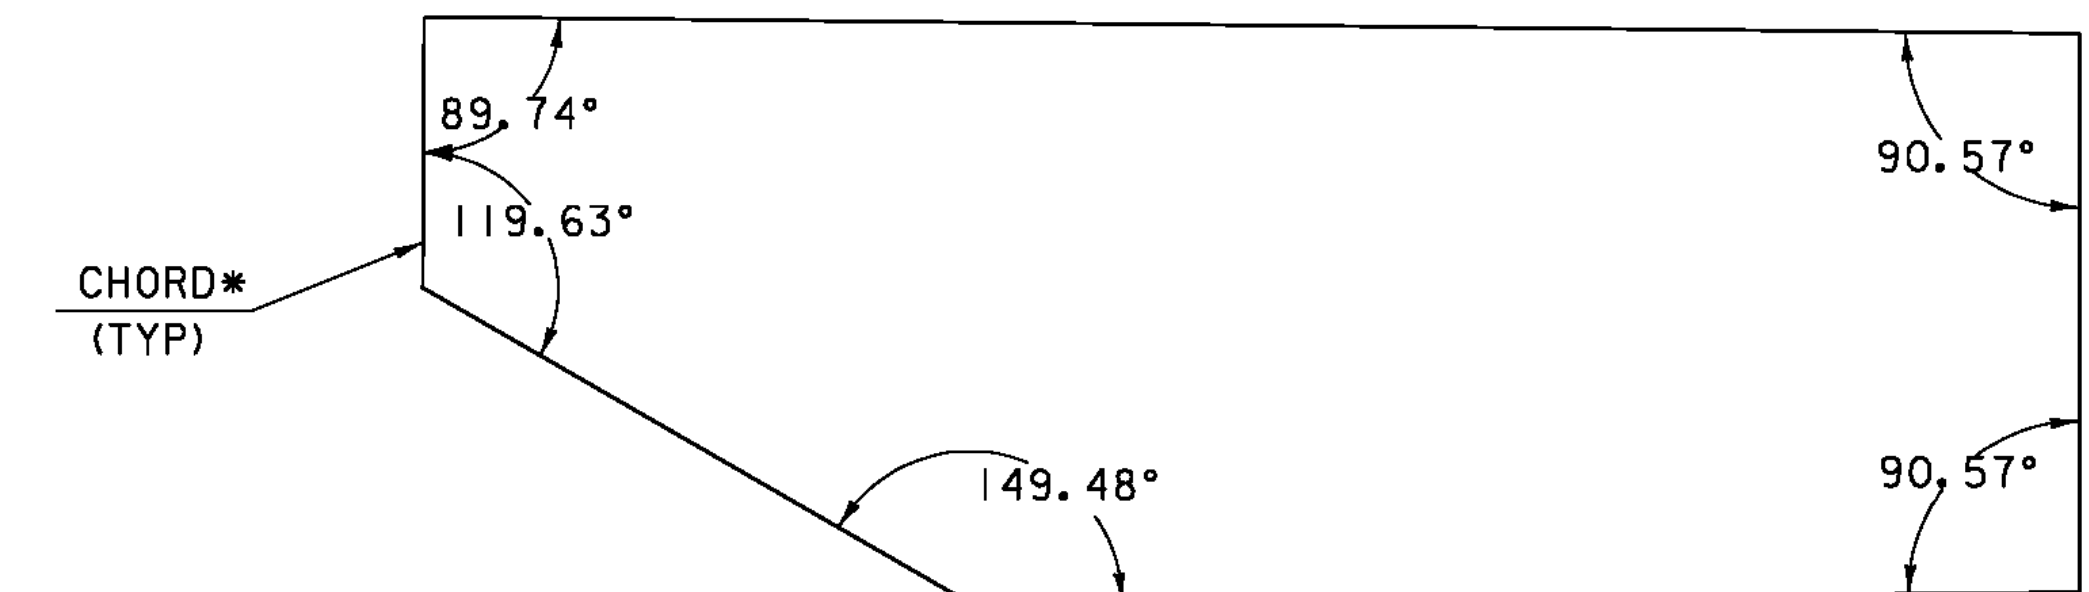

U14 ANGLES

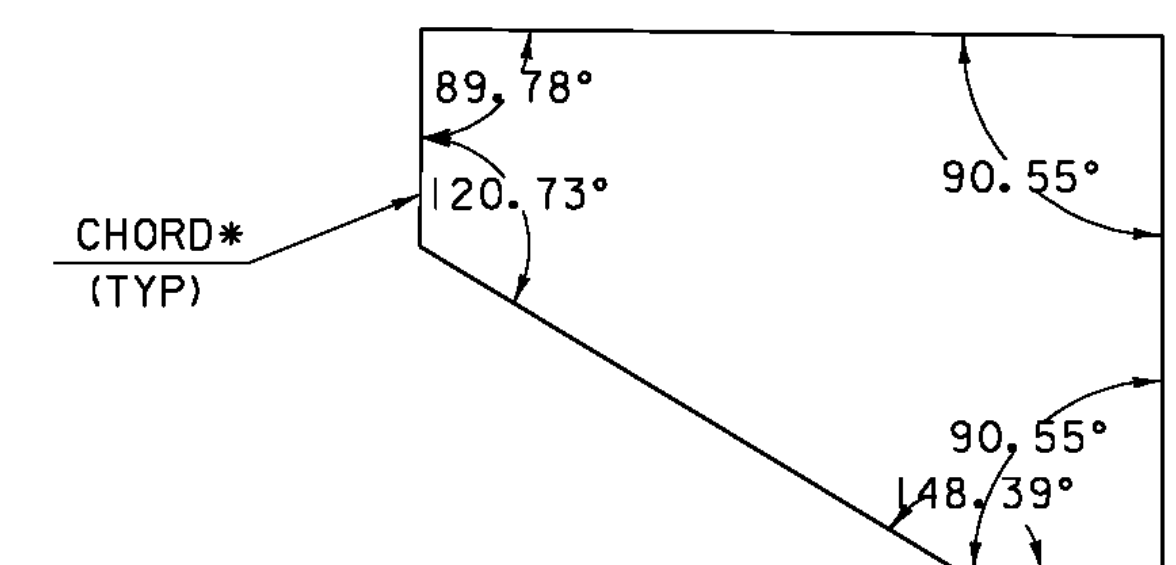

U15 ANGLES

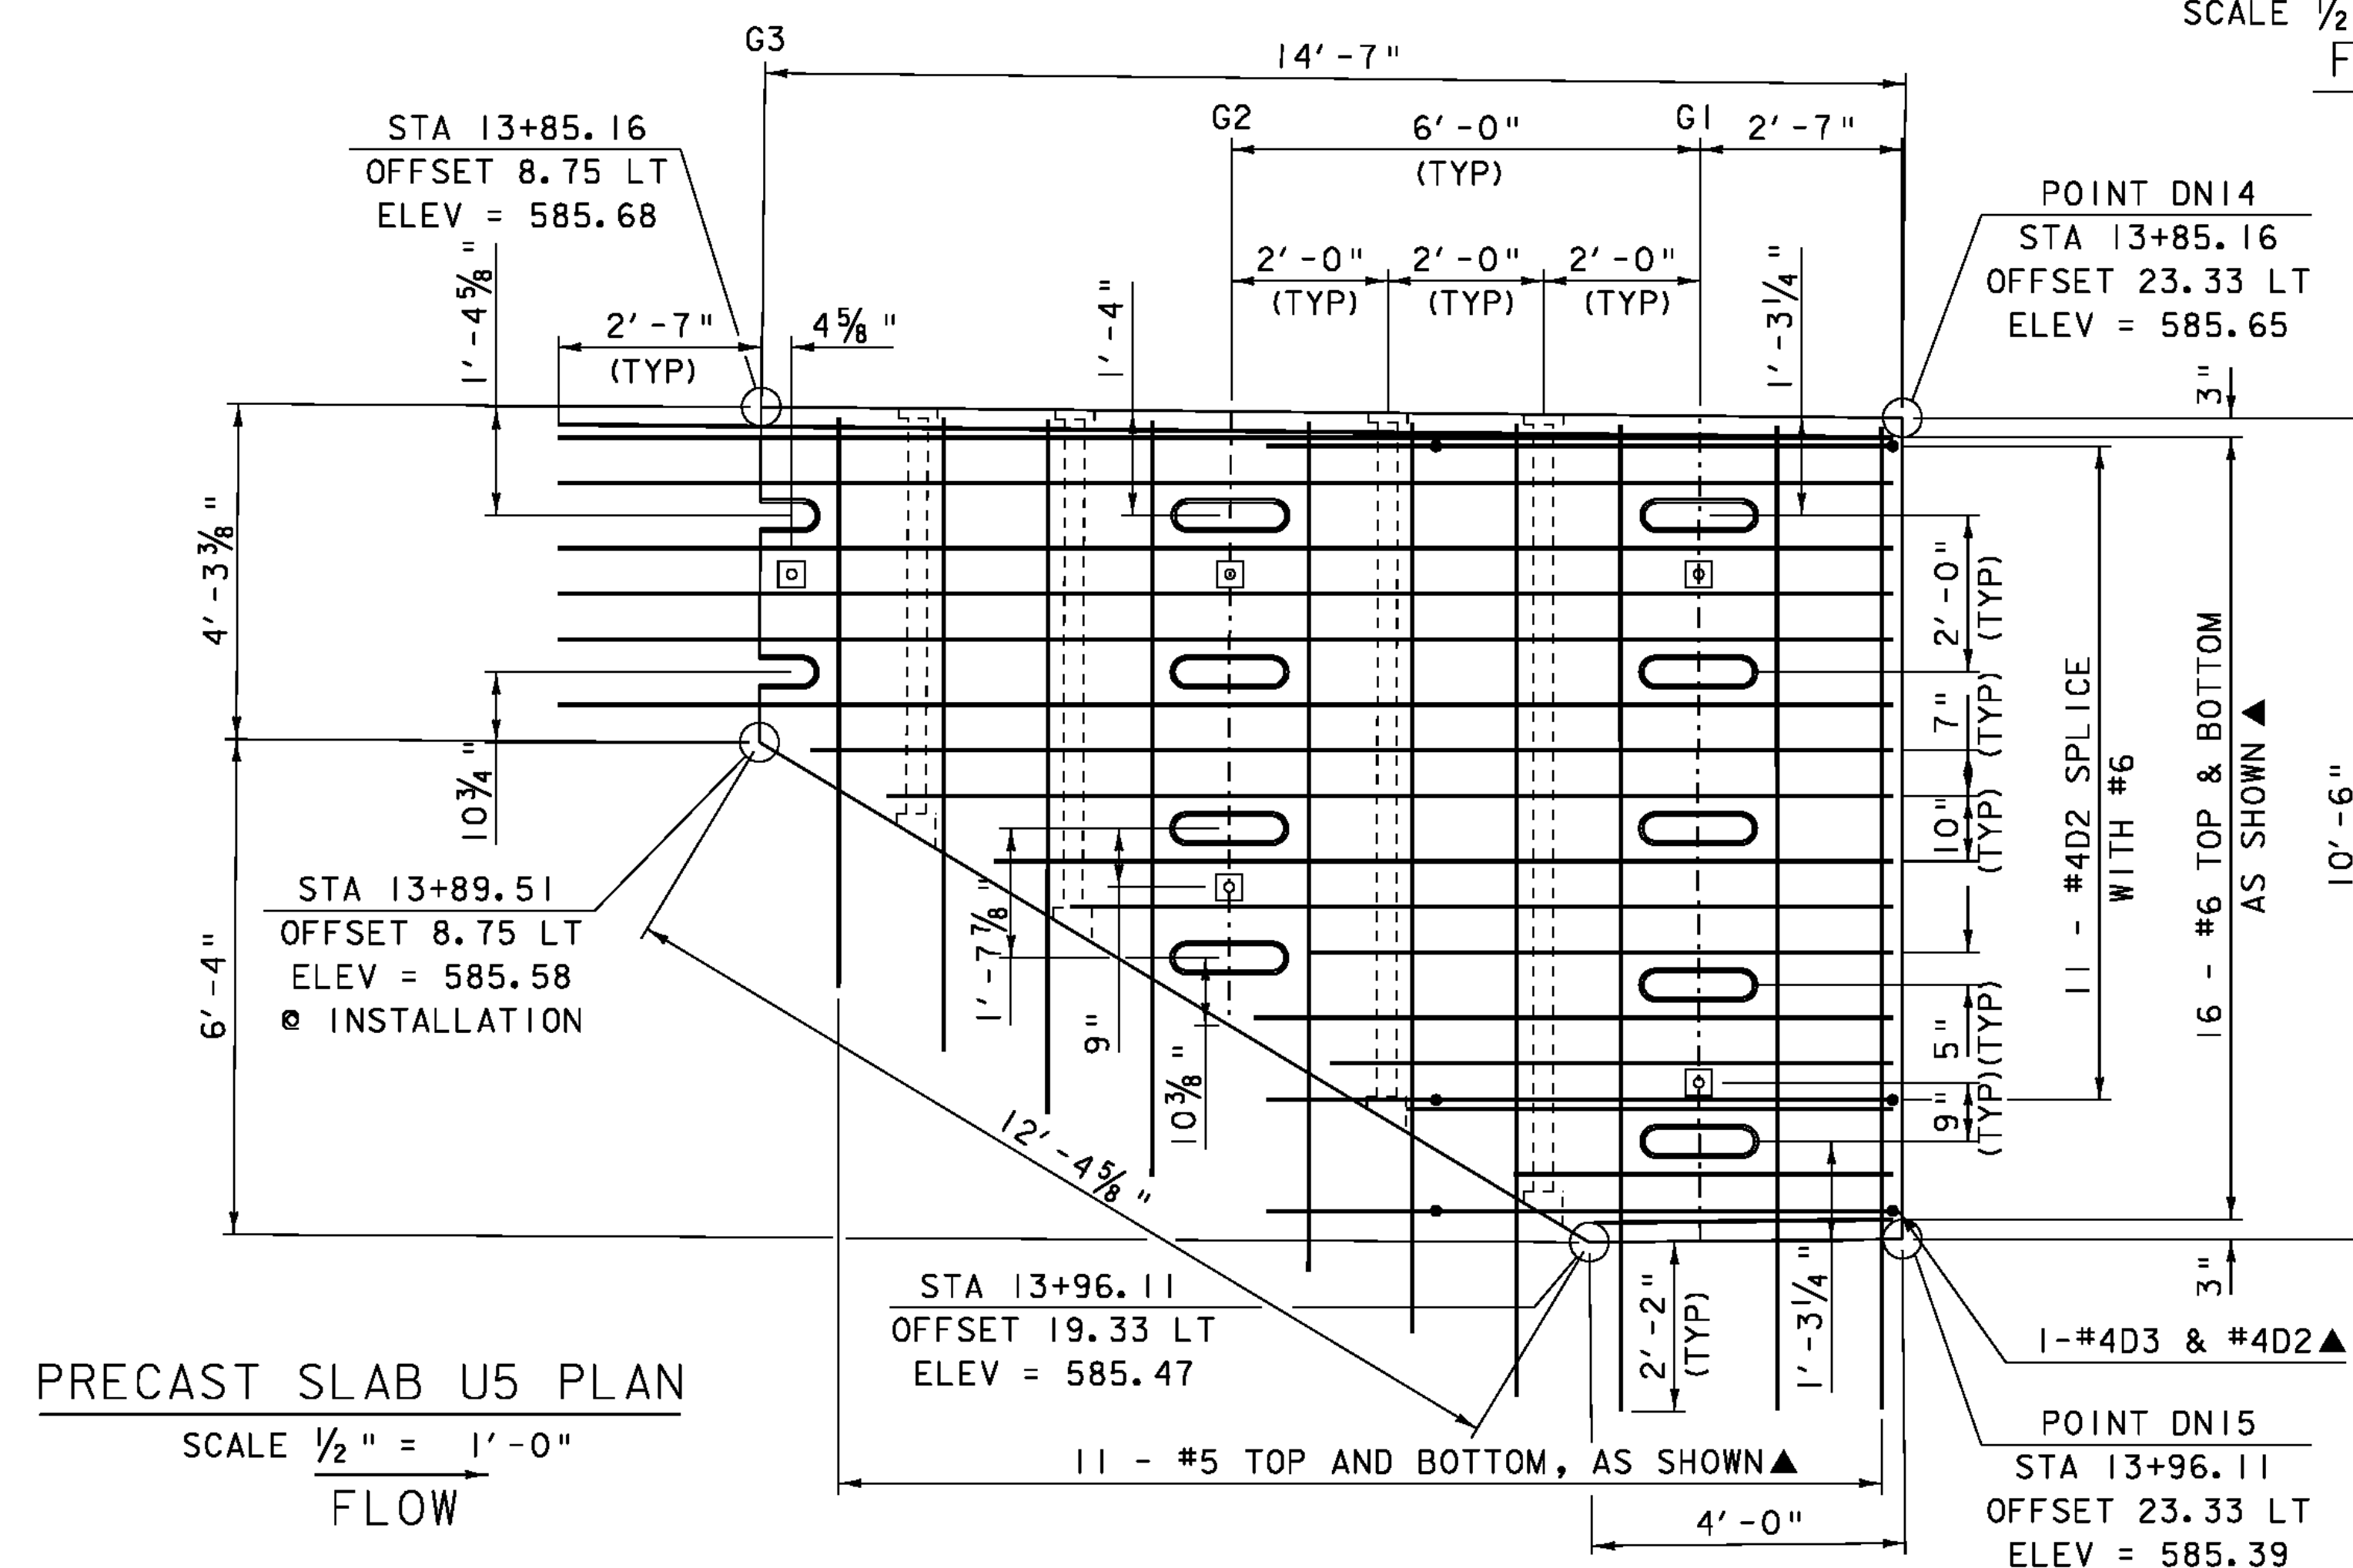

PRECAST SLAB U5 PLAN

SCALE $\frac{1}{2}$ " = 1'-0"
FLOW

NOTE:

NF = NEAR FACE
FF = FAR FACE
EF = EACH FACE
▲ = CUT TO FIT IN FIELD
3" CLEAR, UNLESS OTHERWISE
SPECIFIED ON THE PLANS.
2'-2" BAR LAP UNLESS OTHERWISE
SPECIFIED ON THE PLANS.

* ANGLES ARE IN REFERENCE TO THE CHORD BETWEEN POINTS OF CURVATURE
AT THE CORNERS. THE SLAB FASCIAS SHALL BE FORMED RADIAL.

SCALE $\frac{1}{2}$ " = 1'-0"
0 1 2

PROJECT NAME: CHESTER
PROJECT NUMBER: BRF 025-1(37)

FILE NAME: 95b168\95b168deckpanels.dgn PLOT DATE: 21-SEP-2010
PROJECT LEADER: C.P. WILLIAMS DRAWN BY: D.D. BEARD
DESIGNED BY: H.I. SALLS CHECKED BY: R.S. YOUNG
BRIDGE 9 PRECAST DECK SLAB DETAILS 3 SHEET 89 OF 124