


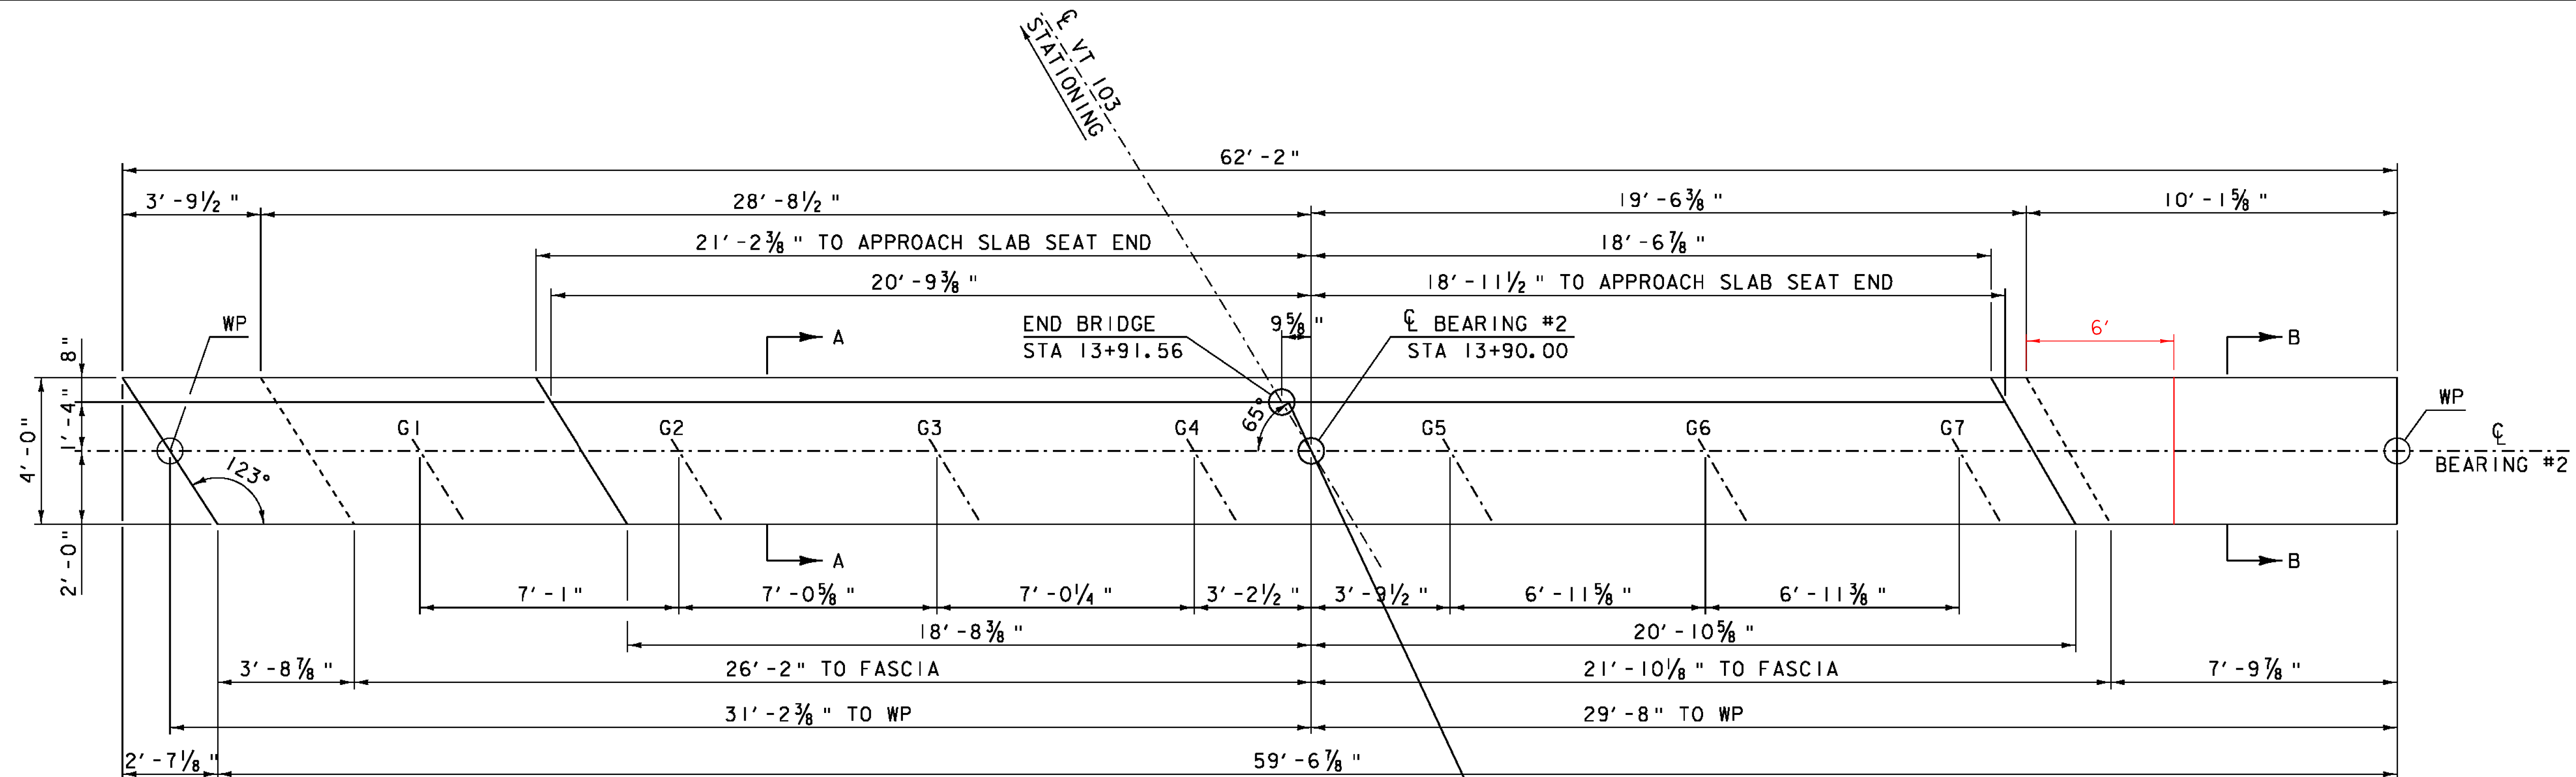

NOTE:


NF = NEAR FACE
 FF = FAR FACE
 EF = EACH FACE
 ▲ = CUT TO FIT IN FIELD
 3" CLEAR, UNLESS OTHERWISE
 SPECIFIED ON THE PLANS.
 2'-2" BAR LAP UNLESS OTHERWISE
 SPECIFIED ON THE PLANS.

ABUTMENT #2 PLAN

SCALE $\frac{3}{8}" = 1'-0"$


SEE SHEET 96 FOR SECTIONS "A-A" & "B-B"

ABUTMENT #2, WW4
 FIELD CHANGES:
 LOWERED CONCRETE HEIGHT
 AND ANGLED WINGWALL

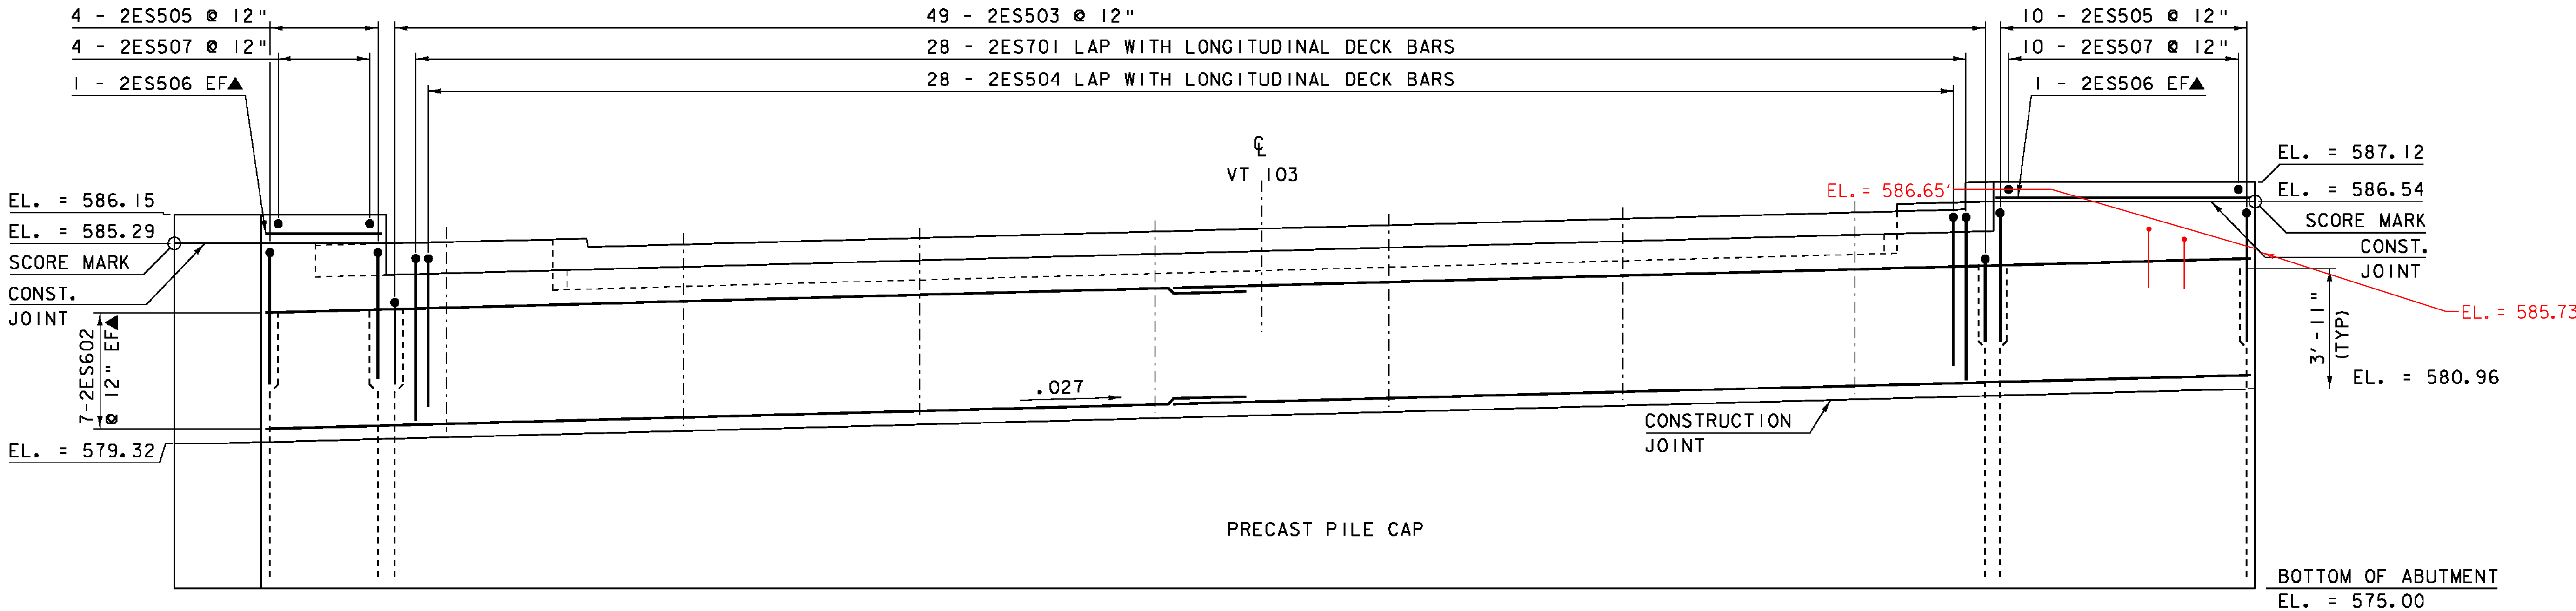

ABUTMENT #2 ELEVATION

SCALE $\frac{3}{8}" = 1'-0"$

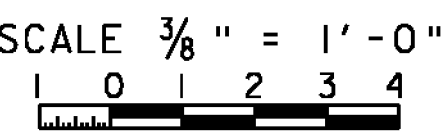

PROJECT NAME: CHESTER	PLOT DATE: 20-SEP-2010
PROJECT NUMBER: BRF 025-1(37)	DRAWN BY: D.D.BEARD
FILE NAME: 95b168\95b168sub.dgn	CHECKED BY: R.S.YOUNG
PROJECT LEADER: C.P.WILLIAMS	SHEET 93 OF 124
DESIGNED BY: R.S.YOUNG	
BRIDGE 9 ABUTMENT 2 DETAILS	