
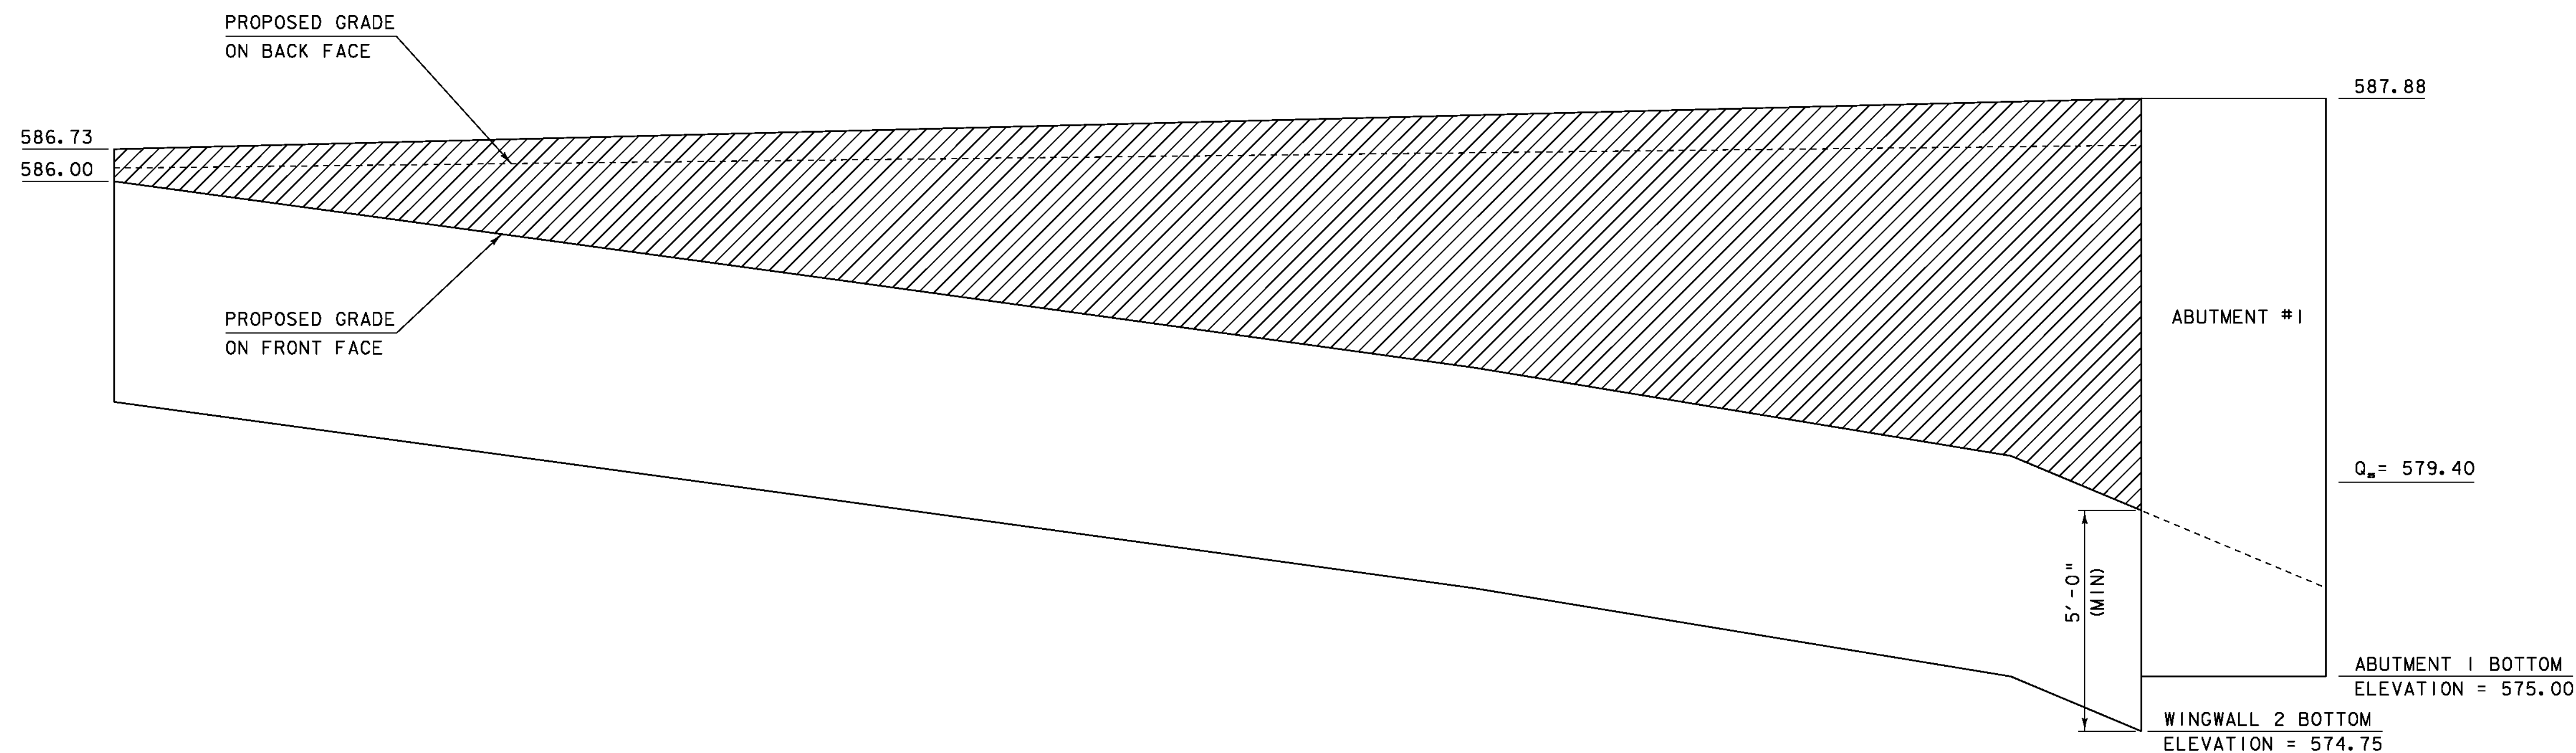
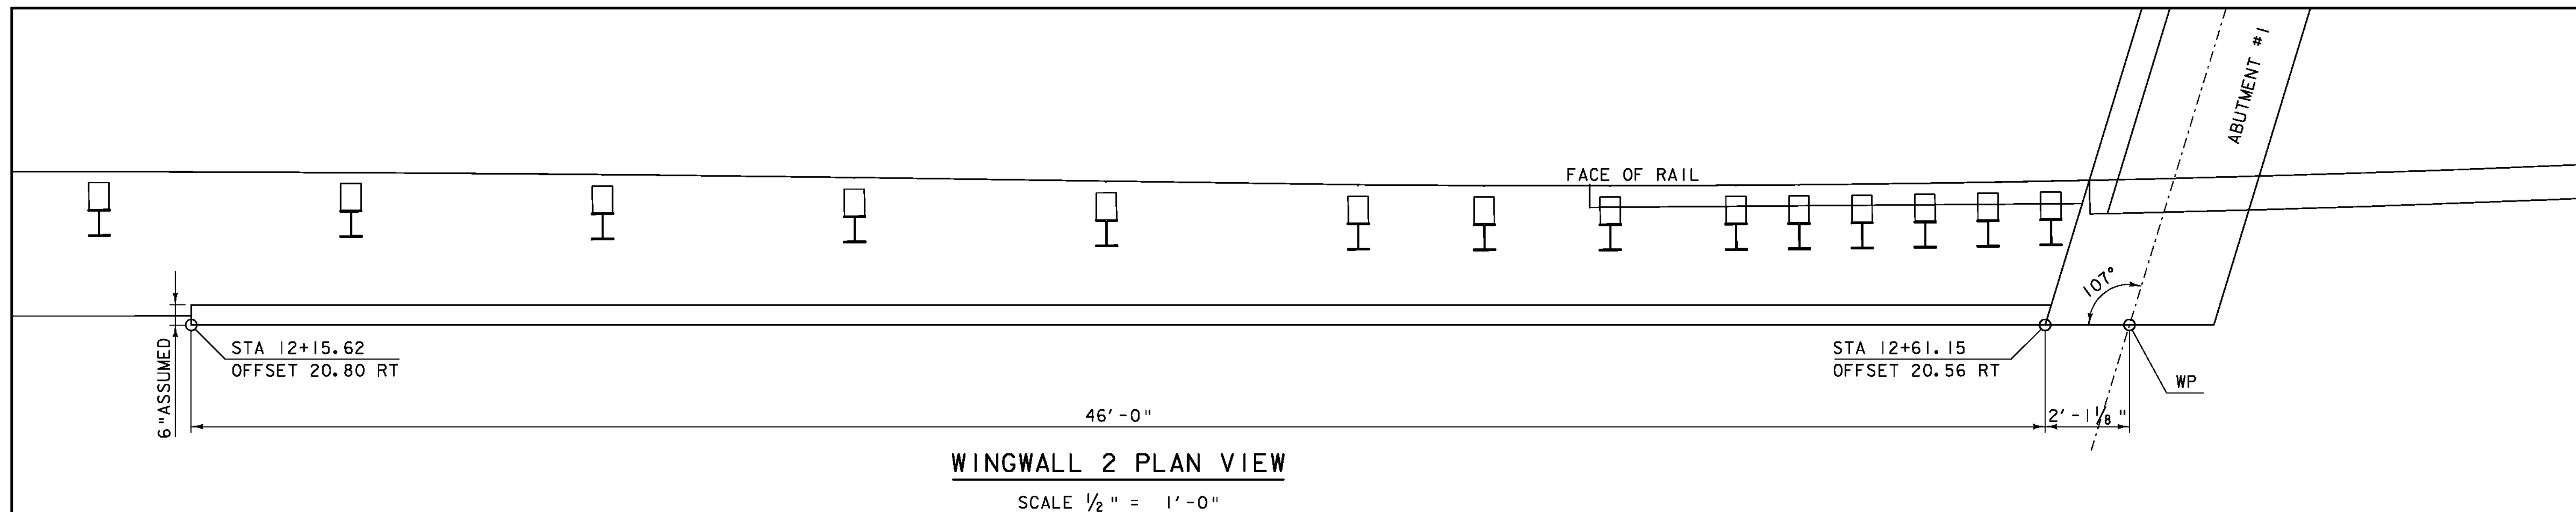
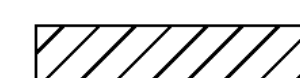


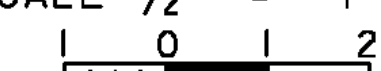

 PAY LIMITS OF ITEM 900.670 "SPECIAL PROVISION (RETAINING WALL)"

SEE SHEET 98 FOR
ADDITIONAL INFORMATION
AND TYPICAL SECTION

SCALE 1/2" = 1'-0"


PROJECT NAME:	CHESTER	FILE NAME:	95bl68\s95bl68sub.dgn	PLOT DATE:	21-SEP-2010
PROJECT NUMBER:	BRF 025-1(37)	PROJECT LEADER:	C.P.WILLIAMS	DRAWN BY:	D.D.BEARD
		DESIGNED BY:	R.S.YOUNG	CHECKED BY:	E.R.CHARBONNEAU
		BRIDGE 9 WINGWALL 2 DETAILS		SHEET	97 OF 124