

REMOVING SIGNS


12+11.10 RT
12+29.00 RT
12+45.20 RT
12+51.15 LT (X2)
12+57.60 LT (X12)
12+58.90 LT
13+74.65 RT
13+76.10 RT
13+82.50 RT
13+96.10 LT
14+28.00 LT (X3)
20+20.00 LT (NARROW BRIDGE)
52+25.05 LT (X2)

TRAFFIC SIGNS, TYPE A

12+12.65 RT
12+34.10 RT
12+54.75 LT (X2)
12+73.30 LT (X12)
13+86.20 RT
14+26.20 LT (X3)
52+25.05 LT (X2)

SQUARE TUBE SIGN
POST AND ANCHOR

12+12.65 RT (X2)
12+34.10 RT
12+54.75 LT
12+73.30 LT (X2)
13+86.20 RT
14+26.20 LT
52+25.05 LT

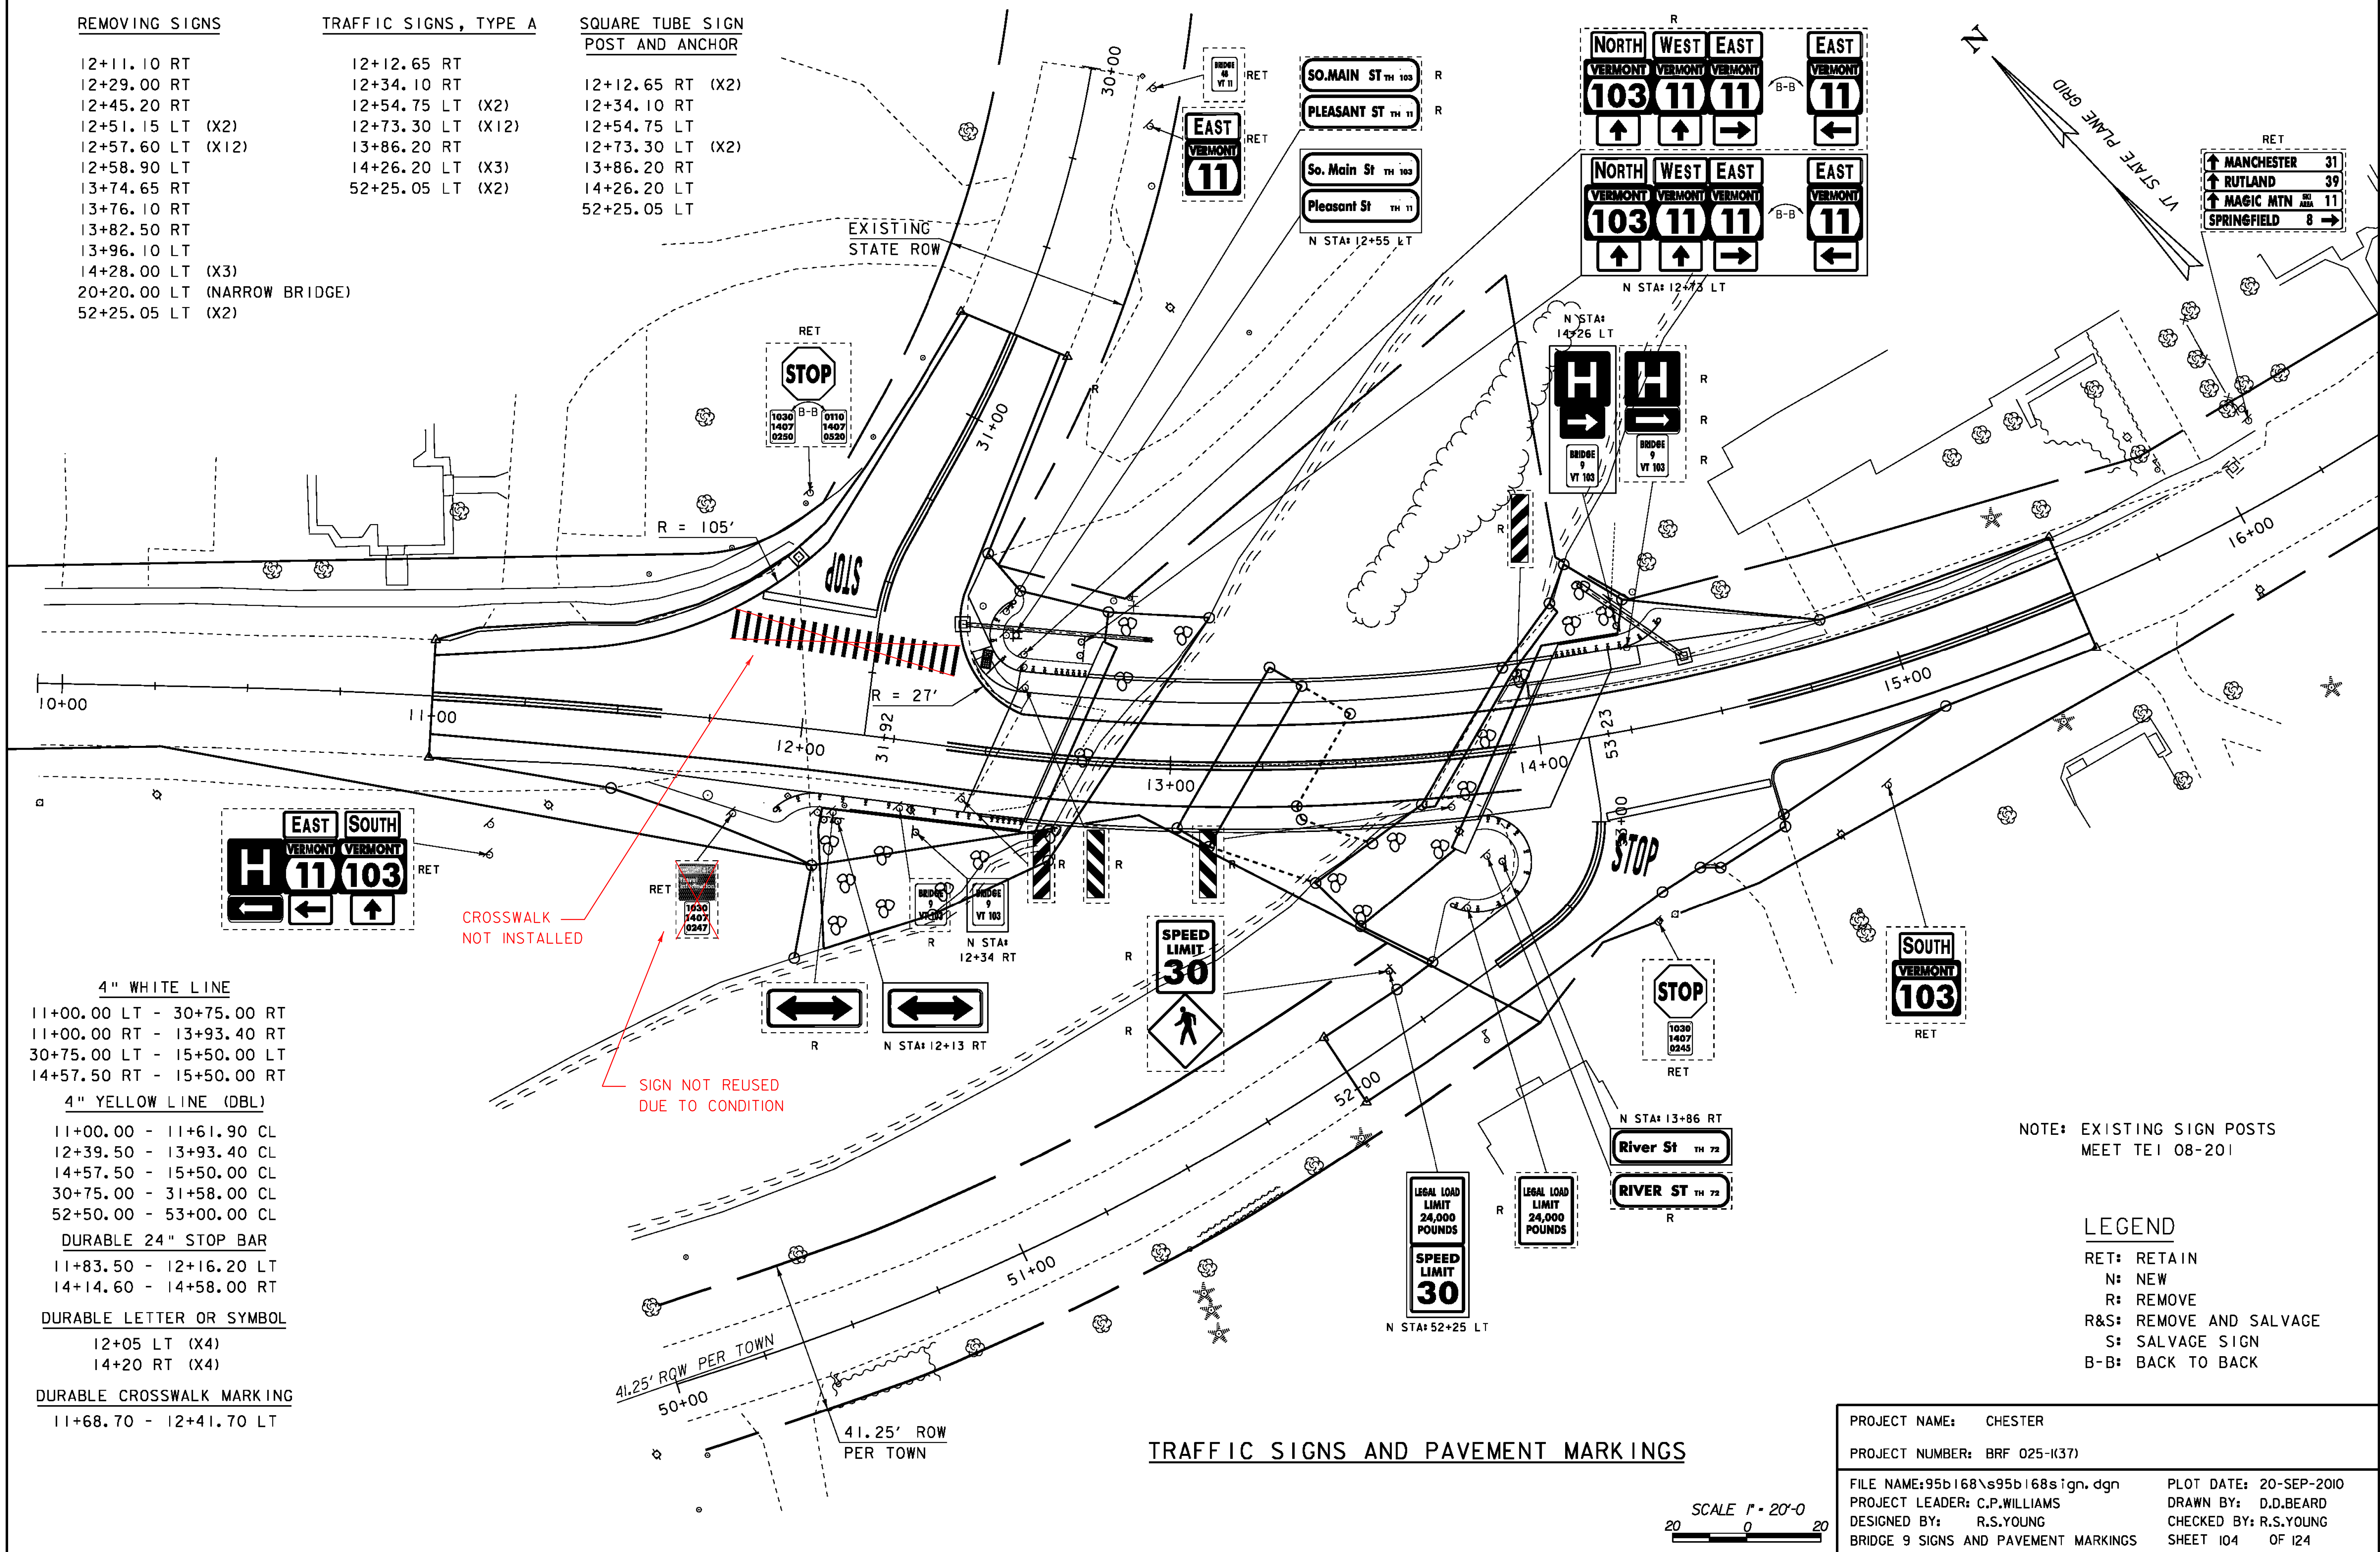

TRAFFIC SIGNS AND PAVEMENT MARKINGS

NOTE: EXISTING SIGN POSTS
MEET TEL 08-201

LEGEND

RET: RETAIN
N: NEW
R: REMOVE
R&S: REMOVE AND SALVAGE
S: SALVAGE SIGN
B-B: BACK TO BACK

PROJECT NAME: CHESTER

PROJECT NUMBER: BRF 025-1(37)

FILE NAME: 95b168\95b168sign.dgn
PROJECT LEADER: C.P.WILLIAMS
DESIGNED BY: R.S.YOUNG
BRIDGE 9 SIGNS AND PAVEMENT MARKINGS

PLOT DATE: 20-SEP-2010
DRAWN BY: D.D.BEARD
CHECKED BY: R.S.YOUNG
SHEET 104 OF 124