



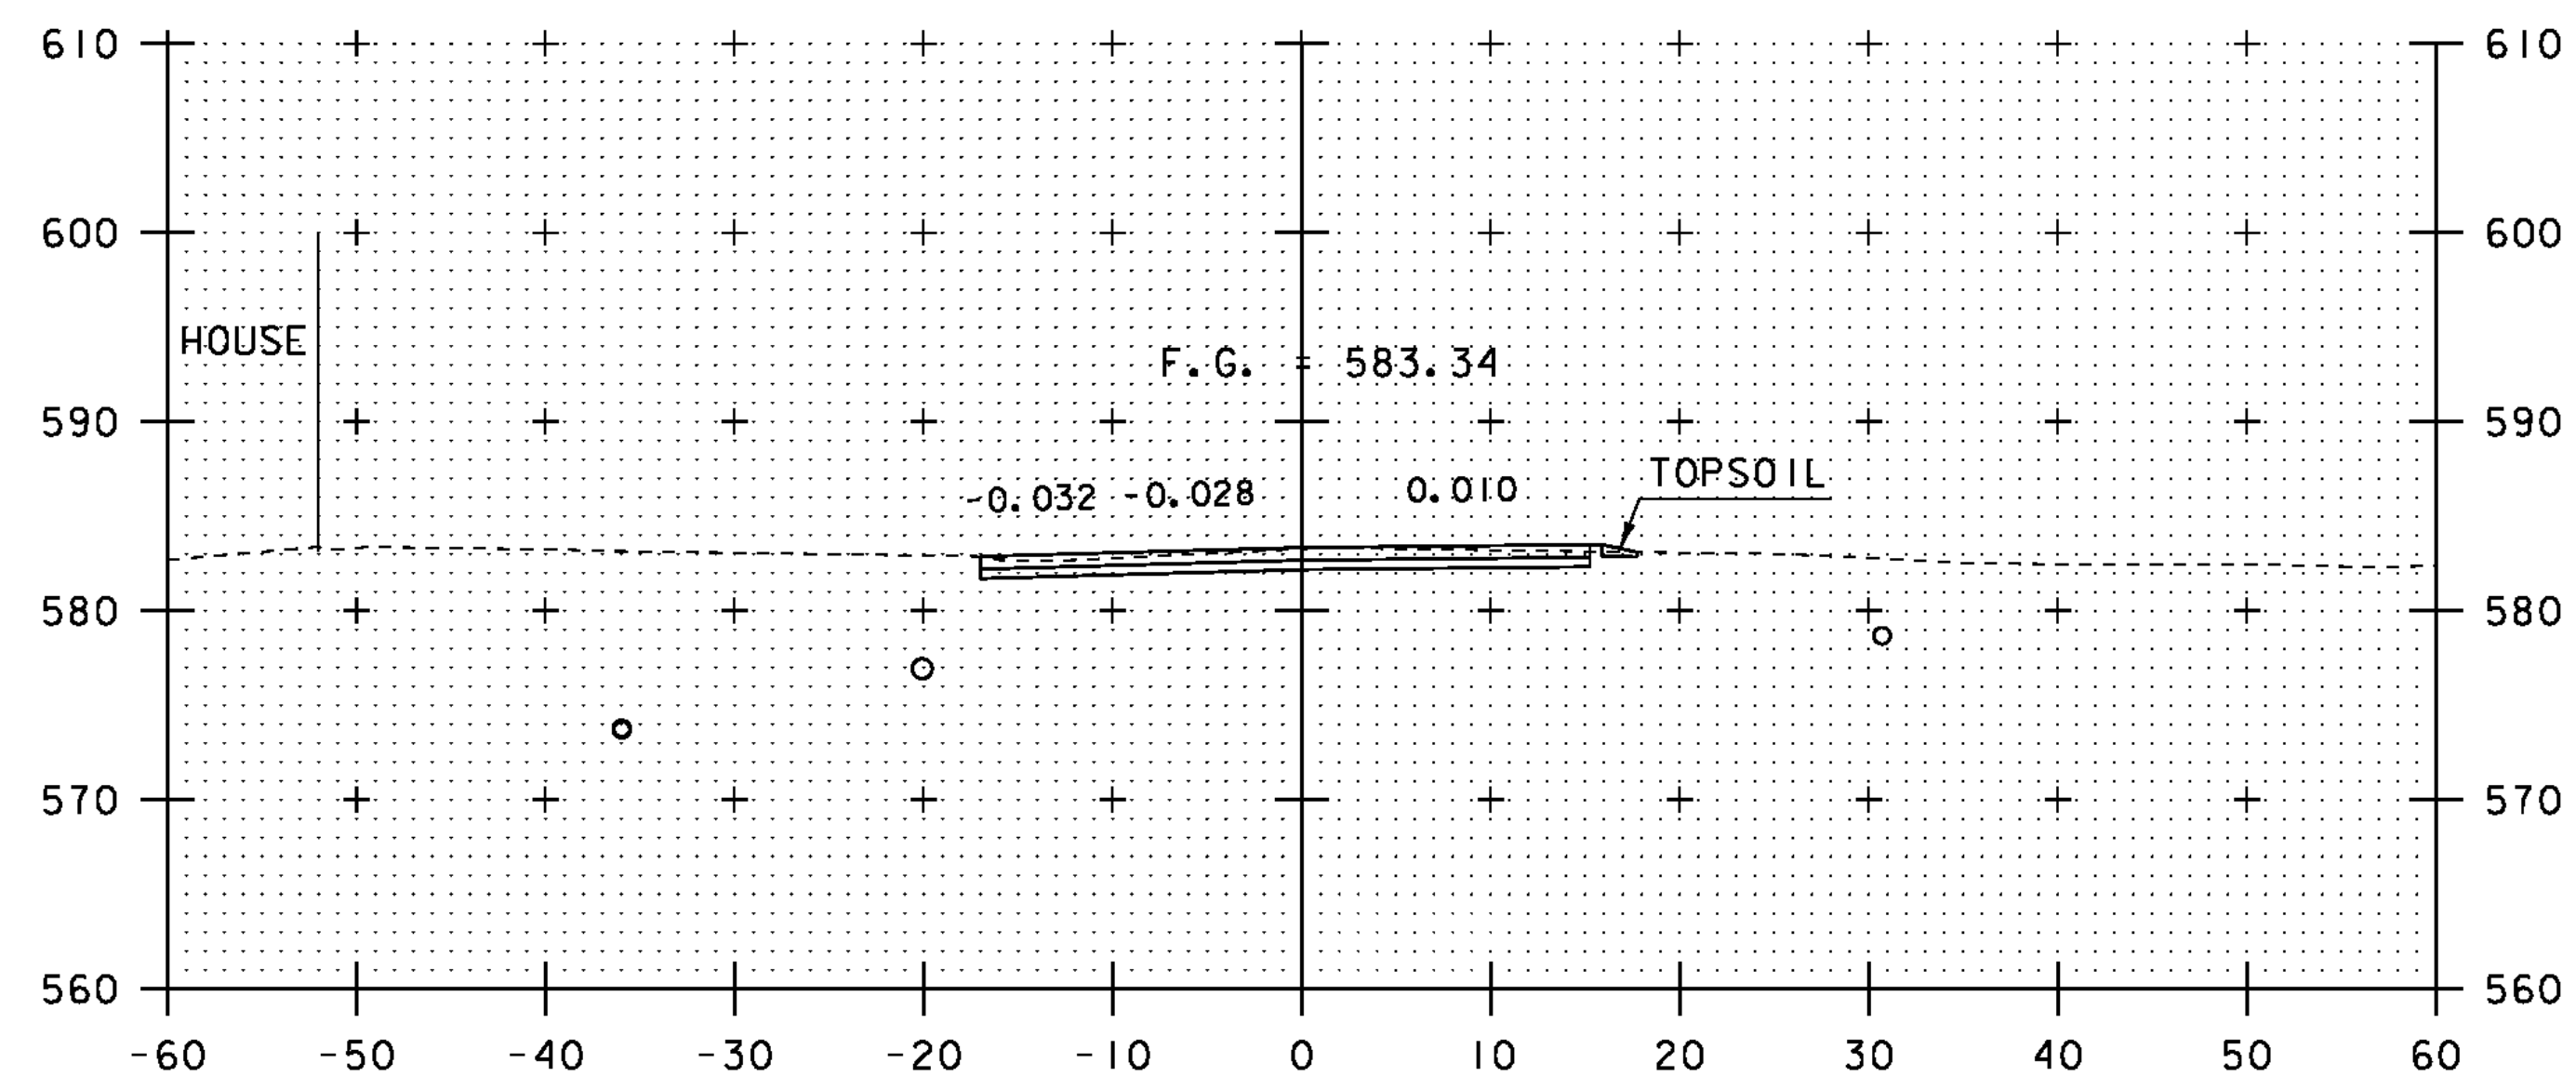


BEGIN 3" TOPSOIL
STATION 14+58.50 RT

15+00

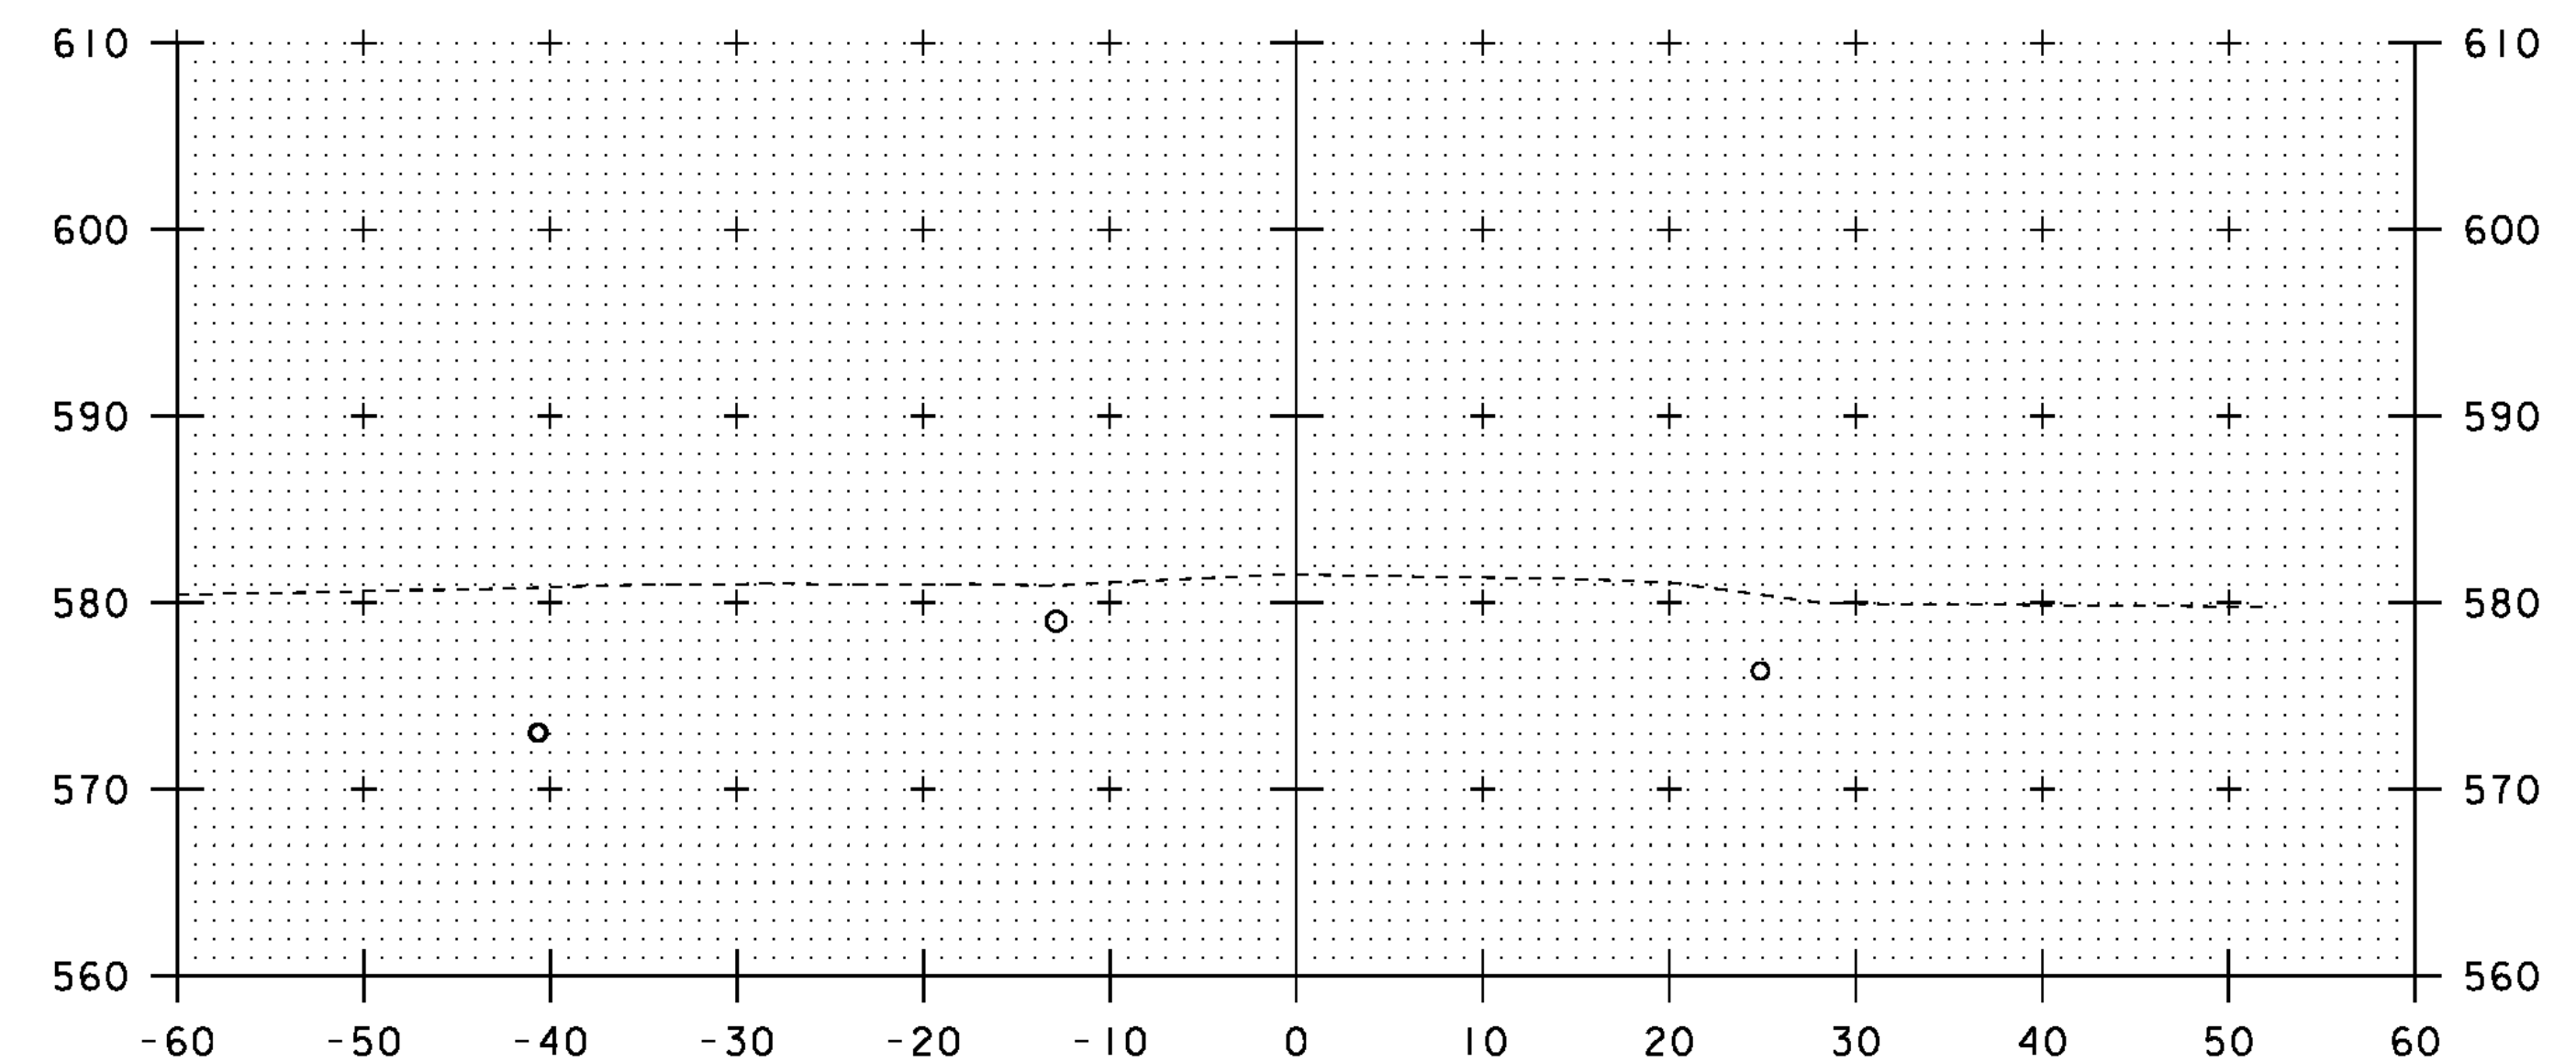


16+00

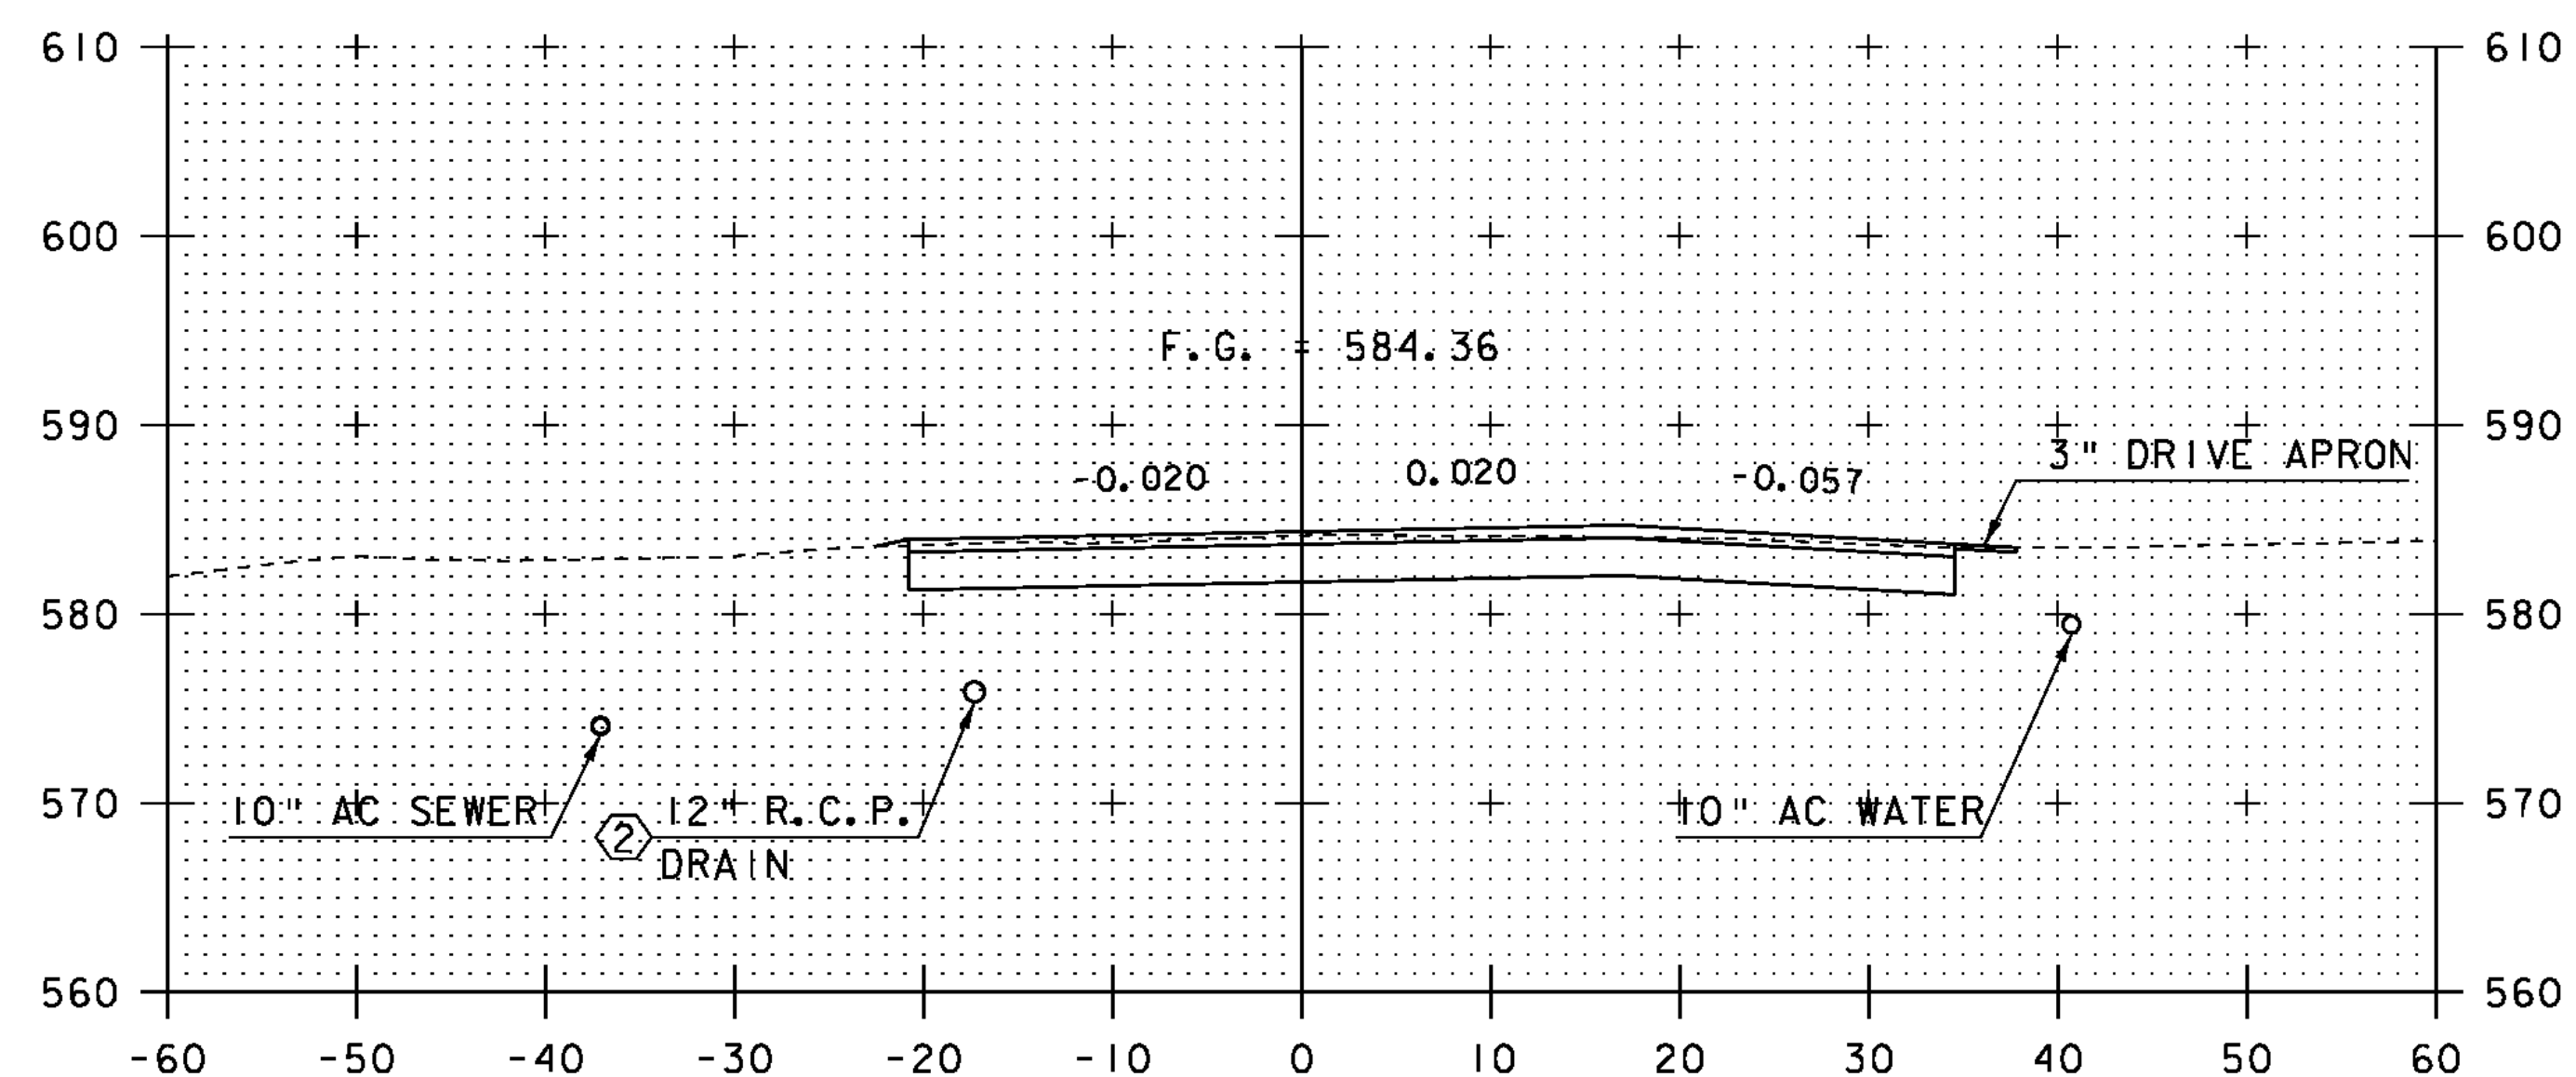

END PROJECT
STATION 14+50.00

14+50

② STA 14+37.76 LT
INLET ELEV = 575.00 EST
OUTLET ELEV = 574.00 EST

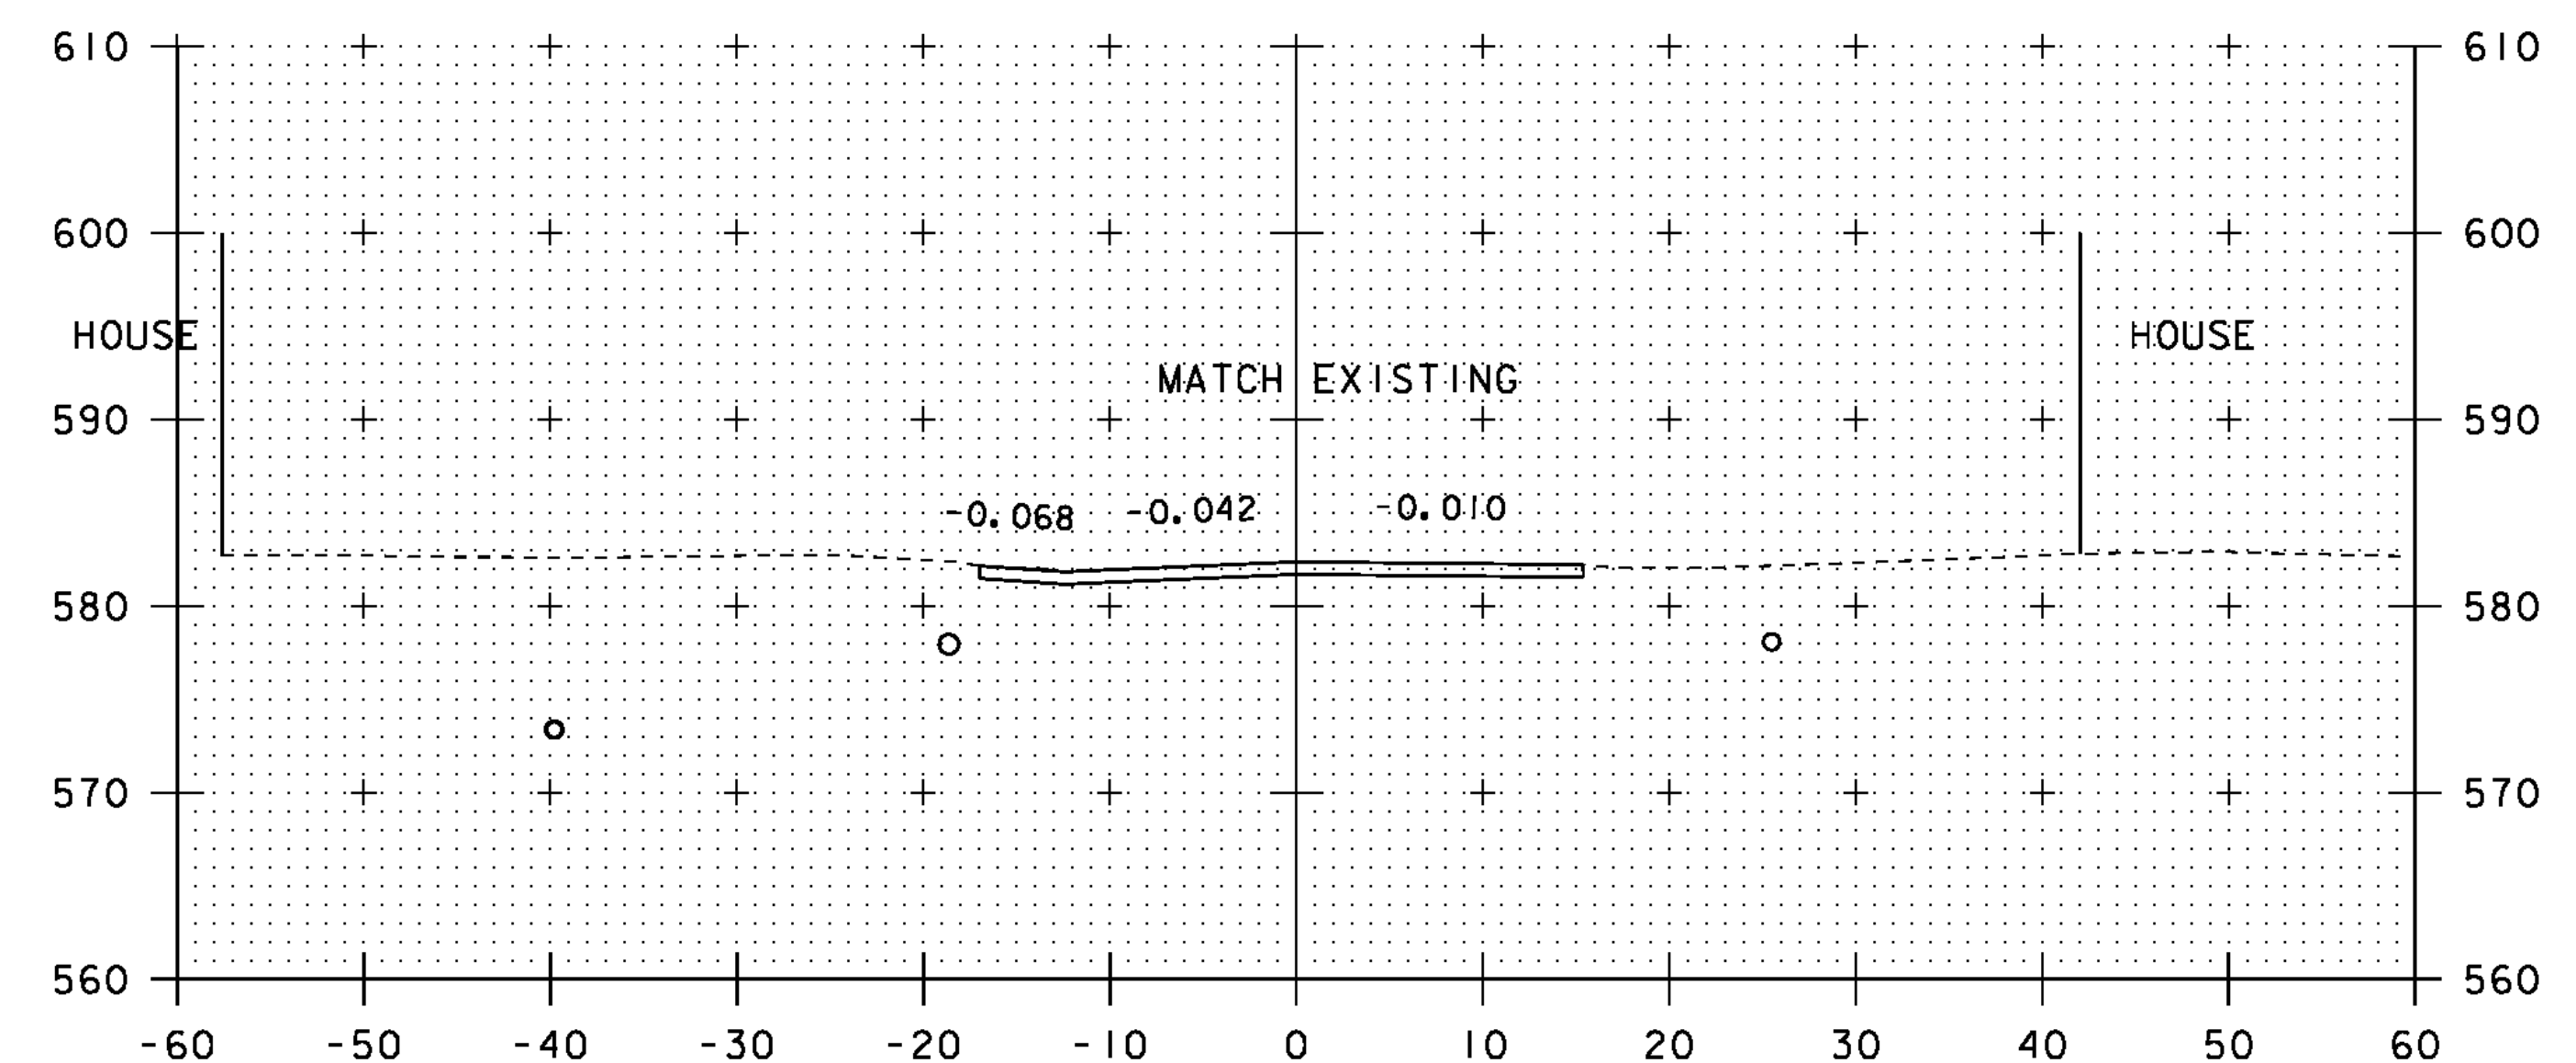

END APPROACH
STATION 15+50.00
END 3" TOPSOIL
STATION 15+07.65 RT

15+50

SCALE 1" = 10'-0"

STA. 14+50 TO STA. 16+00

PROJECT NAME: CHESTER

PROJECT NUMBER: BRF 025-1(37) SC

FILE NAME: s95b168xsl.dgn

PROJECT LEADER: C.P.WILLIAMS

DESIGNED BY: R.S.YOUNG

BRIDGE 9 MAINLINE CROSS SECTIONS

PLOT DATE: 20-SEP-2010

DRAWN BY: D.D.BEARD

CHECKED BY: R.S.YOUNG

SHEET 117 OF 124