



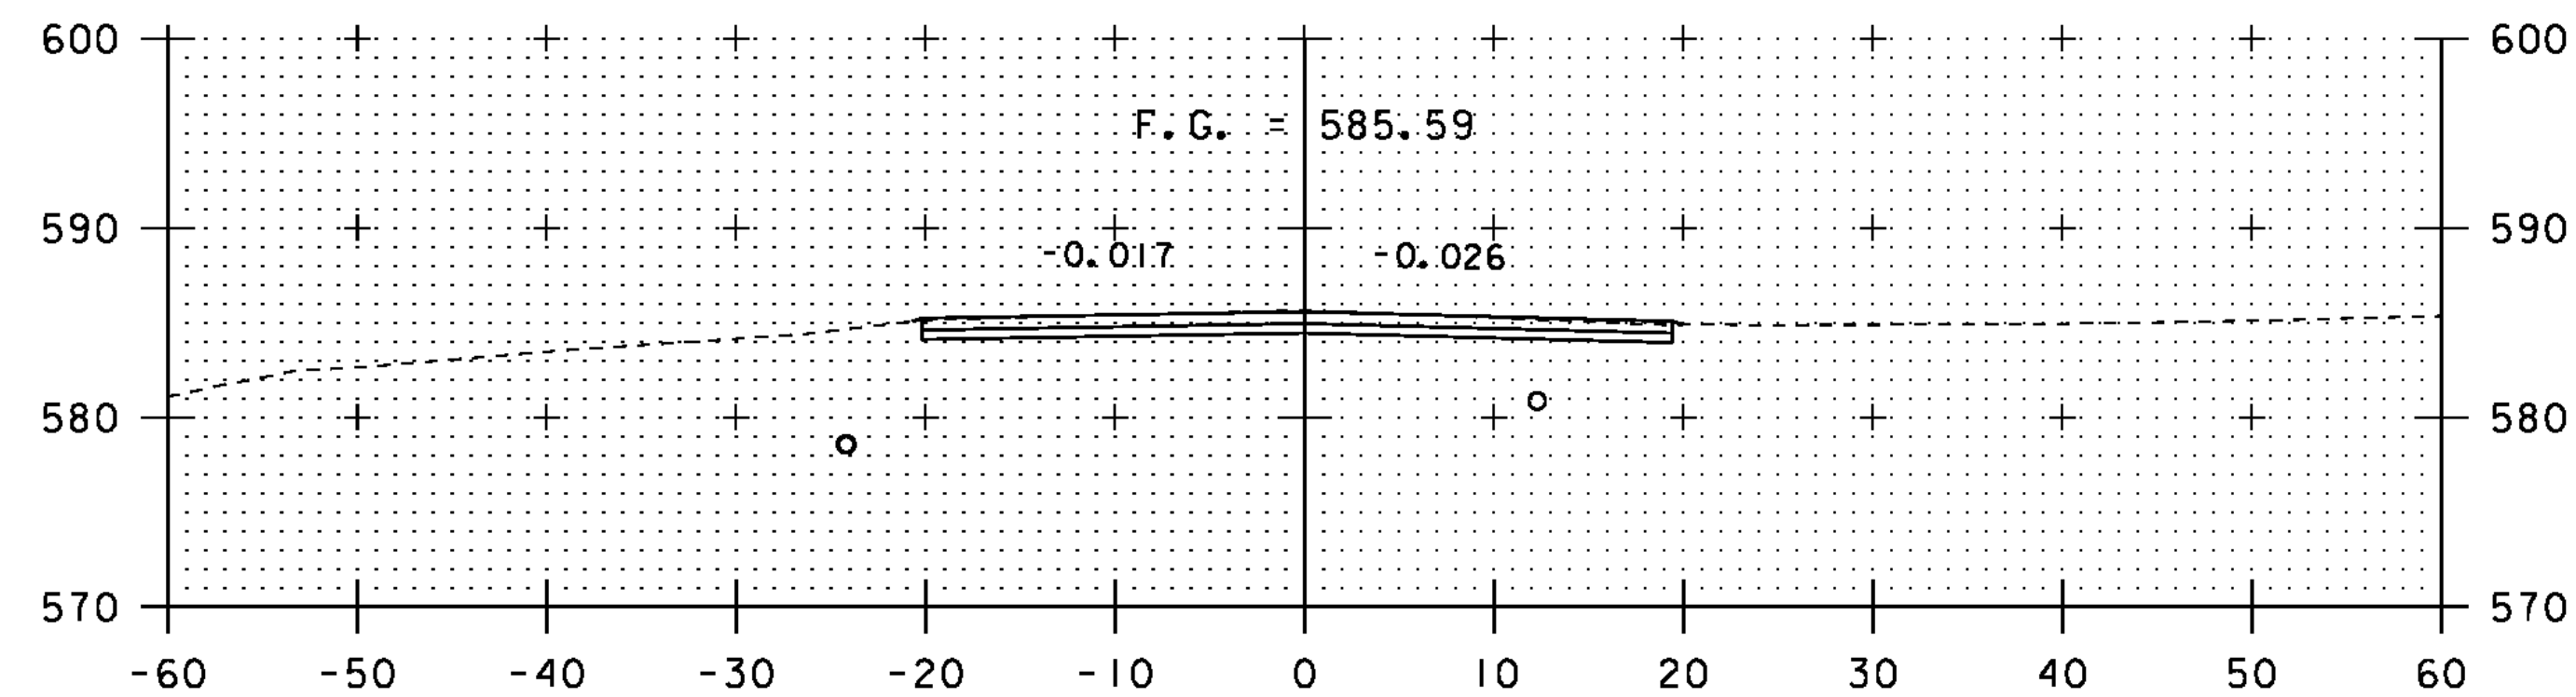


31+25

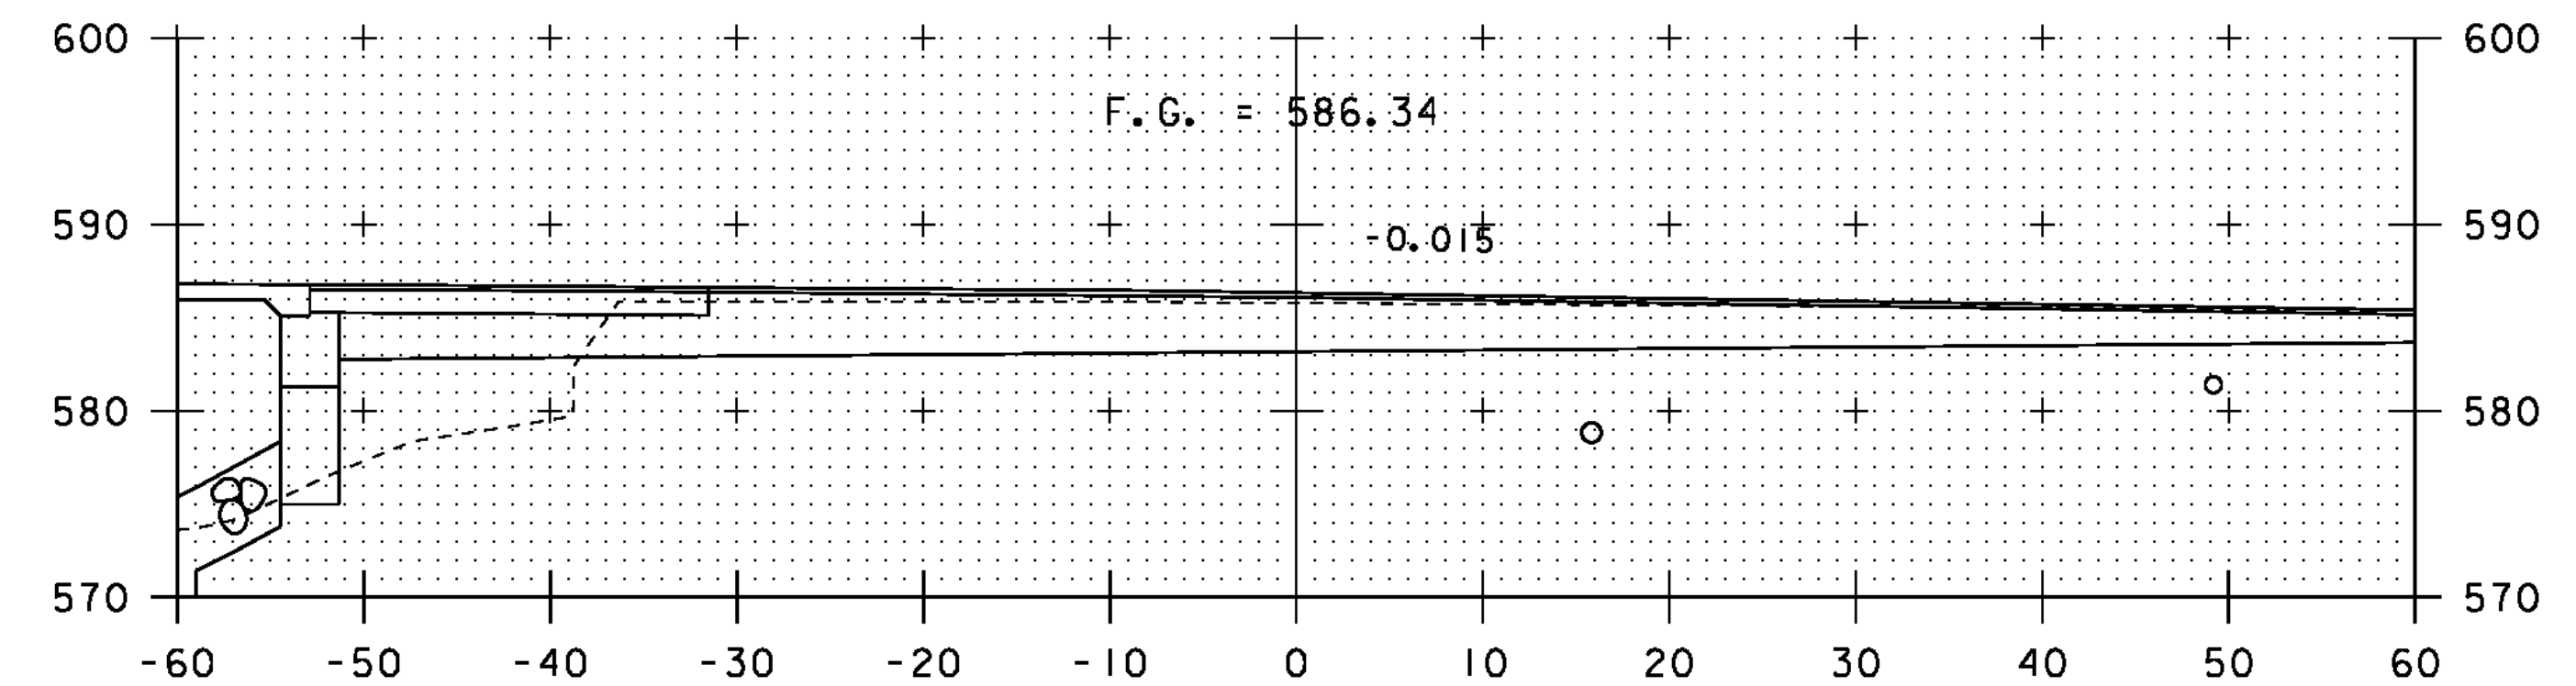


31+92


=STA 12+17.00 @ VT 103

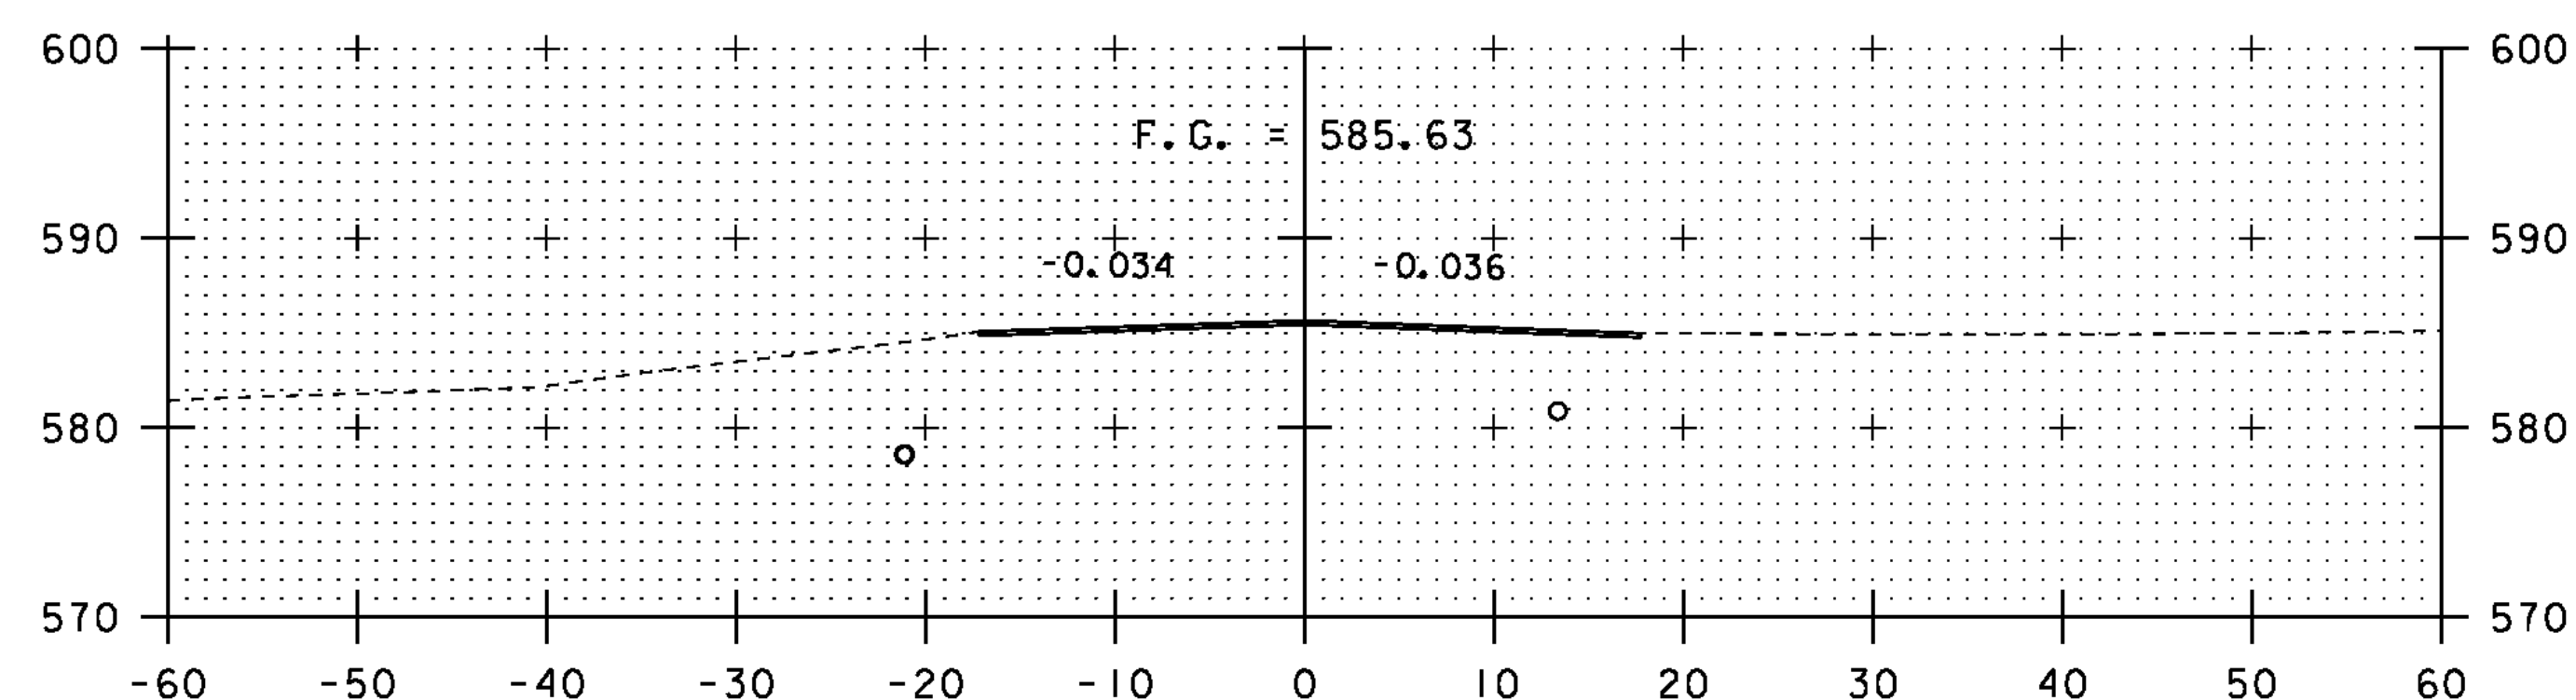


31+00

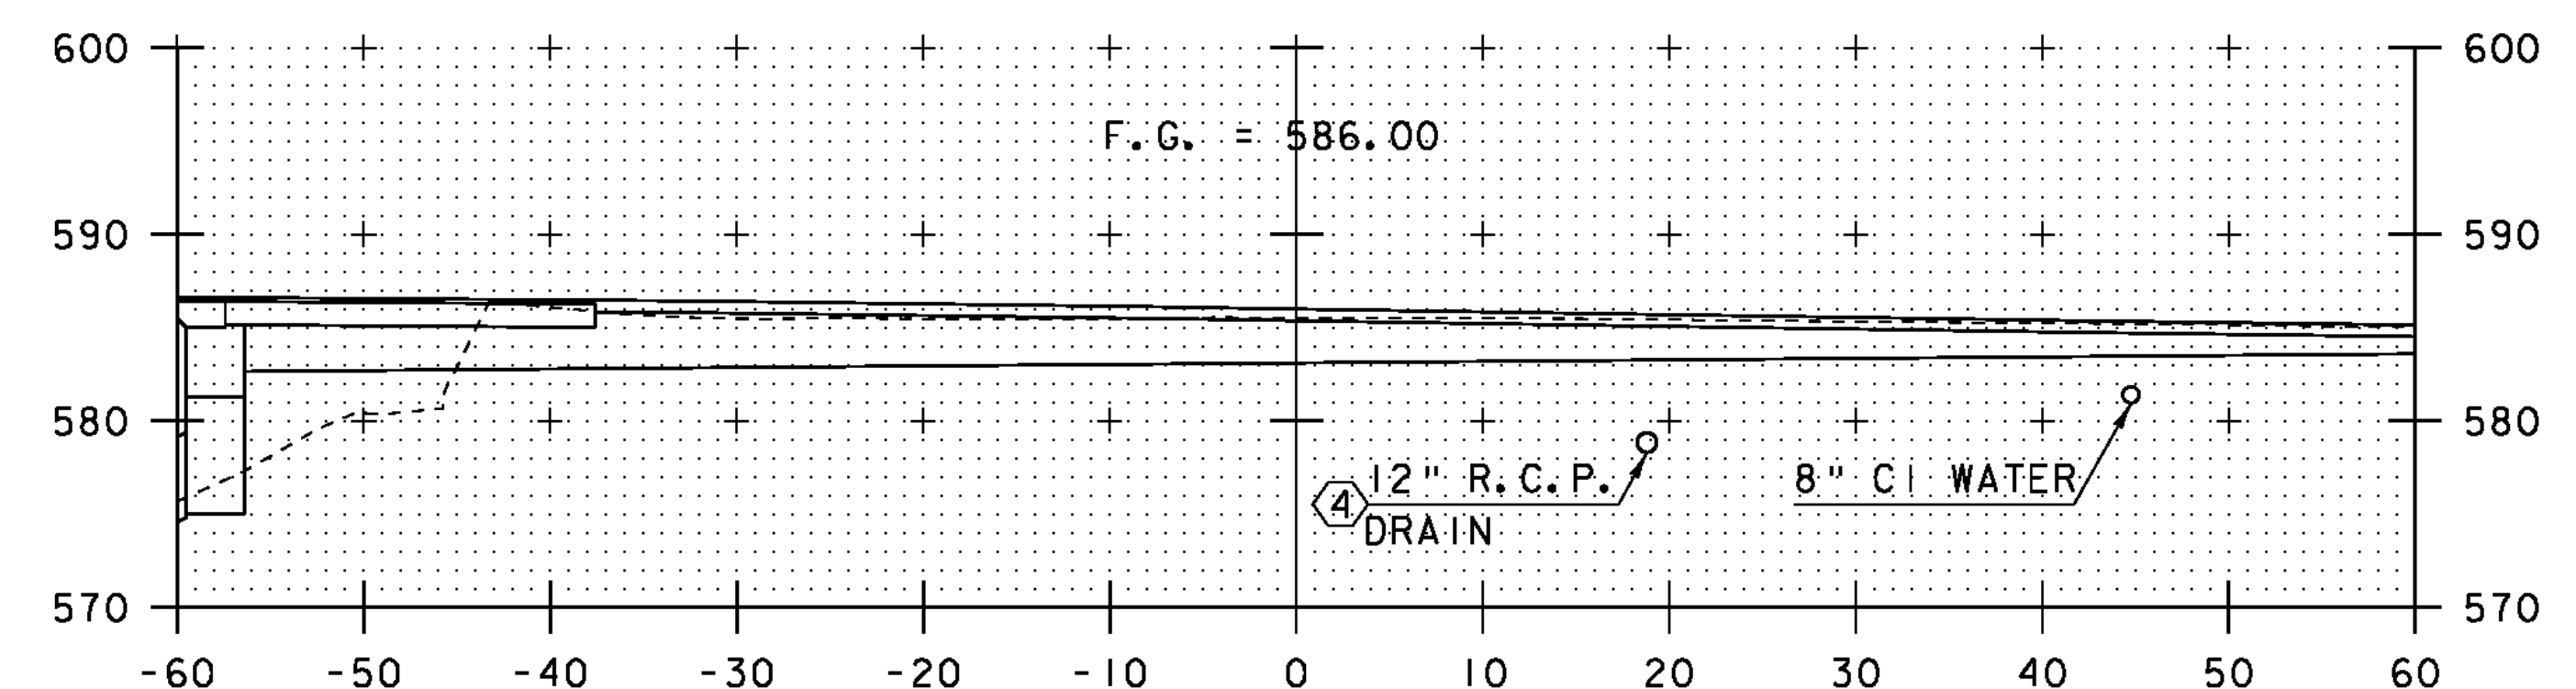

31+75

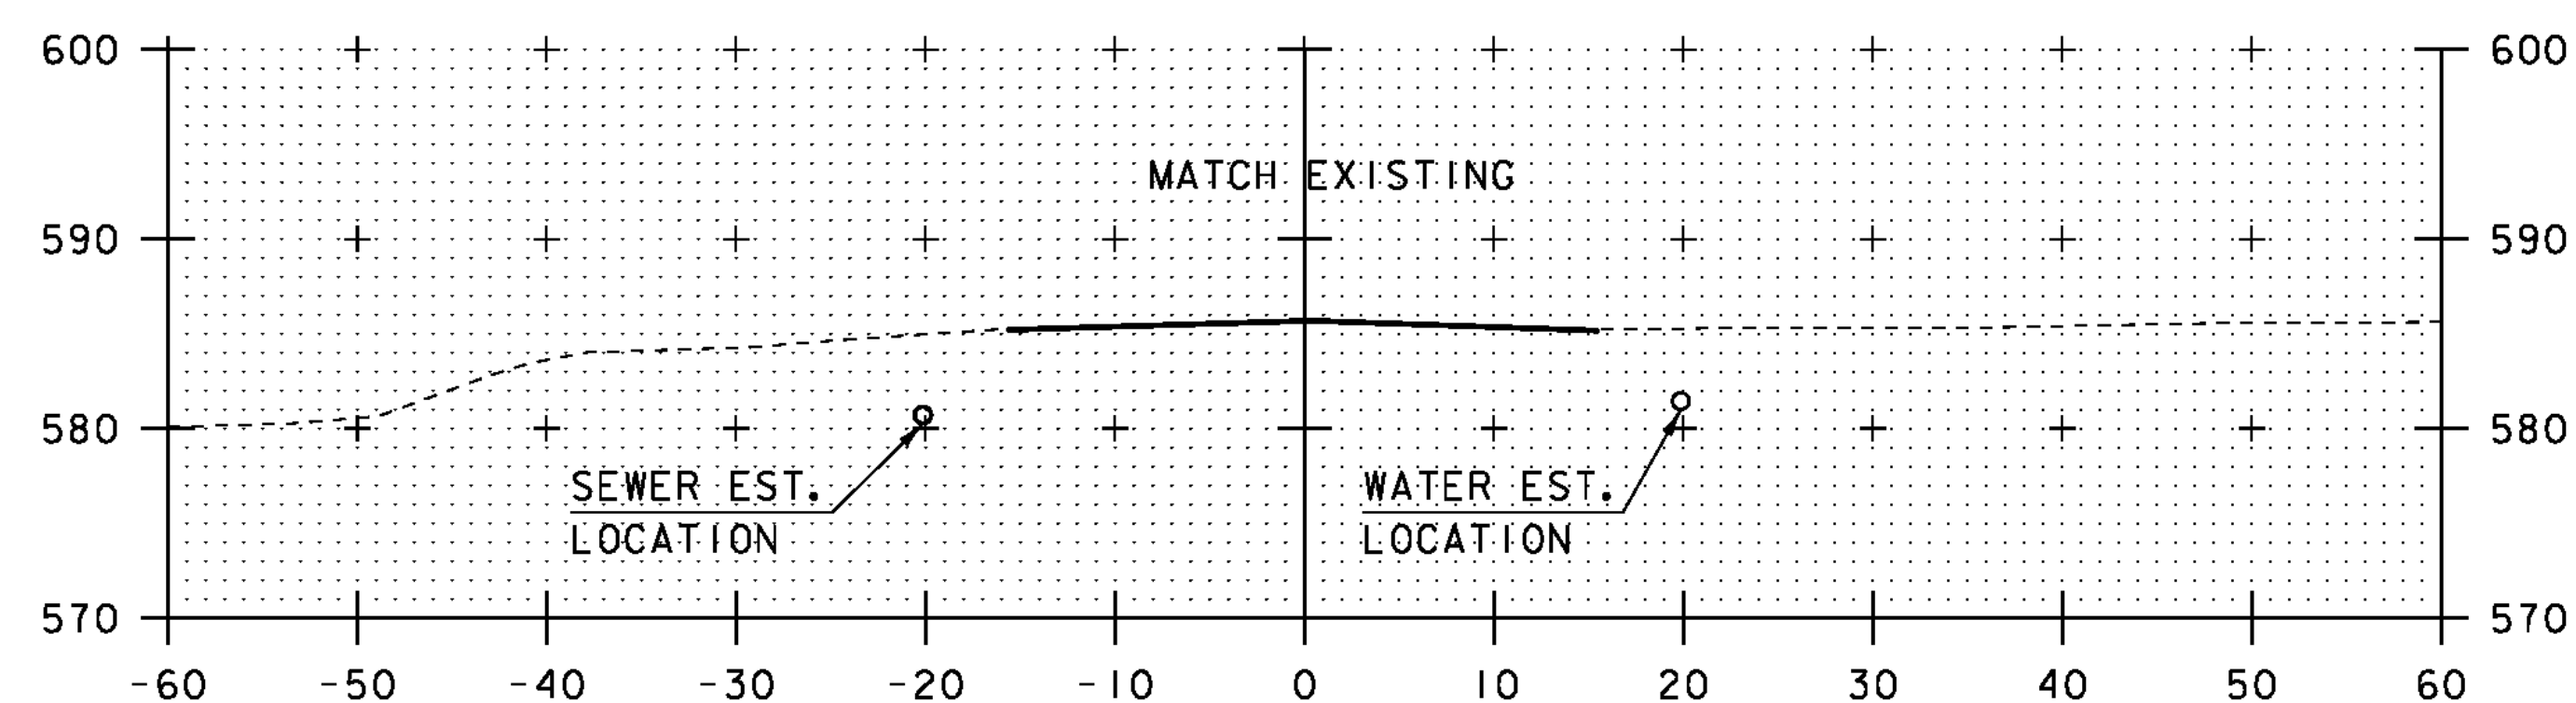

30+75

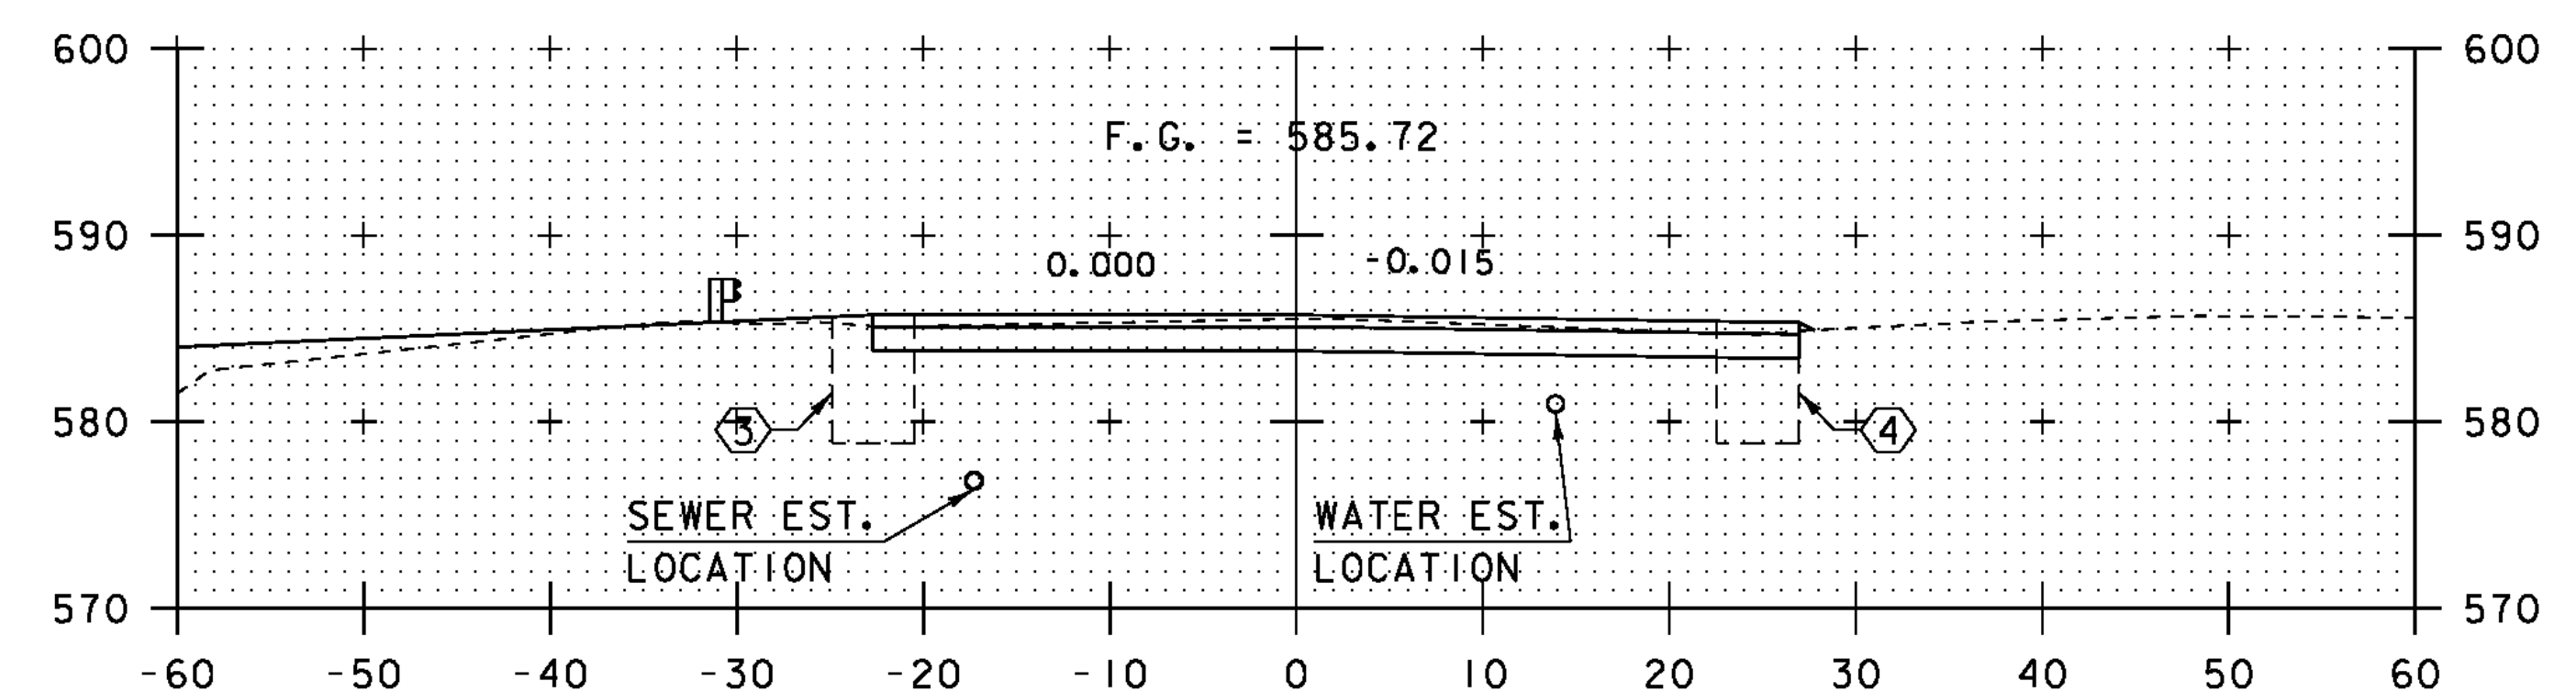

31+50



STA. 30+75 TO STA. 31+92

PROJECT NAME: CHESTER	
PROJECT NUMBER: BRF 025-I(37) SC	
FILE NAME:	PLOT DATE: 20-SEP-2010
PROJECT LEADER: C.P.WILLIAMS	DRAWN BY: D.D.BEARD
DESIGNED BY: R.S.YOUNG	CHECKED BY: R.S.YOUNG
BRIDGE 9 VT RT 11 CROSS SECTIONS	SHEET 118 OF 124