



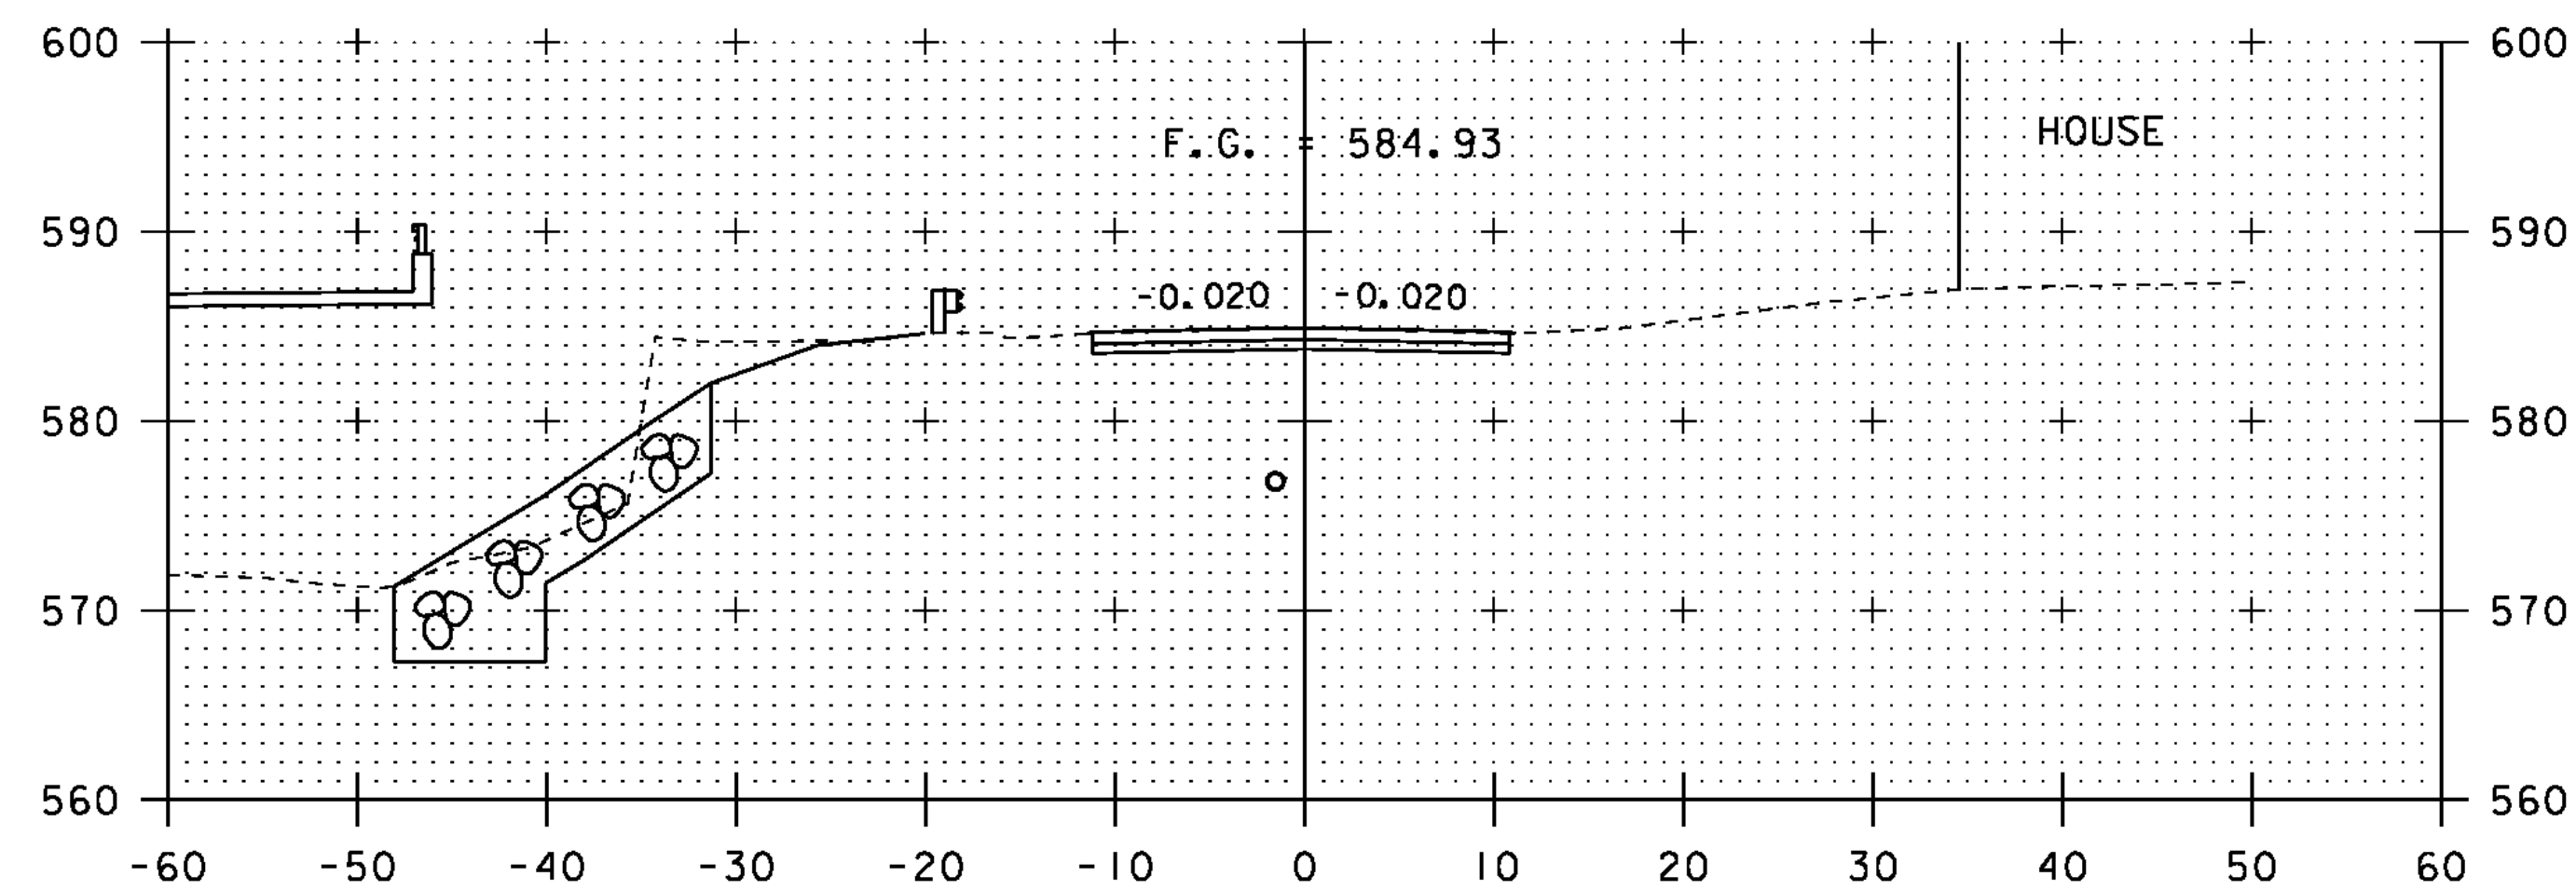


52+50

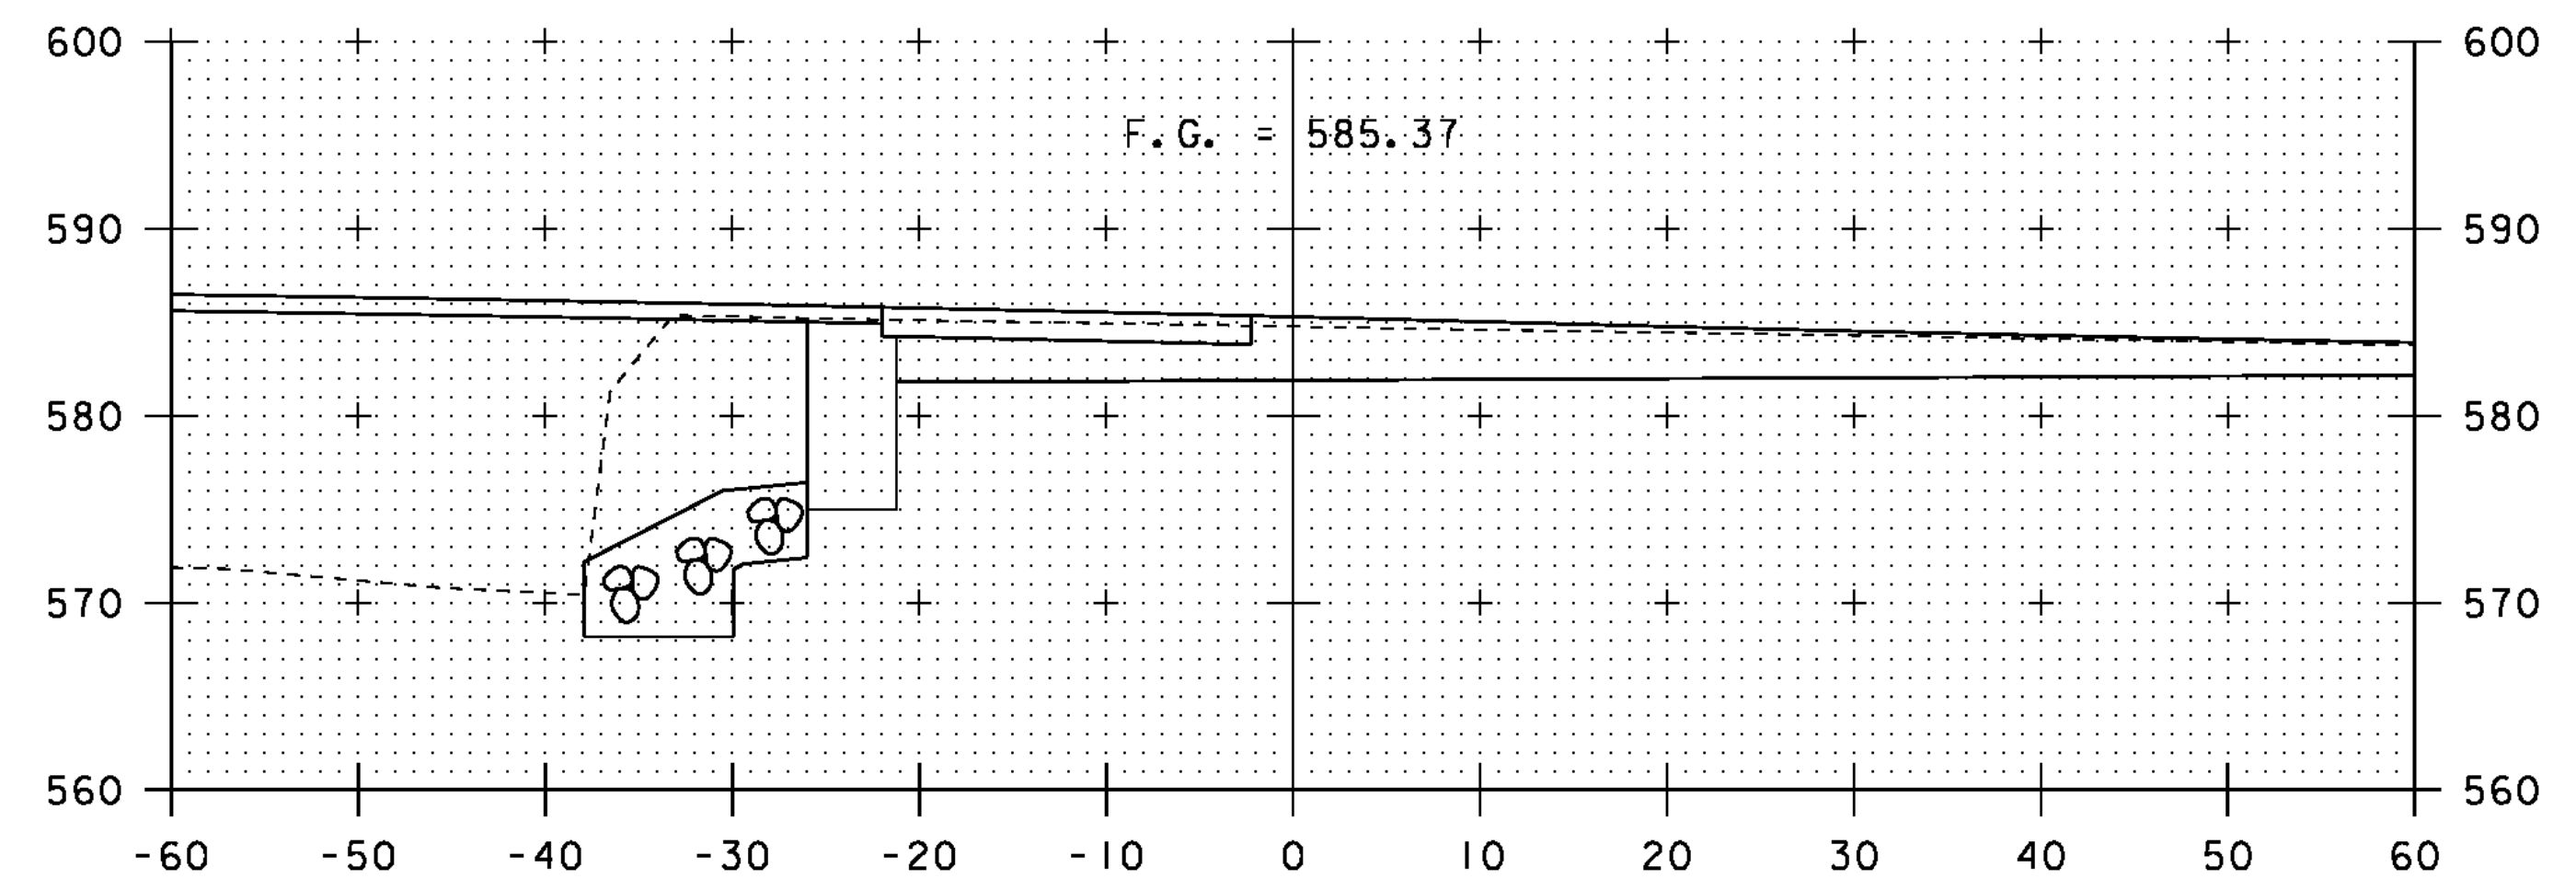


53+23


= STA 14+13.29 @ VT 103

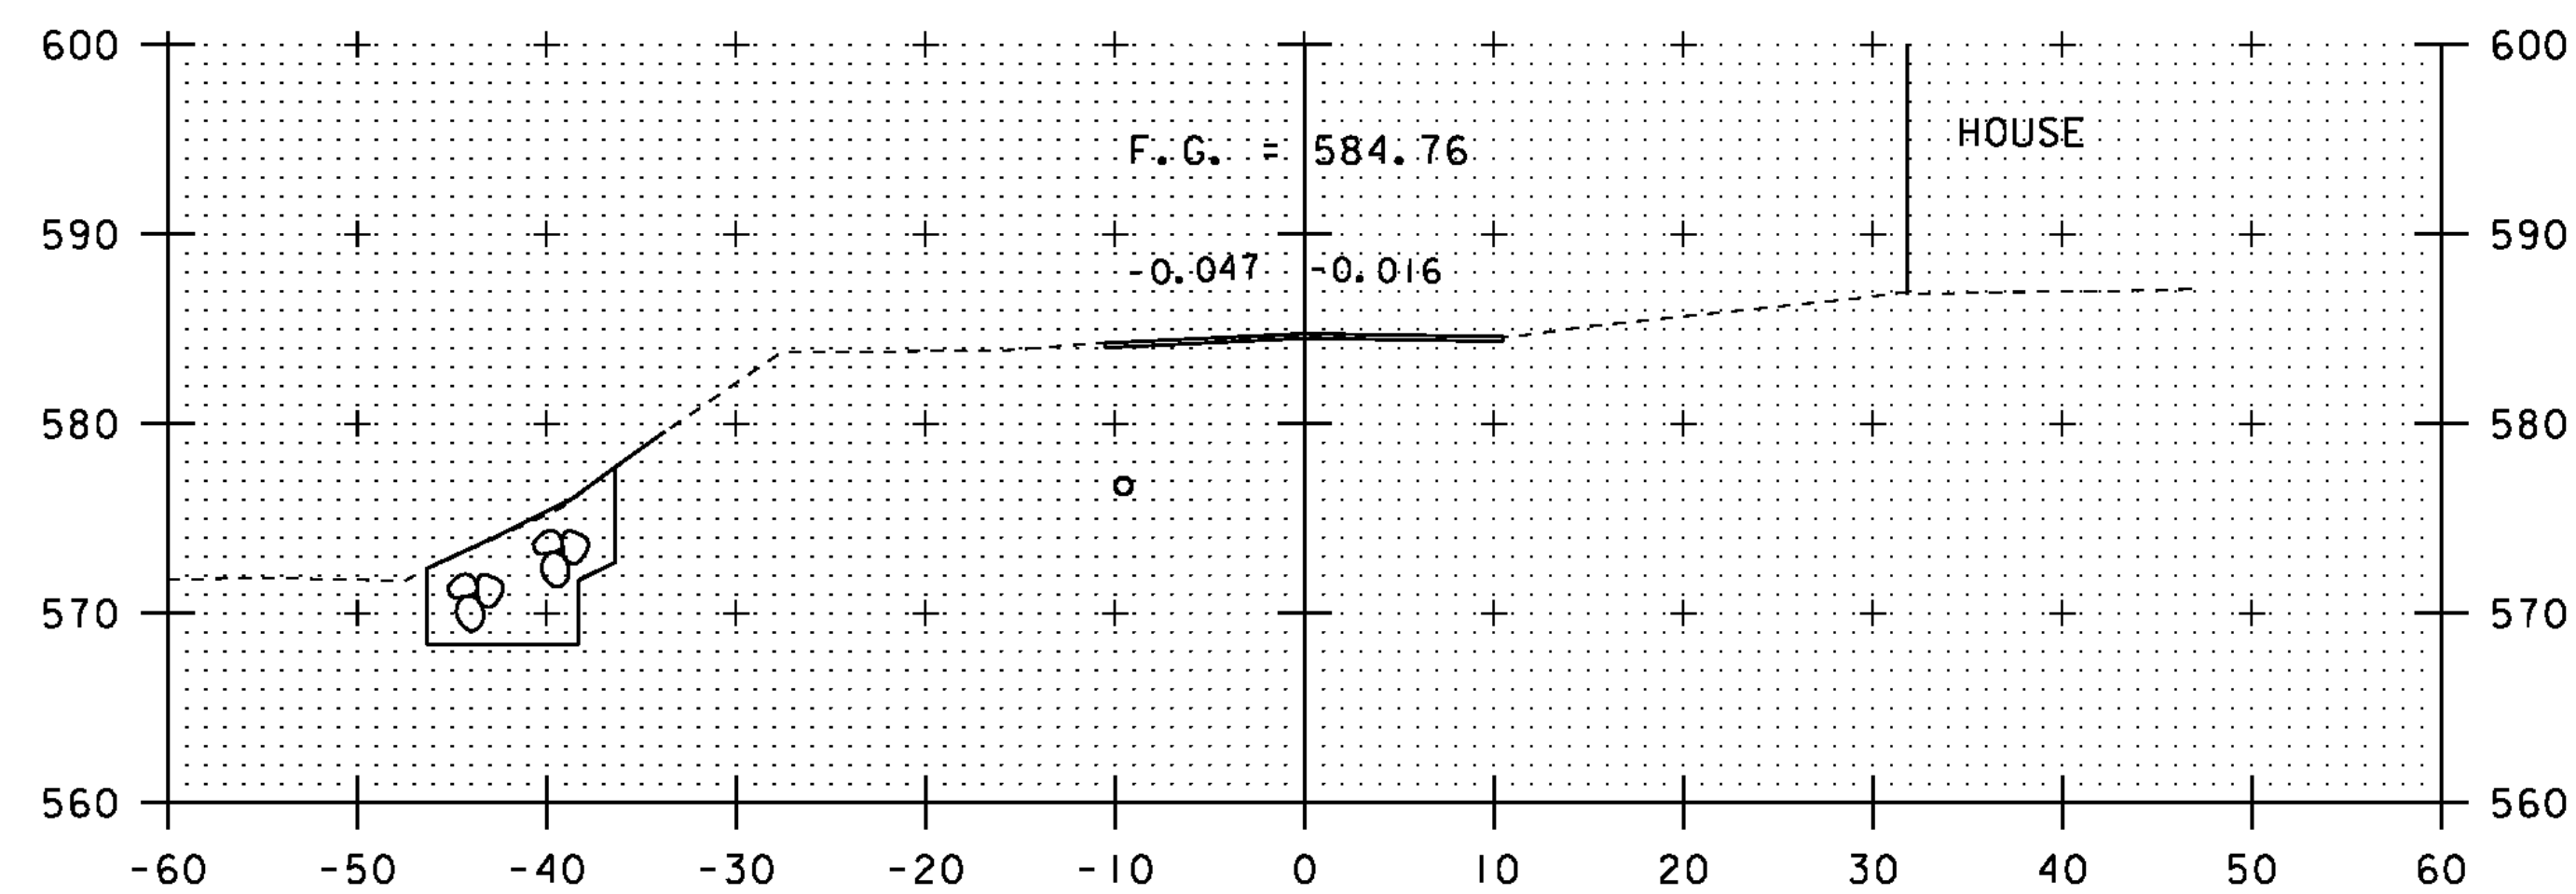


52+25

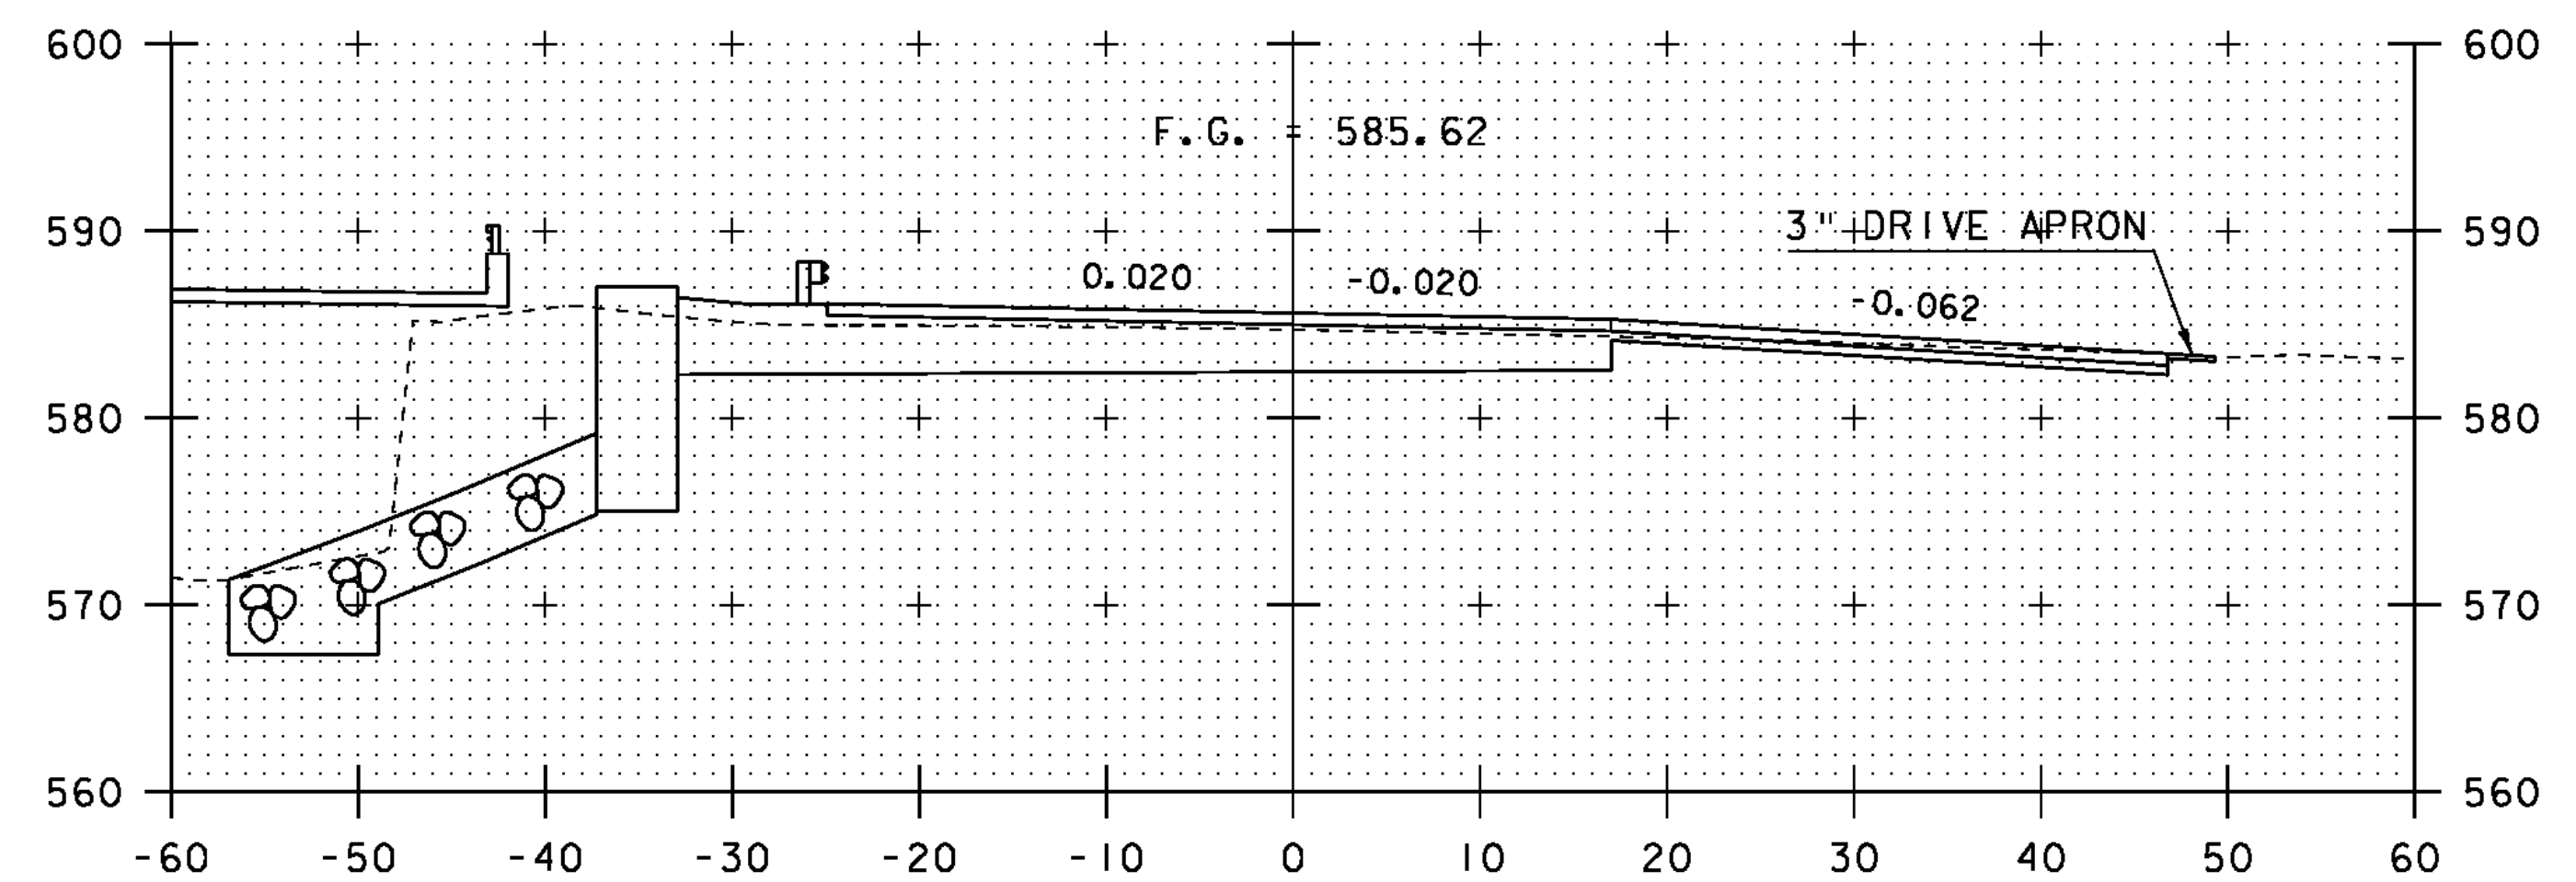

53+00

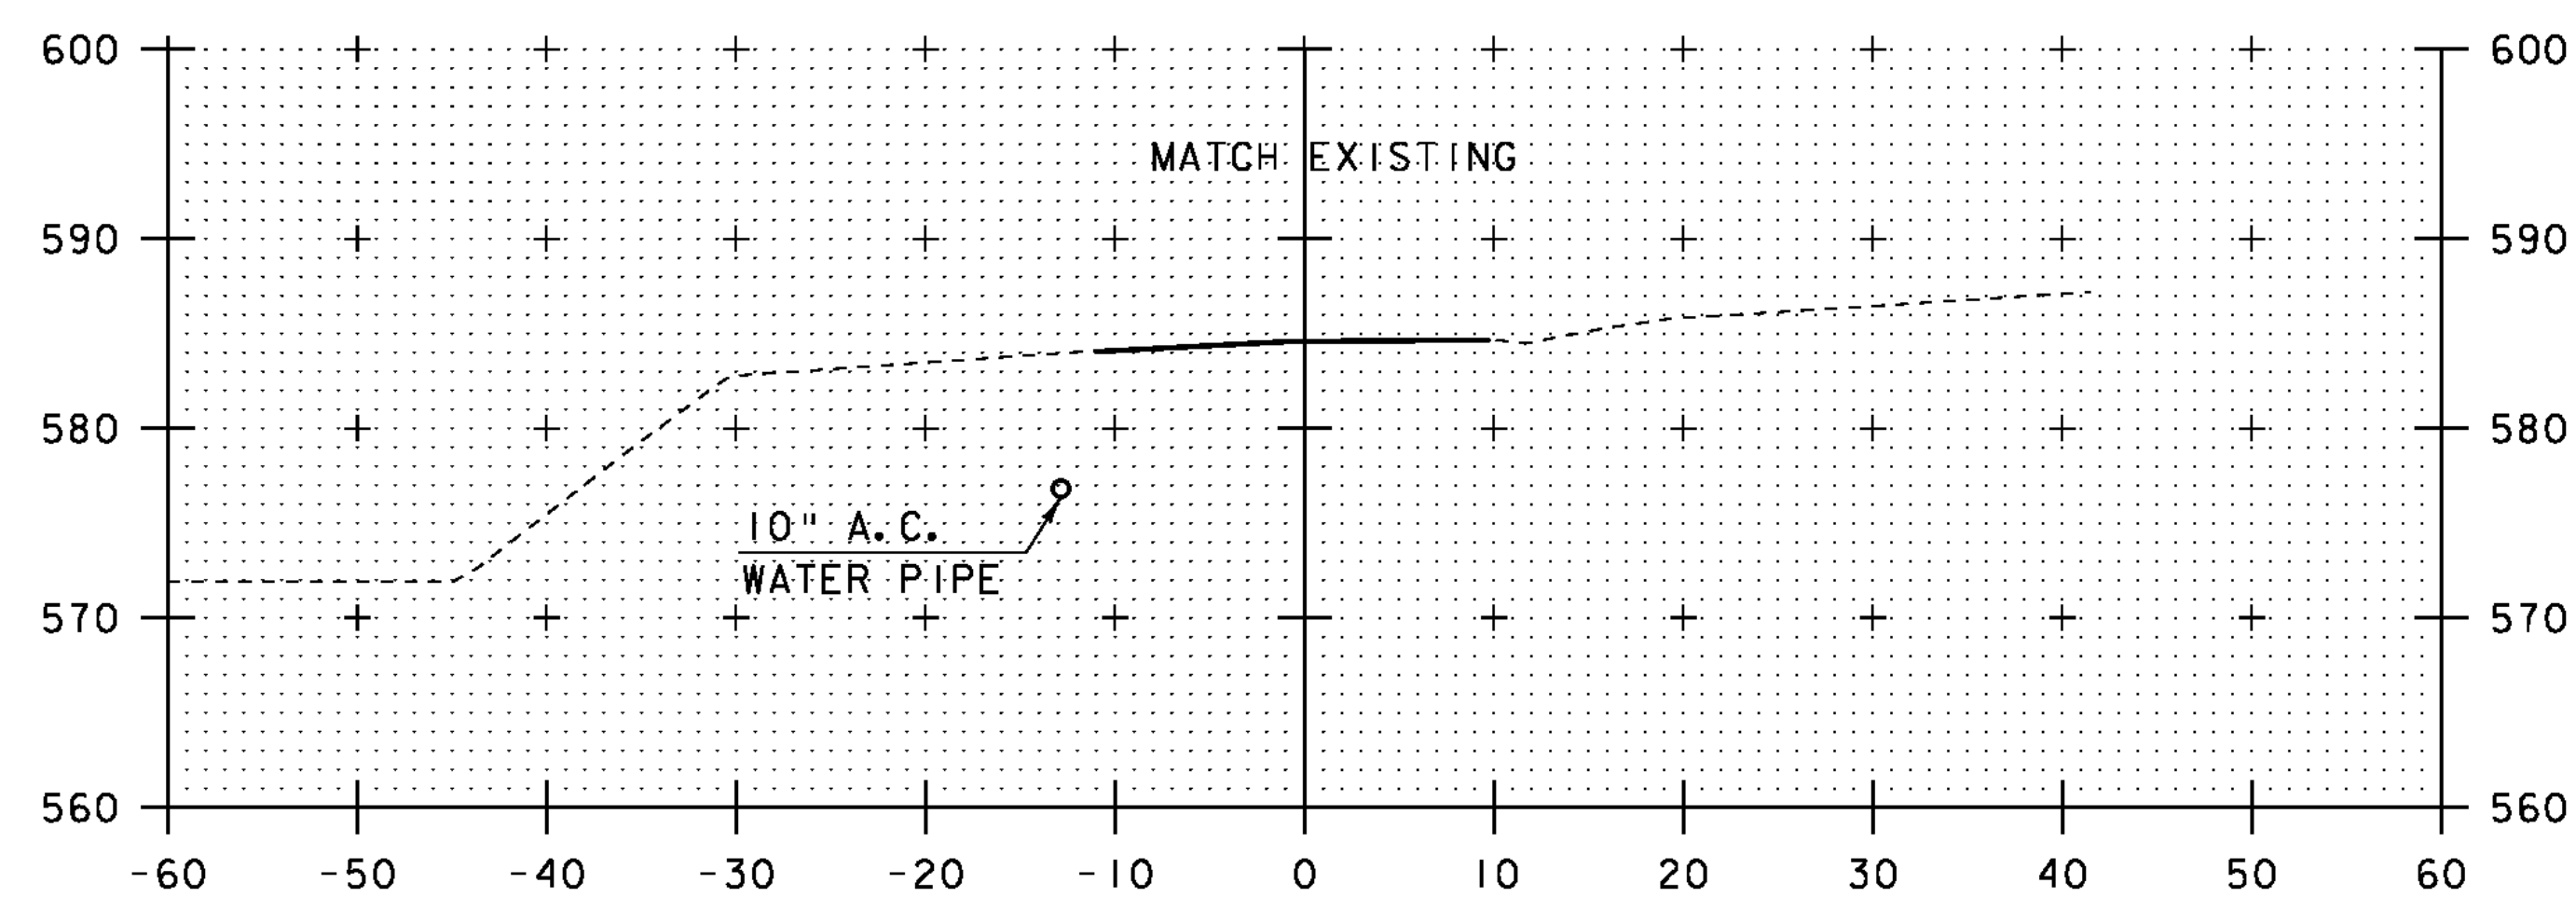

52+00

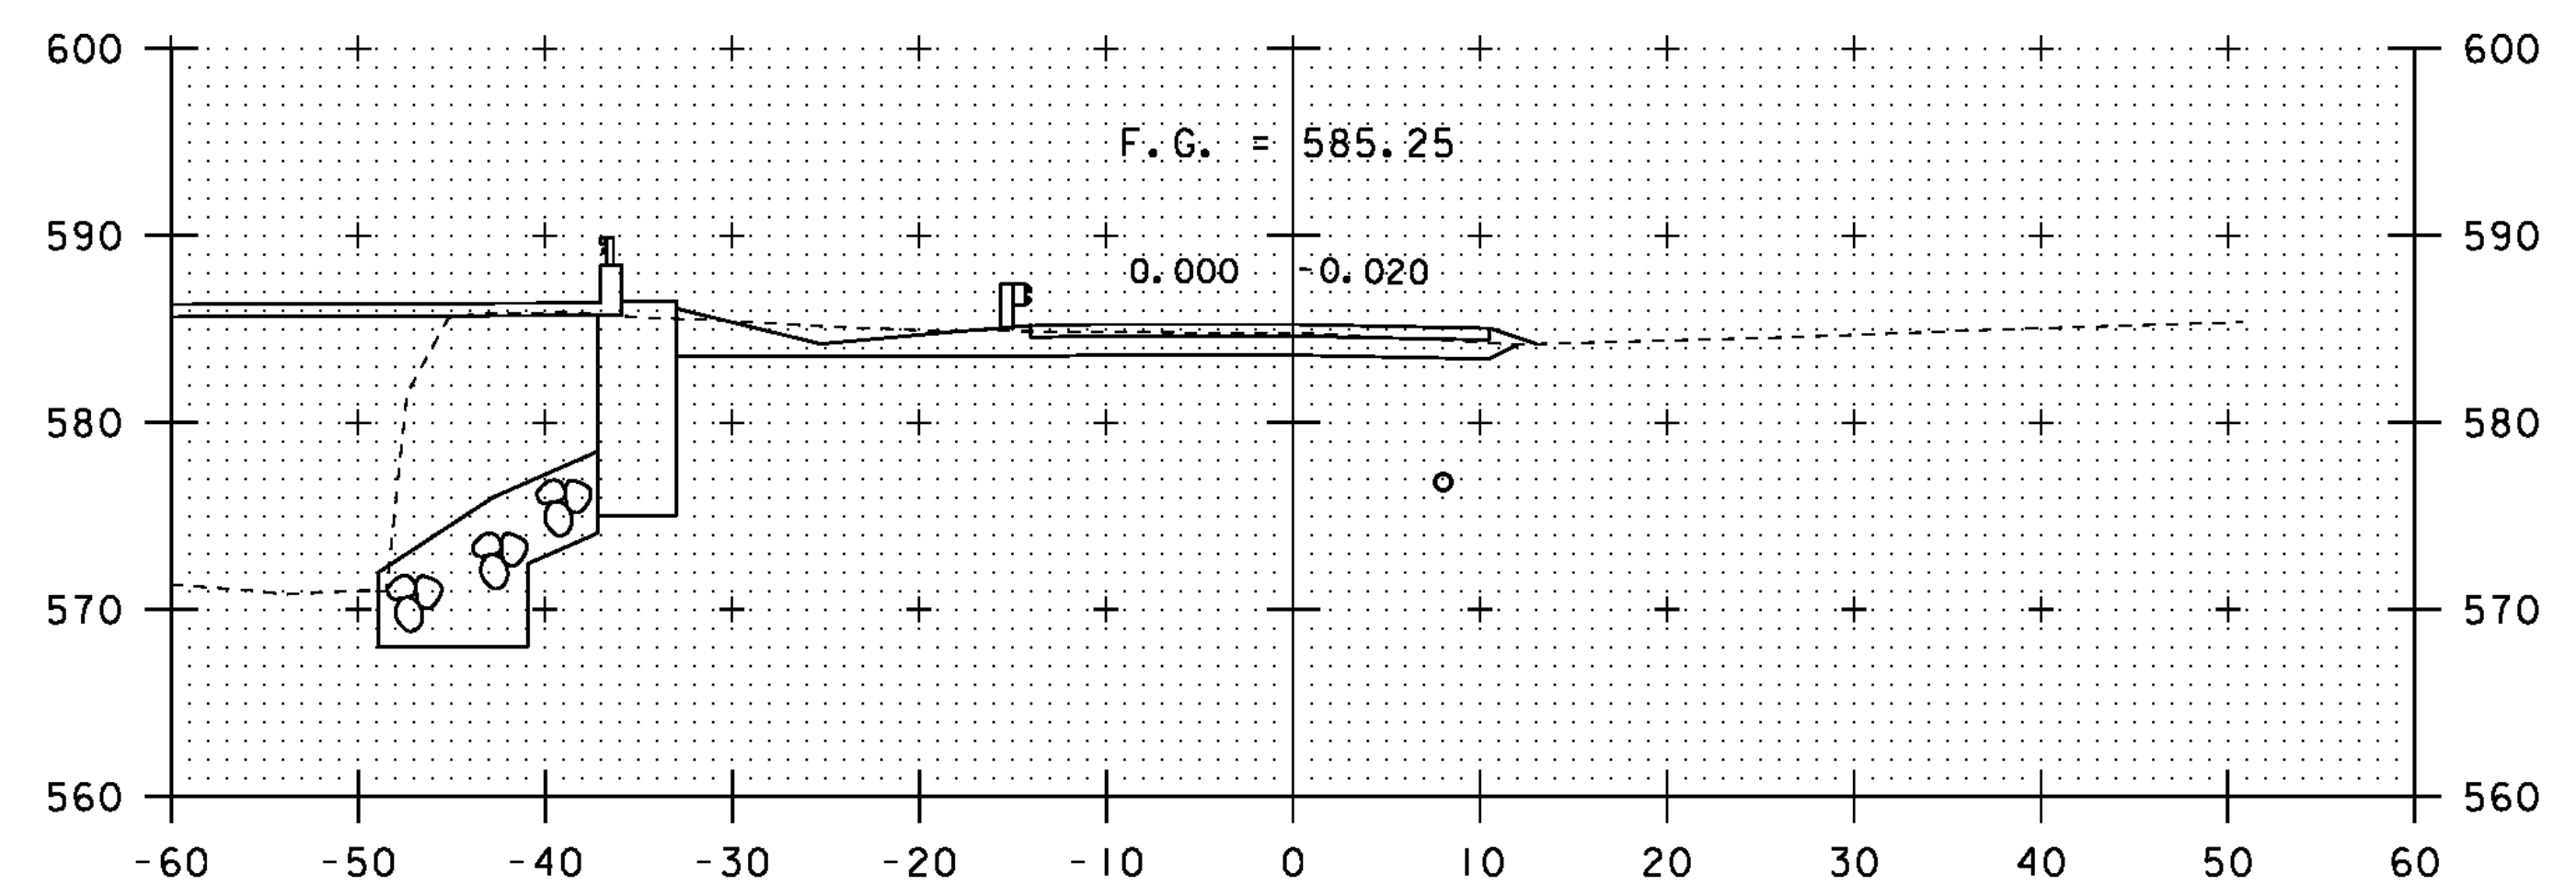

52+75

SCALE 1" = 10'-0"

STA. 52+00 TO STA. 53+23

PROJECT NAME: CHESTER

PROJECT NUMBER: BRF 025-1(37) SC

FILE NAME:

PROJECT LEADER: C.P.WILLIAMS

DESIGNED BY: R.S.YOUNG

BRIDGE 9 TH 72 CROSS SECTIONS

PLOT DATE: 20-SEP-2010

DRAWN BY: D.D.BEARD

CHECKED BY: R.S.YOUNG

SHEET 119 OF 124