



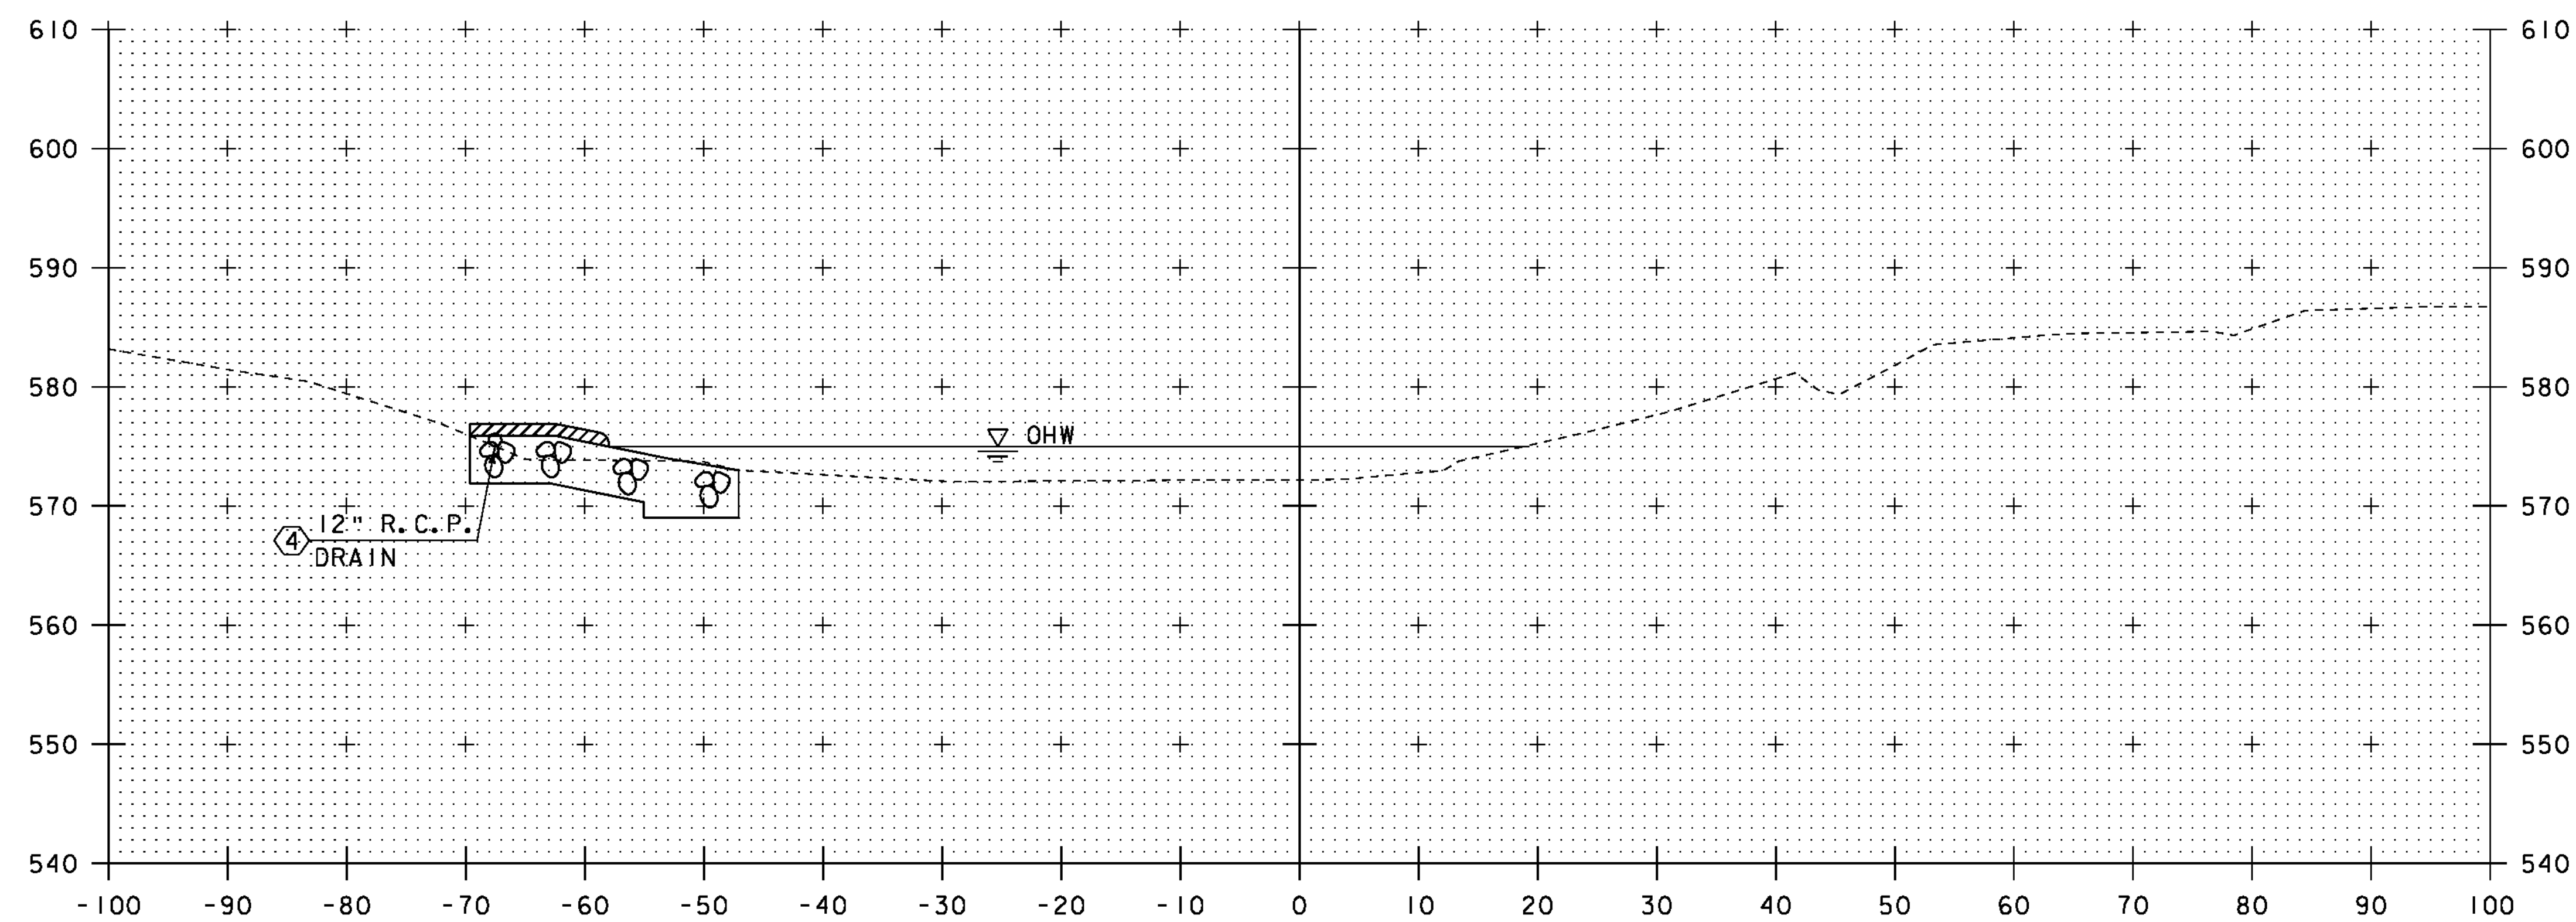

61+25

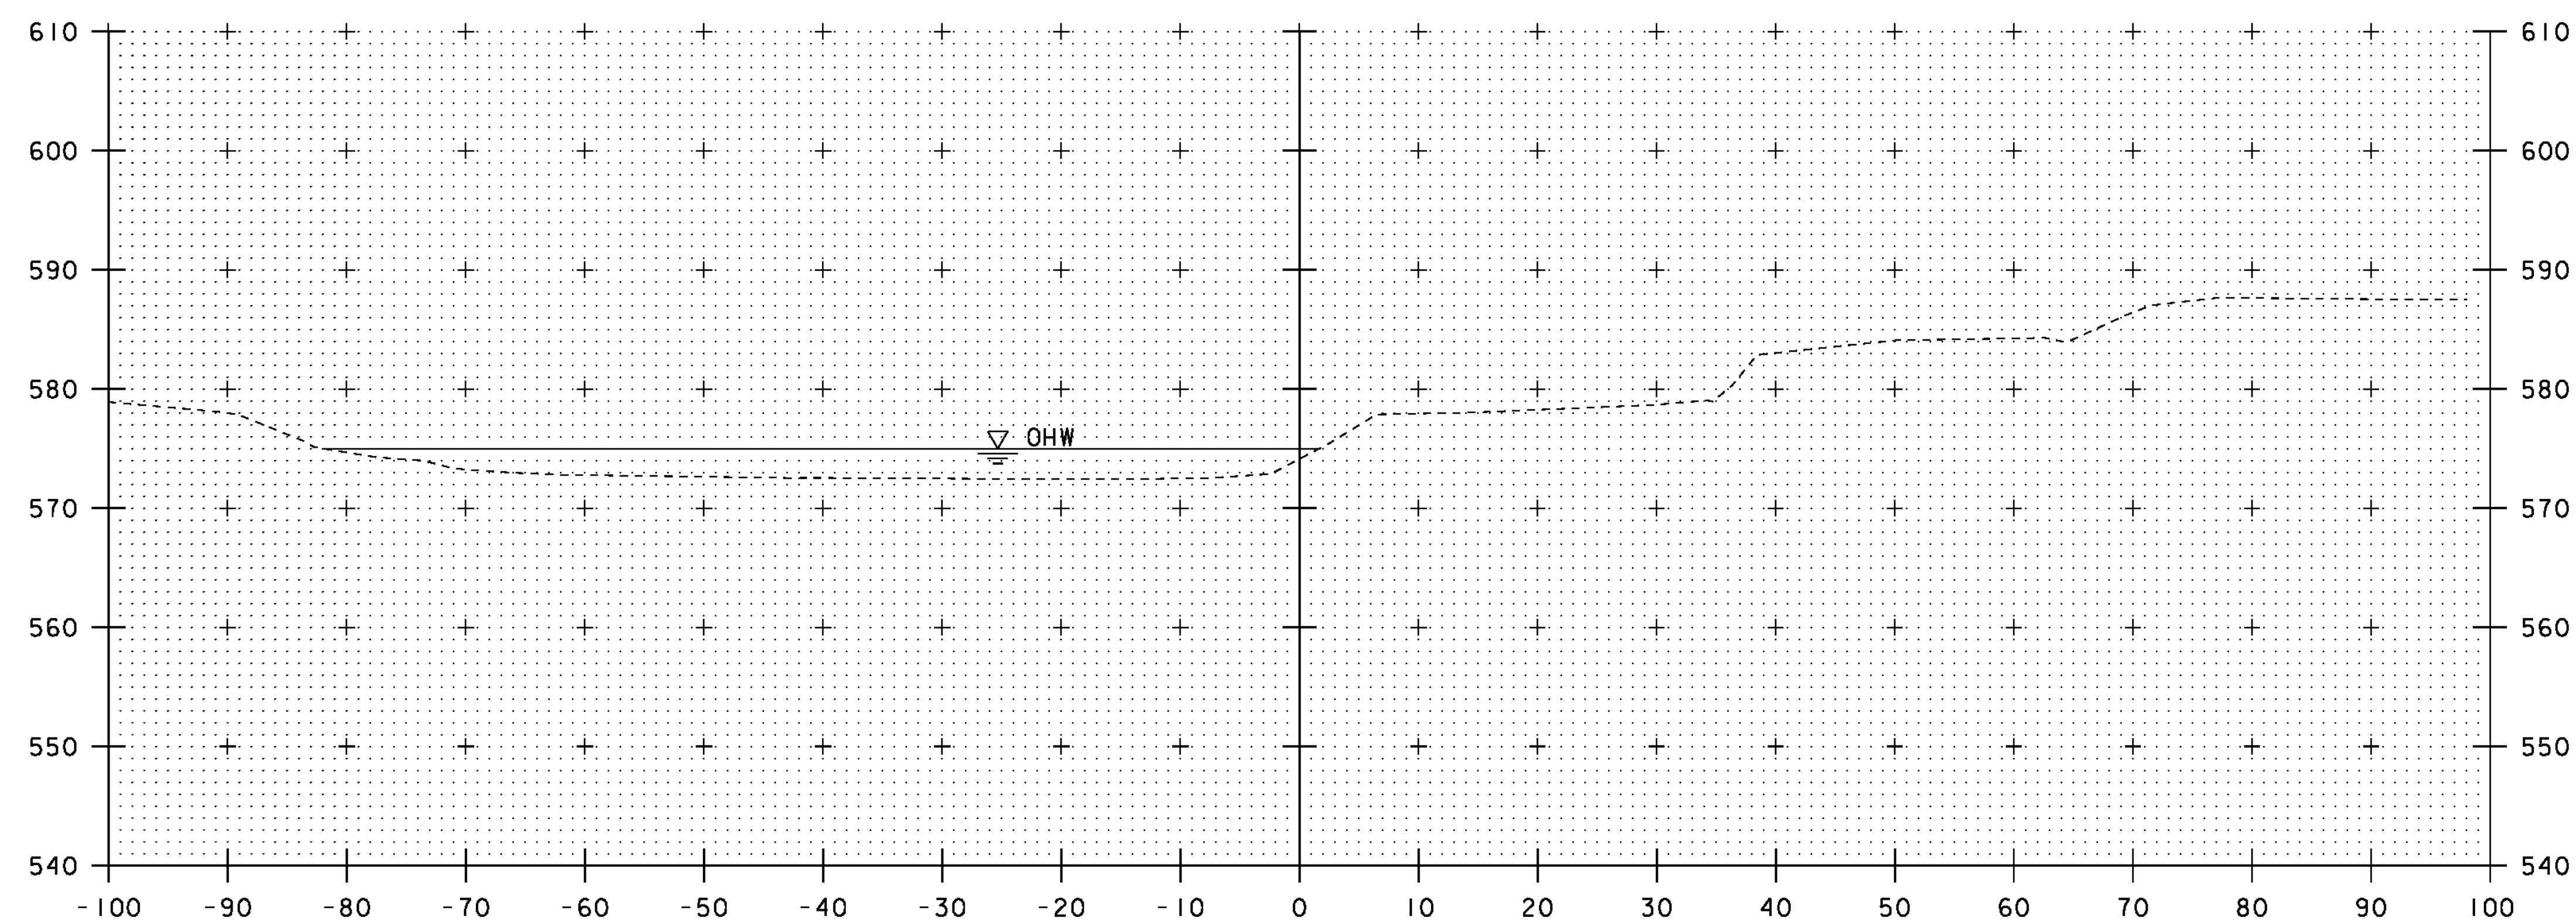

61+00

STA: 61+06.80 LT
BEGIN UNCLASSIFIED CHANNEL EXCAVATION
BEGIN GEOTEXTILE UNDER STONE FILL
BEGIN STONE FILL TYPE IV
BEGIN GRUBBING MATERIAL

SCALE 1" = 10'-0"
10 0 10

STA. 61+00 TO STA. 61+25

PROJECT NAME: CHESTER
PROJECT NUMBER: BR 025-1(37) SC
FILE NAME: s95b168xsl.dgn
PROJECT LEADER: C.P. WILLIAMS
DESIGNED BY: R.S. YOUNG
BRIDGE 9 CHANNEL CROSS SECTIONS

PLOT DATE: 20-SEP-2010
DRAWN BY: D.D. BEARD
CHECKED BY: R.S. YOUNG
SHEET 120 OF 124