



EXISTING ABUTMENT, REMOVE TO
ELEVATION 582.00'. USE ITEM 529.15
"REMOVAL OF STRUCTURE".

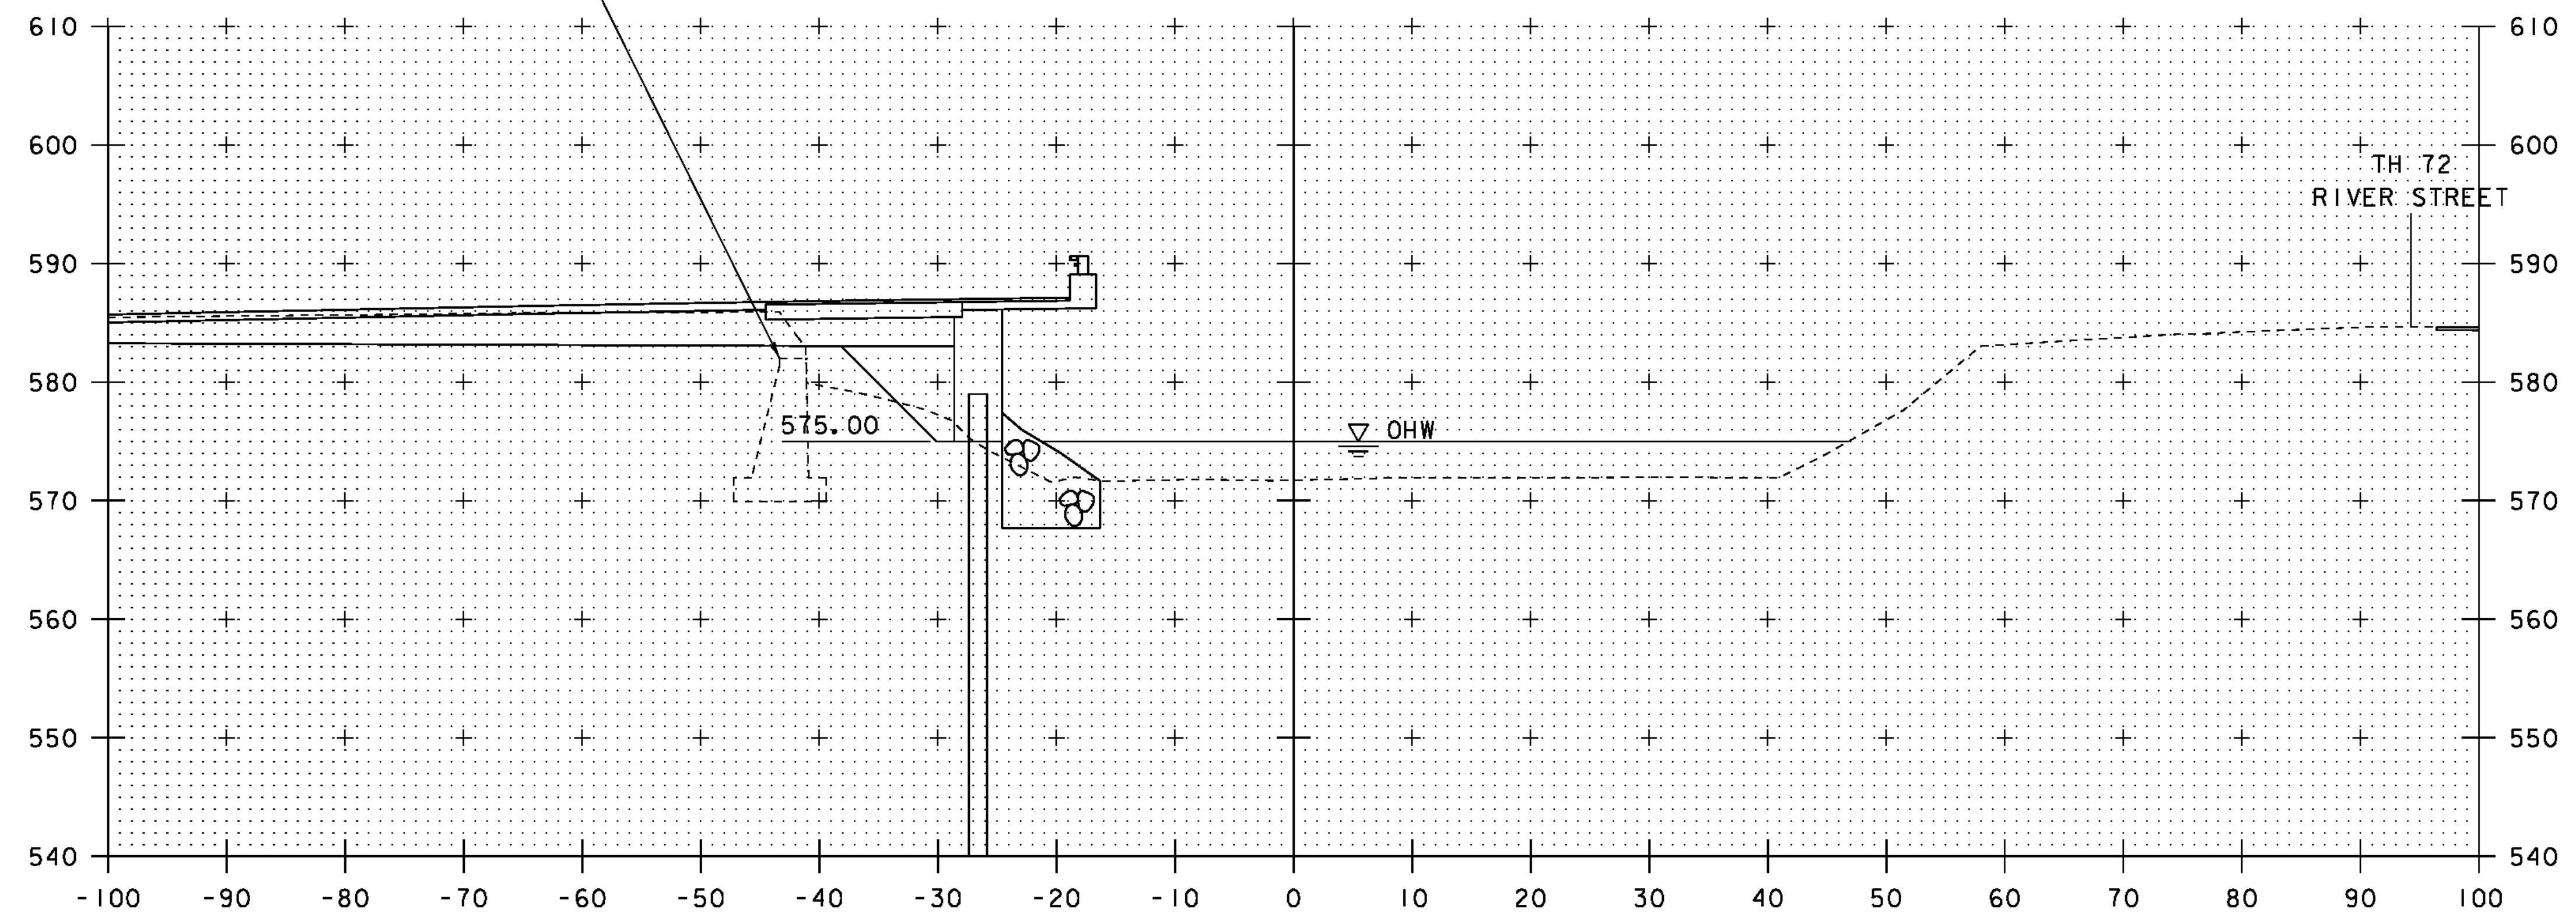

STA: 61+90.50 RT
BEGIN UNCLASSIFIED CHANNEL EXCAVATION
BEGIN GEOTEXTILE UNDER STONE FILL
BEGIN STONE FILL TYPE IV
BEGIN GRUBBING MATERIAL

61+75

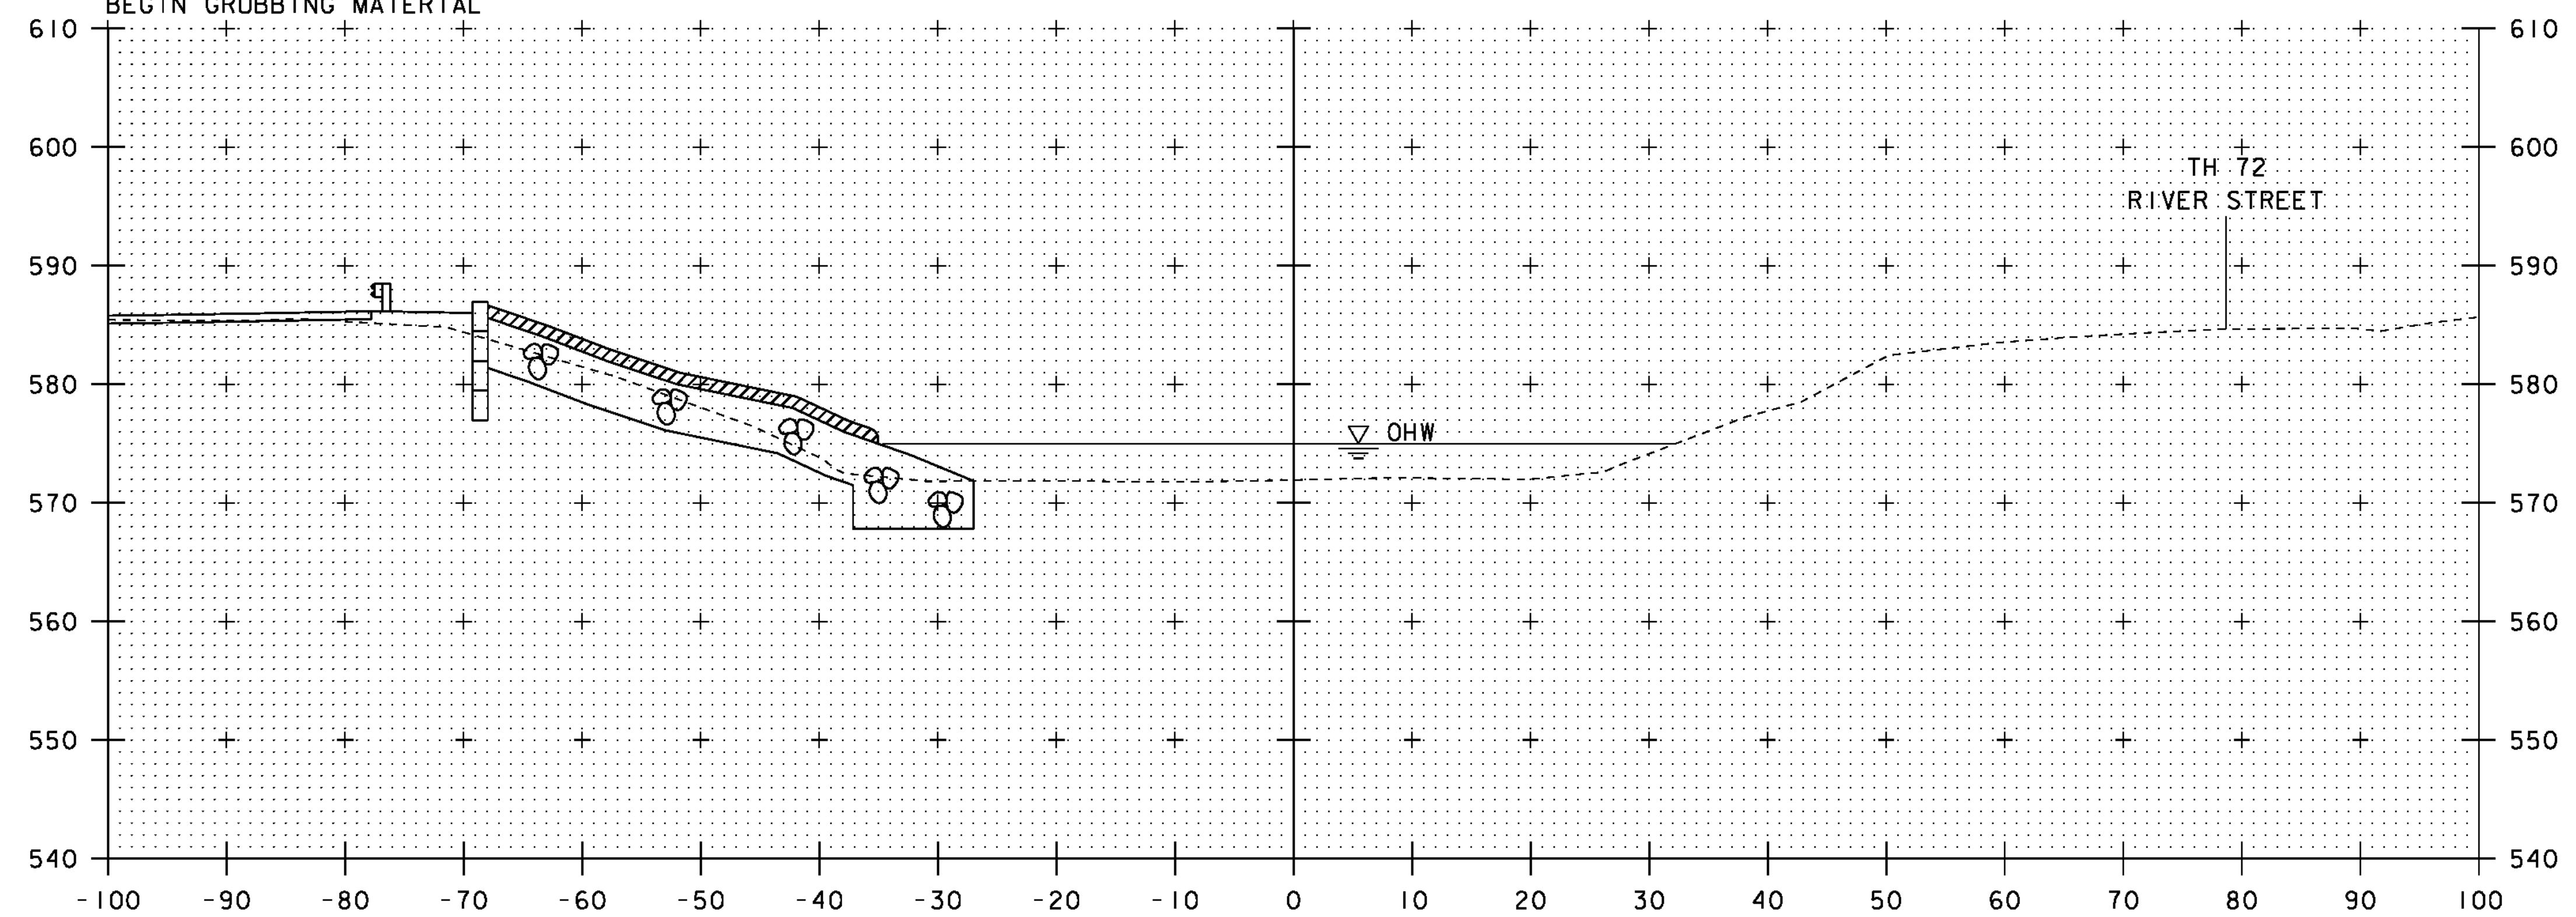

61+50

SCALE 1" = 10'-0"

STA. 61+50 TO STA. 61+75

PROJECT NAME: CHESTER

PROJECT NUMBER: BRF 025-I(37) SC

FILE NAME: s95b168xs2.dgn

PROJECT LEADER: C.P. WILLIAMS

DESIGNED BY: R.S. YOUNG

BRIDGE 9 CHANNEL CROSS SECTIONS

PLOT DATE: 20-SEP-2010

DRAWN BY: D.D. BEARD

CHECKED BY: R.S. YOUNG

SHEET 121 OF 124