





62+75

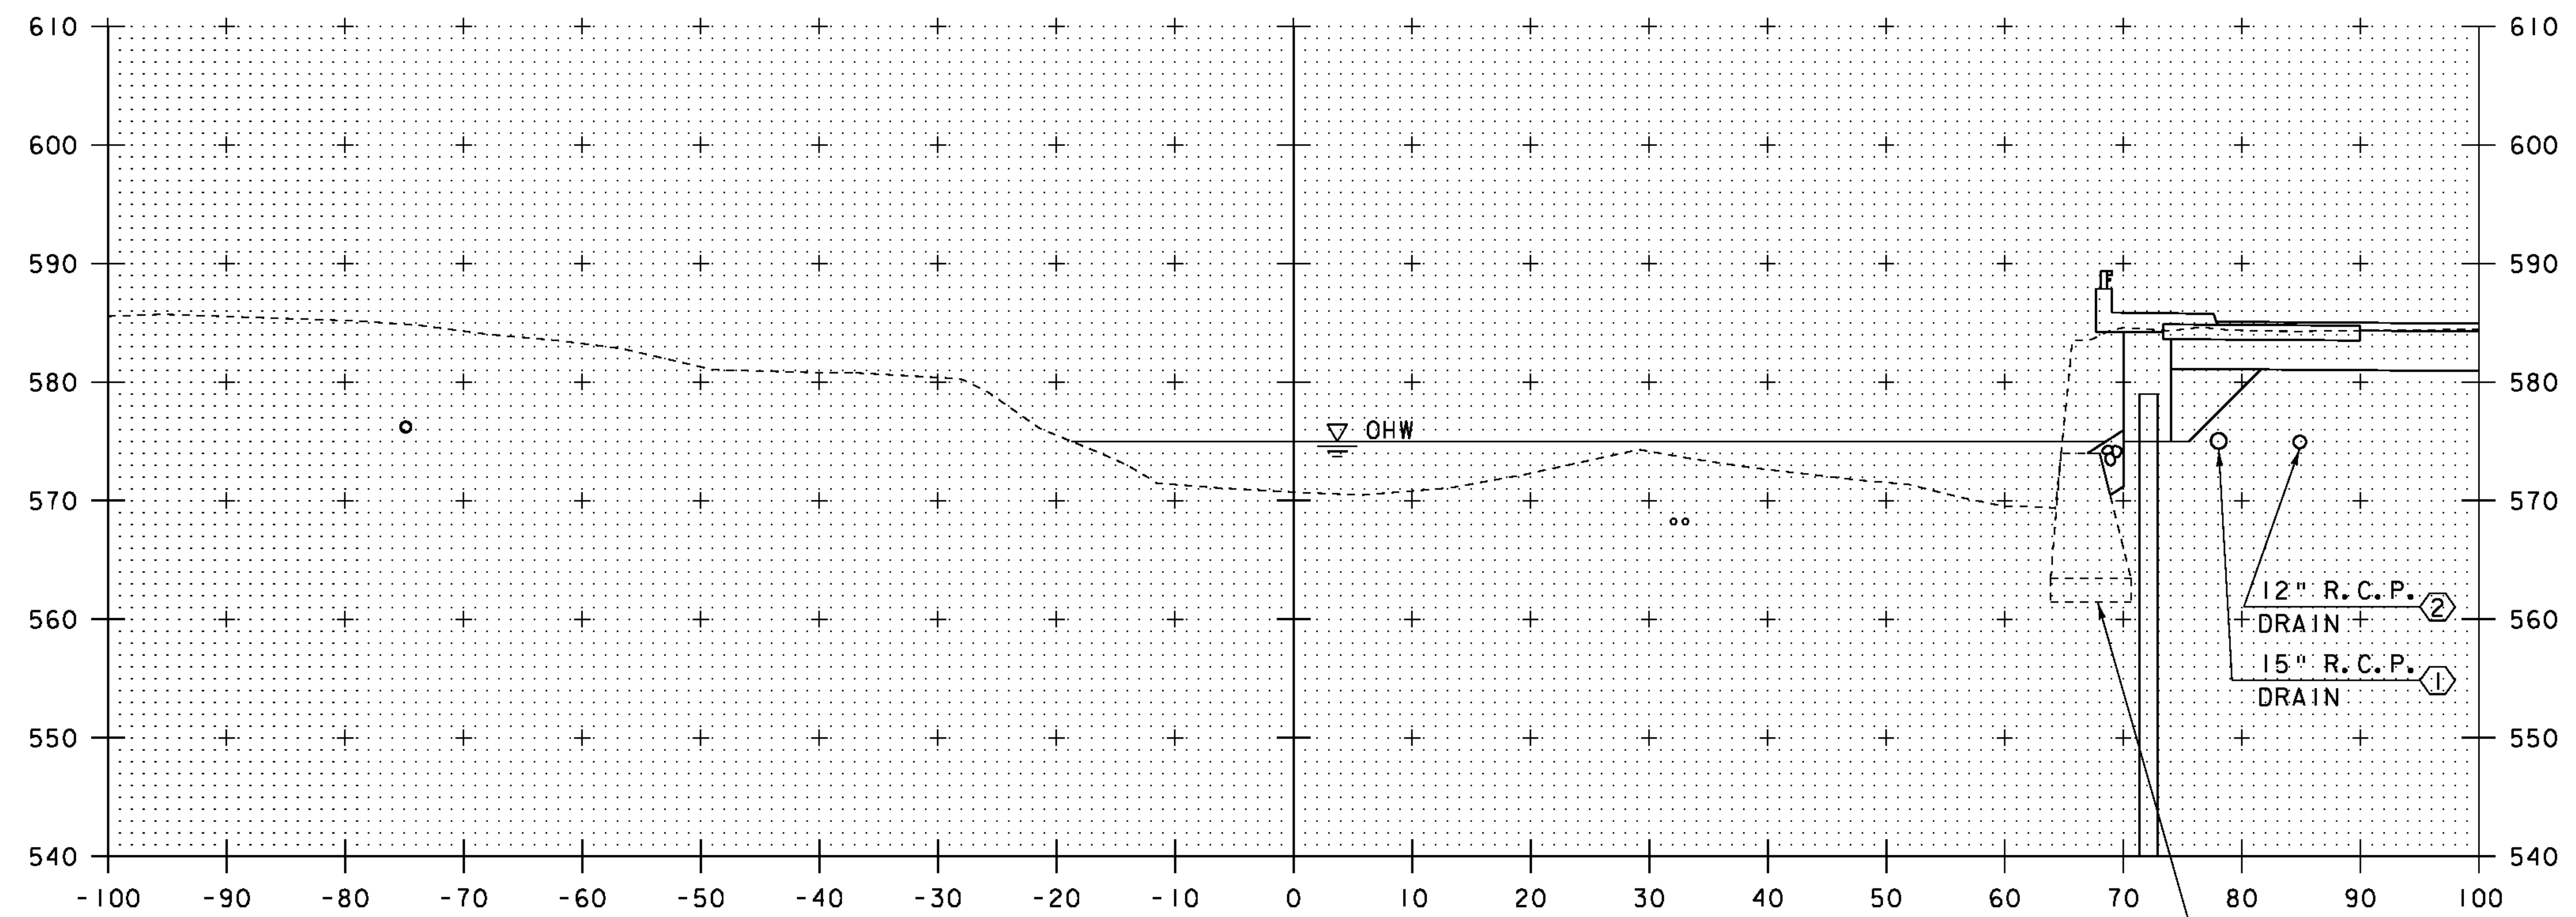

62+50

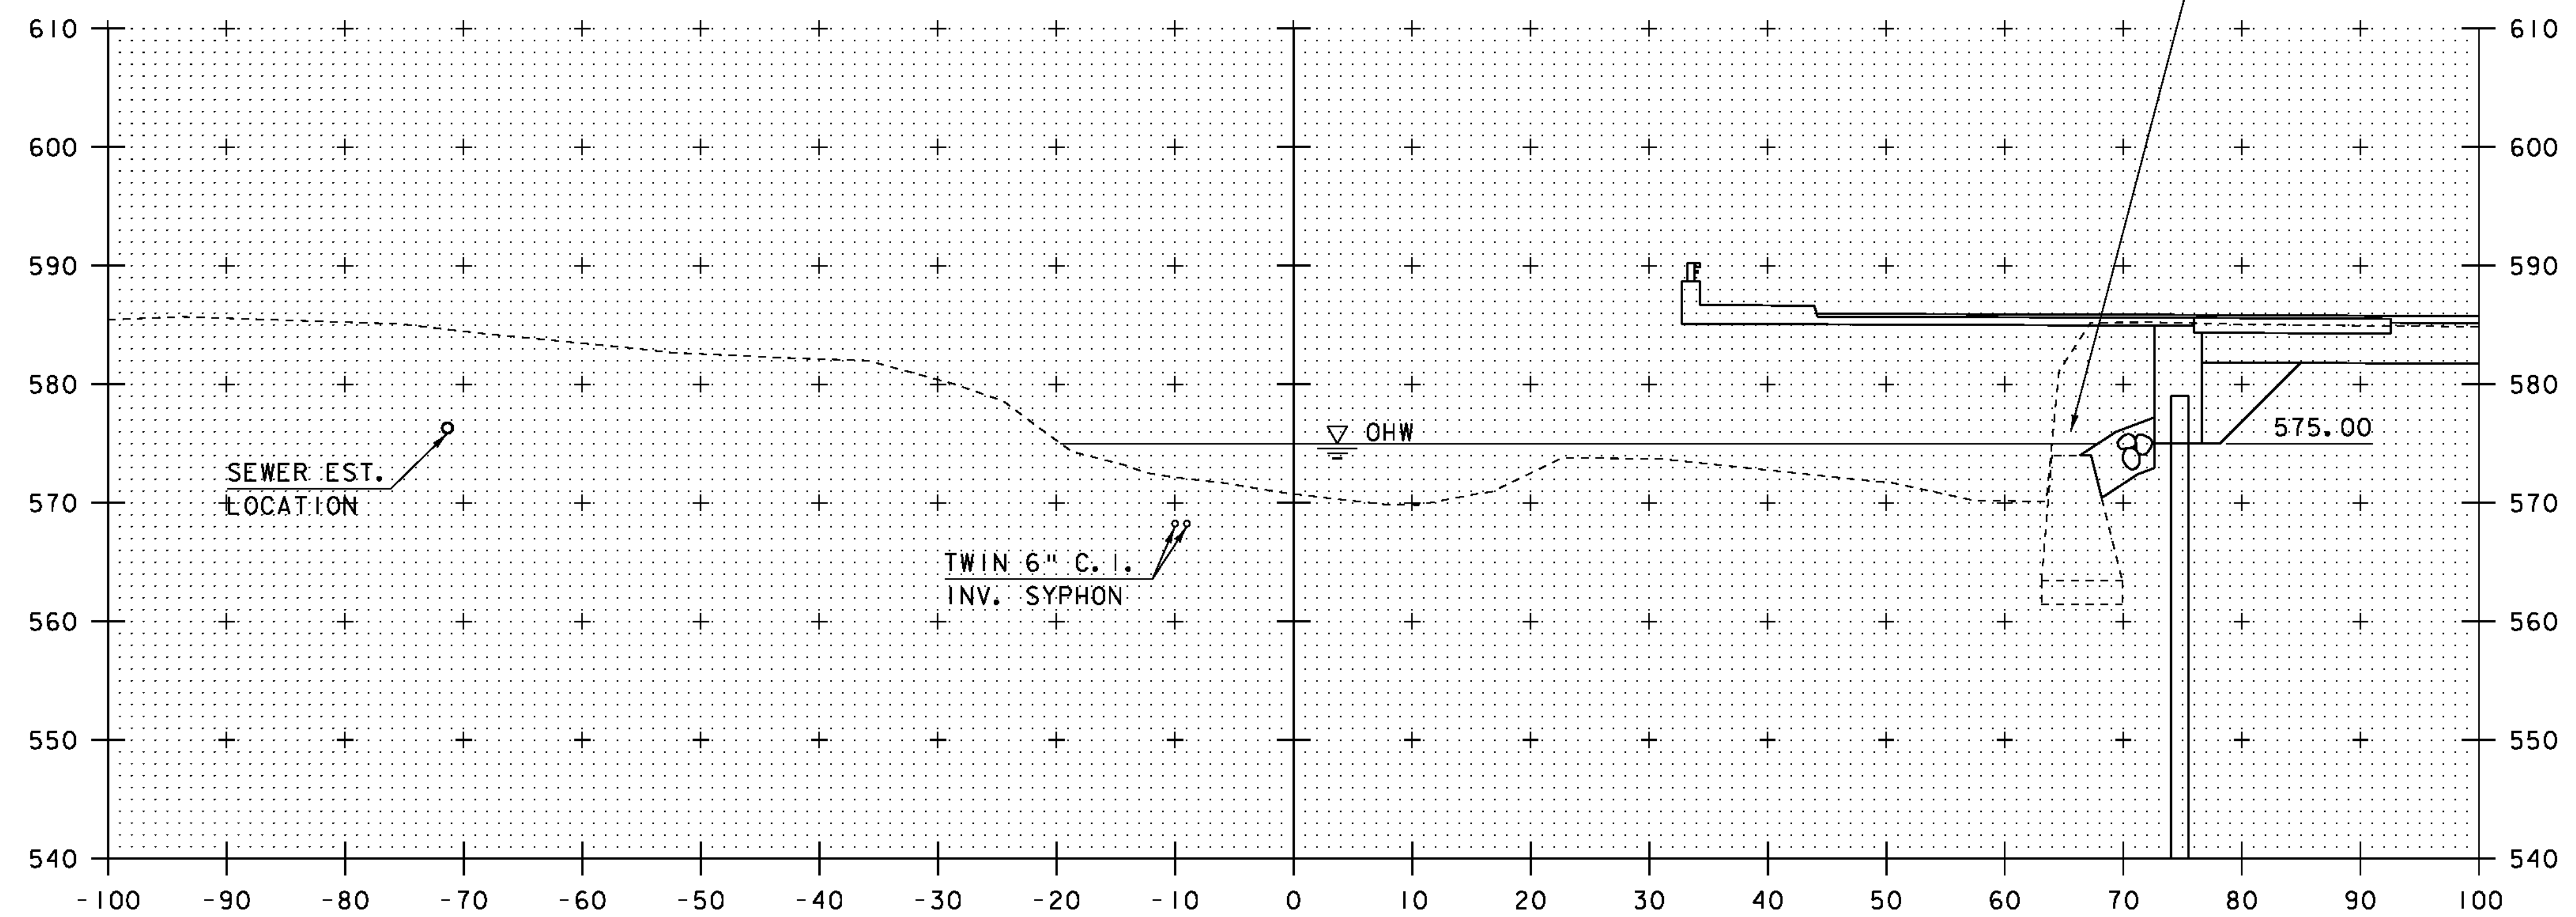

STA. 62+50 TO STA. 62+75

|                                  |                        |
|----------------------------------|------------------------|
| PROJECT NAME: CHESTER            |                        |
| PROJECT NUMBER: BRF 025-I(37) SC |                        |
| FILE NAME: s95b168xs4.dgn        | PLOT DATE: 20-SEP-2010 |
| PROJECT LEADER: C.P.WILLIAMS     | DRAWN BY: D.D.BEARD    |
| DESIGNED BY: R.S.YOUNG           | CHECKED BY: R.S.YOUNG  |
| BRIDGE 9 CHANNEL CROSS SECTIONS  | SHEET 123 OF 124       |