


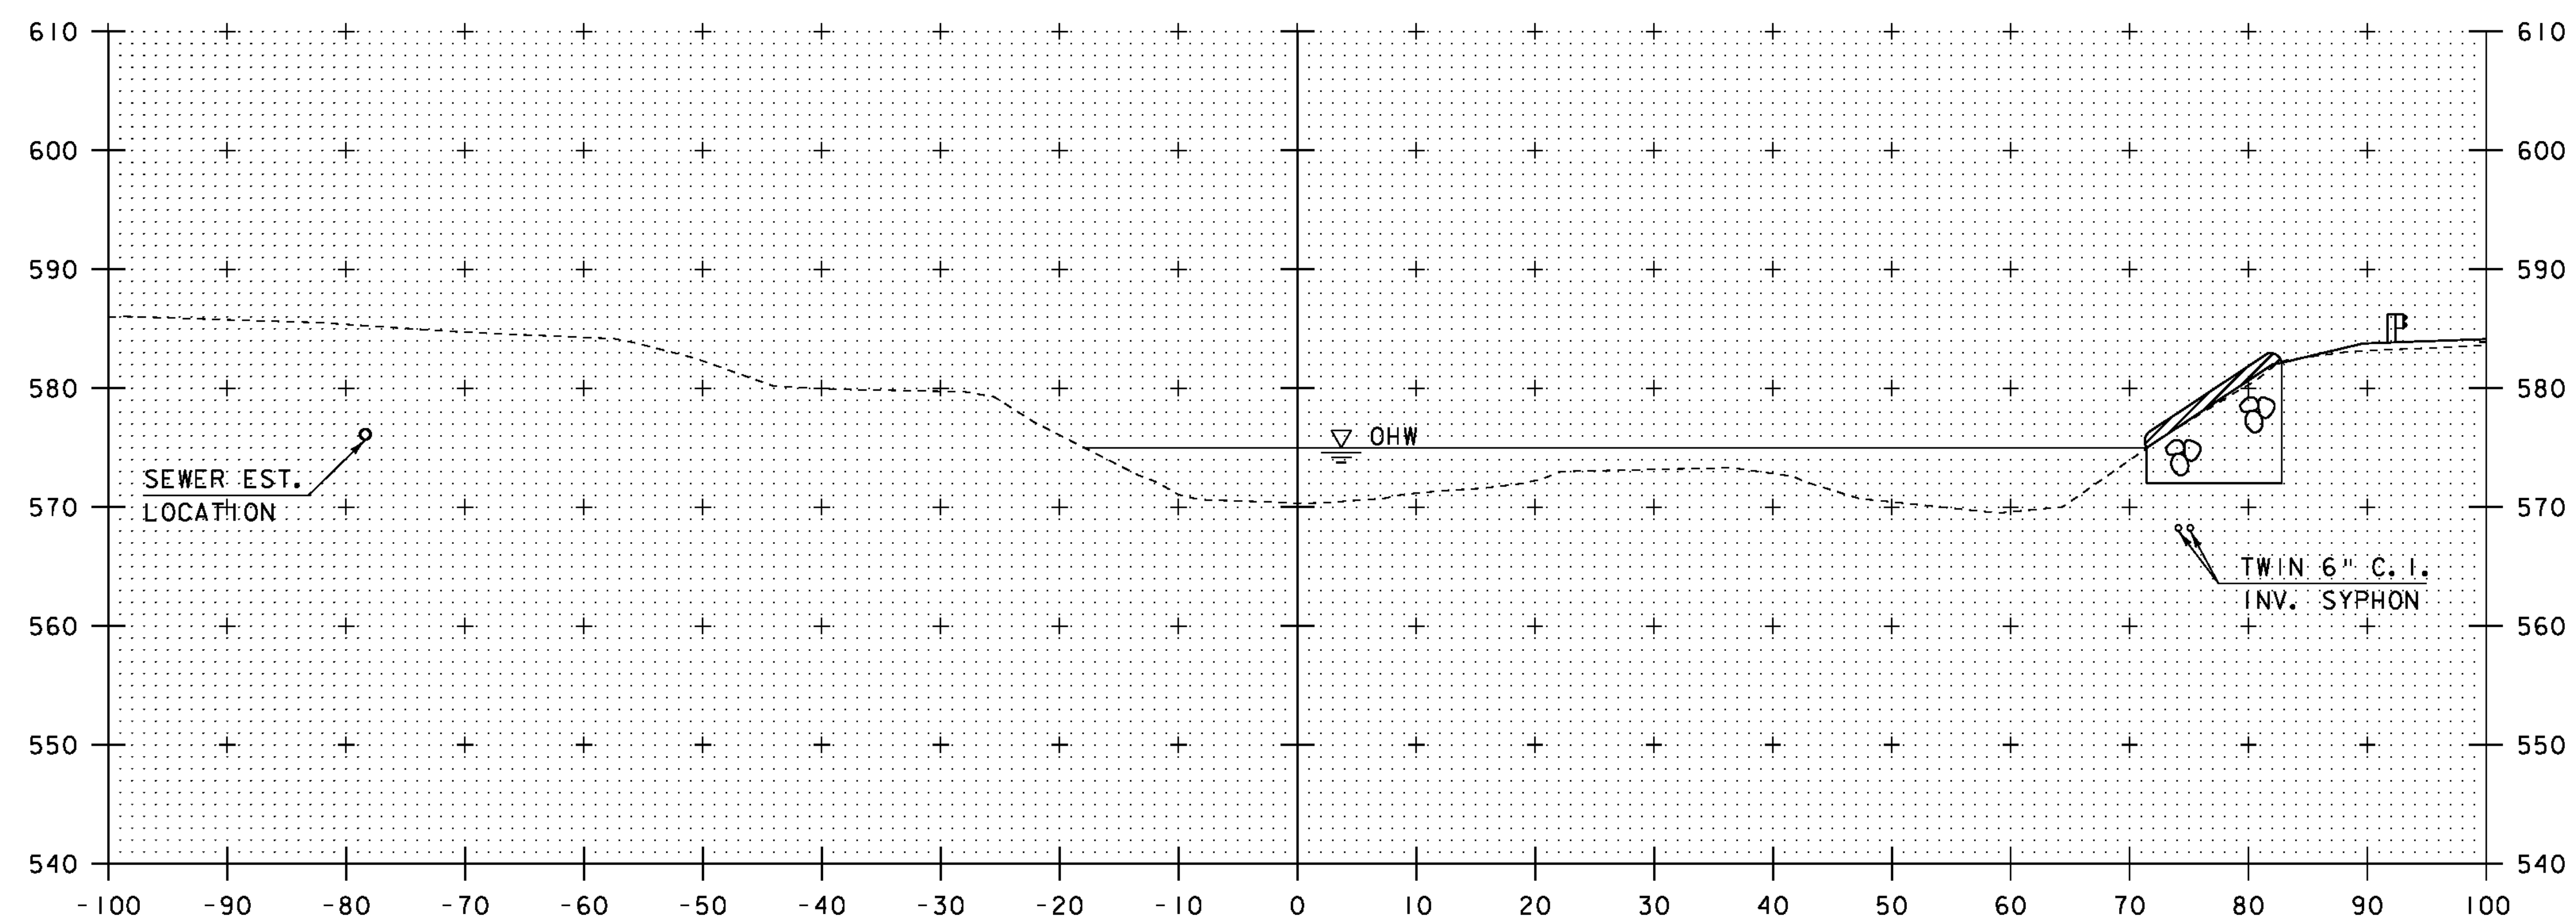

STA: 63+03.10 RT
END UNCLASSIFIED CHANNEL EXCAVATION
END GEOTEXTILE UNDER STONE FILL
END STONE FILL, TYPE IV
END GRUBBING MATERIAL

63+00

SCALE 1" = 10'-0"
10 0 10

STA. 63+00 TO STA. 63+00

PROJECT NAME: CHESTER	
PROJECT NUMBER: BRF 025-(K37) SC	
FILE NAME: s95b168xs5.dgn	PLOT DATE: 20-SEP-2010
PROJECT LEADER: C.P.WILLIAMS	DRAWN BY: D.D.BEARD
DESIGNED BY: R.S.YOUNG	CHECKED BY: R.S.YOUNG
BRIDGE 9 CHANNEL CROSS SECTIONS	SHEET 124 OF 124