


EXCAVATIONS & REMOVALS  
(NOT TO SCALE)

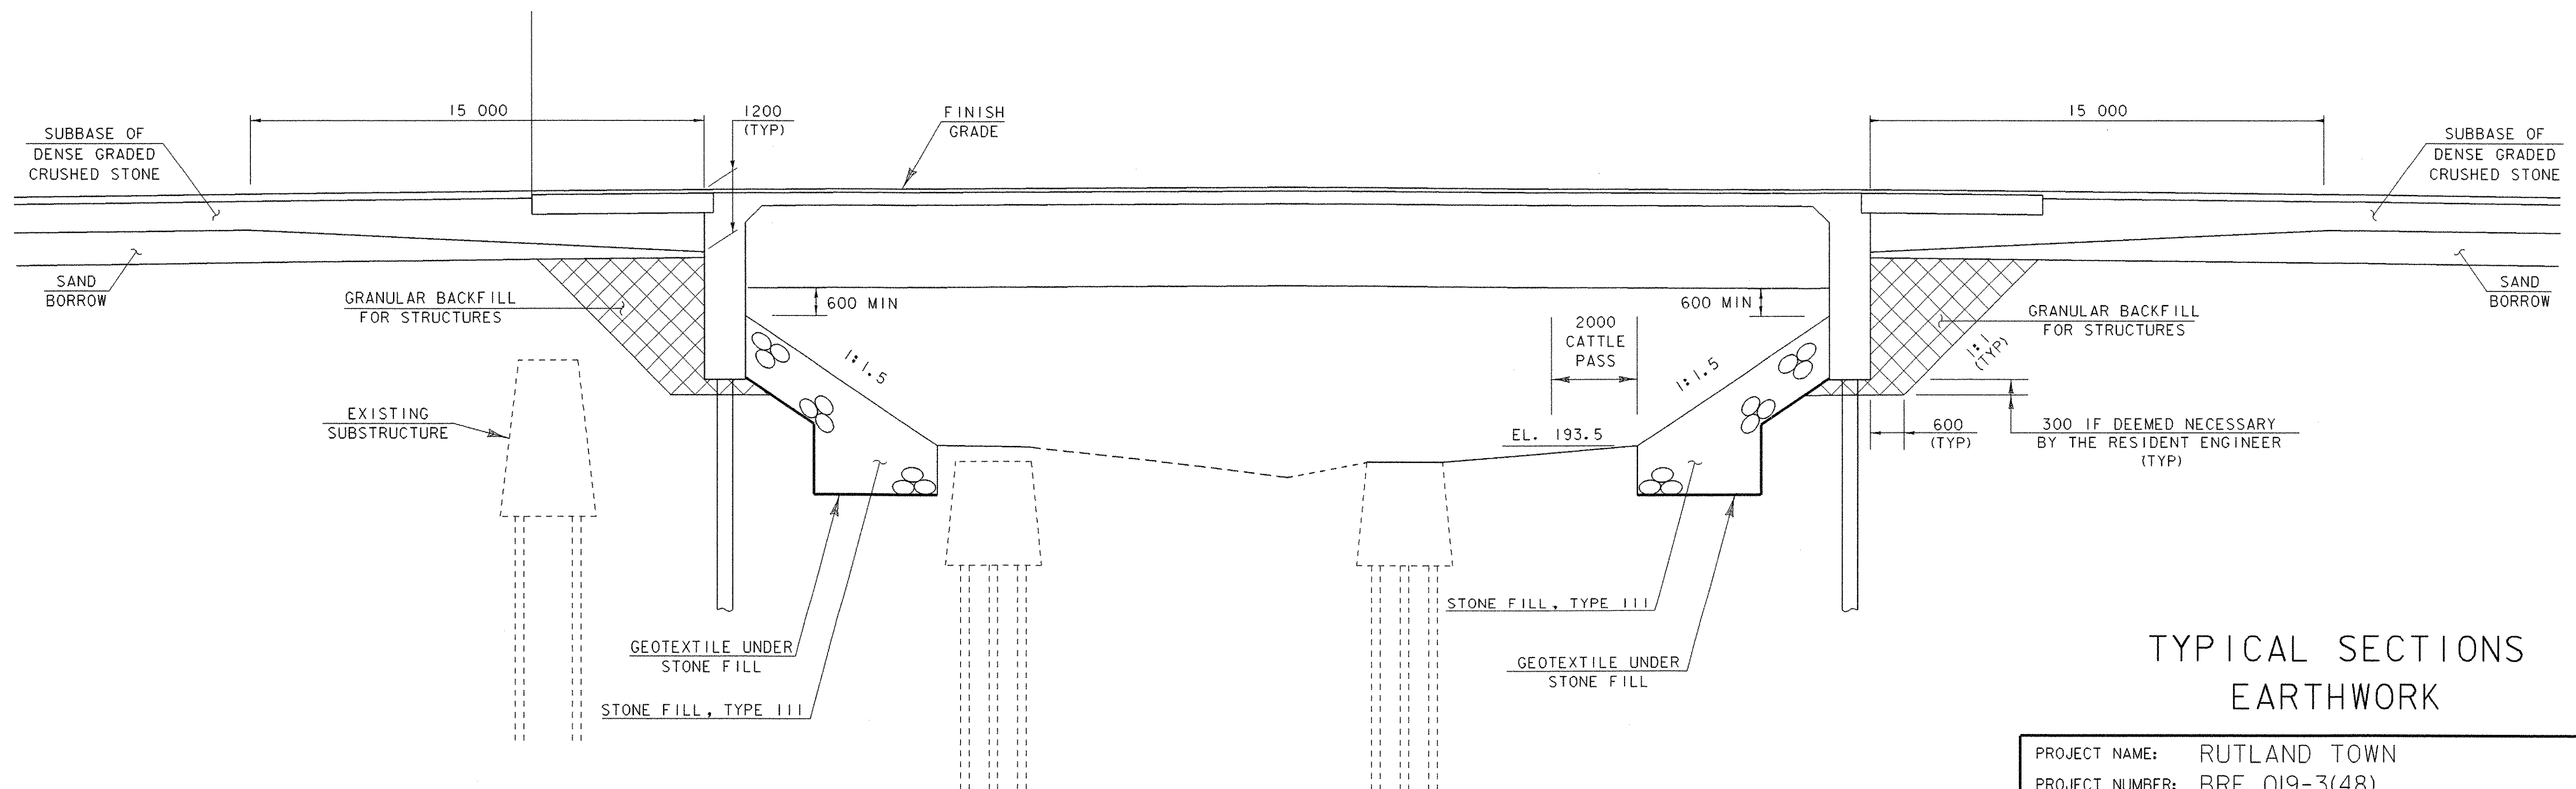

FILLS  
(NOT TO SCALE)

TYPICAL SECTIONS  
EARTHWORK

PROJECT NAME:	RUTLAND TOWN	FILE NAME:	sbi72+y3.j	PLOT DATE:	11-MAR-2008
PROJECT NUMBER:	BRF 019-3(48)	PROJECT LEADER:	R. WHITCOMB	DRAWN BY:	T. LACKEY
		DESIGNED BY:	T. LACKEY	CHECKED BY:	R. WHITCOMB
		95bi72/structures/sbi72typ.dgn		SHEET 6	OF 75