


**END R.O.W. PROJECT
STA 2+464.08
7.74M(25.4')RT**

**FOR R.O.W.
USE ONLY**

R.O.W. LAYOUT PLAN 3

LINES SHOWN ON THIS PLAN AS EXISTING PROPERTY LINES P/L ARE BELIEVED TO BE ACCURATE BUT SHOULD NOT BE RELIED UPON FOR PURPOSES UNRELATED TO THE STATE OF VERMONT'S ACQUISITION OF LAND AND RIGHTS FOR THIS PROJECT.

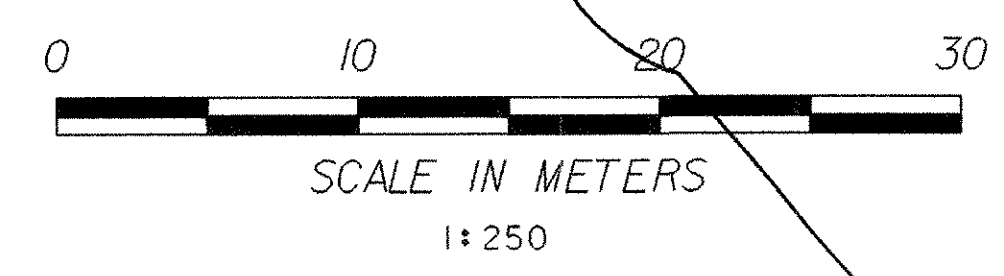

PROJECT NAME:	RUTLAND TOWN	PLOT DATE:	11-MAR-2008
PROJECT NUMBER:	BRF 019-3(48)	DRAWN BY:	T. LACKEY
FILE NAME:	sbi72lp3.1	CHECKED BY:	R.WHITCOMB
PROJECT LEADER:	R.WHITCOMB	ROW SHEET 19 OF 19	SHEET 14 OF 75
DESIGNED BY:	T. LACKEY		