



MAINLINE

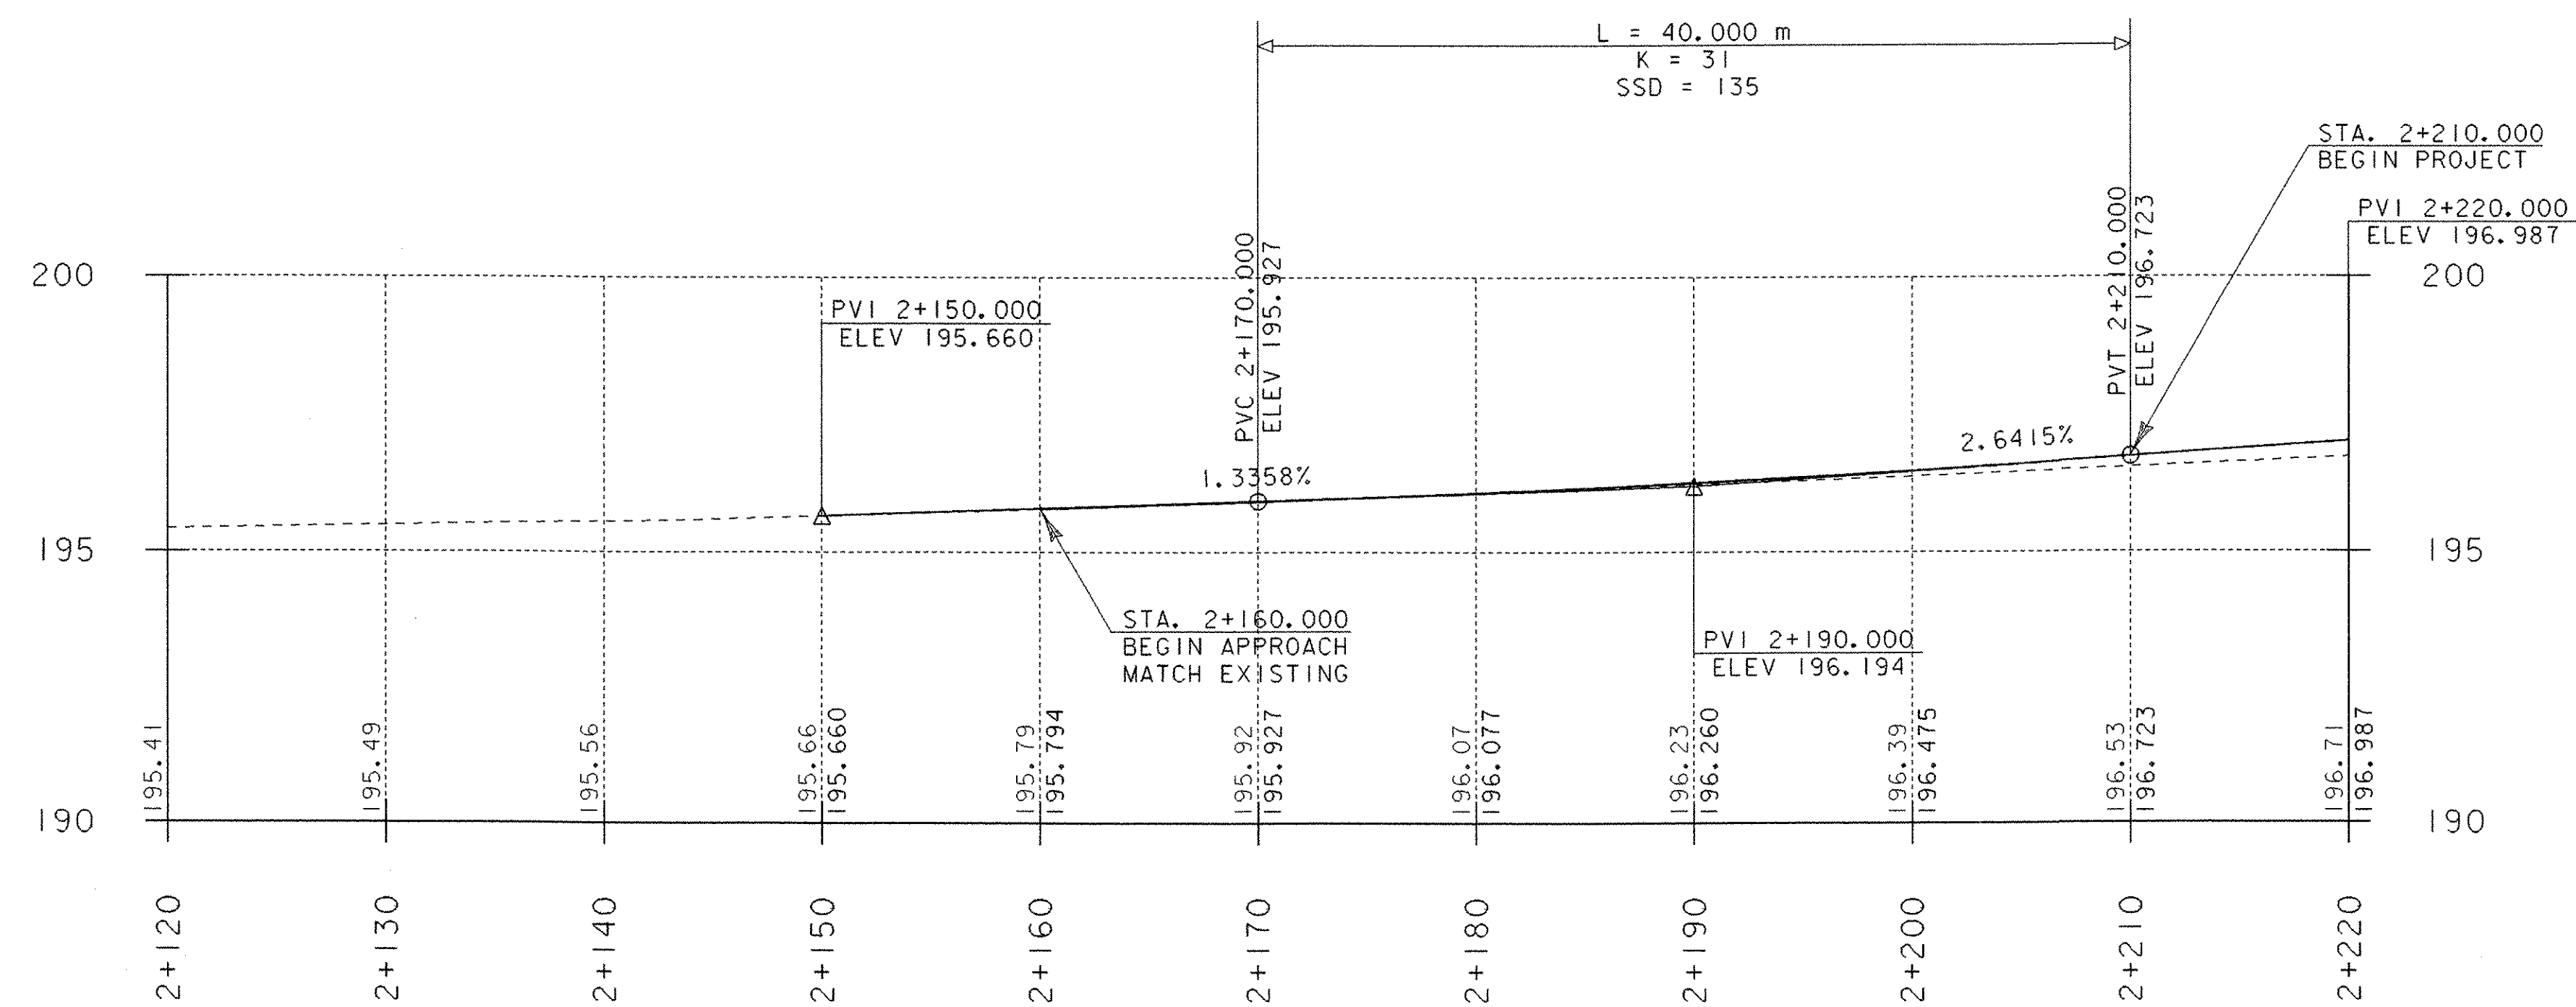

MAINLINE PROFILE 1

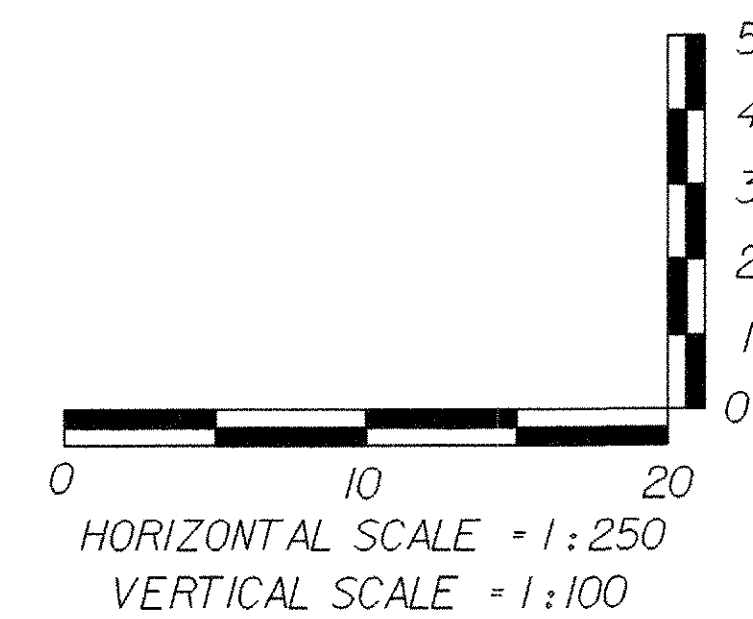

NOTE:
ELEVATIONS TO THE NEAREST HUNDREDTH ARE EXISTING GROUND ALONG PROPOSED CENTERLINE.
ELEVATIONS TO THE NEAREST THOUSANDTH ARE FINISH GRADE ALONG PROPOSED CENTERLINE.

PROJECT NAME: RUTLAND TOWN
PROJECT NUMBER: BRF 019-3(48)

FILE NAME: sb172pfl1
PROJECT LEADER: R. WHITCOMB
DESIGNED BY: T. LACKEY
95b172/str/sb172xs2.dgn

PLOT DATE: 11-MAR-2008
DRAWN BY: L. BULLOCK
CHECKED BY: R. WHITCOMB
SHEET 23 OF 75