


MATERIAL TRANSITION DETAIL

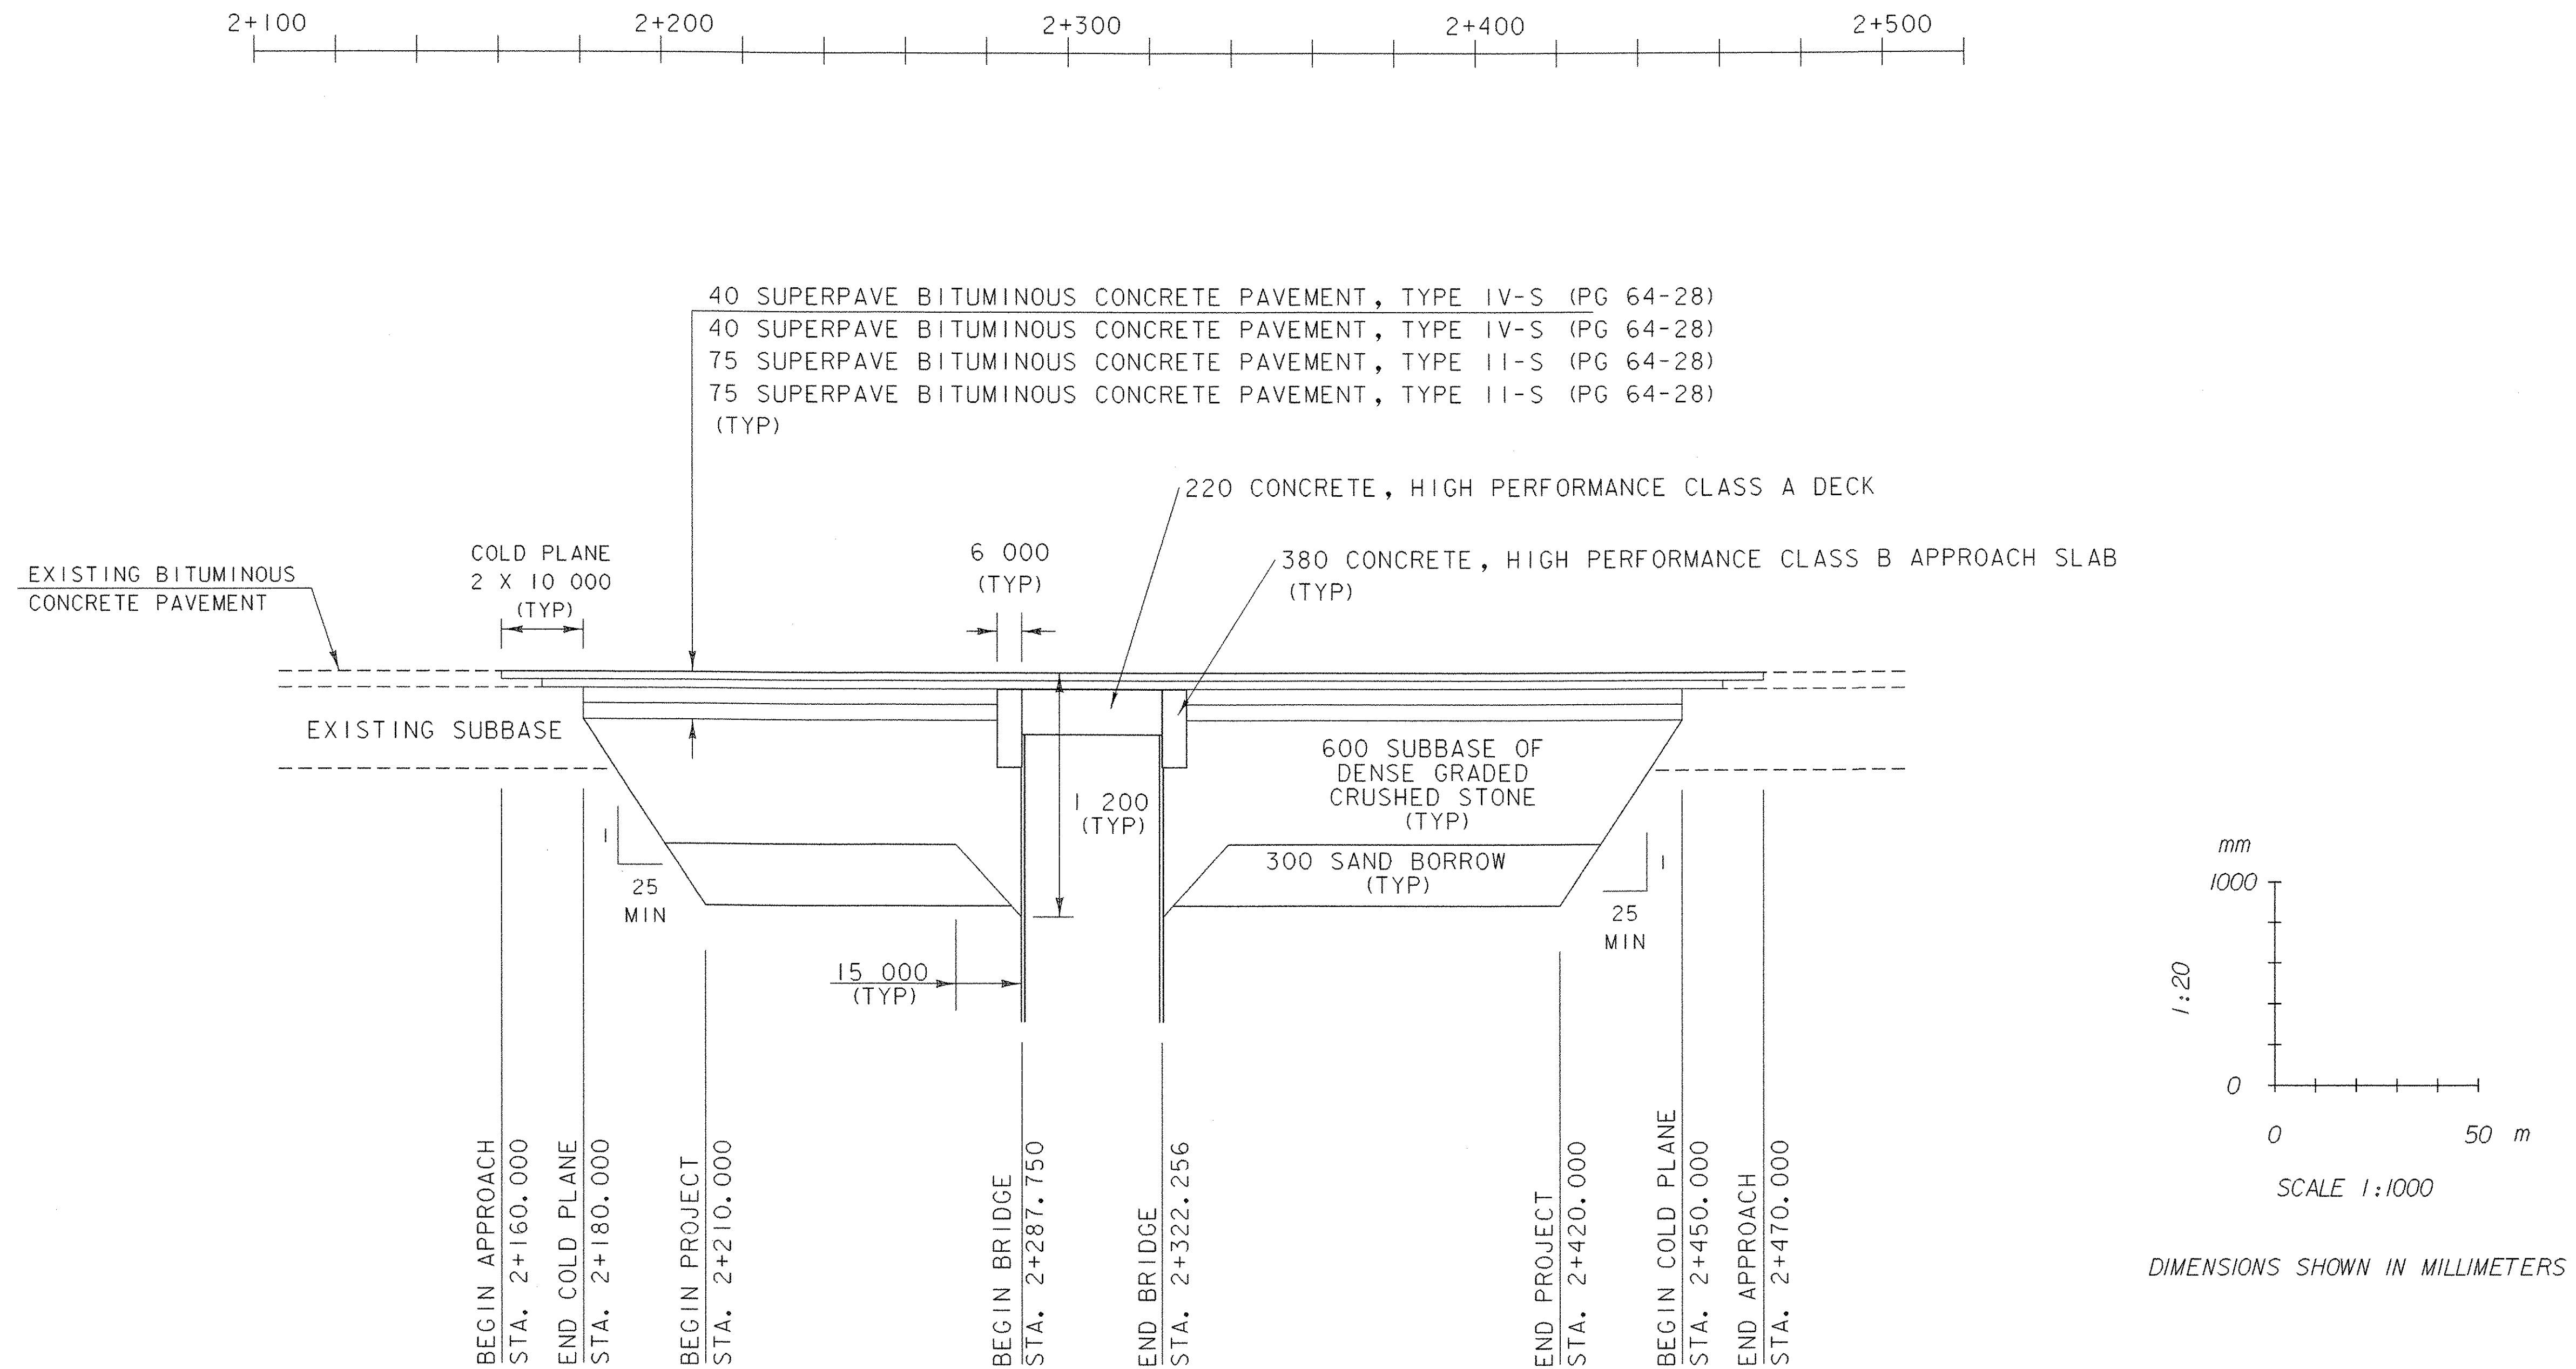

MAINLINE MATERIAL TRANSITION DETAIL

PROJECT NAME:	RUTLAND TOWN
PROJECT NUMBER:	BRF 019-3(48)
FILE NAME:	sbi72pf4.1
PROJECT LEADER:	R. WHITCOMB
DESIGNED BY:	T. LACKEY
95bi72/str/sbi72xs2.dgn	
PLOT DATE:	11-MAR-2008
DRAWN BY:	L. BULLOCK
CHECKED BY:	R. WHITCOMB
SHEET	26 OF 75