


MAINLINE WIDTHS & SUPERELEVATIONS

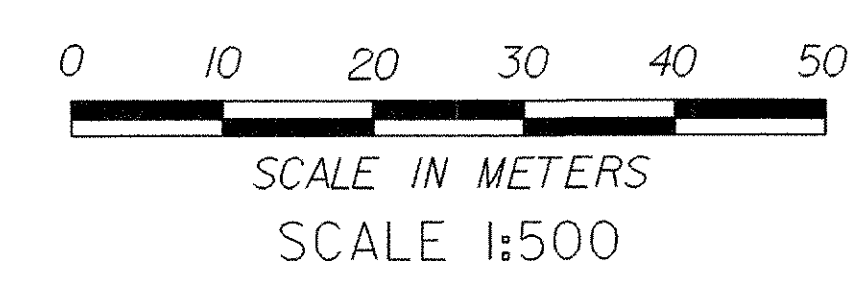

PROJECT NAME:	RUTLAND TOWN	PLOT DATE:	11-MAR-2008
PROJECT NUMBER:	BRF 019-3(48)	DRAWN BY:	L. BULLOCK
FILE NAME:	sb172pf5.1	CHECKED BY:	R. WHITCOMB
PROJECT LEADER:	R. WHITCOMB	SHEET	27 OF 75
DESIGNED BY:	T. LACKEY		
95bl72/str/sbl72xs2.dgn			