
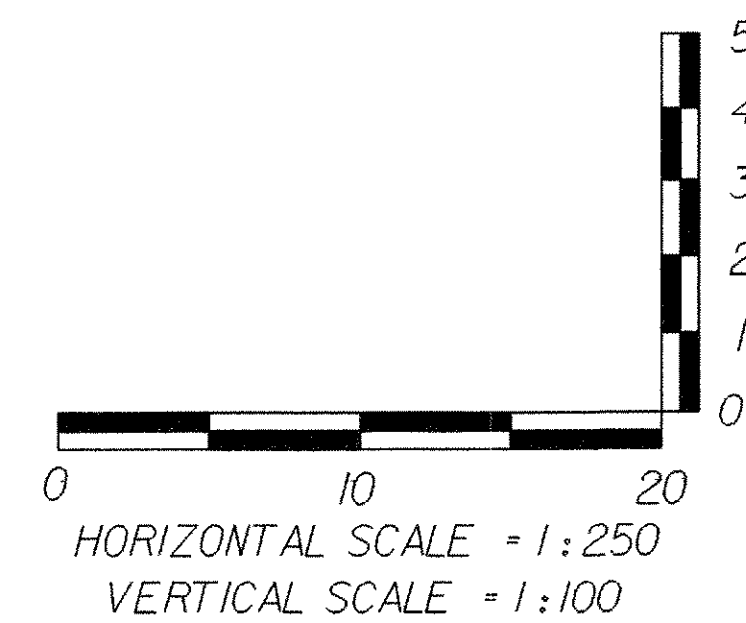


DRIVE (ML 2+263 RT)

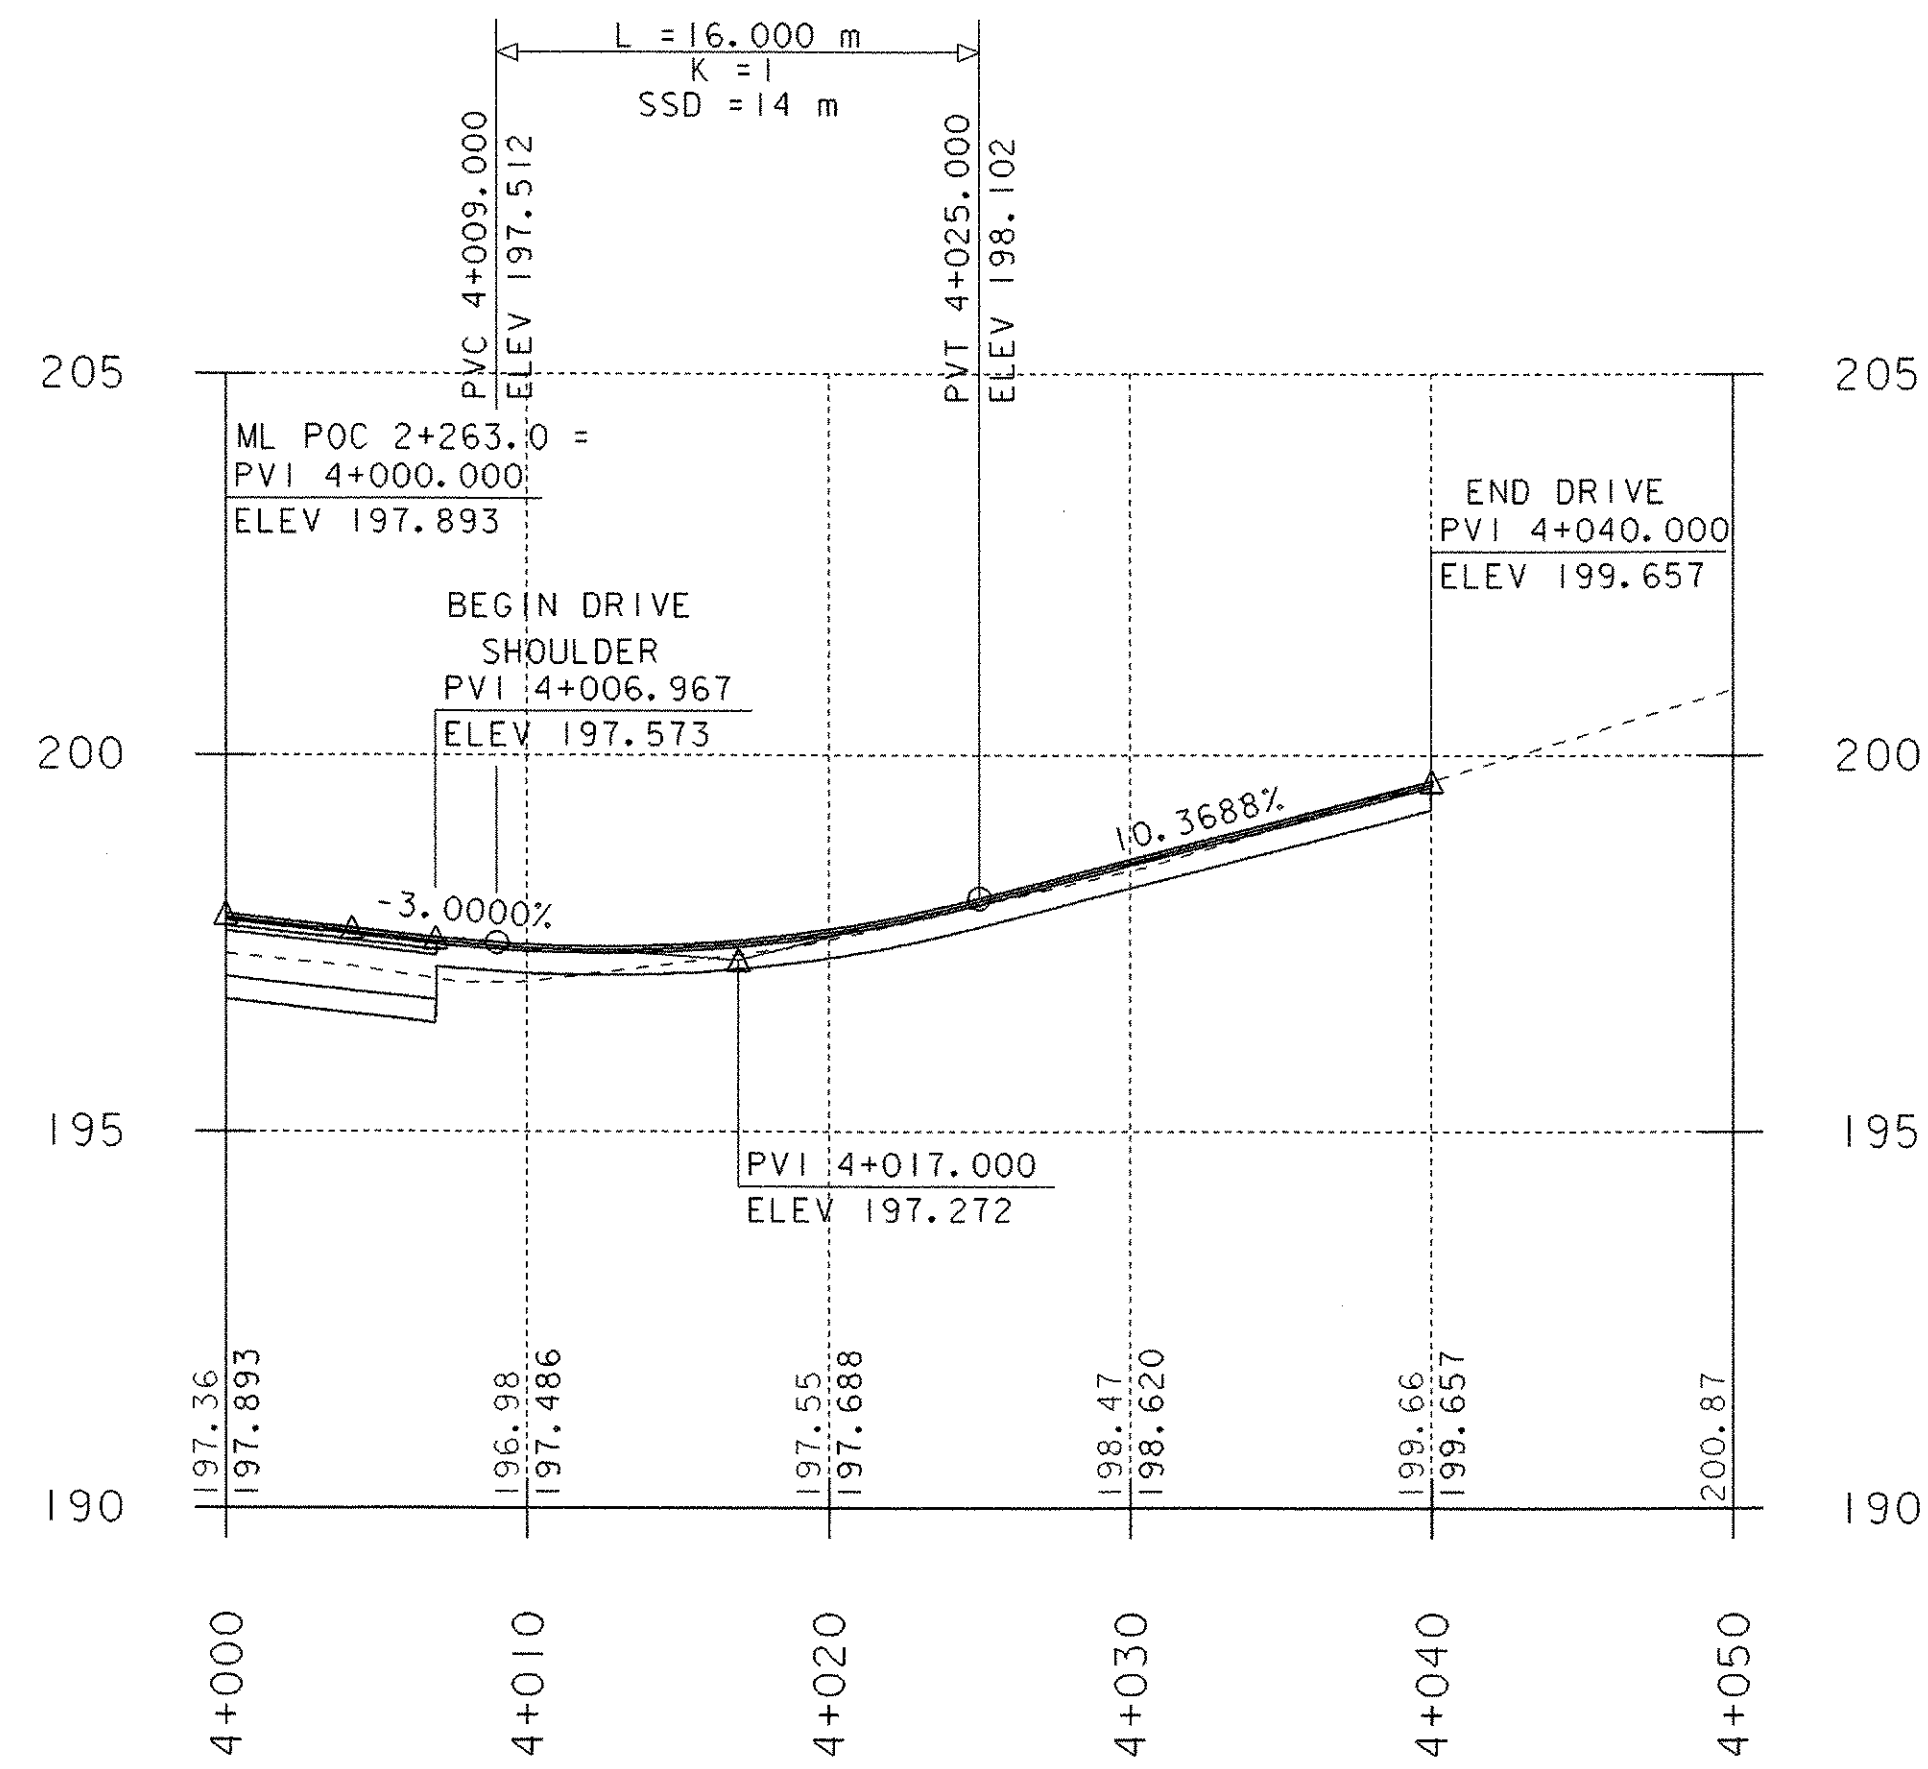

DRIVE PROFILE

NOTE:
 ELEVATIONS TO THE NEAREST HUNDREDTH ARE EXISTING GROUND ALONG PROPOSED CENTERLINE.
 ELEVATIONS TO THE NEAREST THOUSANDTH ARE FINISH GRADE ALONG PROPOSED CENTERLINE.

PROJECT NAME: RUTLAND TOWN	
PROJECT NUMBER: BRF 019-3(48)	
FILE NAME: sb172pf6.i	PLOT DATE: 11-MAR-2008
PROJECT LEADER: WHITCOMB	DRAWN BY: L. BULLOCK
DESIGNED BY: T. LACKEY	CHECKED BY:
95bl72/str/sbl72xs2.dgn	SHEET 28 OF 75