



ARCHAEOLOGICALLY SENSITIVE AREA

100 MM WHITE LINE
 2+400.0 LT. - 2+470.0 LT.
 2+400.0 RT. - 2+470.0 RT.

100 MM YELLOW LINE
 2+400.0 C/L - 2+430.0 C/L (DOUBLE)
 2+439.0 C/L - 2+470.0 C/L (DOUBLE)

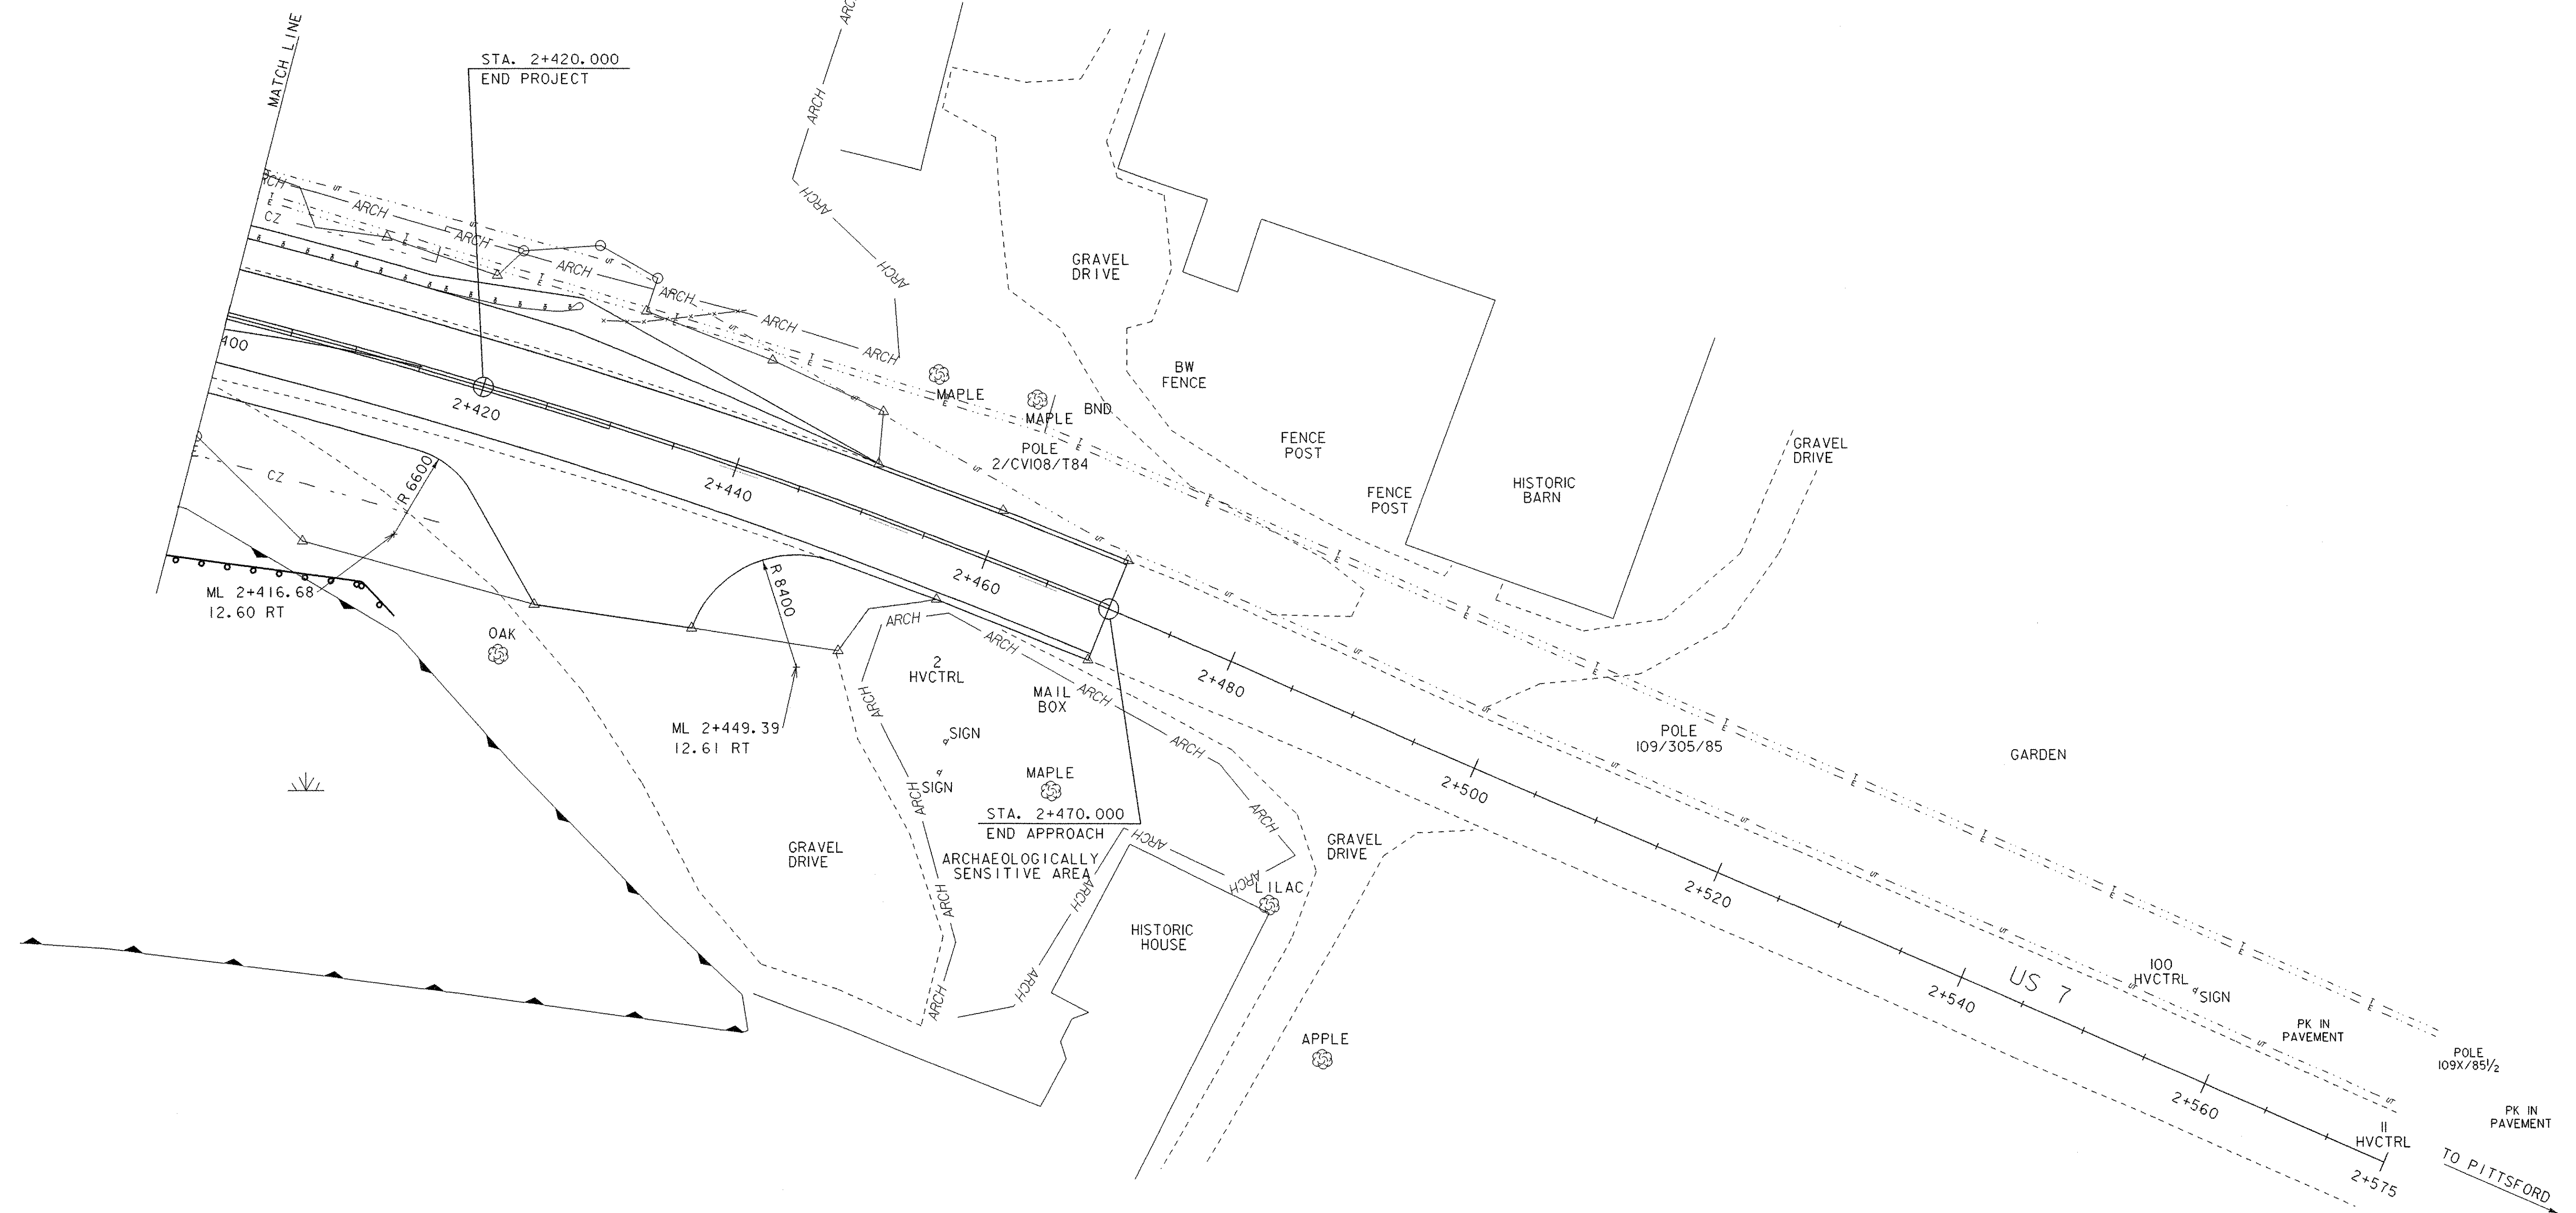

TRAFFIC
 FINAL PLAN 3

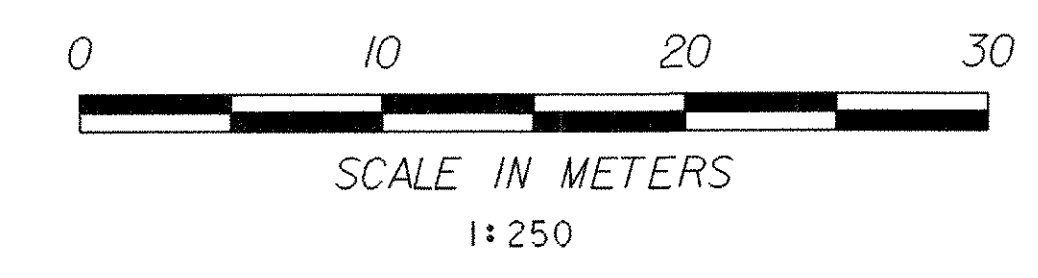

PROJECT NAME:	RUTLAND TOWN	PLOT DATE:	11-MAR-2008
PROJECT NUMBER:	BRF 019-3(48)	DRAWN BY:	L. BULLOCK
FILE NAME:	sbt72+c5.1	CHECKED BY:	T. LACKEY
PROJECT LEADER:	R. WHITCOMB	SHEET	40 OF 75
DESIGNED BY:	L. BULLOCK		
95bt72/str/sbt72+c.dgn			