

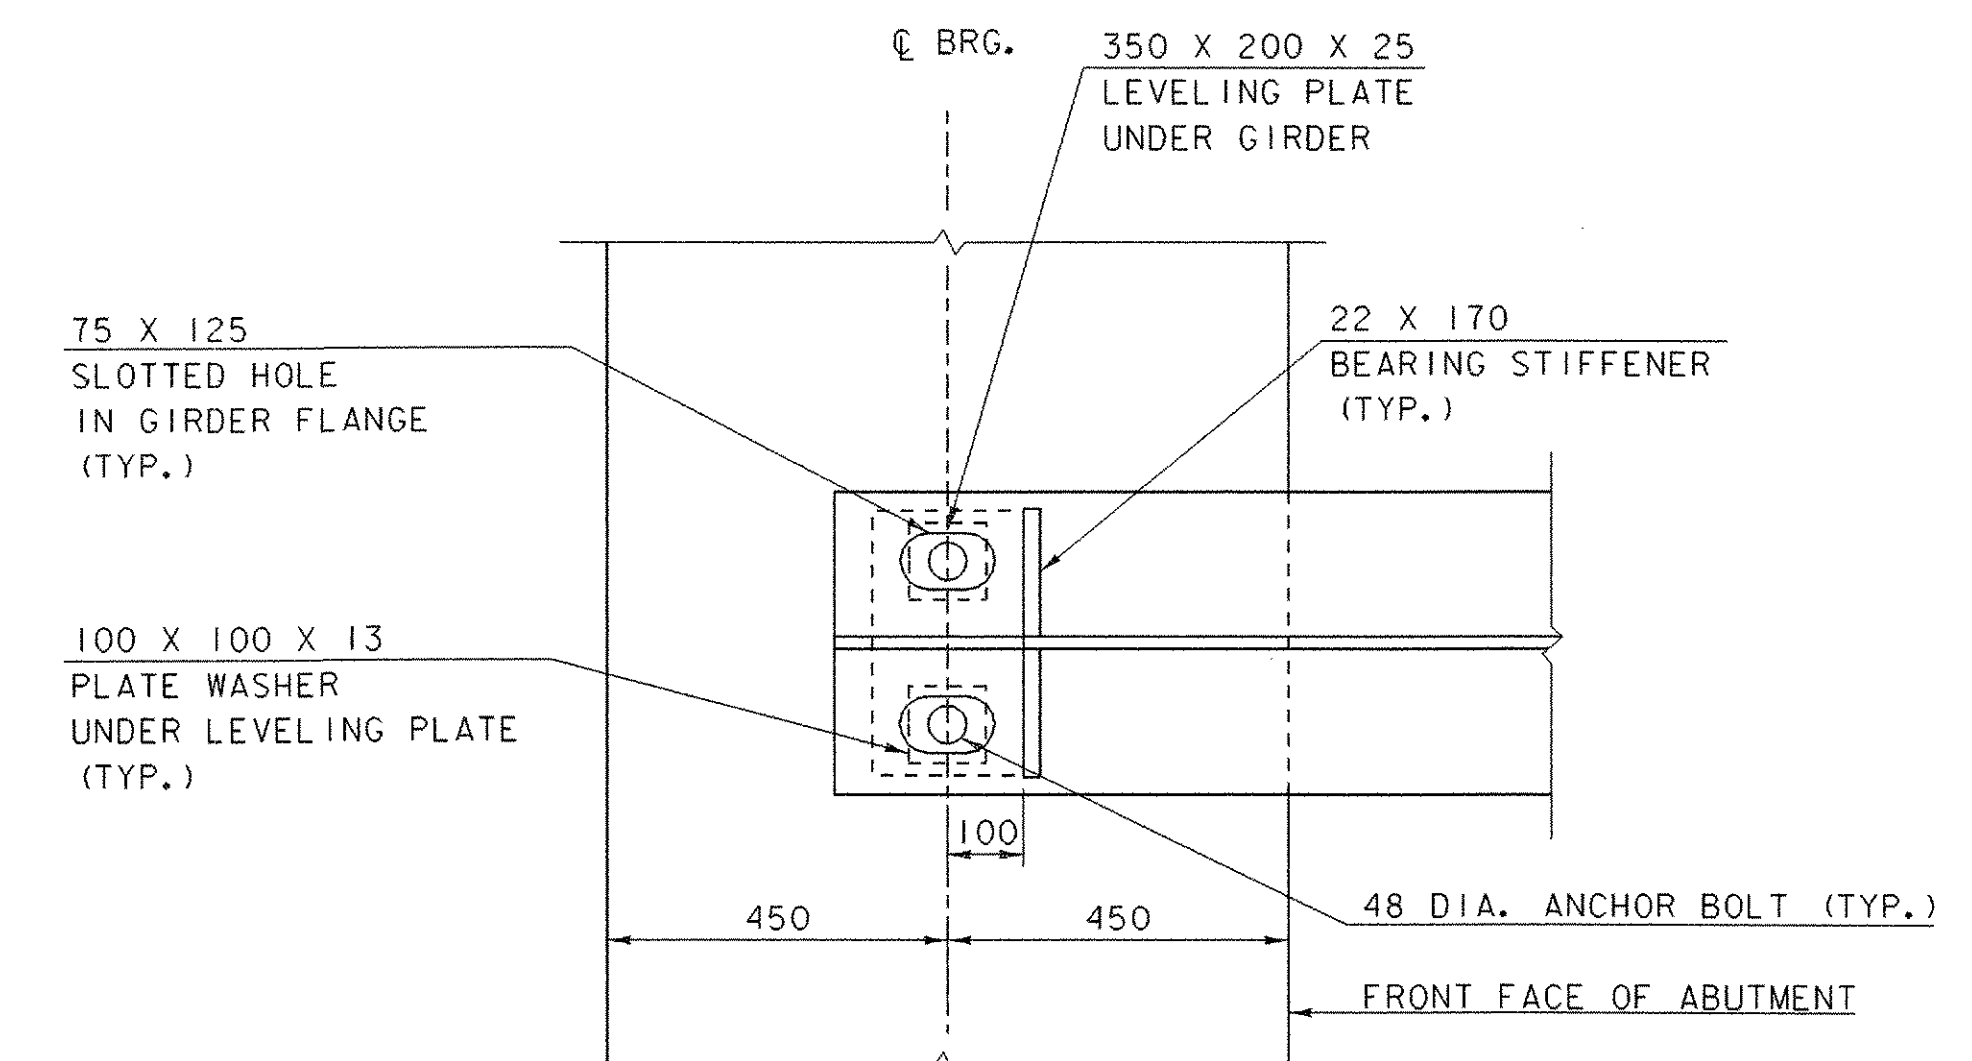
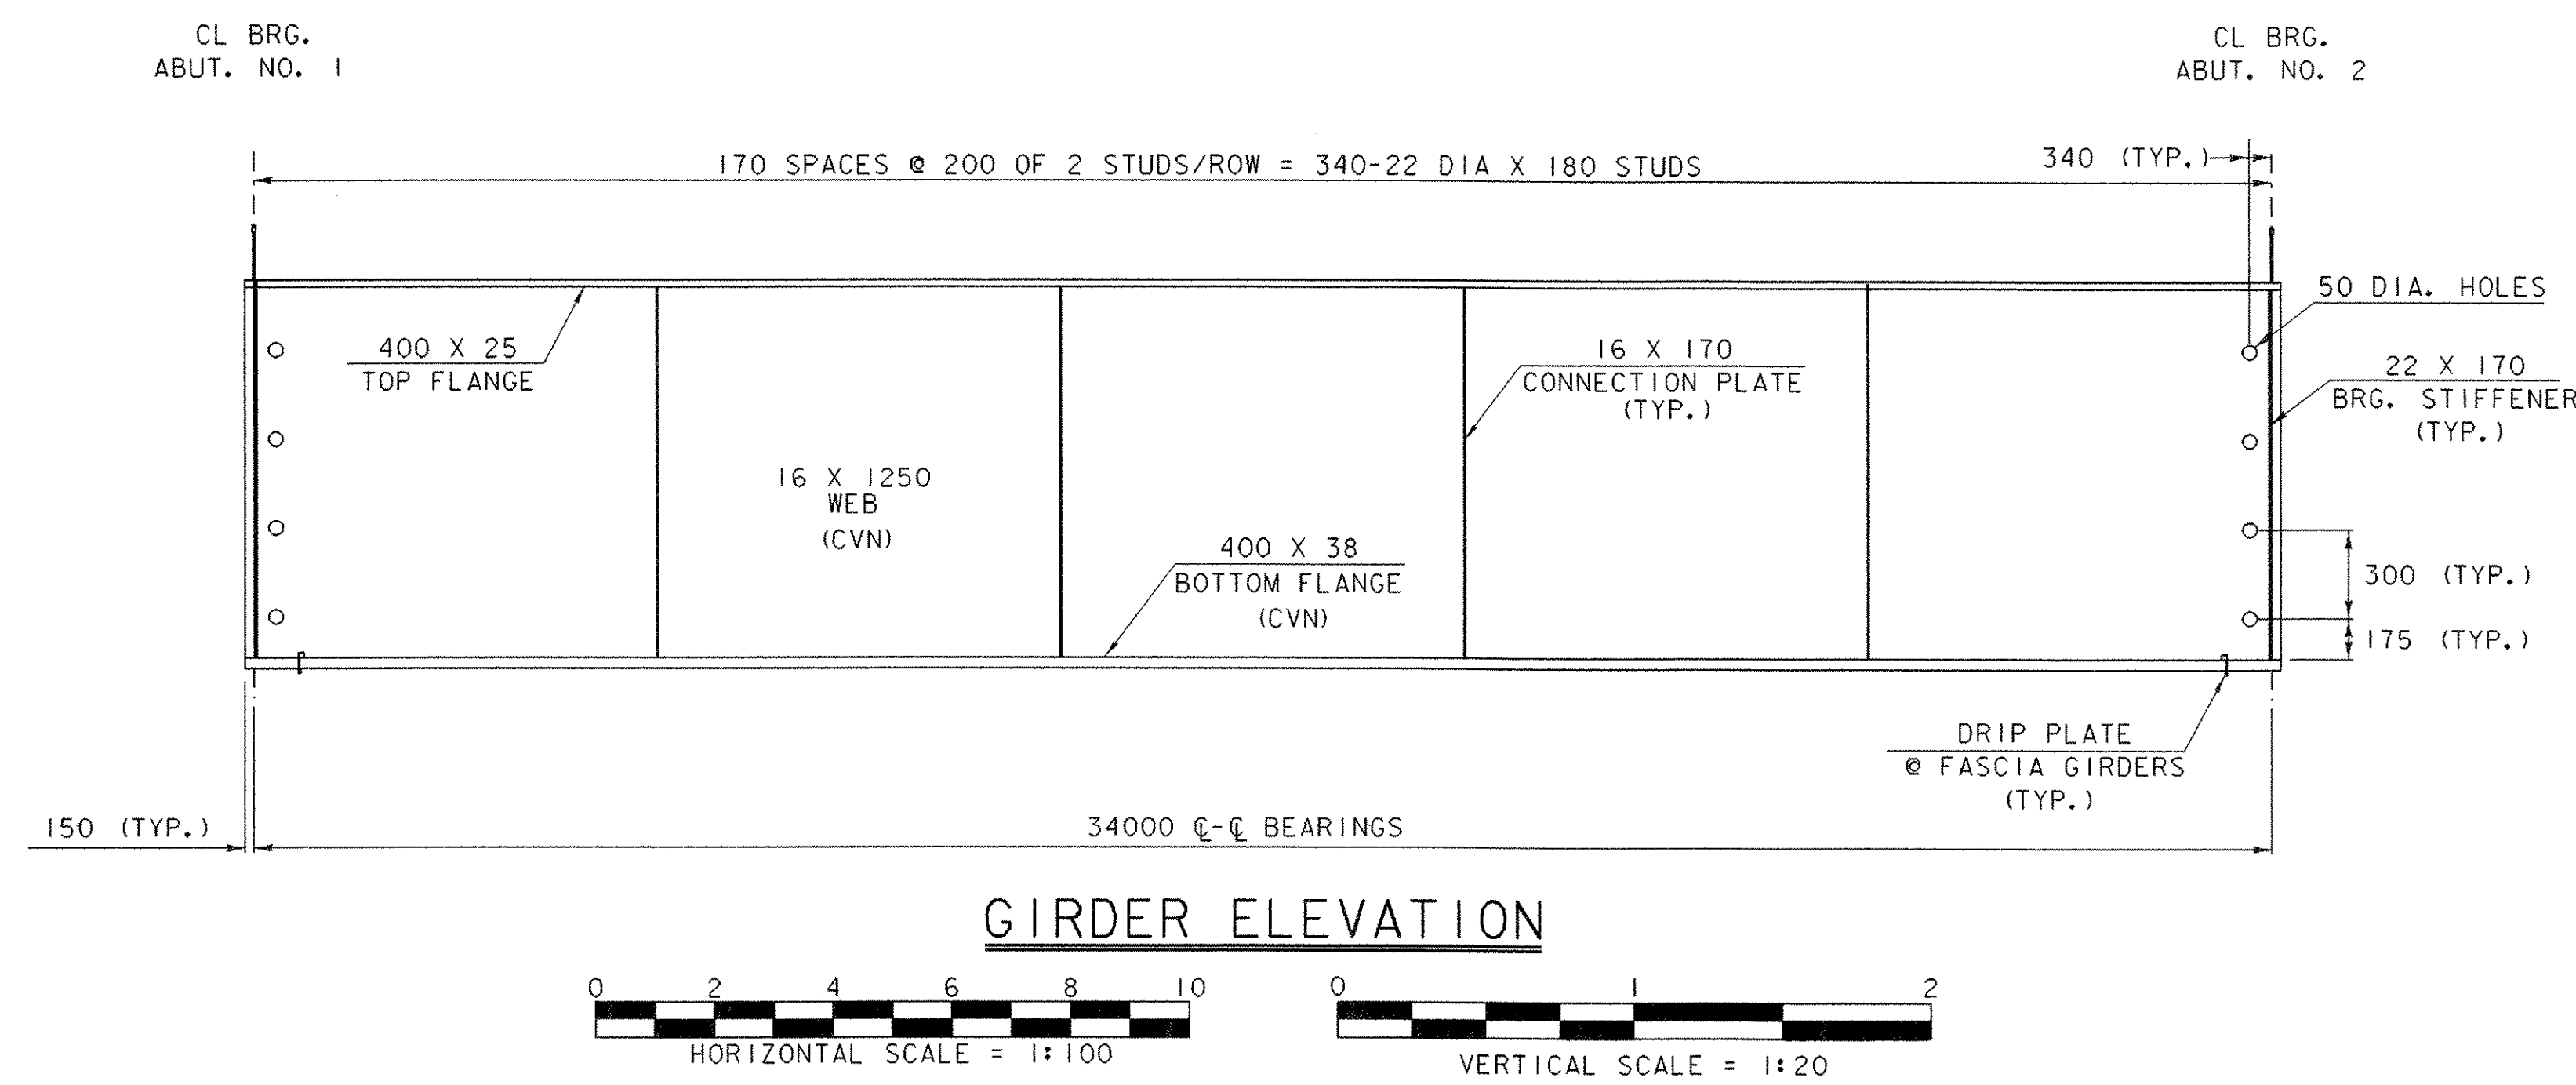
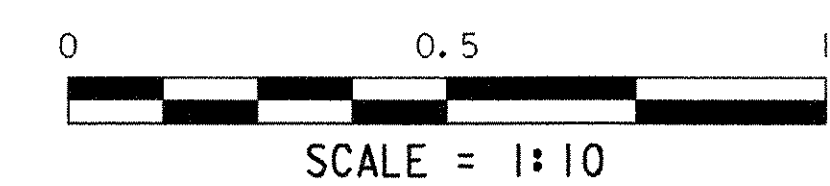


**NOTE:** THE 75mm HORIZONTAL SECTION MAY BE ELIMINATED FOR FORMING SYSTEMS DESIGNED FOR THE CONSTRUCTION OF VERTICAL HAUNCHES. SYSTEMS SHALL BE SUBMITTED FOR APPROVAL TO THE STRUCTURES ENGINEER. ALL VOIDS SHALL BE FILLED WITH MORTAR, TYPE IV OR AN EQUIVALENT PRODUCT FROM THE APPROVED PRODUCTS LIST.

SHEAR CONNECTOR DETAIL

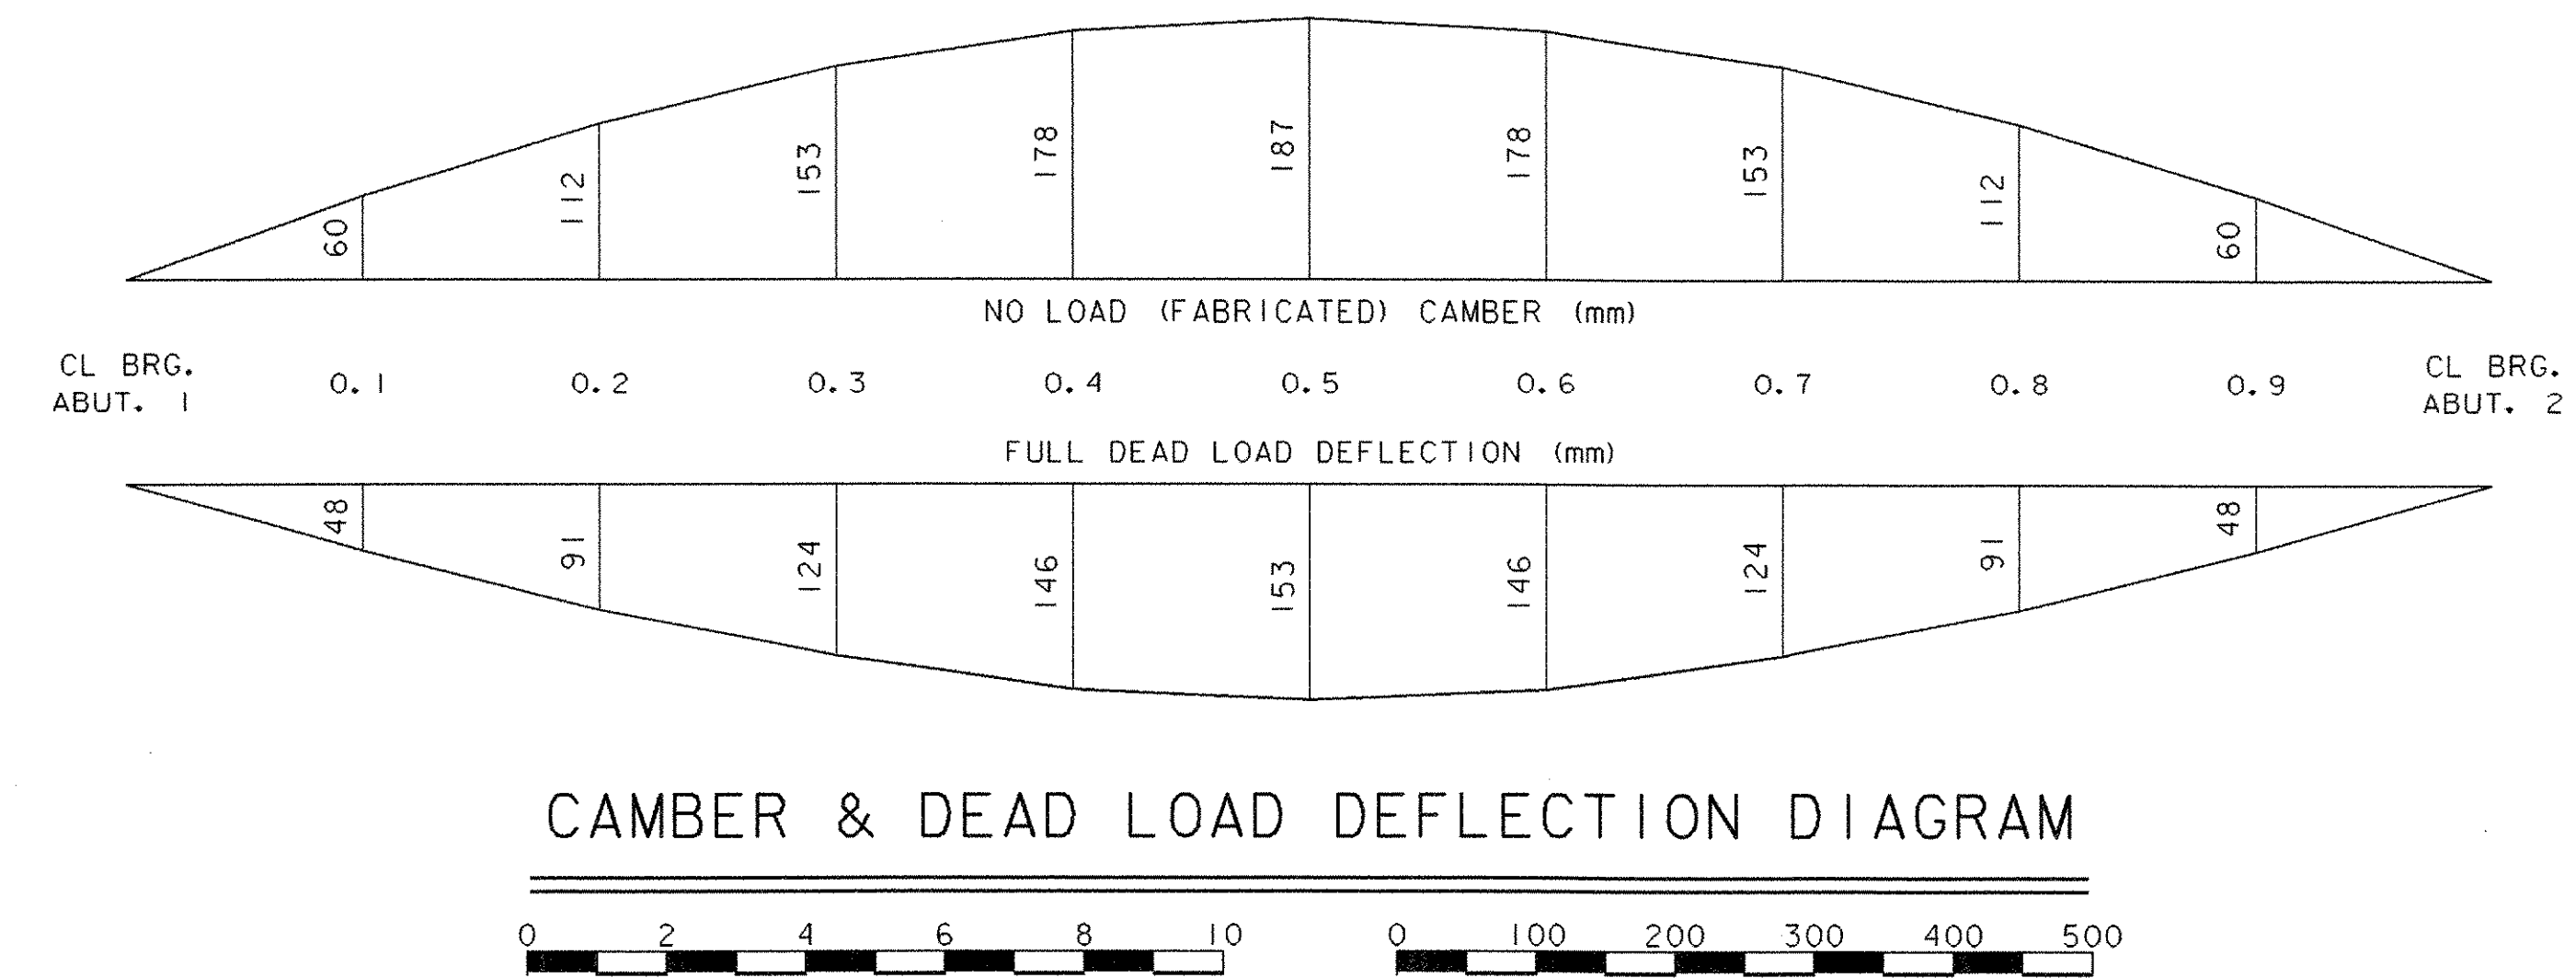

PLAN OF GIRDER END

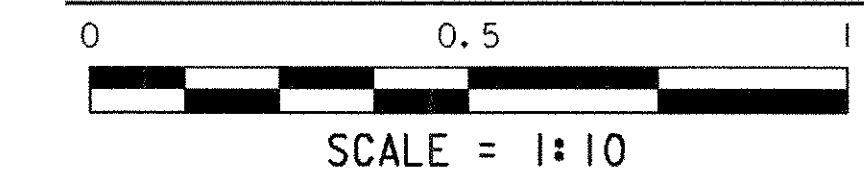

**NOTE:**  
NF = NEAR FACE  
FF = FAR FACE  
EF = EACH FACE  
▲ = CUT TO FIT IN FIELD  
75 COVER UNLESS OTHERWISE SPECIFIED ON THE PLANS.  
660 MIN. LAP LENGTH UNLESS OTHERWISE SPECIFIED ON THE PLANS

SUPERSTRUCTURE GIRDER DETAILS

PROJECT NAME: RUTLAND TOWN	PLOT DATE: 11-MAR-2008
PROJECT NUMBER: BRF 019-3(48)	DRAWN BY: D. PETERSON
FILE NAME: sb172sp4.i	CHECKED BY: R.WHITCOMB
PROJECT LEADER: R.WHITCOMB	SHEET 49 OF 75
DESIGNED BY: T. LACKEY	
95b172/structures/sb172sup.dgn	