


APPROACH SLAB REINFORCING PLAN

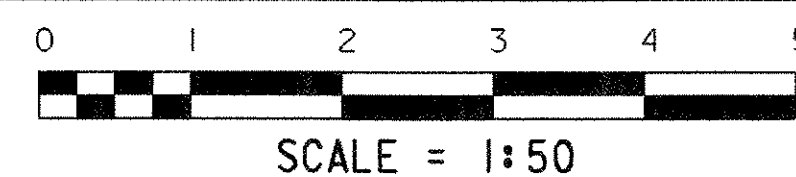

NOTES:

1. PLACE HOOKED ENDS OF BOTTOM STEEL RUNNING PARALLEL TO CENTERLINE AT ABUTMENT END OF SLAB.
2. ALL ELEVATIONS ARE AT THE TOP OF APPROACH SLAB, NOT THE FINISH GRADE.
3. APPLY 2 COATS OF TAR EMULSION BOND BREAKER BETWEEN APPROACH SLAB AND CURB. INCLUDE IN ITEM 501.34 "CONCRETE, HIGH PERFORMANCE CLASS B".

NOTE:

- NF = NEAR FACE
 - FF = FAR FACE
 - EF = EACH FACE
 - ▲ = CUT TO FIT IN FIELD
- 75 COVER UNLESS OTHERWISE SPECIFIED ON THE PLANS.
660 MIN. LAP LENGTH UNLESS OTHERWISE SPECIFIED ON THE PLANS

SUPERSTRUCTURE
APPROACH SLABS PLAN

PROJECT NAME: RUTLAND TOWN
PROJECT NUMBER: BR 019-3(48)

FILE NAME: sbi72sp6.i
PROJECT LEADER: R.WHITCOMB
DESIGNED BY: T. LACKEY
95b172/structures/sbi72sup.dgn

PLOT DATE: 11-MAR-2008
DRAWN BY: D. PETERSON
CHECKED BY: R.WHITCOMB
SHEET 51 OF 75