



**NOTES**


1. REFER TO DETAIL SHEET BRIM FOR ADDITIONAL DETAILS, NOTES AND MATERIAL SPECIFICATIONS.
2. PAYMENT FOR "GUARD RAIL APPROACH SECTION, GALVANIZED NETC 2 RAIL" SHALL INCLUDE THE TERMINAL CONNECTOR, THE CONNECTION PLATE, THE DEFLECTOR PLATE, RAIL, POSTS, BLOCKS AND ATTACHMENT HARDWARE.
3. THE REFLECTORIZED ALUMINUM DELINEATION IS TO BE ERECTED EVERY 9m (OR CLOSEST POST) WITH A M16 BOLT.
4. REFLECTIVE MATERIAL SHALL MEET REQUIREMENTS OF SUBSECTION 750.08 (b) (3), AND SHALL BE OF ENCAPSULATED LENS SILVER OR AMBER. INSTALL AMBER ON THE DRIVER'S LEFT AND SILVER ON THEIR RIGHT.
5. ALL APPROACH RAIL SPLICES SHALL BE LAPPED IN THE DIRECTION OF TRAFFIC FLOW.
6. ALL BRIDGE APPROACH RAIL MATERIALS, DIMENSION SIZES AND NOTES SHALL BE THE SAME AS THOSE OF THE BRIDGE RAIL, UNLESS OTHERWISE NOTED.
7. WELD TOP SPLICE BAR TO FIT BEND. USE COMPLETE PENETRATION WELD (B-U2).
8. PAY ITEM 616.21 "VERTICAL GRANITE CURB" WILL INCLUDE THE GRANITE CURB, APPROACH SLAB BOND BREAKER, AND BRIDGE CURB CLOSED CELL FOAM.

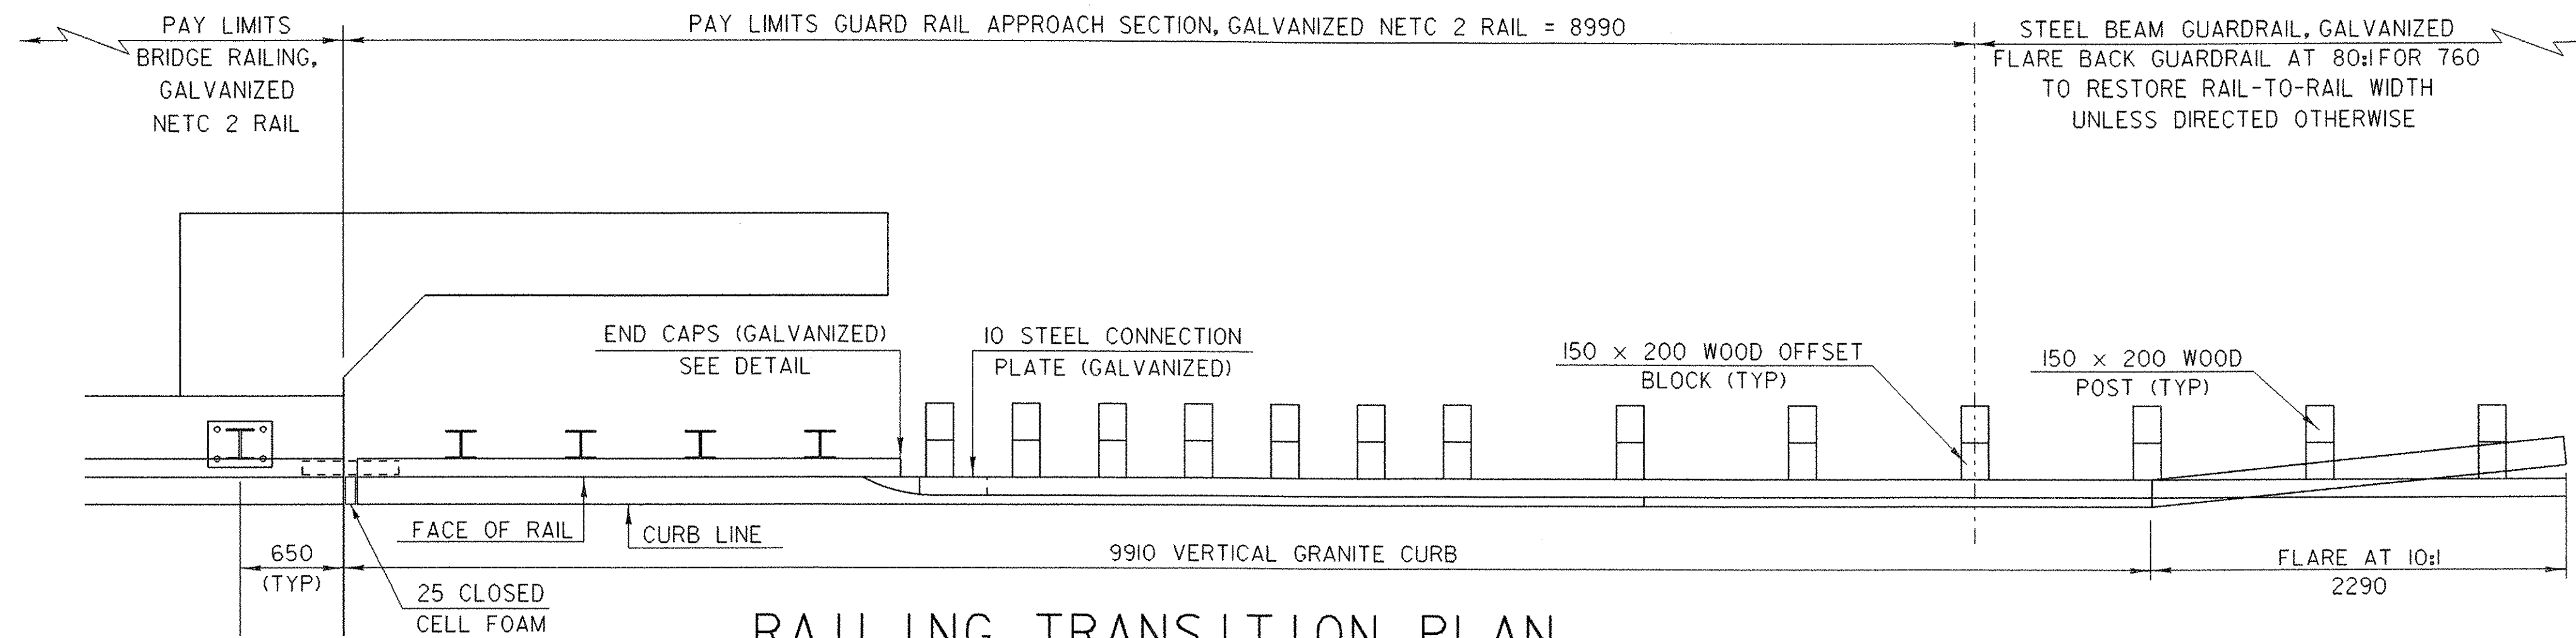


**RAILING TRANSITION PLAN**

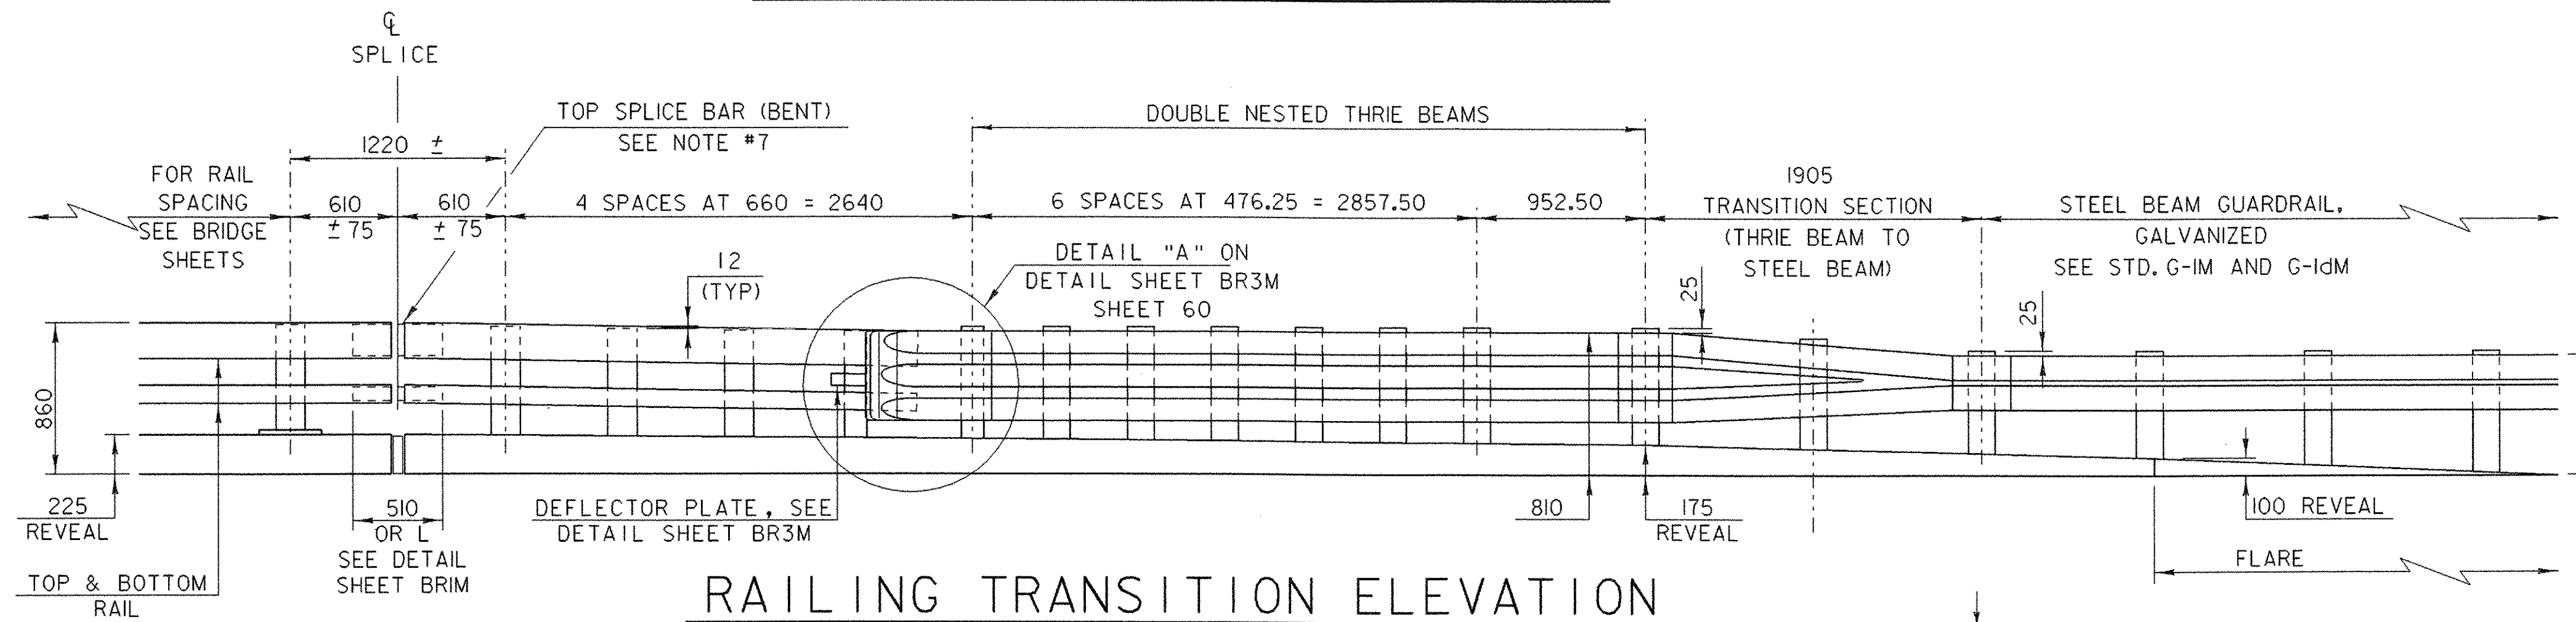

**RAILING TRANSITION ELEVATION**

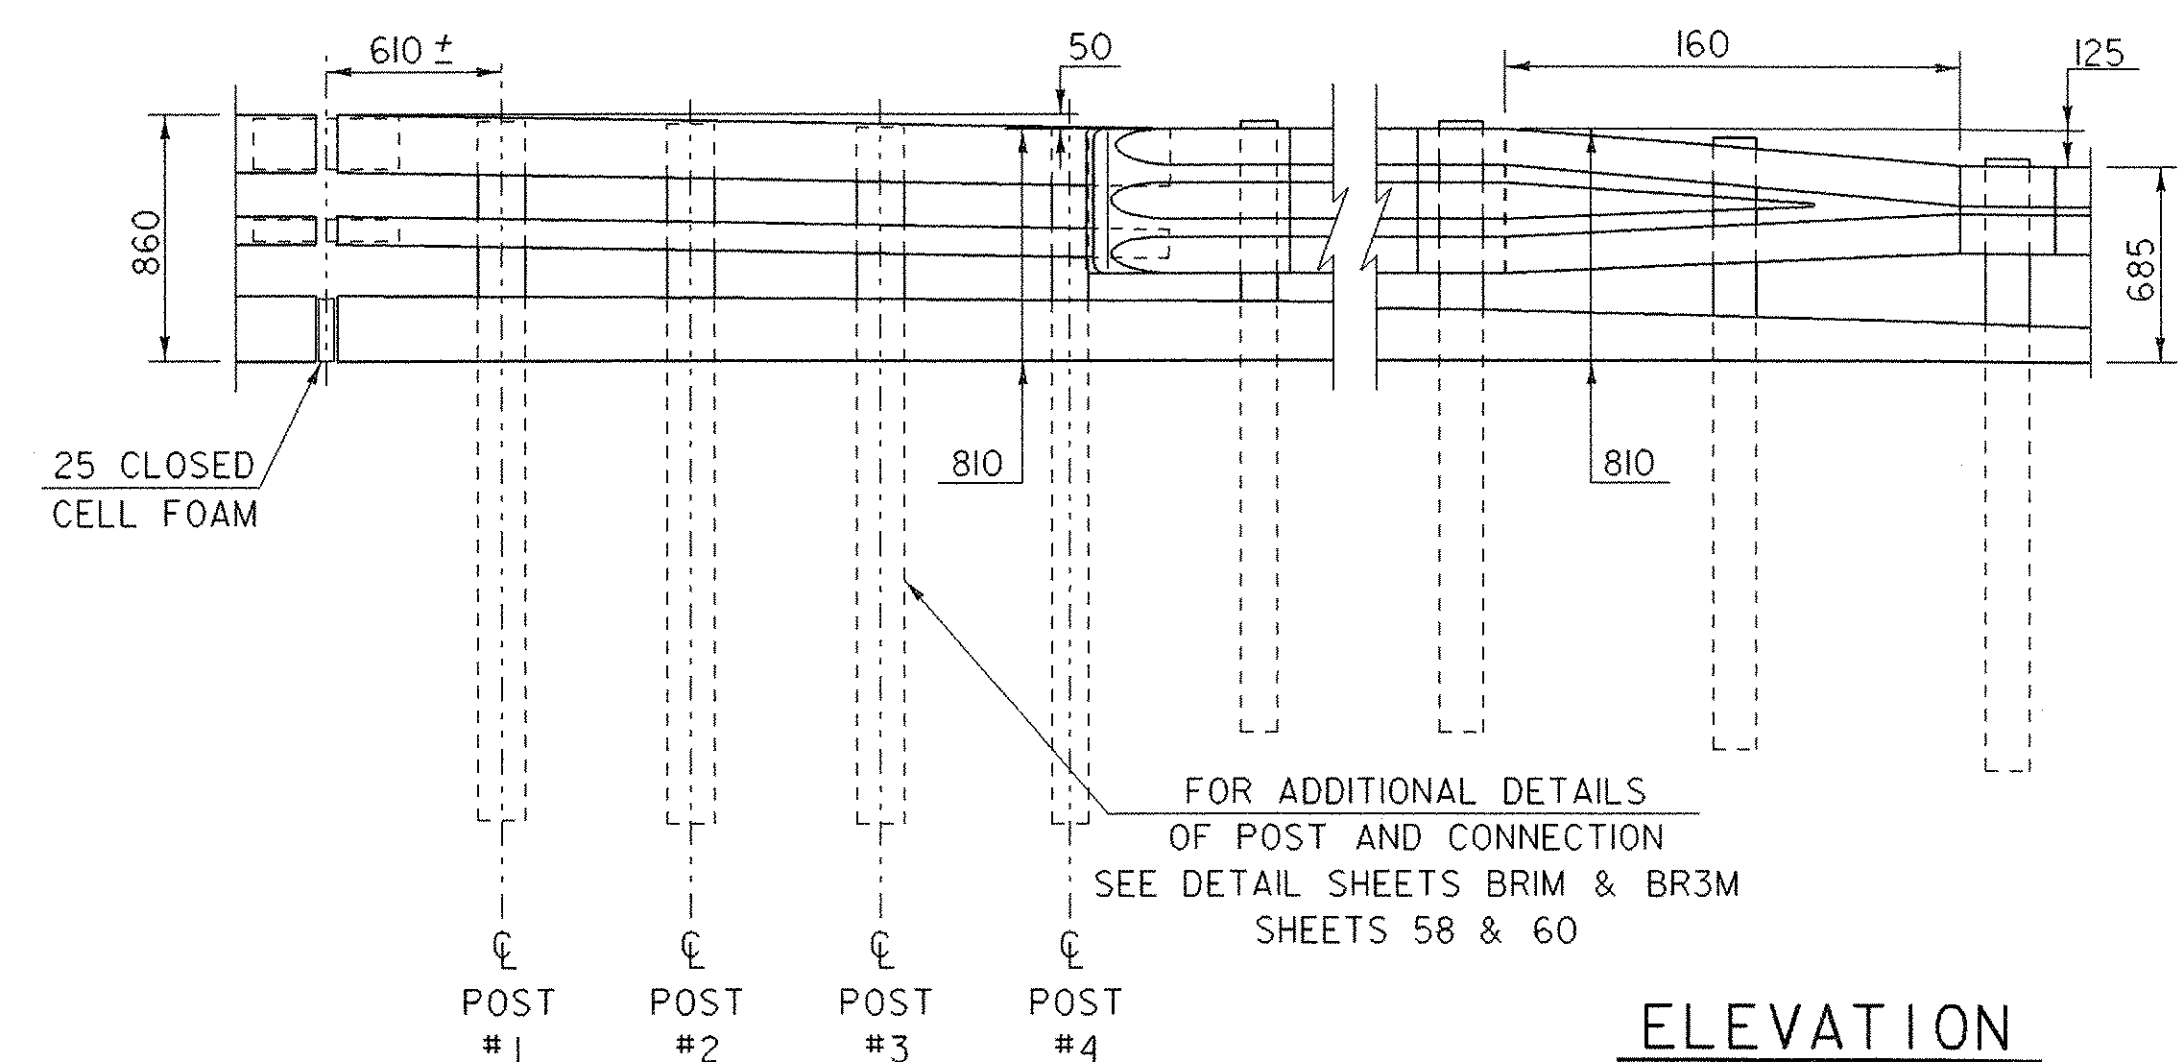


**ELEVATION**

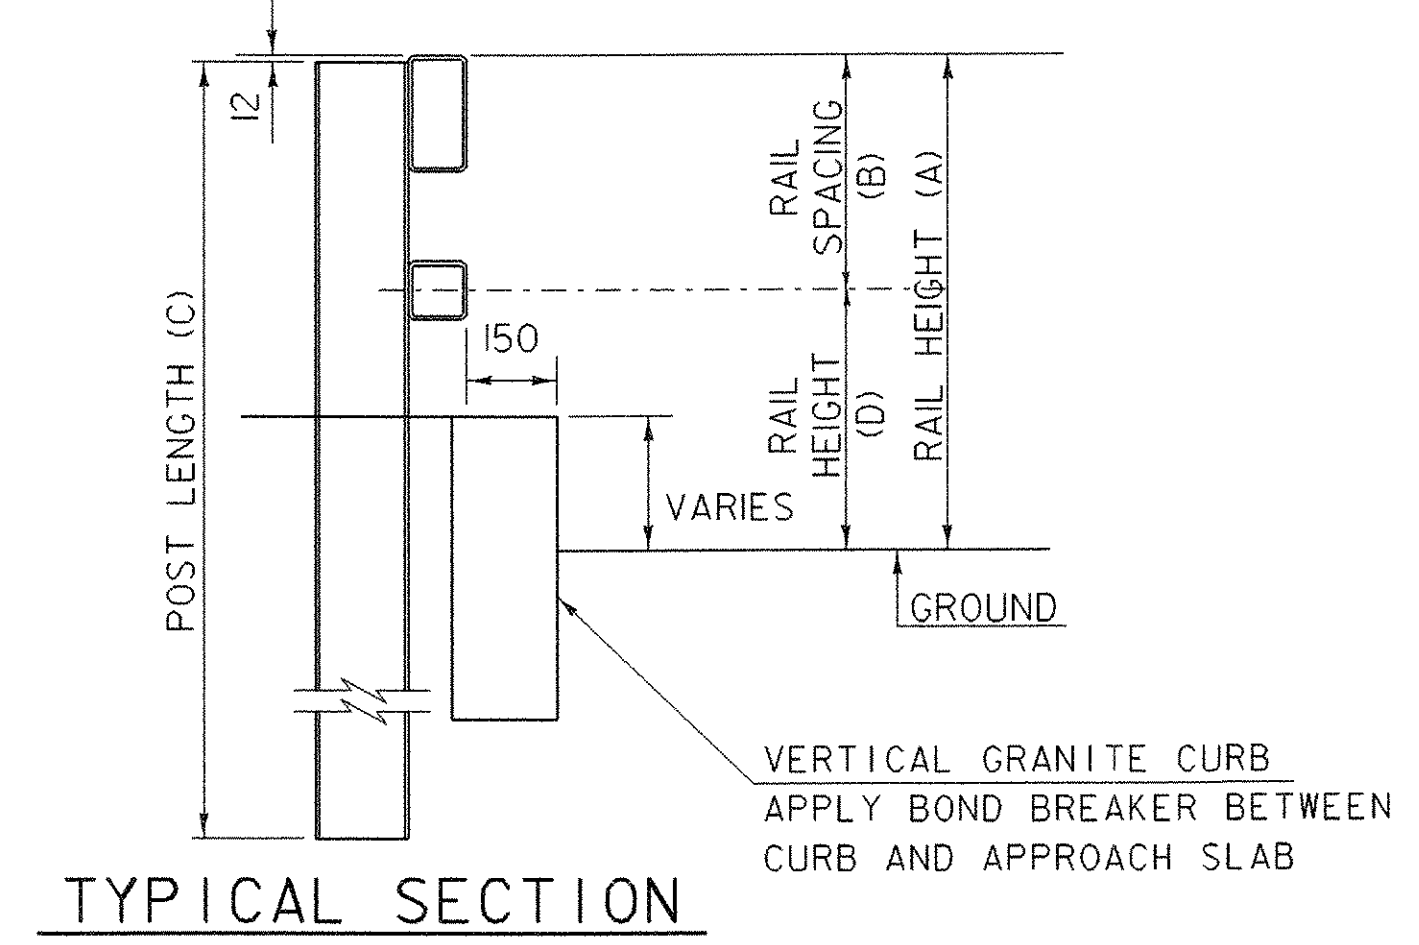

**TYPICAL SECTION**

POST NUMBER	RAIL HEIGHT (A)	RAIL SPACING (B)	POST LENGTH (C)	RAIL HEIGHT (D)
1	850	400	2440	450
2	840	395	2440	445
3	825	385	2440	440
4	810	375	2440	435

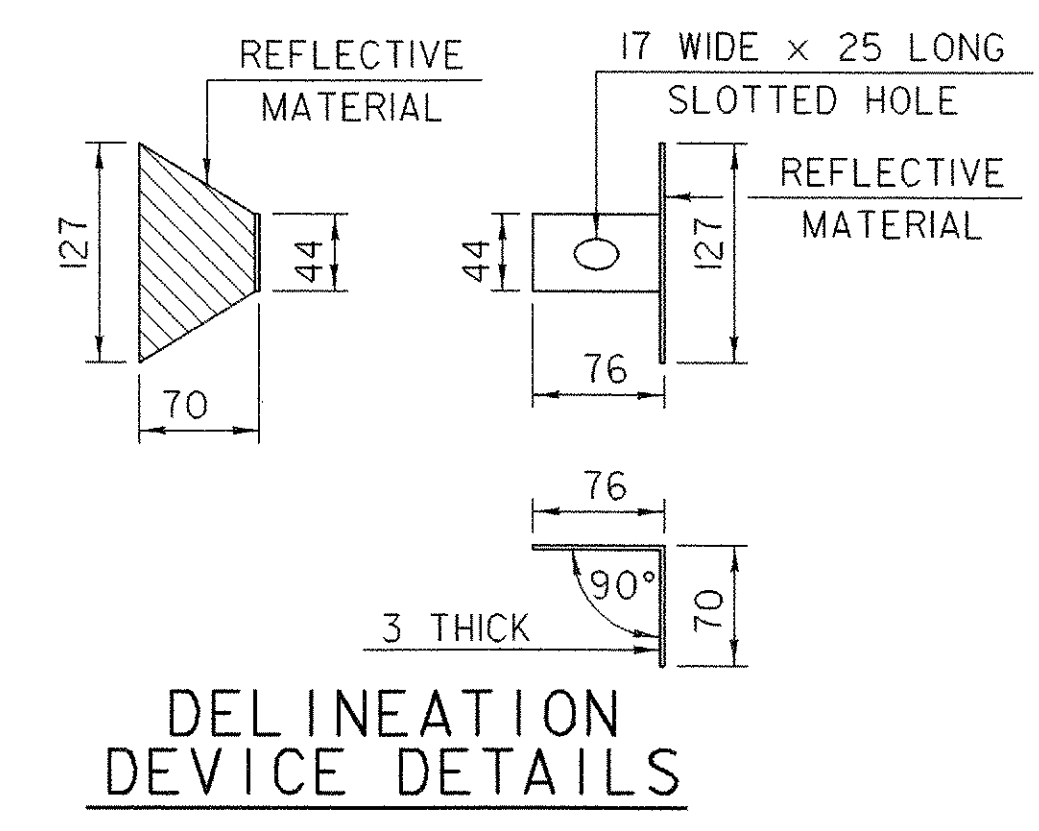

**DELINEATION DEVICE DETAILS**

**BR2M  
BRIDGE RAILING, GALVANIZED N.E.T.C. 2 RAIL  
THRIE BEAM GUARDRAIL APPROACH RAIL**

**BRIDGE RAILING  
DETAIL SHEET BR2M**

PROJECT NAME: RUTLAND TOWN	PLOT DATE: 11-MAR-2008
PROJECT NUMBER: BRF 019-3(48)	DRAWN BY: VTRANS
FILE NAME: sbi72br2.i	CHECKED BY: T. Lockey
PROJECT LEADER: R. Whitcomb	SHEET 59 OF 75
DESIGNED BY: VTRANS	
95bi72/str/sbi72br.dgn	