


2+160.000 BEGIN APPROACH
MATCH EXISTING

2+180.000 END COLD PLANING

MAINLINE SECTIONS I

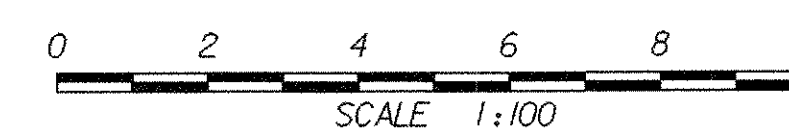

STA. 2+160 TO STA. 2+190

PROJECT NAME: RUTLAND TOWN	FILE NAME: 95b172/str/sb172xs2.dgn	PLOT DATE: 11-MAR-2008
PROJECT NUMBER: BRF 019-3(48)	PROJECT LEADER: R. WHITCOMB	DRAWN BY: L. BULLOCK
	DESIGNED BY: L. BULLOCK	CHECKED BY: T. LACKEY
	sb172m01.t	SHEET 61 OF 75