



2+210.00


2+210.000 BEGIN PROJECT

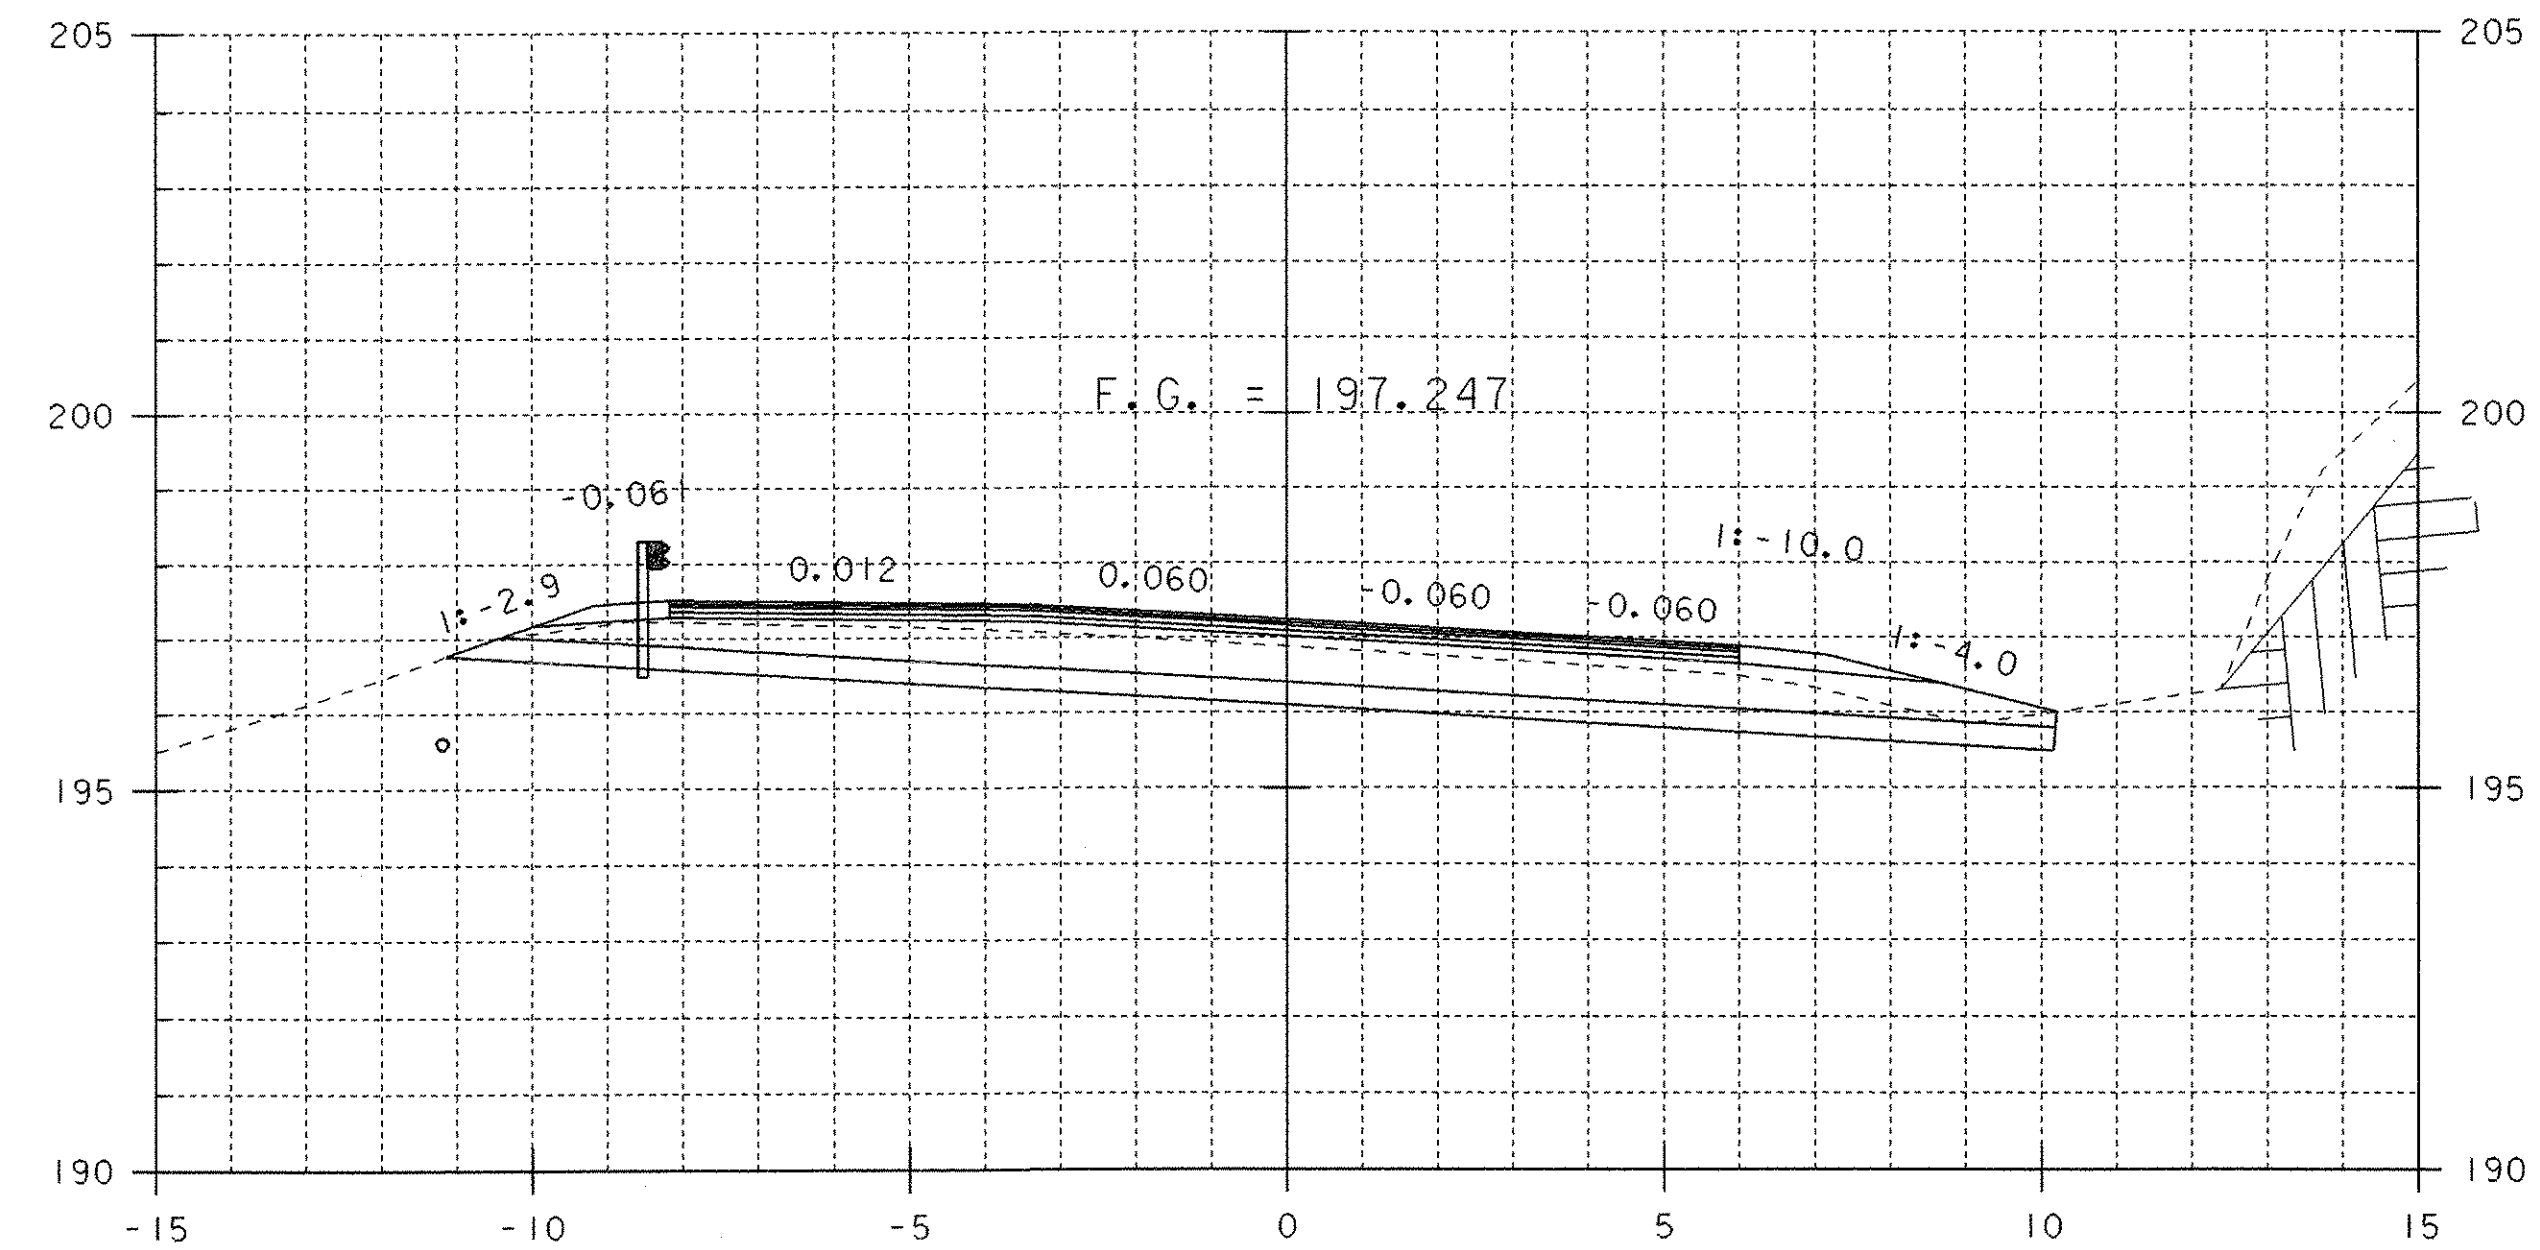

2+230.00

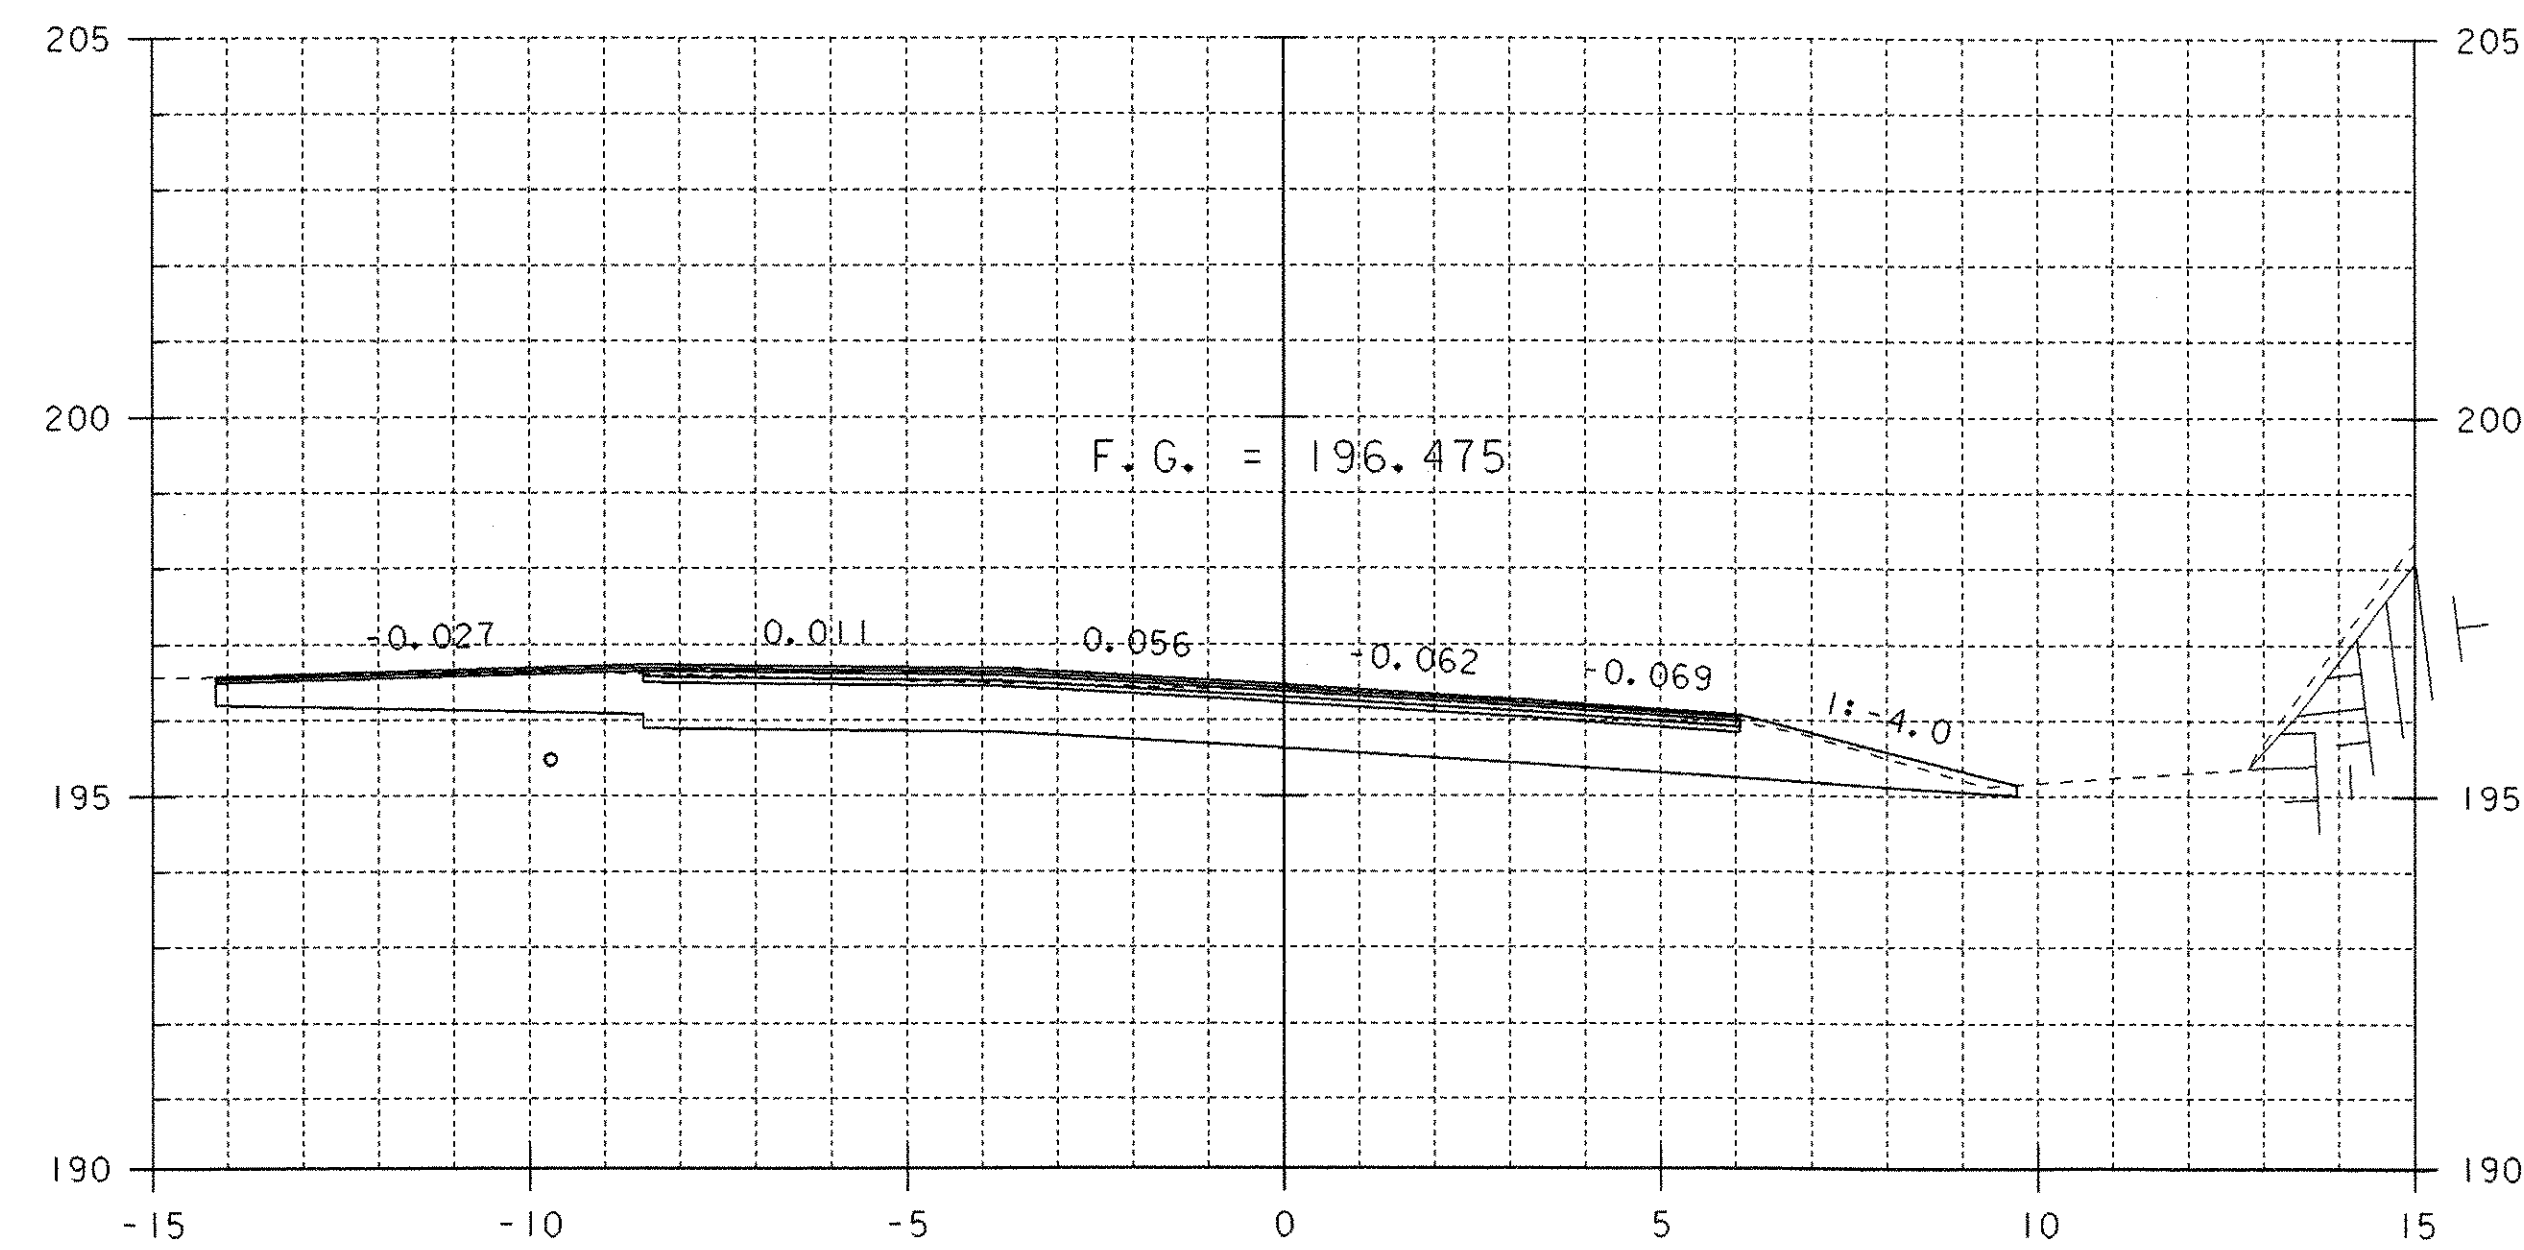


2+200.00

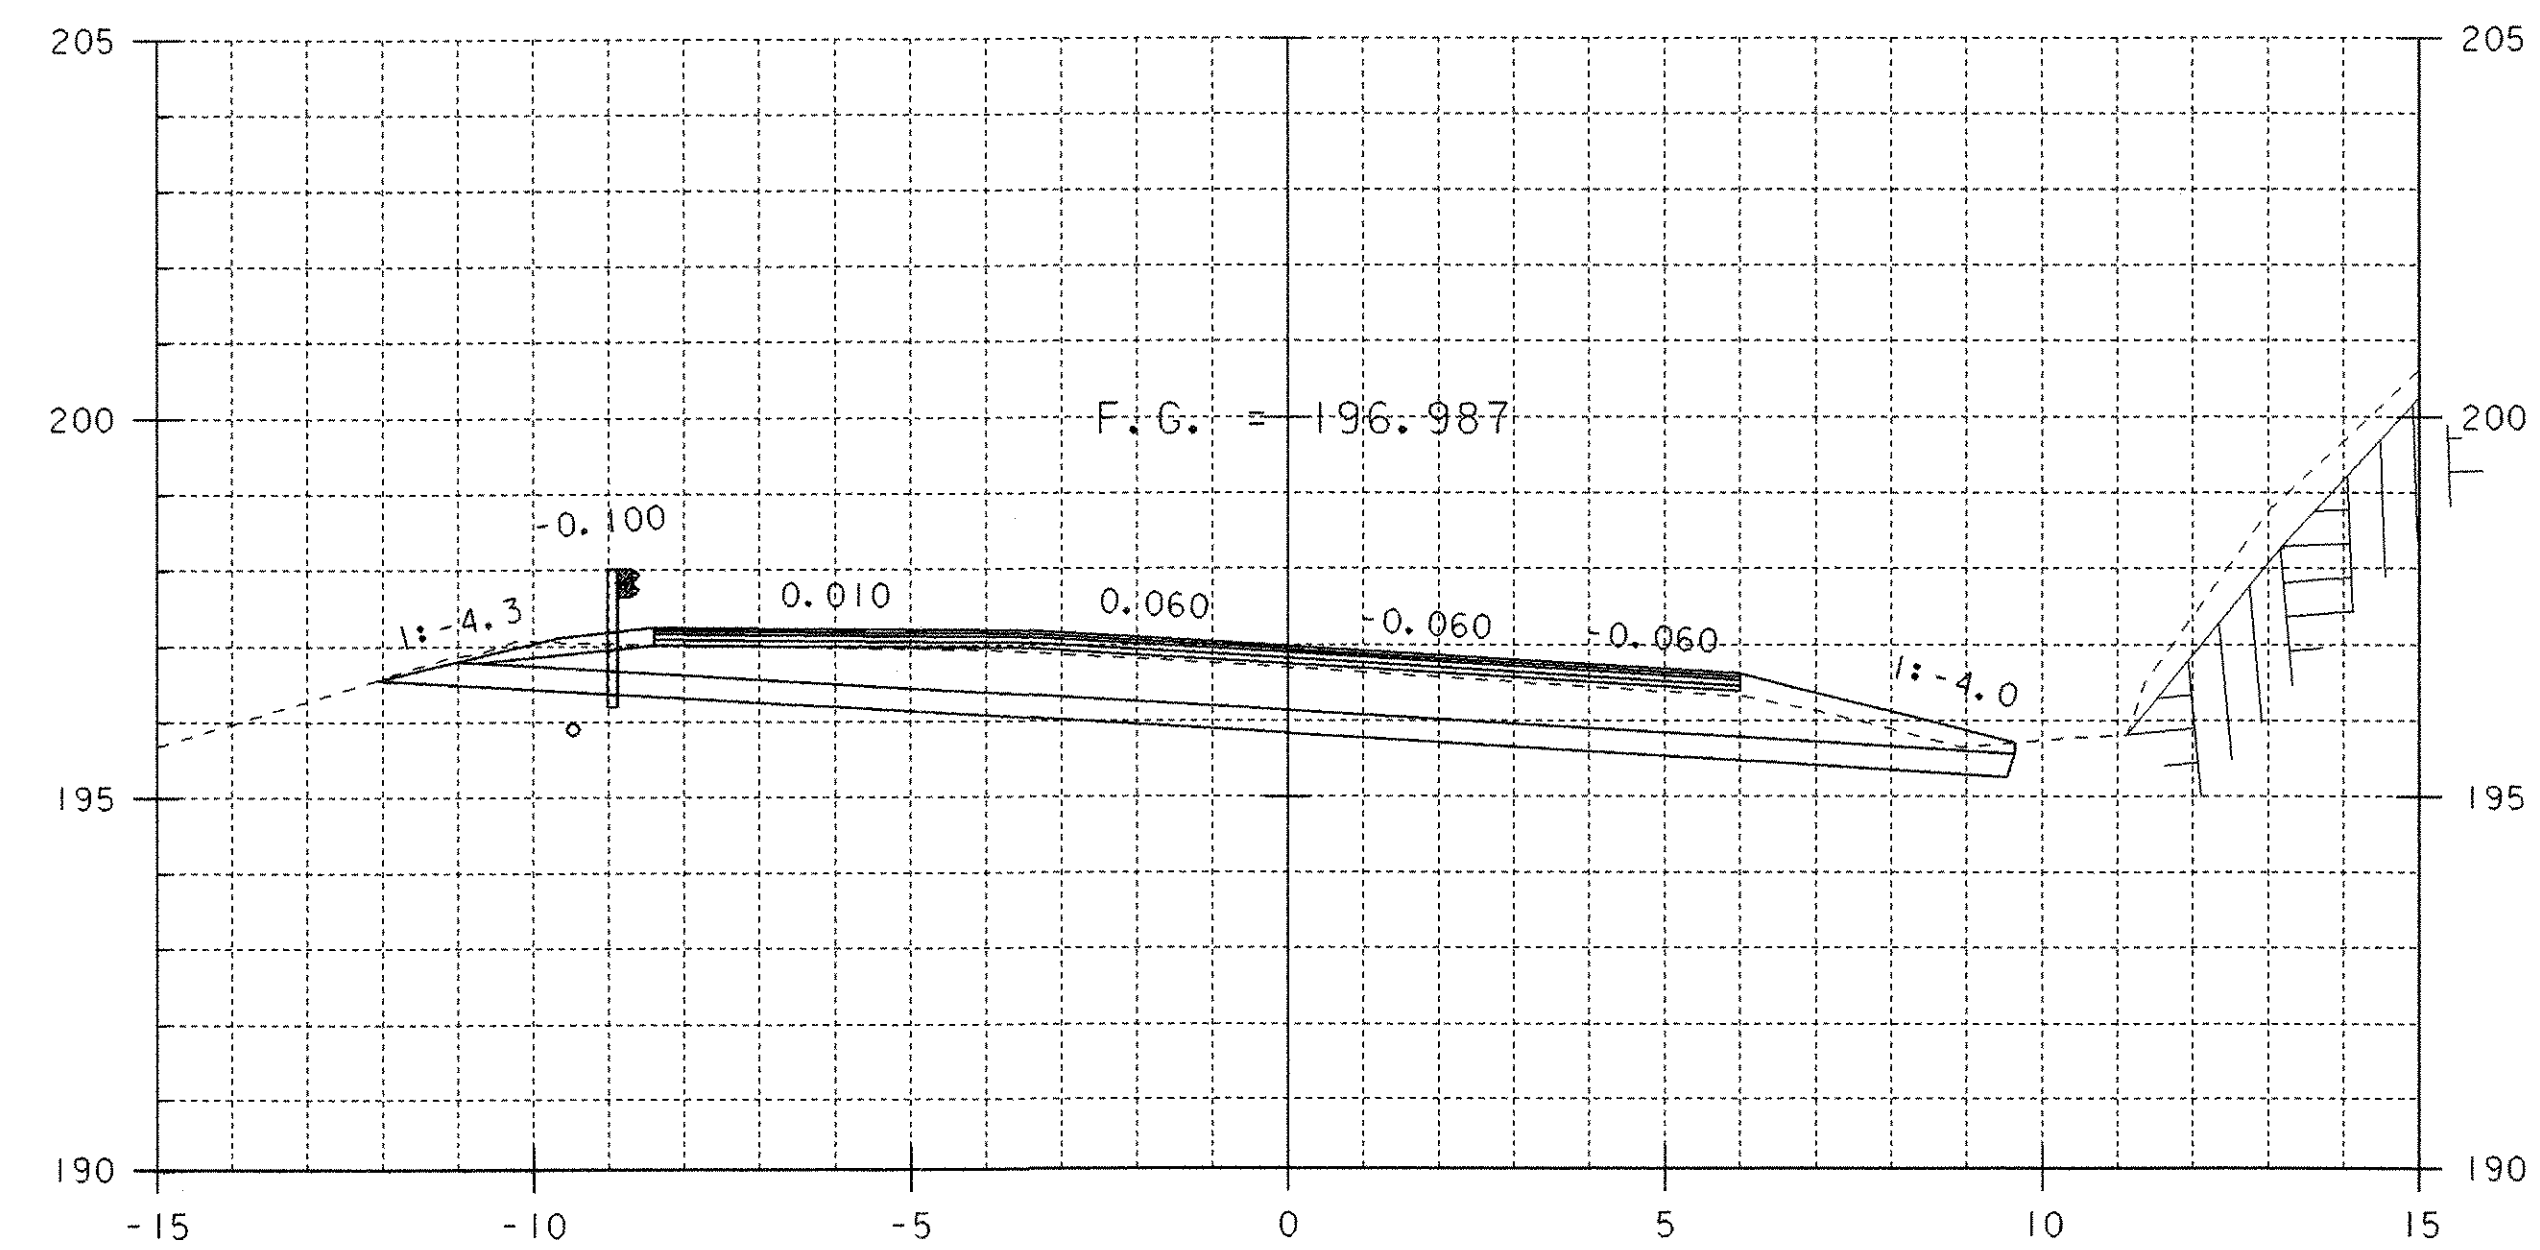

2+220.00

MAINLINE SECTIONS 2

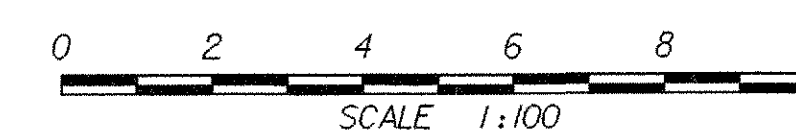

STA. 2+200 TO STA. 2+230

PROJECT NAME: RUTLAND TOWN  
PROJECT NUMBER: BRF 019-3(48)

FILE NAME: 95b172/s1r/sb172xs2.dgn  
PROJECT LEADER: R. WHITCOMB  
DESIGNED BY: L. BULLOCK  
sb172m02.1

PLOT DATE: 11-MAR-2008  
DRAWN BY: L. BULLOCK  
CHECKED BY: T. LACKEY  
SHEET 62 OF 75