


MAINLINE SECTIONS 3

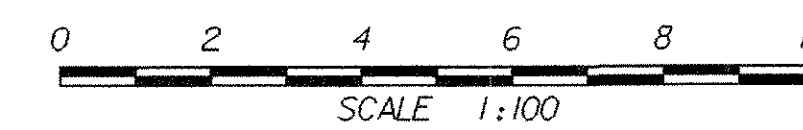

STA. 2+240 TO STA. 2+270

PROJECT NAME:	RUTLAND TOWN	FILE NAME:	95b172/str/sbl72xs2.dgn	PLOT DATE:	11-MAR-2008
PROJECT NUMBER:	BRF 019-3(48)	PROJECT LEADER:	R. WHITCOMB	DRAWN BY:	L. BULLOCK
		DESIGNED BY:	L. BULLOCK	CHECKED BY:	T. LACKEY
			sbl72m03.1	SHEET	63 OF 75