


2+288.000
CL BEARING ABUTMENT 1

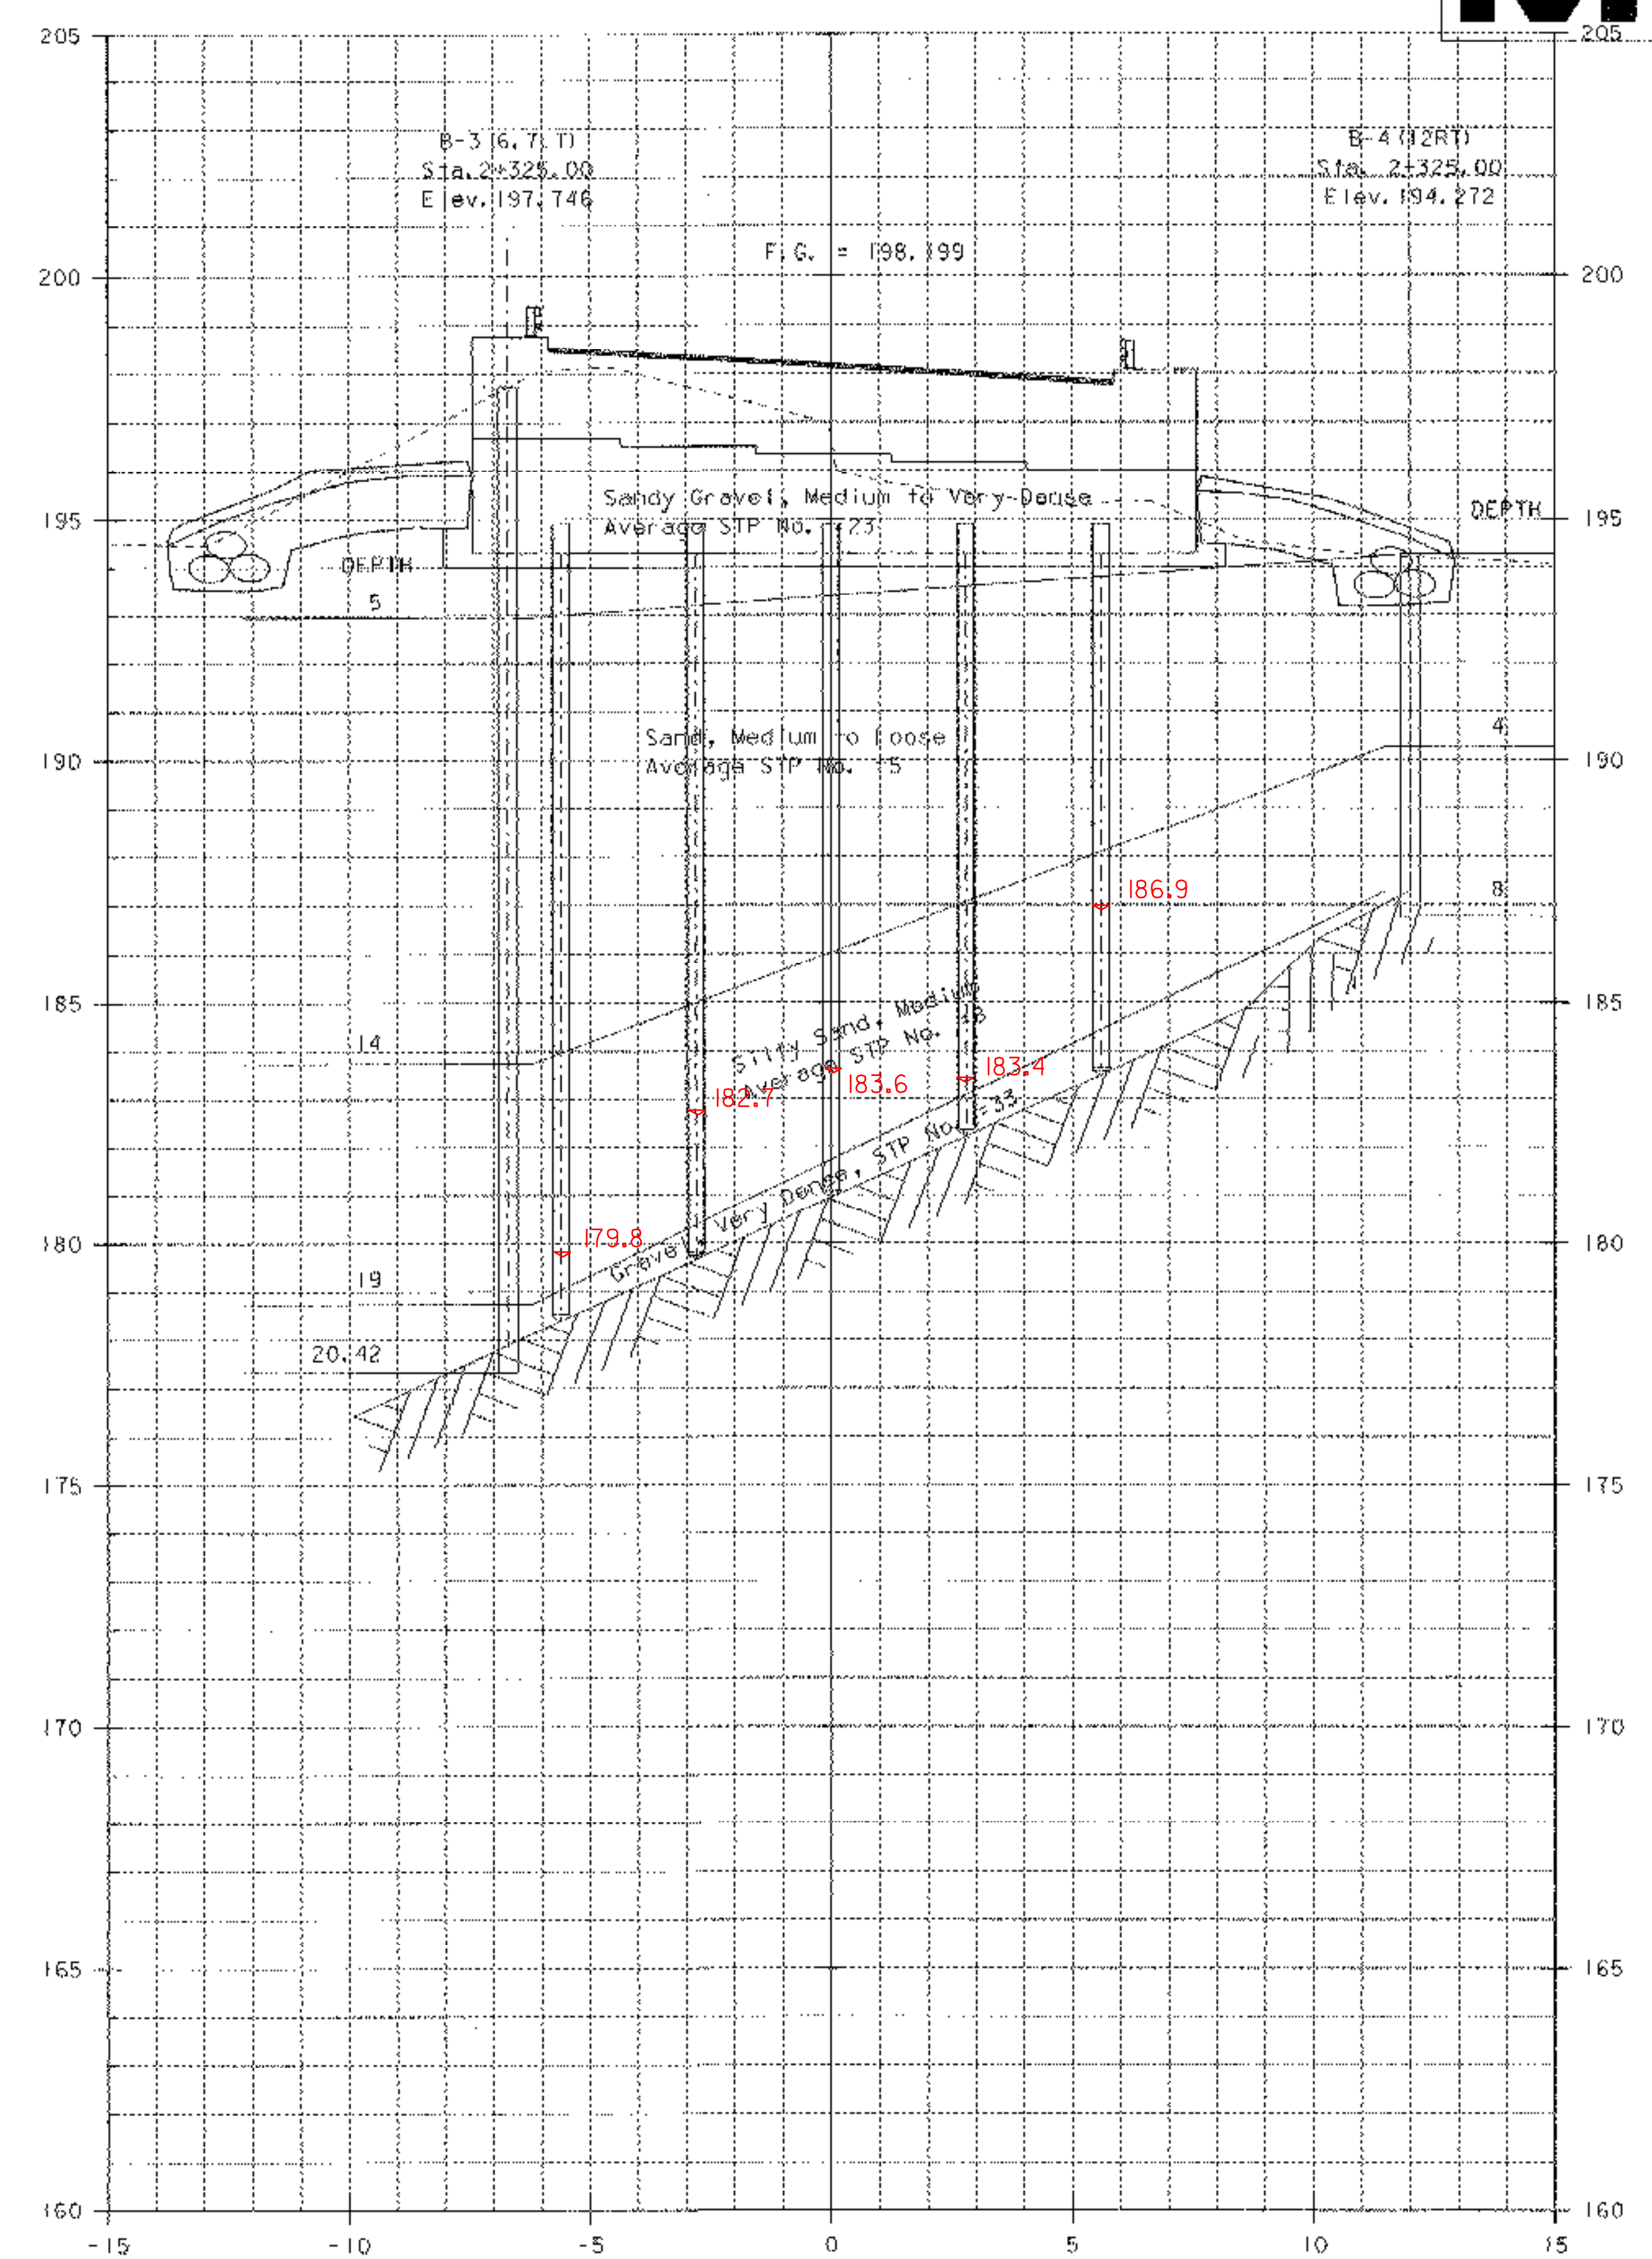

2+322.01
CL BEARING ABUTMENT 2

MAINLINE ABUTMENTS

MAINLINE SECTIONS 10

THE GENERAL NOTES ON THE GEOTECHNICAL PLAN SHEET 41
APPLY TO THE GEOTECHNICAL INFORMATION SHOWN ON THIS SHEET.



PROJECT NAME: RUTLAND TOWN	FILE NAME: 95bit2/str/sb172xs2.dgn	PLOT DATE: 11-MAR-2008
PROJECT NUMBER: BRF 019-3(48)	PROJECT LEADER: R. WHITCOMB	DRAWN BY: T. LACKEY
	DESIGNED BY: T. LACKEY	CHECKED BY:
	sb172m10.j	SHEET 70 OF 75