


CHANNEL SECTIONS 3

PROJECT NAME: RUTLAND TOWN  
 PROJECT NUMBER: BRP 019-3(48)

FILE NAME: sb172c03.1  
 PROJECT LEADER: R. WHITCOMB  
 DESIGNED BY: T. LACKEY  
 95b172/str/sb172xs2.dgn

PLOT DATE: 11-MAR-2008  
 DRAWN BY: T. LACKEY  
 CHECKED BY:  
 SHEET 75 OF 75

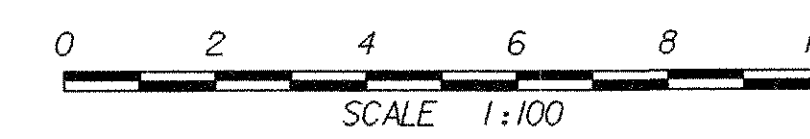

STA. I+035 TO STA. I+040