


DATUM

VERTICAL	NGVD 1929
HORIZONTAL	NAD 1983

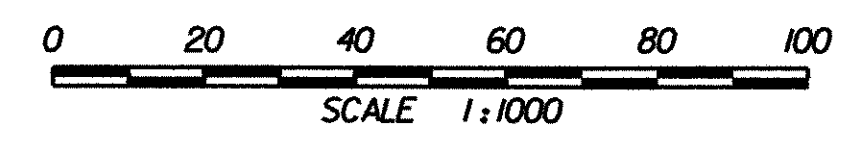

ALIGNMENT PLAN

PROJECT NAME:	BRATTLEBORO
PROJECT NUMBER:	NH 010-2(2)
FILE NAME:	ZB270BD3
PROJECT LEADER:	JHR
DESIGNED BY:	GJB
PLOT DATE:	10-01-2002
DRAWN BY:	LB/LRD
CHECKED BY:	TEM/JHR
SHEET	3 OF 145