
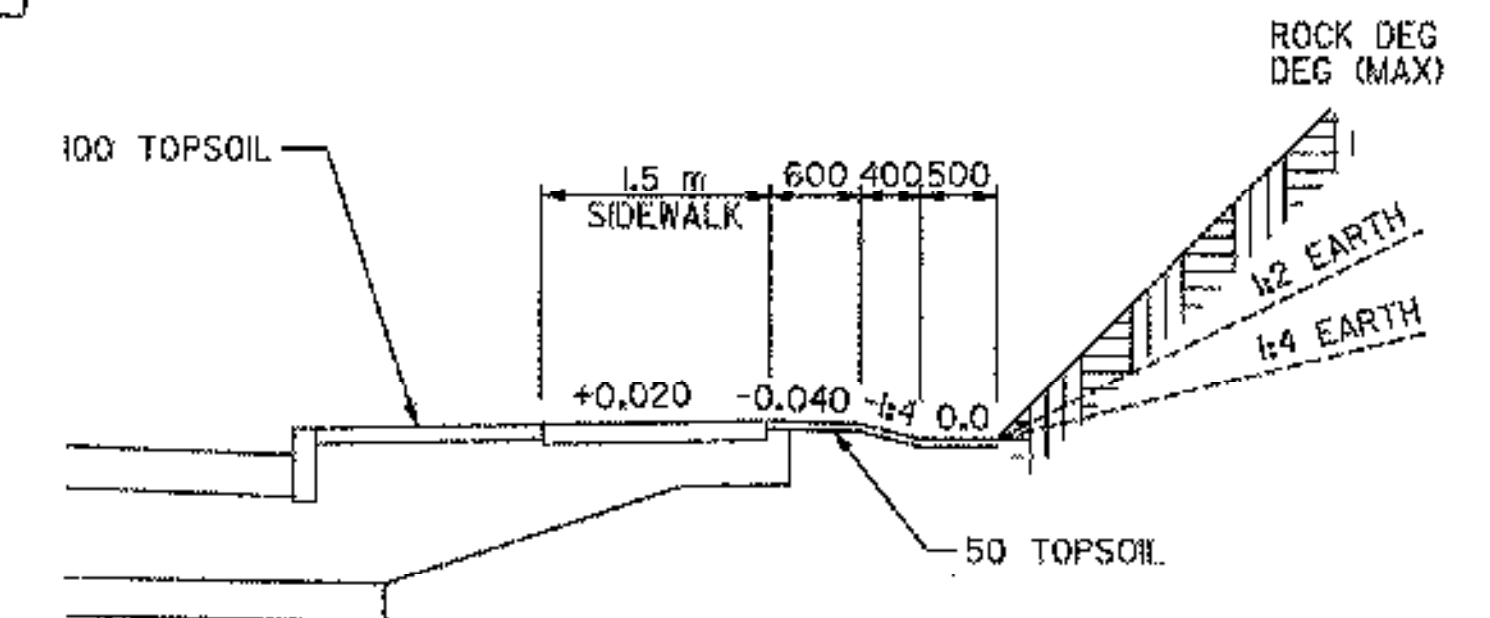
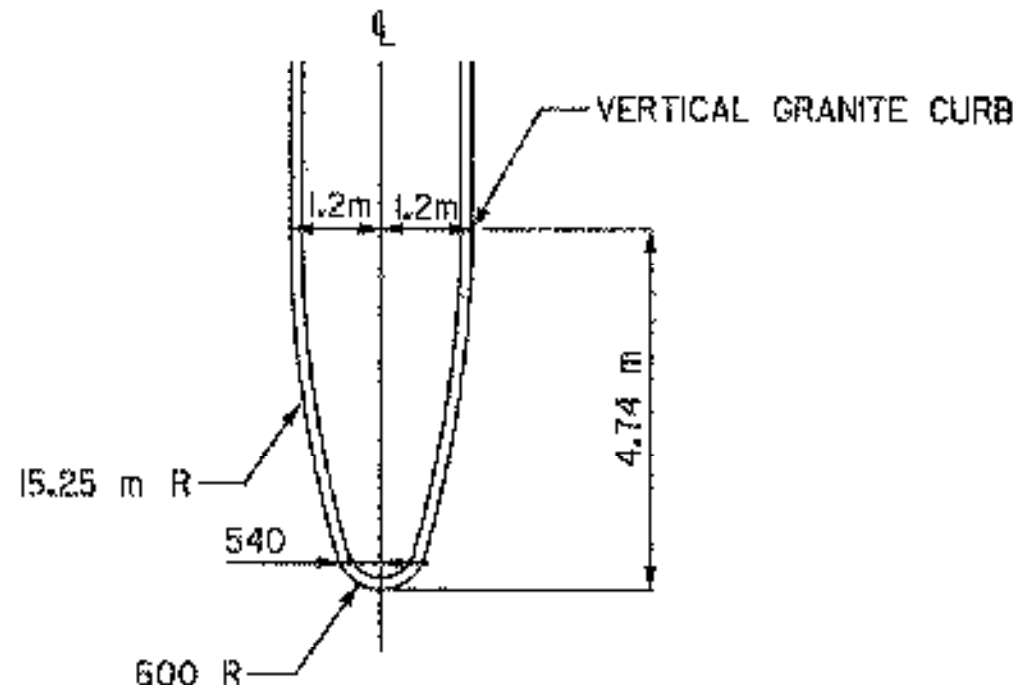
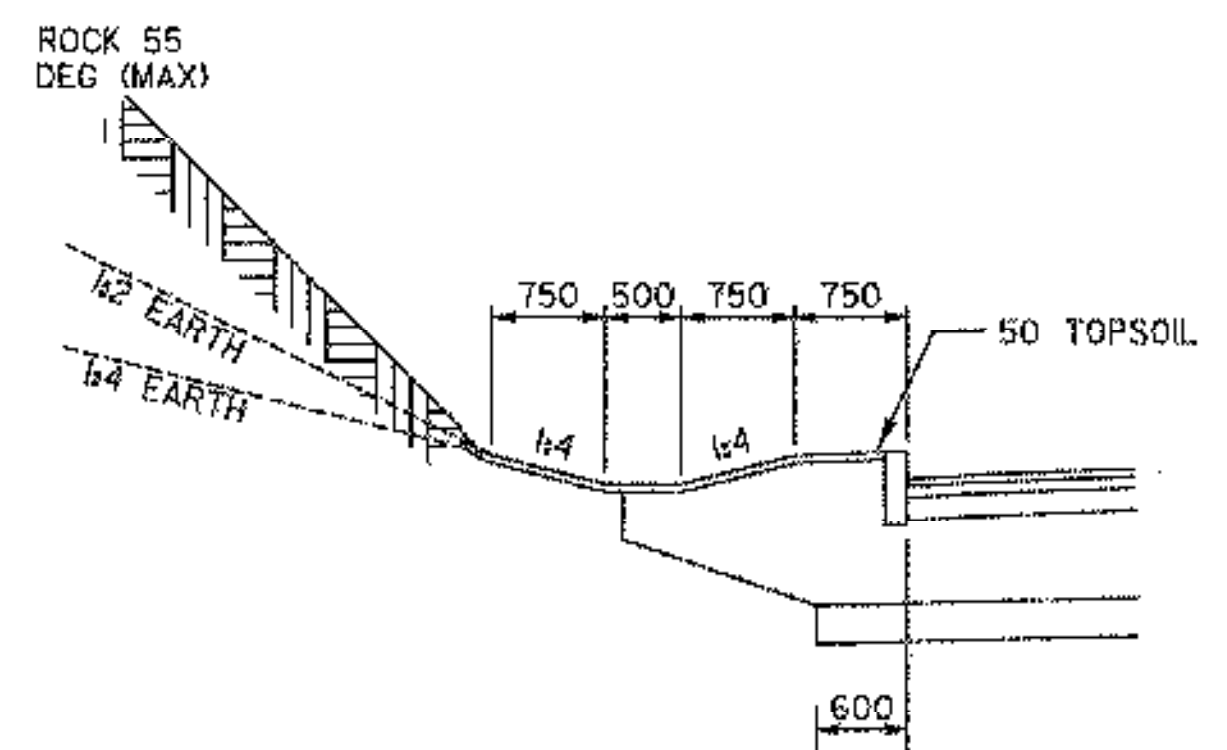
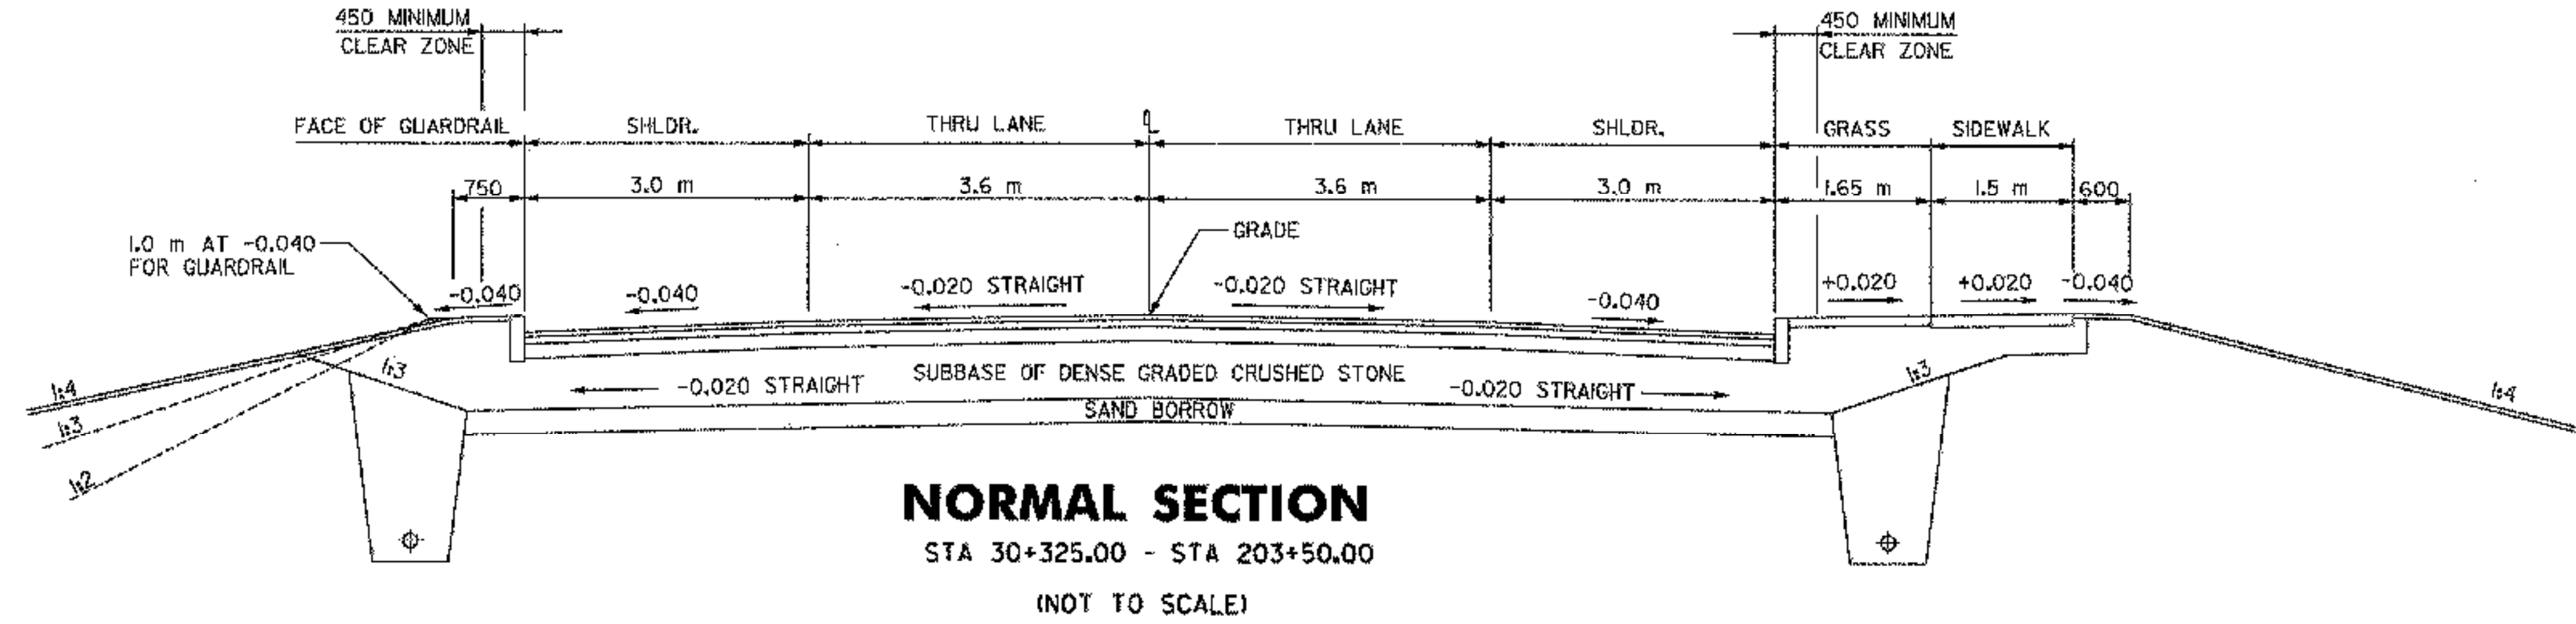


# TYPICAL ROADWAY SECTIONS

MATERIAL ITEM	THICKNESS TOLERANCE
PAVEMENT (TOTAL DEPTH ALL LAYERS)	+/- 5
SUBBASE	+/- 30
SAND BORROW	+/- 30

- 50 BITUMINOUS CONCRETE PAVEMENT (TYPE IIS) (PG 70-28)
- 75 BITUMINOUS CONCRETE PAVEMENT (TYPE IIS) (PG 70-28)
- 150 BITUMINOUS CONCRETE PAVEMENT (TYPE IS) (PG 70-28) (2-75mm LIFTS)
- 600 SUBBASE OF DENSE GRADED CRUSHED STONE
- 250 SAND BORROW (IN EARTH AREAS)
- 75 SAND BORROW (IN ROCK AREAS)

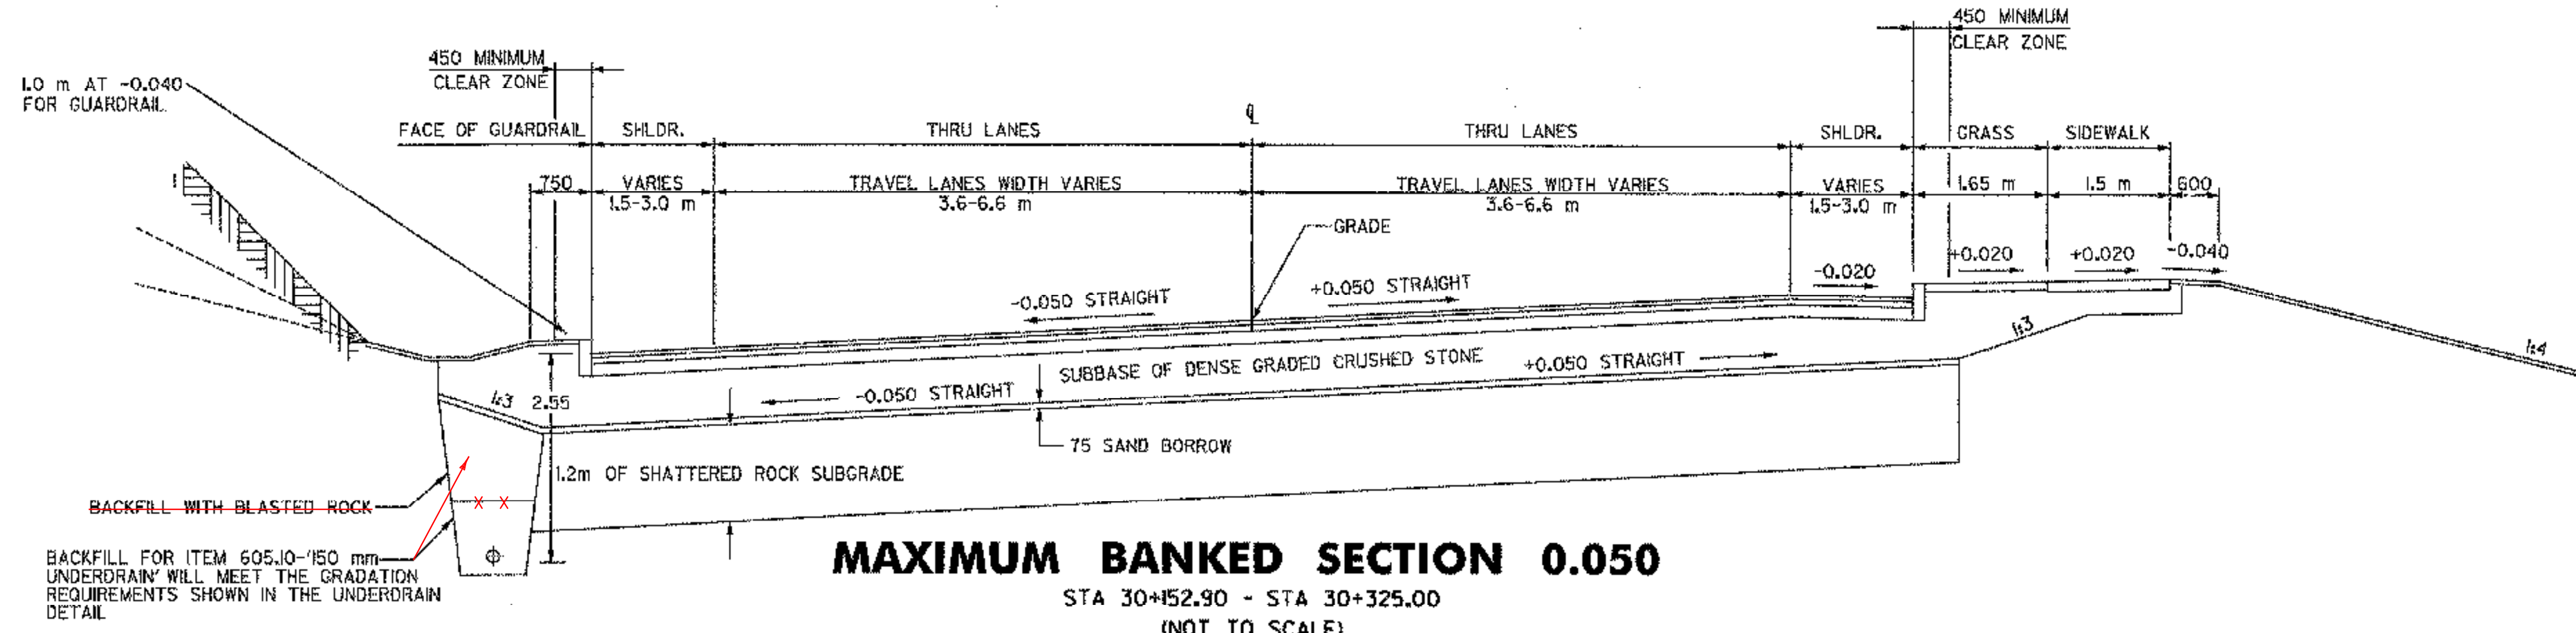

NOTE: UNLESS OTHERWISE NOTED IN THESE PLANS, ALL ELEVATIONS ARE IN METERS AND ALL DIMENSIONS ARE IN MILLIMETERS

DATUM	
VERTICAL	NGVD 1929
HORIZONTAL	NAD 1983

PROJECT: BRATTLEBORO	PROJECT NO. # NH 010-2(2)
DESIGN FILE NAME: ...zb270+yp.dgn	PLOT DATE: 09/20/2002
IPARM FILE NAME:	SURVEY DATE:
SURVEYED BY:	DRAWN BY: P SHEDO
SQUAD LEADER: W HUSBAND	SHEET: 9 OF 145
CLD REF NO. 00-0356	