



**TYPICAL TRACK TRANSITION SECTION
STA 50+500 TO STA 50+580**

SCALE 1:50

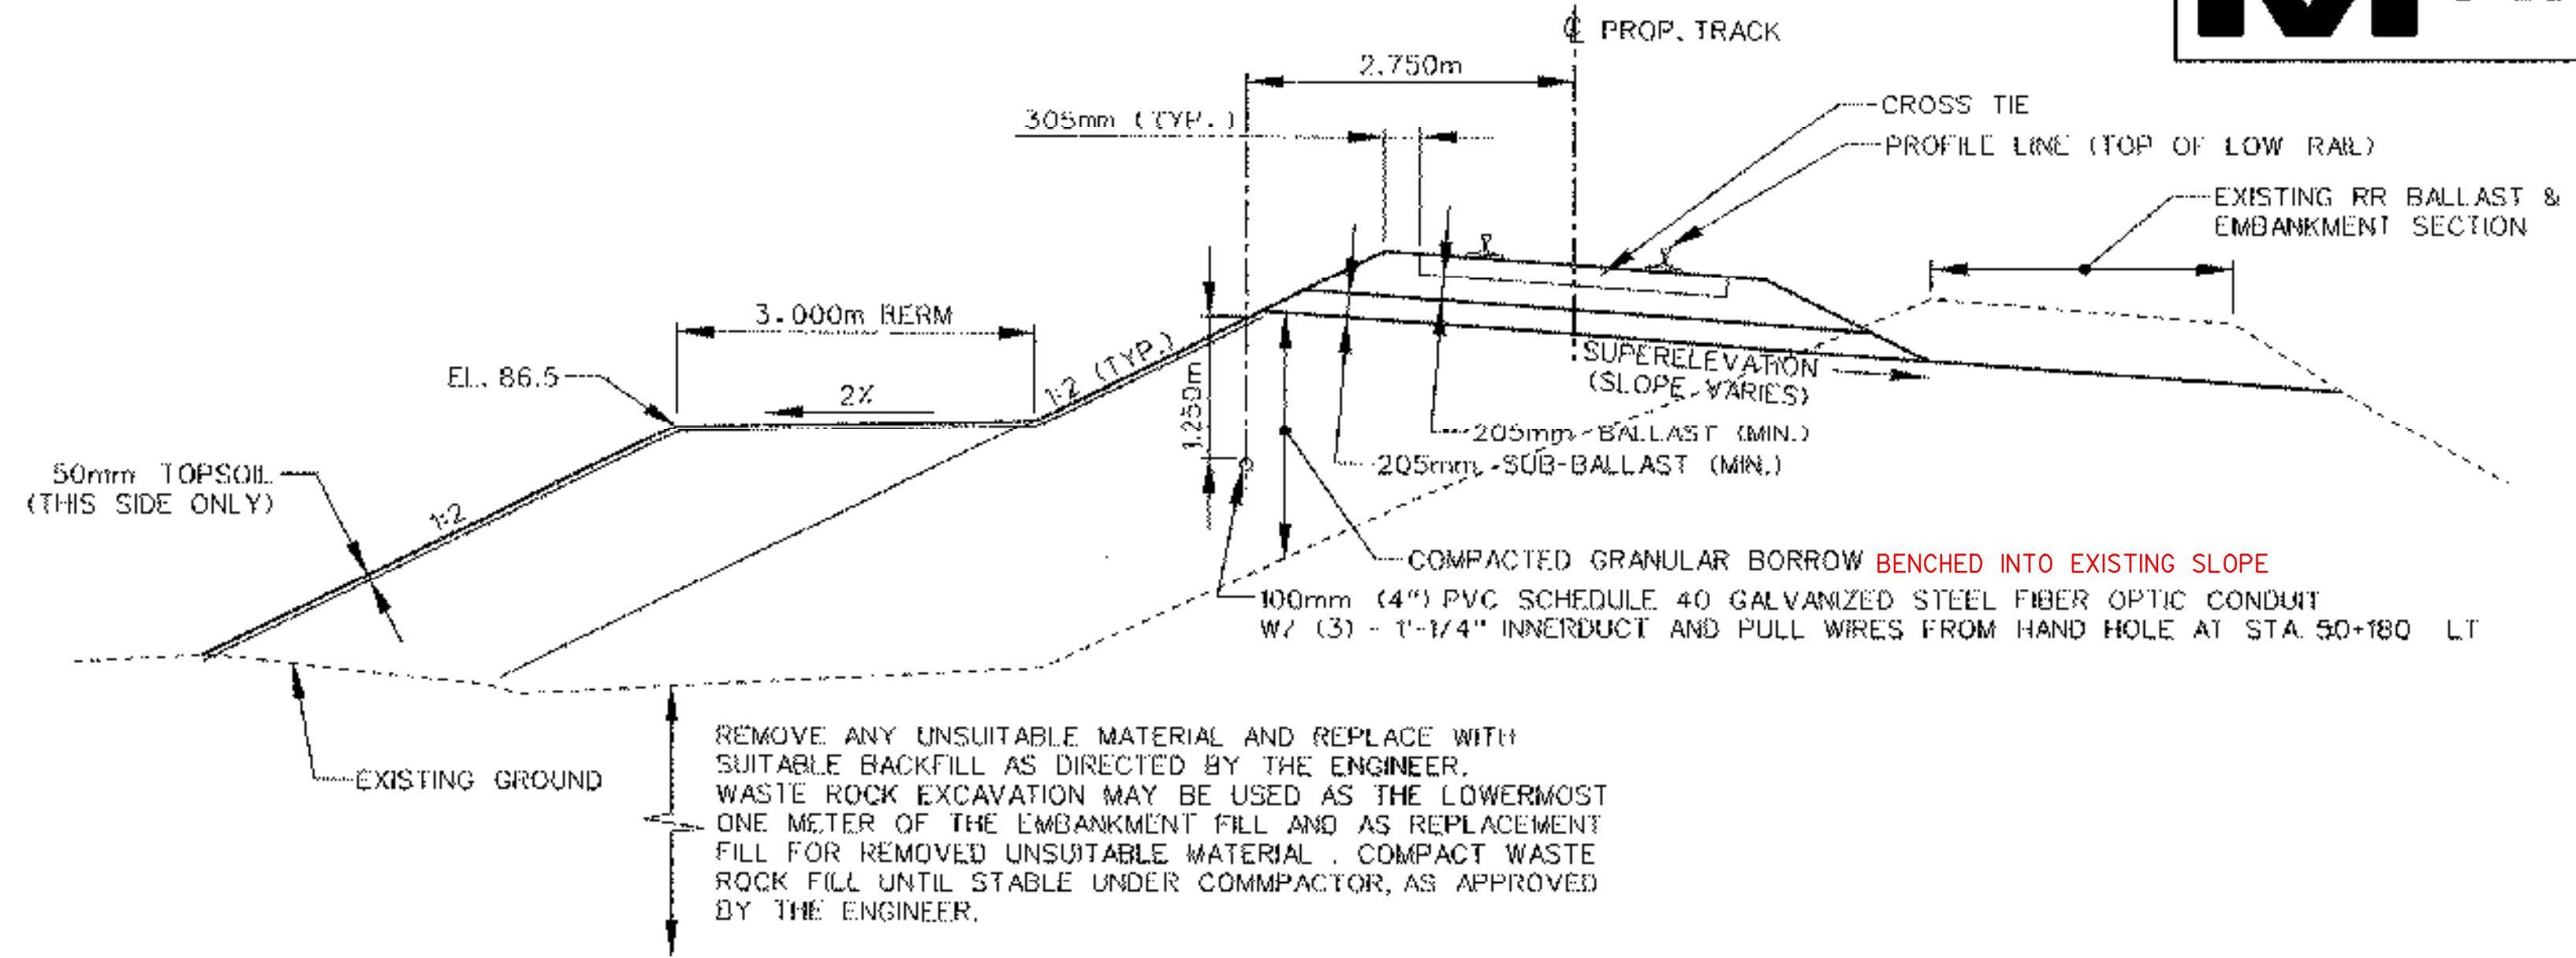

**TYPICAL BERM SECTION
FULL DEPTH CONSTRUCTION
STA 50+193.123 TO STA 50+254.520
(SARGENT BROOK TO VT ROUTE 9)**

SCALE 1:50

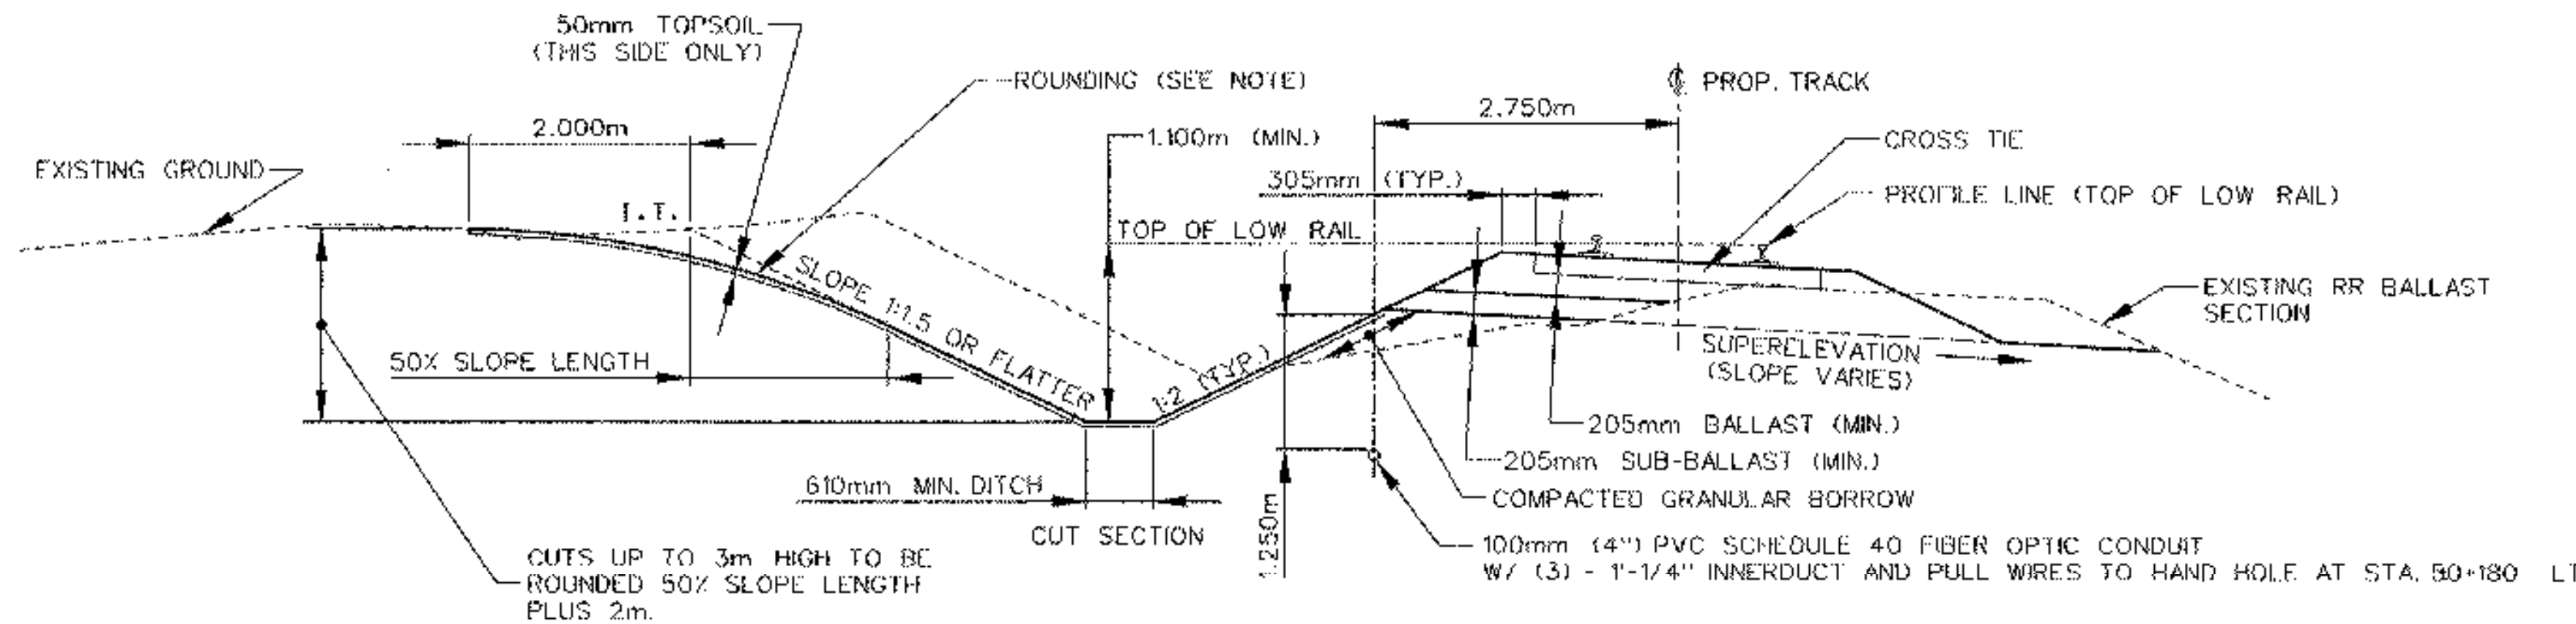


**TYPICAL TRACK TRANSITION SECTION
STA 50+120 TO STA 50+186.417**

SCALE 1:50


NOTE:

WHEN STEEPNESS OF EXISTING GROUND, SHALLOWNESS OF CUT OR PRESENCE OF EXISTING VEGETATION OR BUILDINGS IS CONSIDERED A FACTOR PREVENTING NORMAL ROUNDING, THE EXTENT OF THE ROUNDING SHOULD BE MODIFIED TO MEET CONDITIONS. SEE NOTE 3.

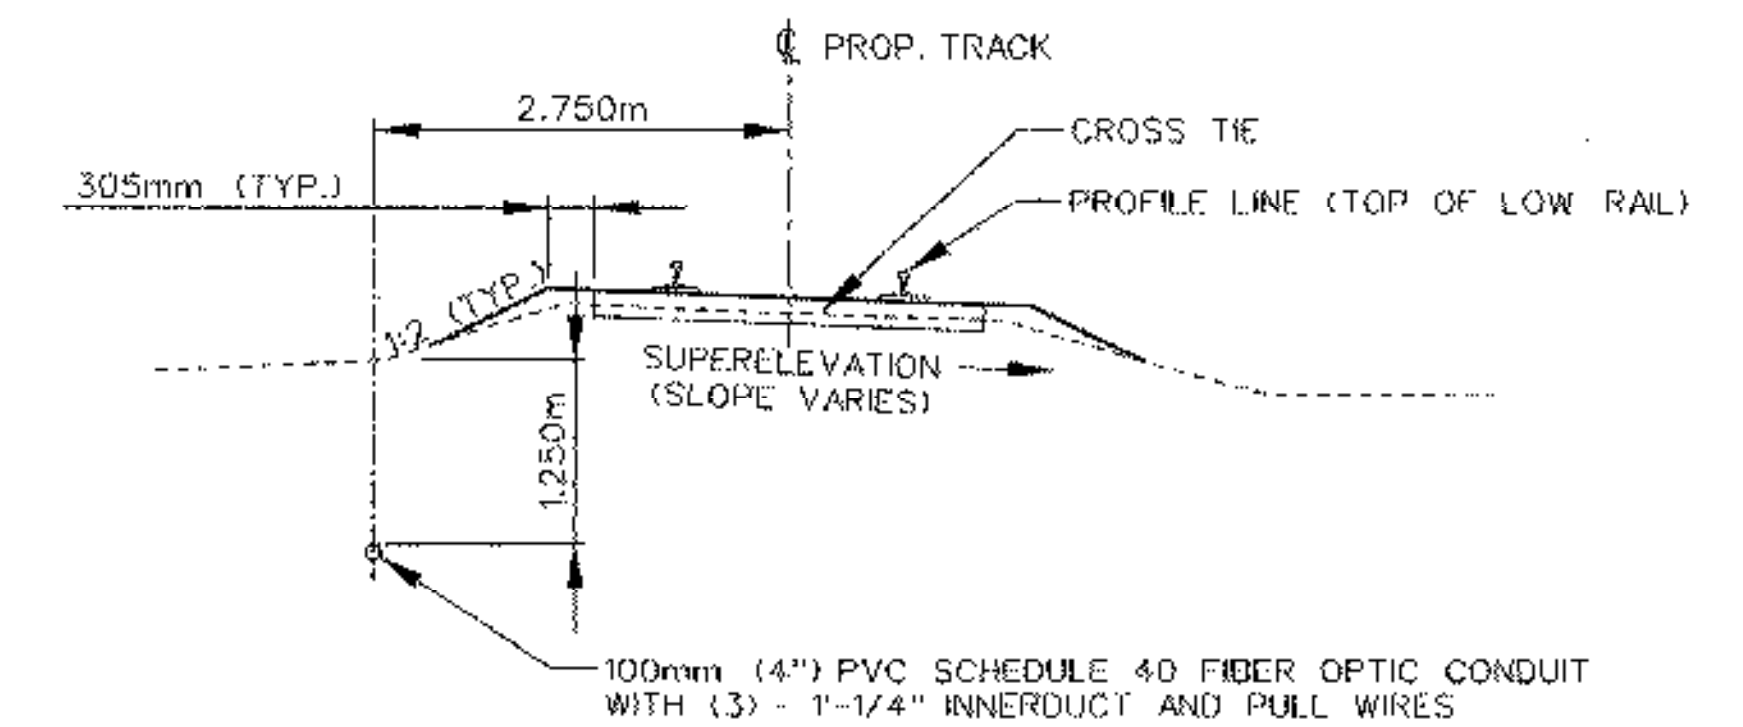

**TYPICAL TRACK REHABILITATION SECTION
STA 50+020 TO STA 50+120
STA 50+580 TO STA 50+698.603**

SCALE 1:50

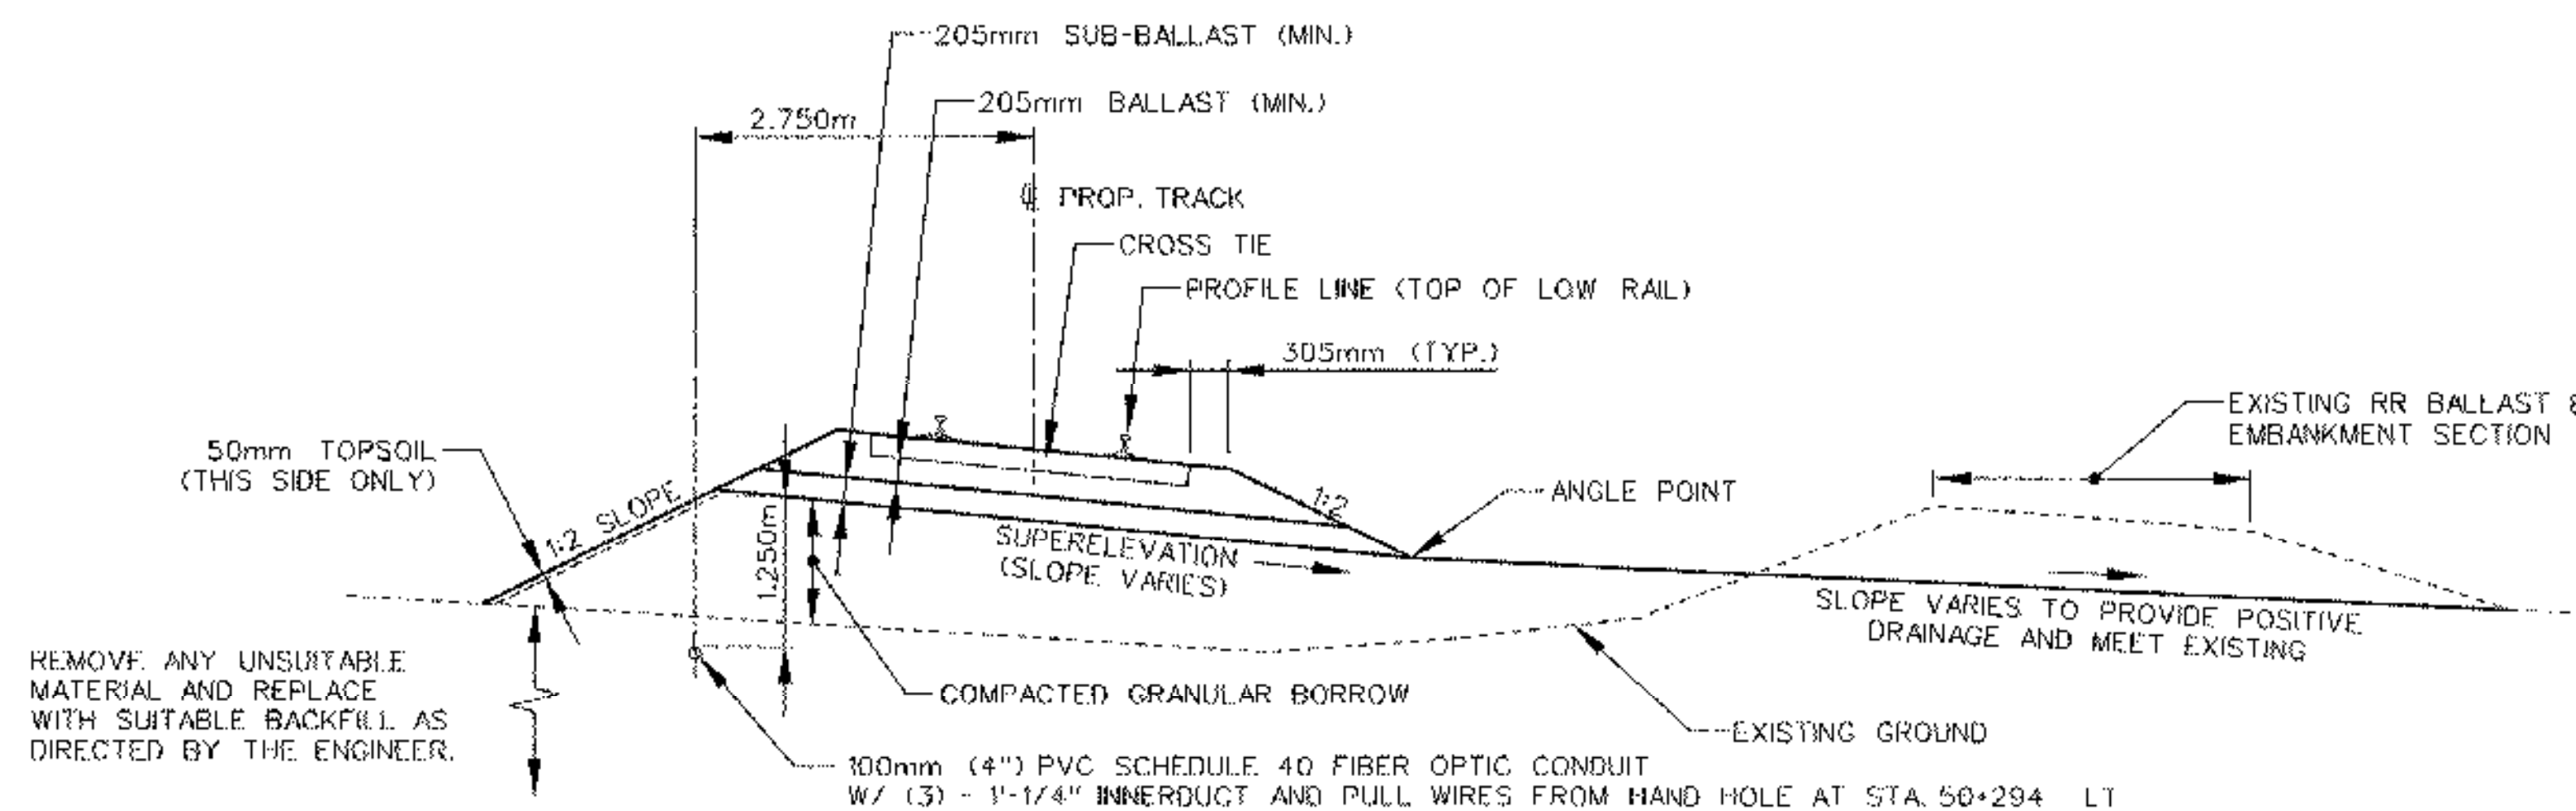

**TYPICAL SUPERELEVATED TRACK SECTION - (ON CURVE)
FULL DEPTH CONSTRUCTION
STA 50+285.220 TO STA 50+500**

SCALE 1:50

NOTES:

- REFER TO ROADWAY TYPICAL SECTIONS FOR "GENERAL NOTES FOR ROADWAY TYPICALS", AND UTILIZE AS APPLICABLE TO RAILROAD TYPICAL SECTIONS. NOTE THAT TOPSOIL AND/OR SEED IS NEVER TO BE APPLIED ABOVE RAILROAD SUBGRADE ELEVATION.
- RAIL TO BE 115 POUND CONTINUOUS WELDED RAIL. CROSS TIES TO BE 7"X9"X8'-6" TIMBER. BALLAST TO BE STONE BALLAST, SIZE #4. SUB-BALLAST TO BE SCREENED GRAVEL. ALL ABOVE MATERIALS MUST MEET THE REQUIREMENTS OF AREMA. (WORK BY OTHERS)
- ALLOWANCE FOR ROUNDING HAS NOT BEEN INDICATED ON RAILROAD PLANS AND CROSS SECTIONS. DUE TO UNTYPICAL CONDITIONS IN CUT, ROUNDINGS WILL BE AS DIRECTED BY THE ENGINEER.

DATUM	
VERTICAL	NGVD 1929
HORIZONTAL	NAD 1983

RAILROAD TYPICAL SECTIONS	PROJECT NAME:	BRATTLEBORO
	PROJECT NUMBER:	NH 010-2(2)
	FILE NAME:	track sections
	PROJECT LEADER:	JHR
	DESIGNED BY:	GJB
	PLOT DATE:	10-01-2002
	DRAWN BY:	DHL
	CHECKED BY:	TEM
	SHEET	10 OF 145