
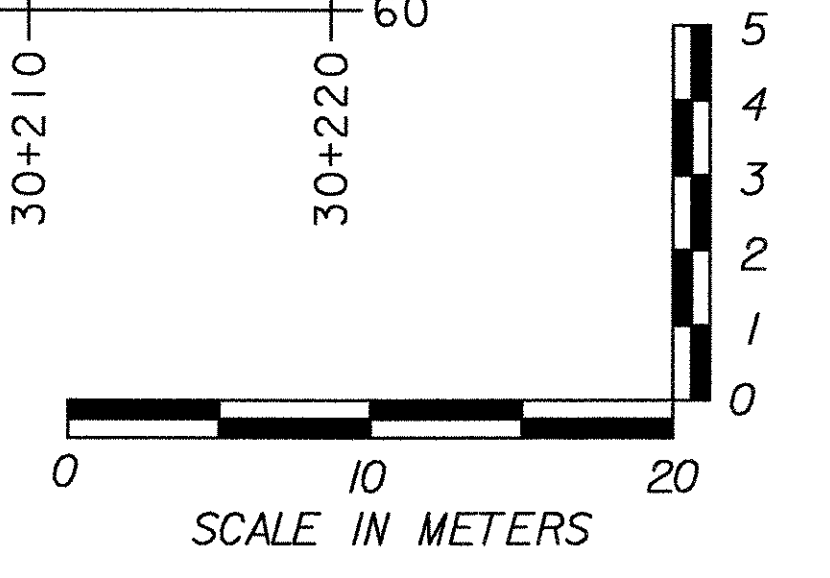


PROFILE - VT ROUTE 9

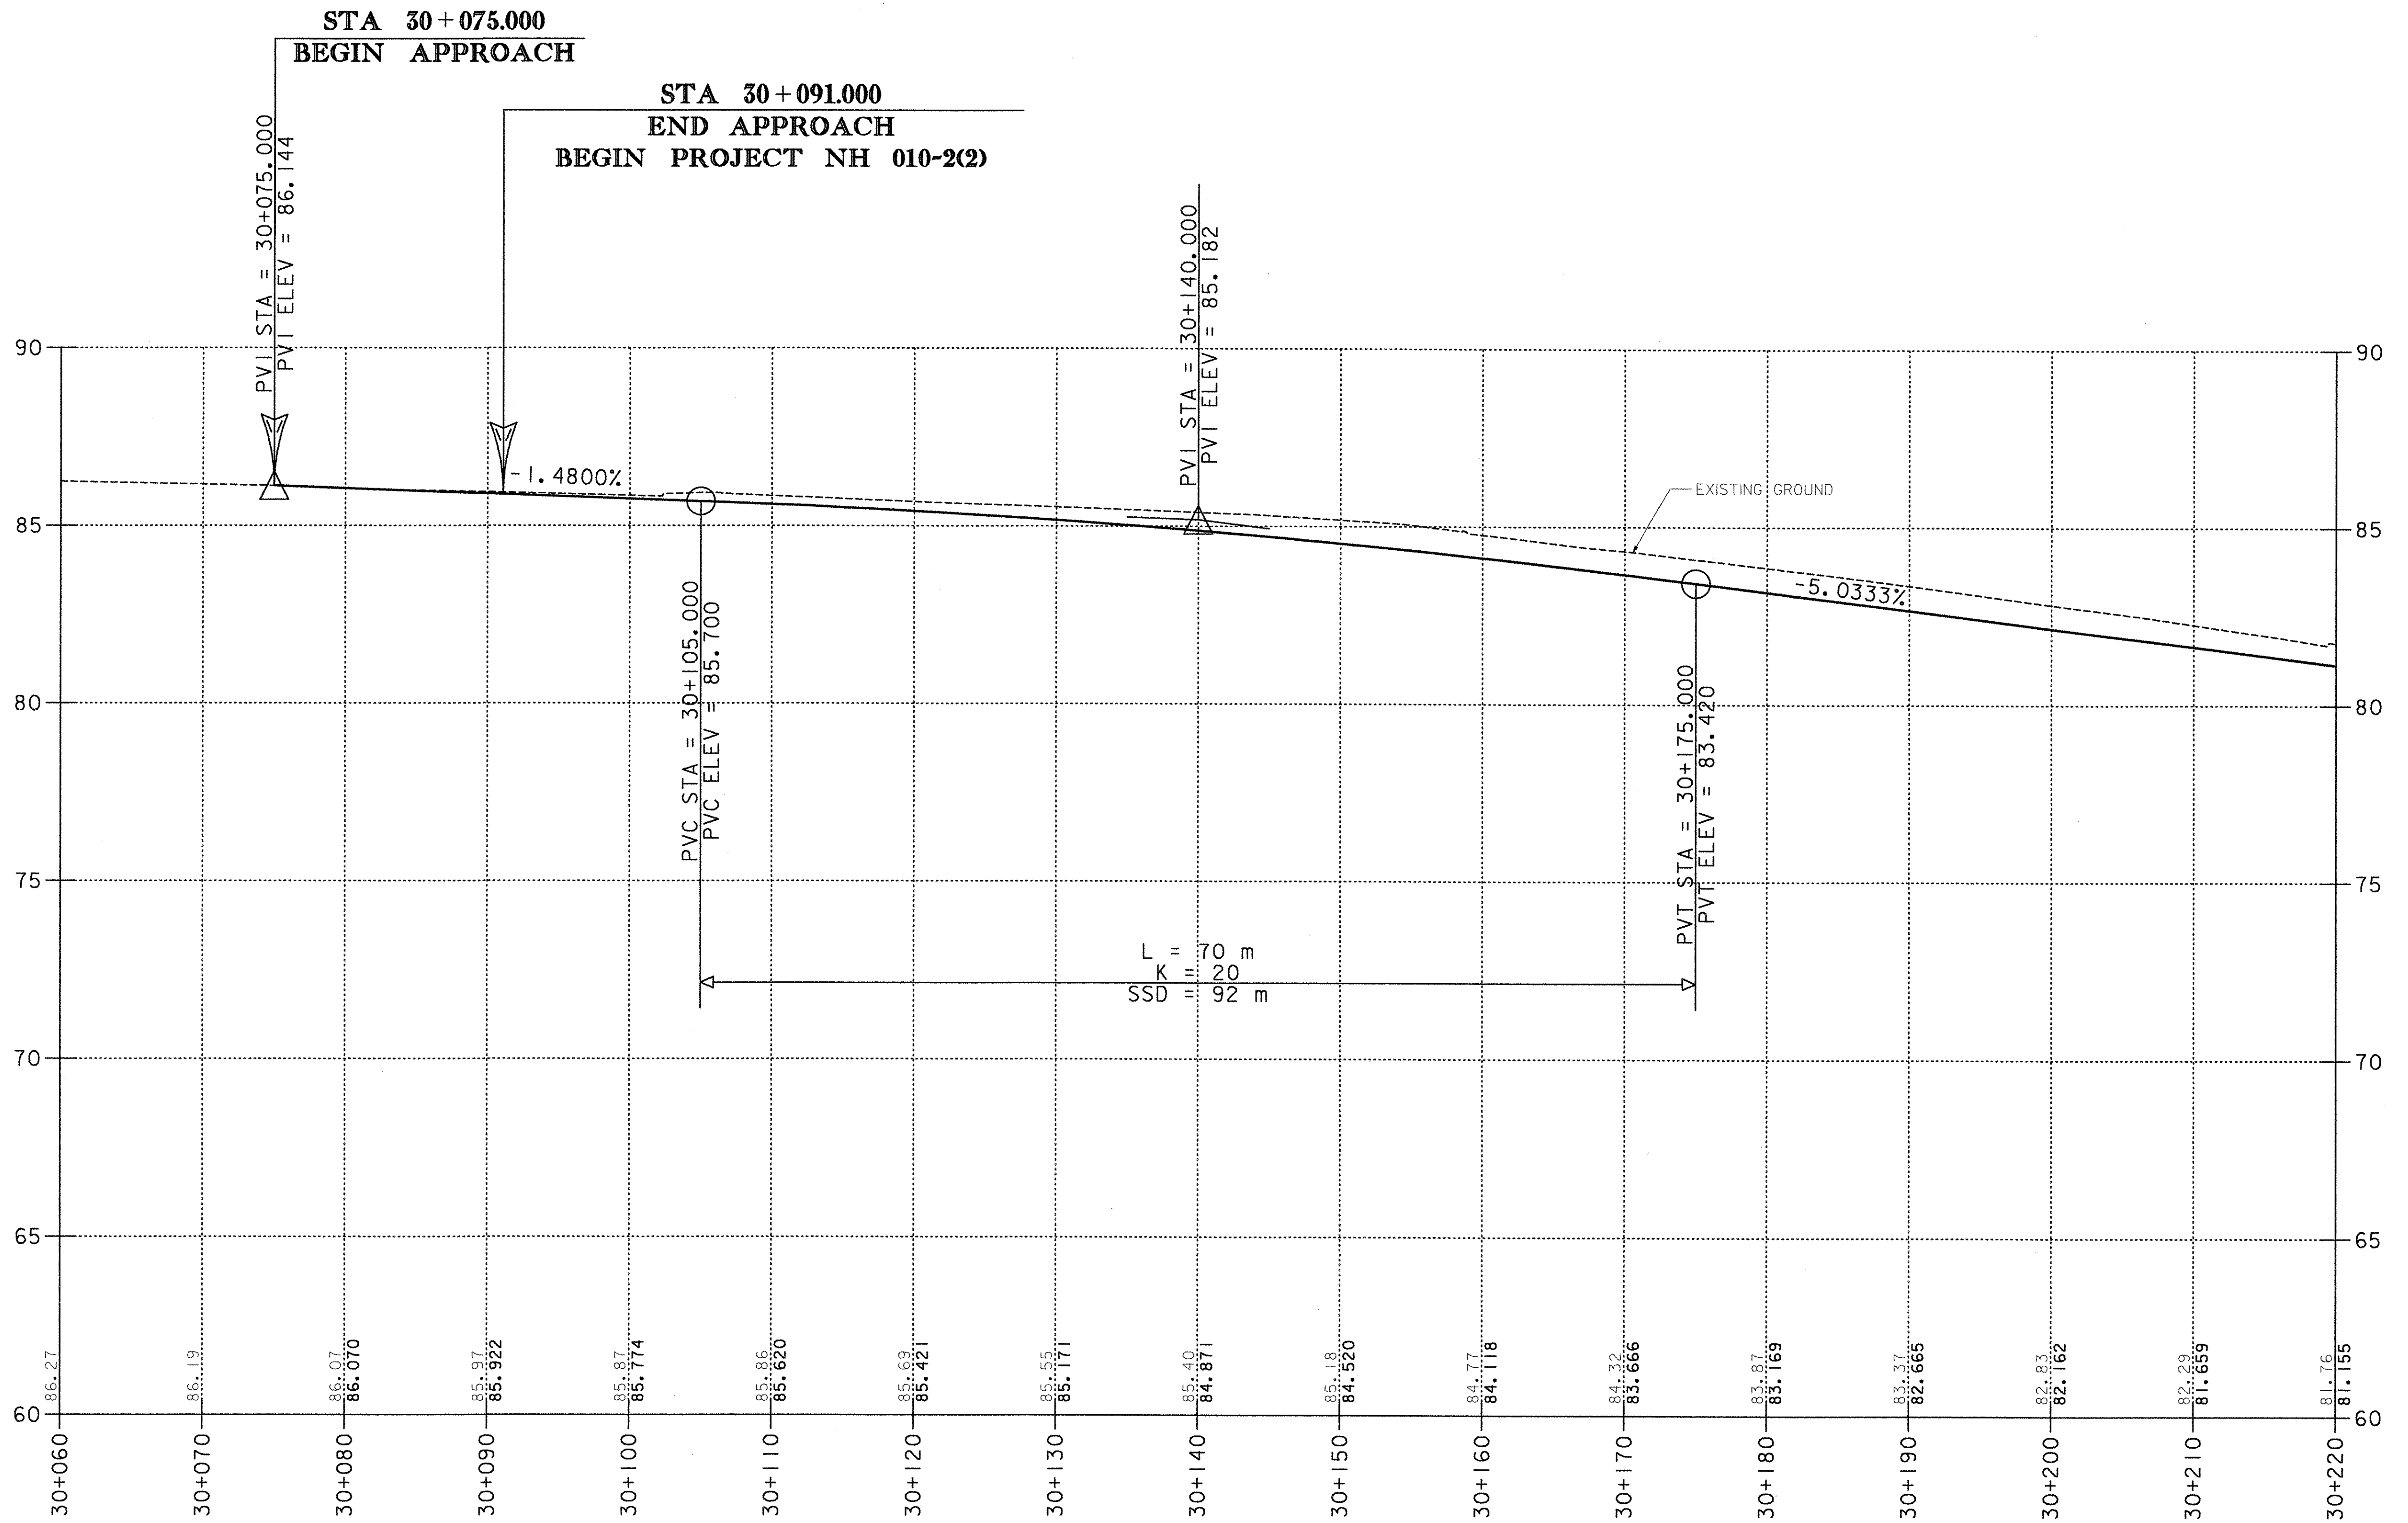

DATUM
 VERTICAL NGVD 1929
 HORIZONTAL NAD 1983

| | |
|-------------------------------------|------------------------------|
| PROJECT: BRATTLEBORO | PROJECT NO. : NH 010-2(2) |
| DESIGN FILE NAME: ... \zb270xs2.dgn | PLOT DATE: 09/20/2002 |
| IPARM FILE NAME: | SURVEY DATE: |
| SURVEYED BY: | DRAWN BY: P SHEDD |
| SQUAD LEADER: W HUSBAND | SHEET: 39 OF 145 |
| CLD REF NO. 00-0358 | |