
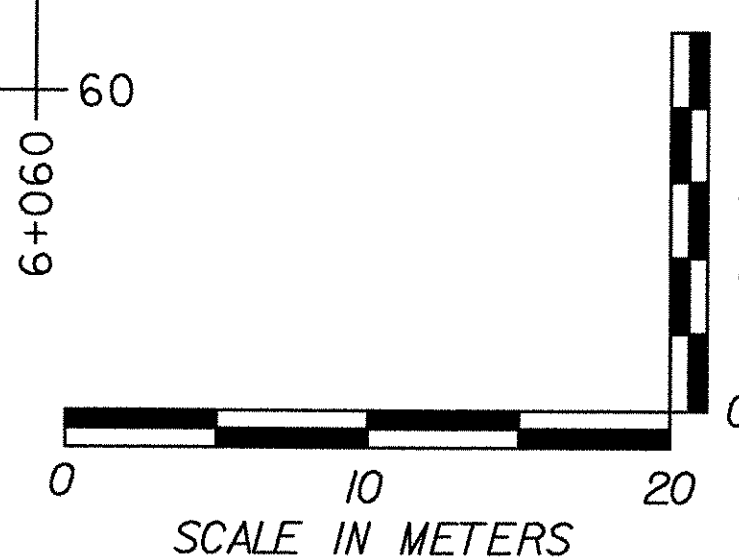
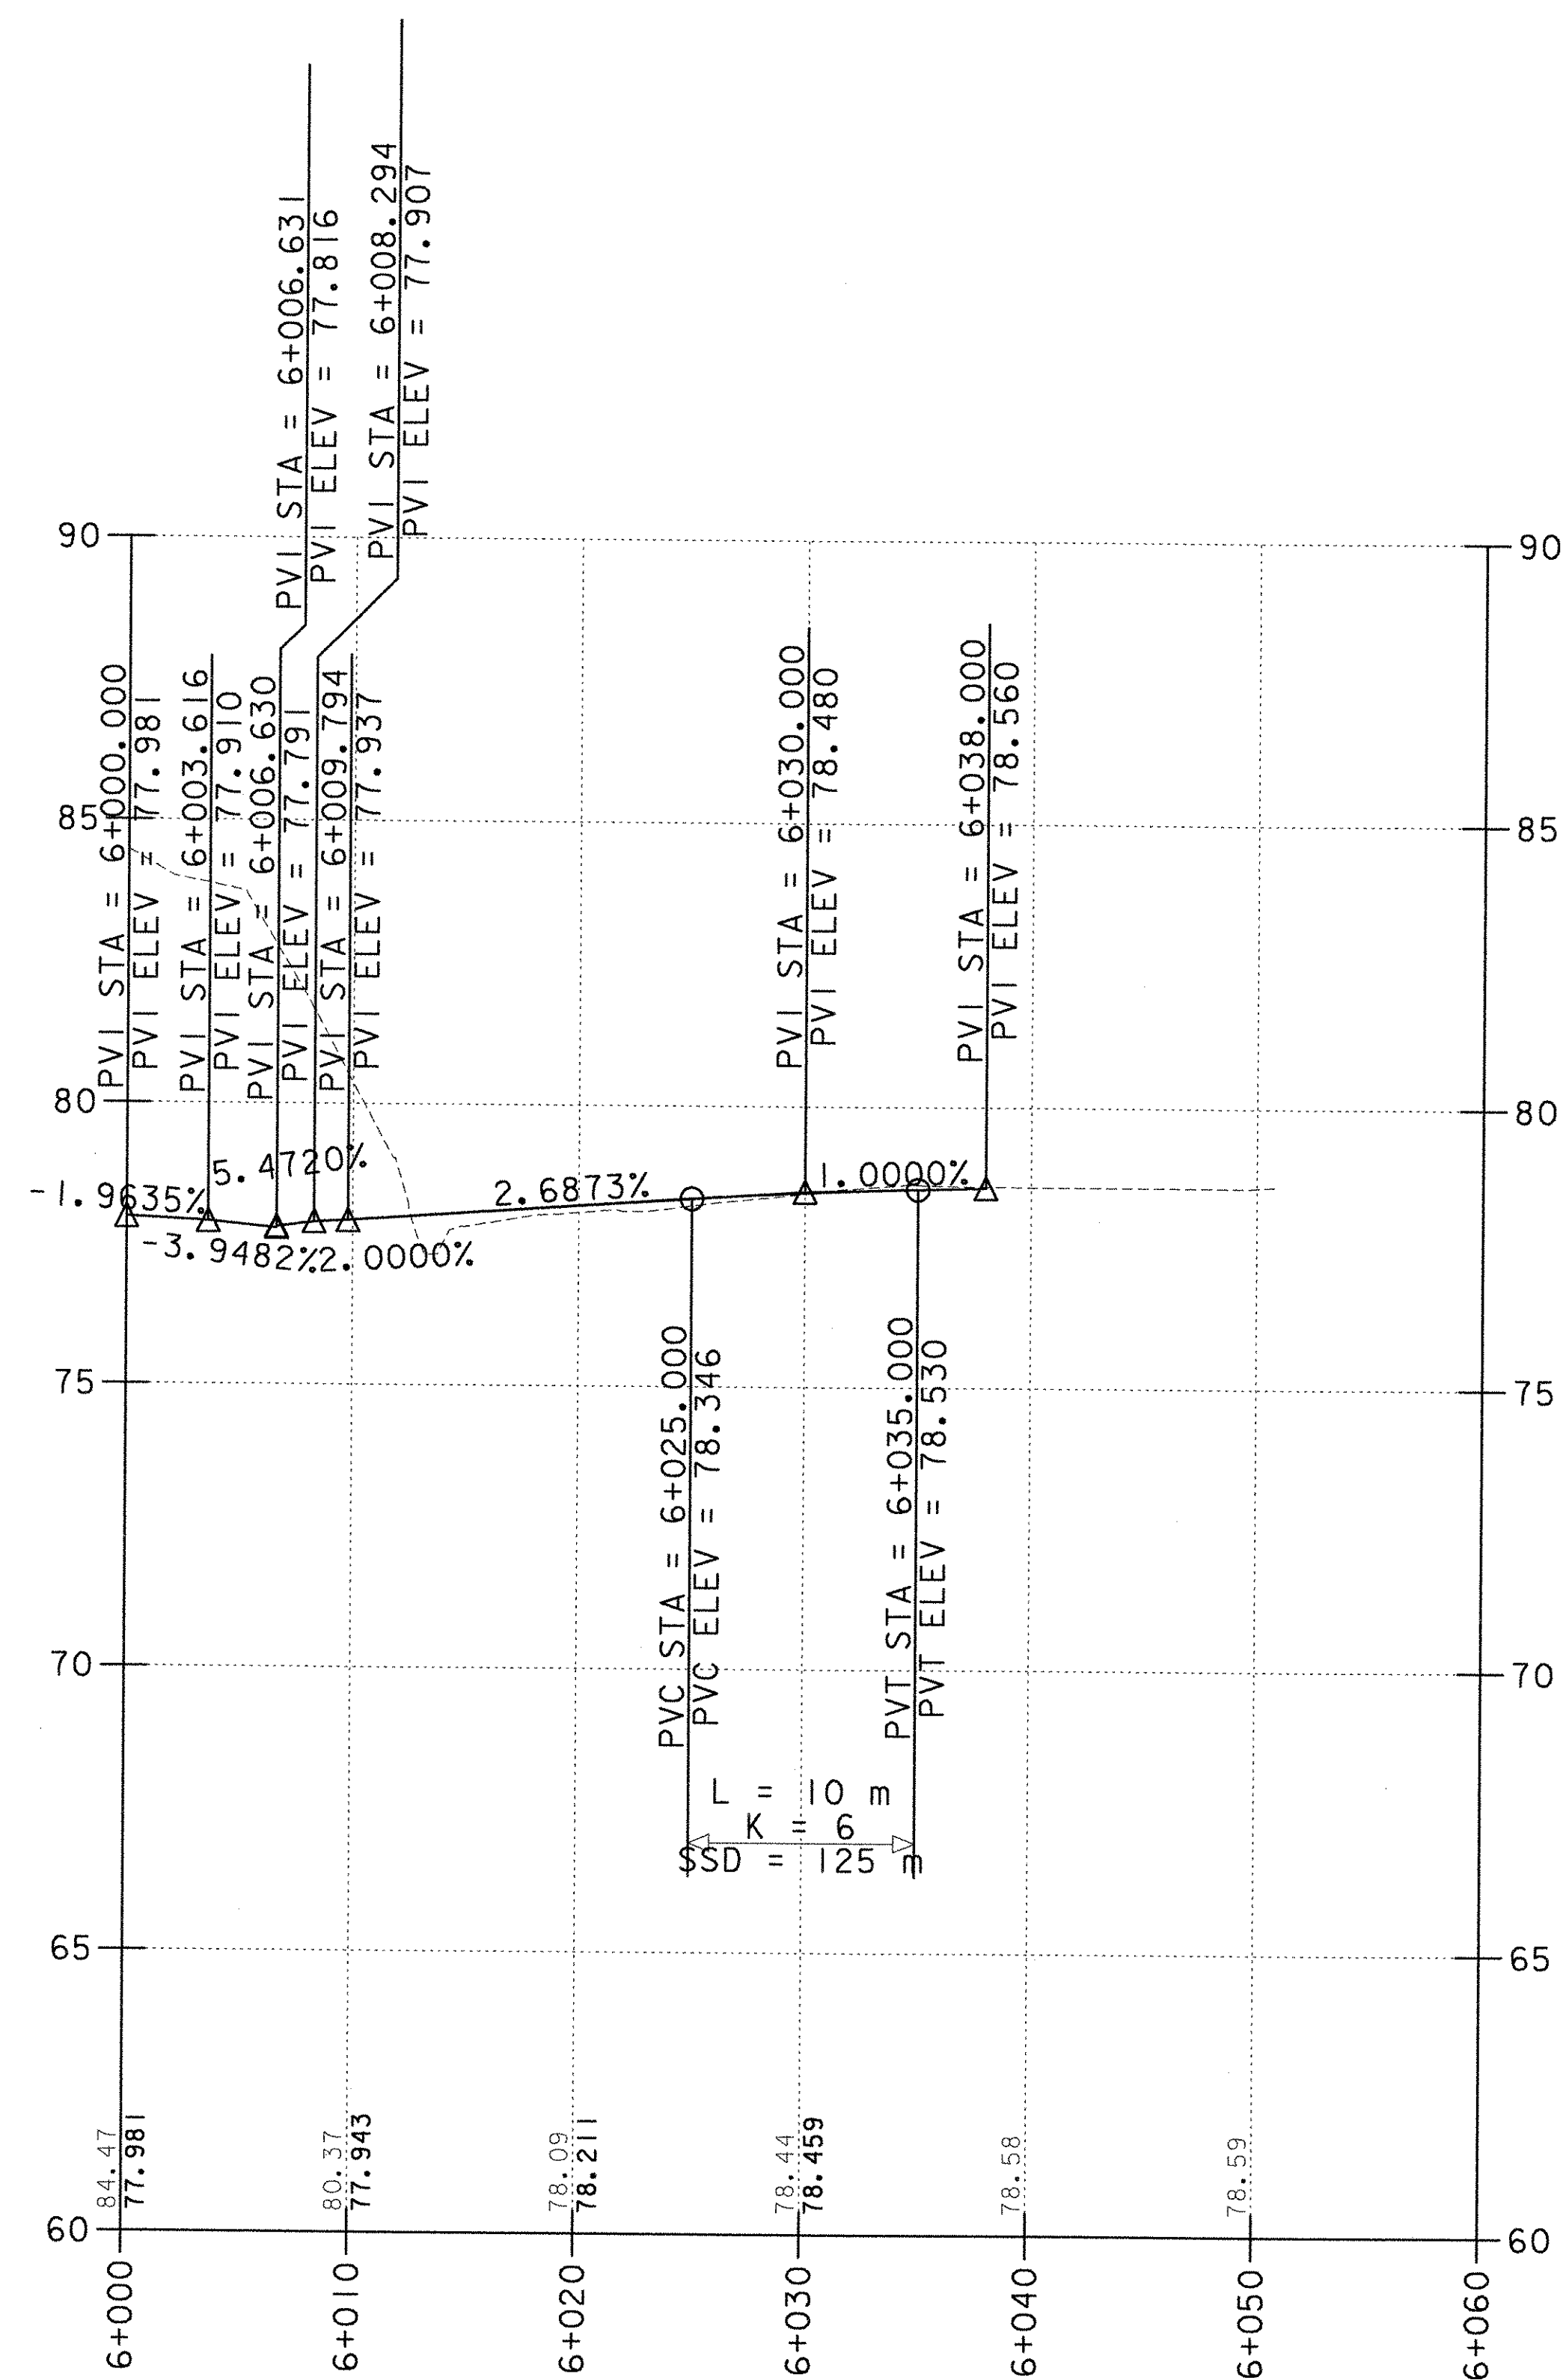


PROFILE - DRIVEWAY

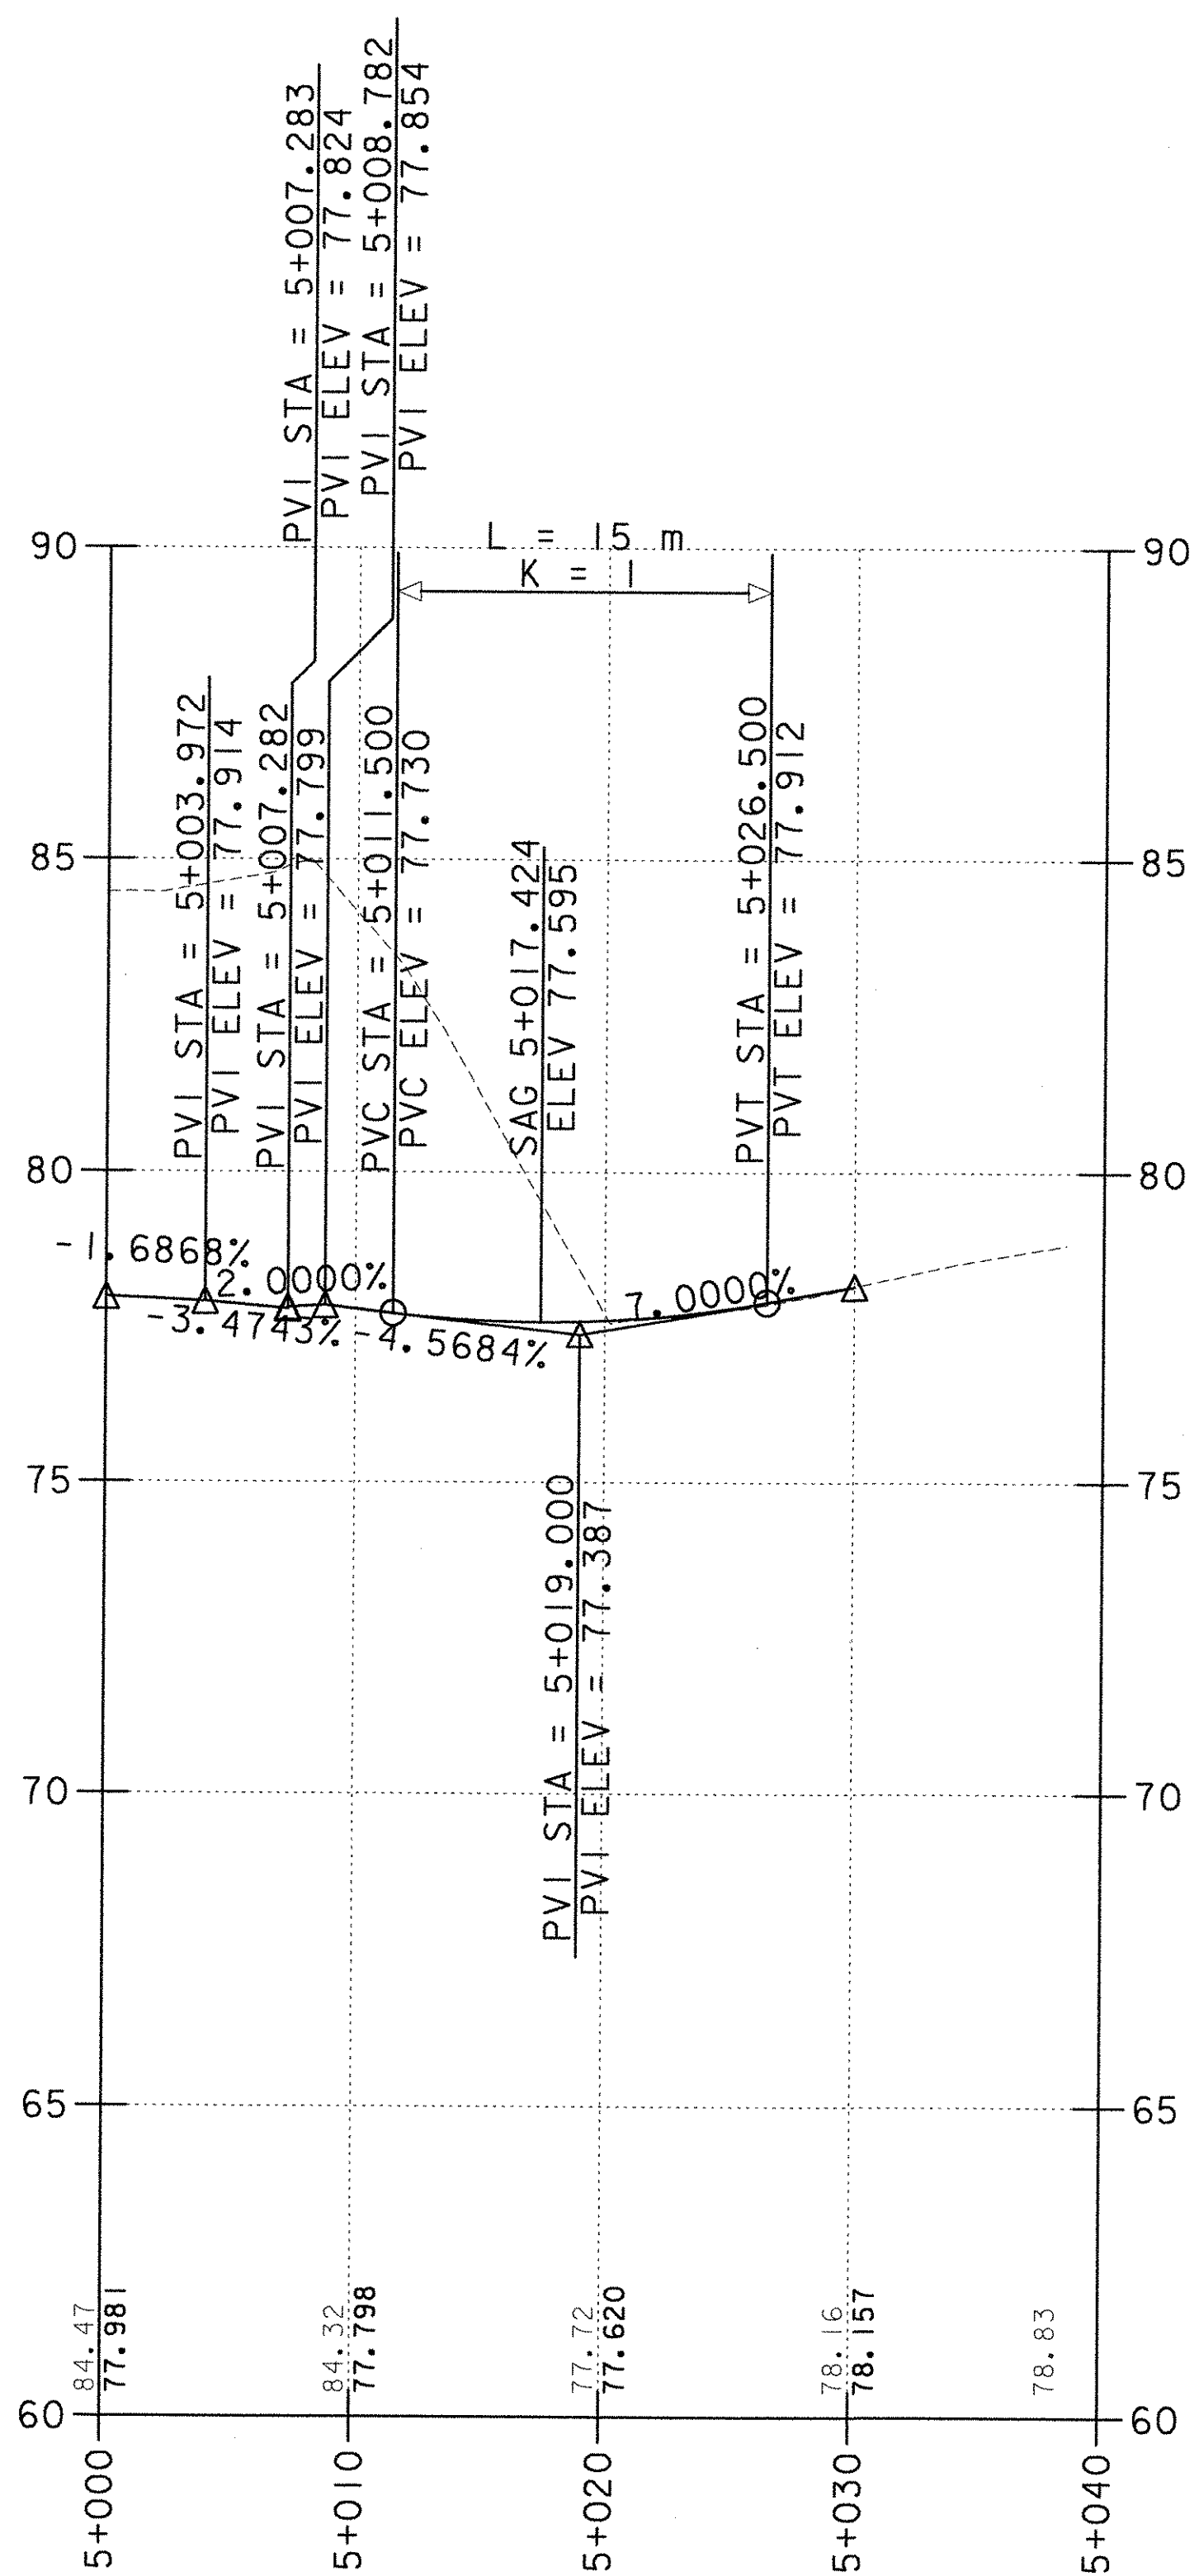

DATUM	
VERTICAL	NGVD 1929
HORIZONTAL	NAD 1983

PROJECT: BRATTLEBORO	PROJECT NO.: NH 010-2(2)
DESIGN FILE NAME: ...\\zb270xs2.dgn	PLOT DATE: 09/20/2002
IPARM FILE NAME:	SURVEY DATE:
SURVEYED BY:	DRAWN BY: P SHEDD
SQUAD LEADER: W HUSBAND	SHEET: 41 OF 145
CLD REF NO. 00-0358	