

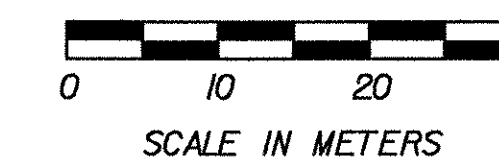
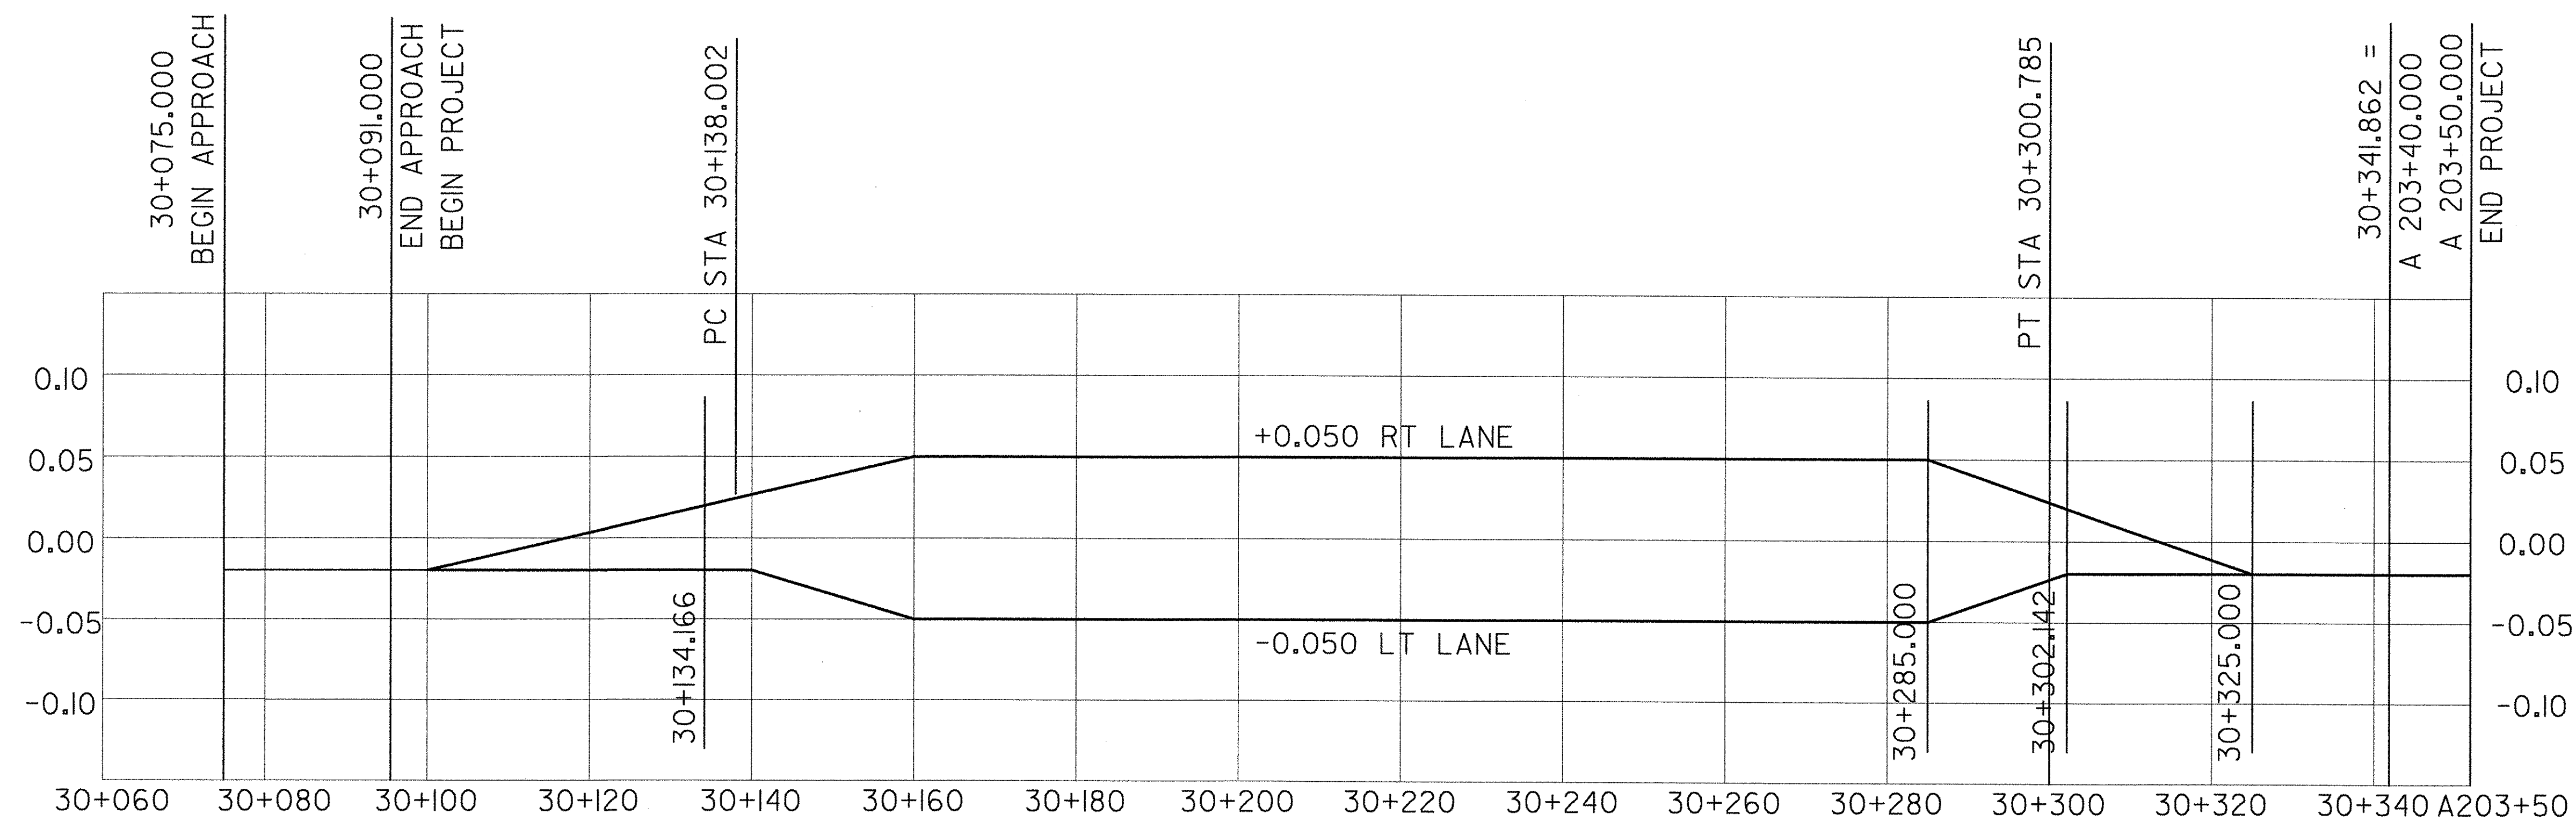


# BANKING DIAGRAM

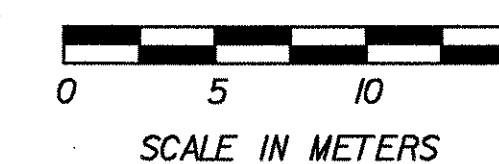

# MATERIAL TRANSITION DETAIL

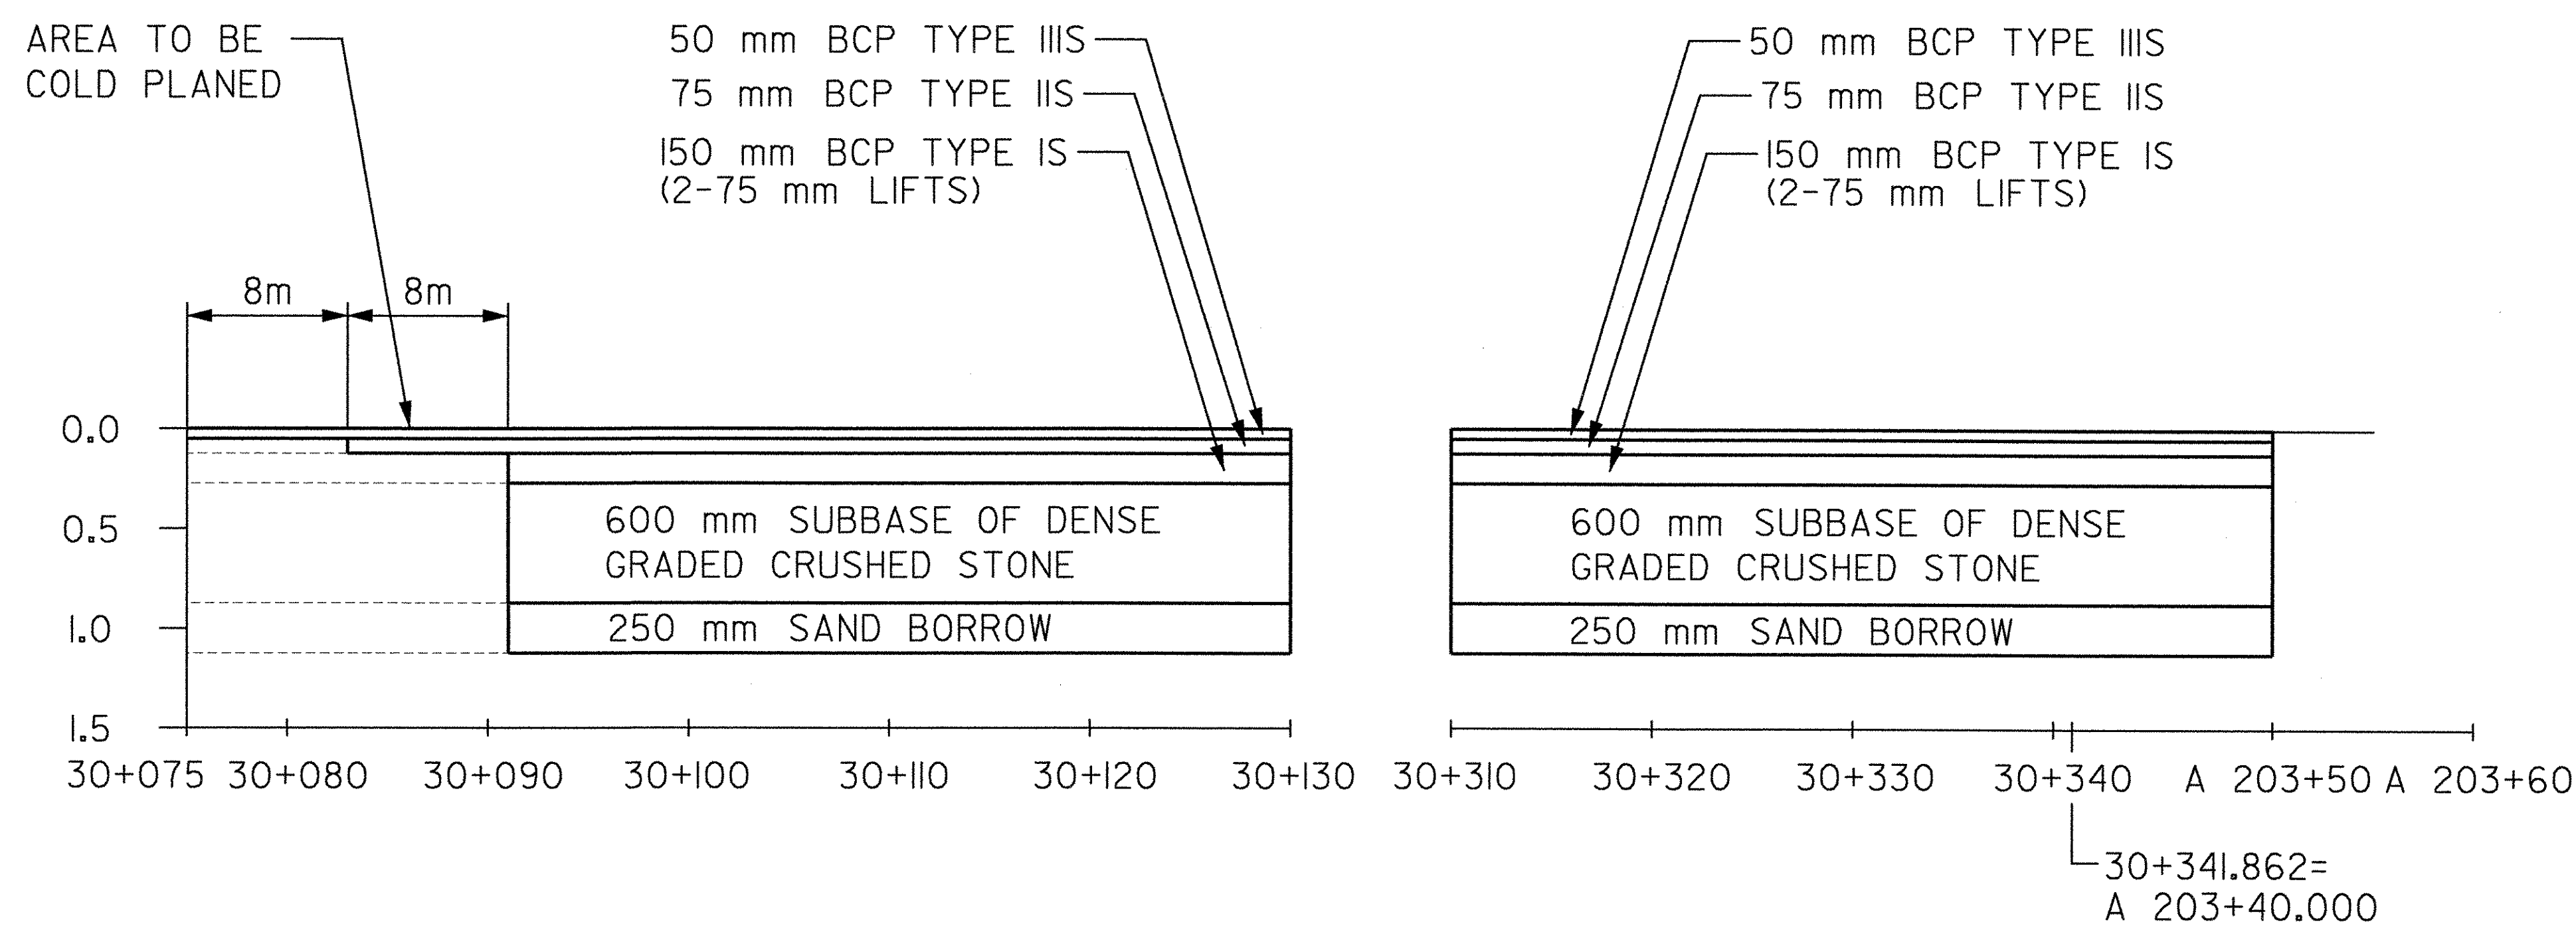

**DATUM**  
 VERTICAL NGVD 1929  
 HORIZONTAL NAD 1983

PROJECT: BRATTLEBORO	PROJECT NO.: NH 010-2(2)
DESIGN FILE NAME: ...zb270xs2.dgn	PLOT DATE: 09/20/2002
IPARM FILE NAME:	SURVEY DATE:
SQUAD LEADER: W HUSBAND	DRAWN BY: N LEMAY
CLD REF NO. 00-0358	SHEET: 42 OF 145