



# RAILROAD PROFILE

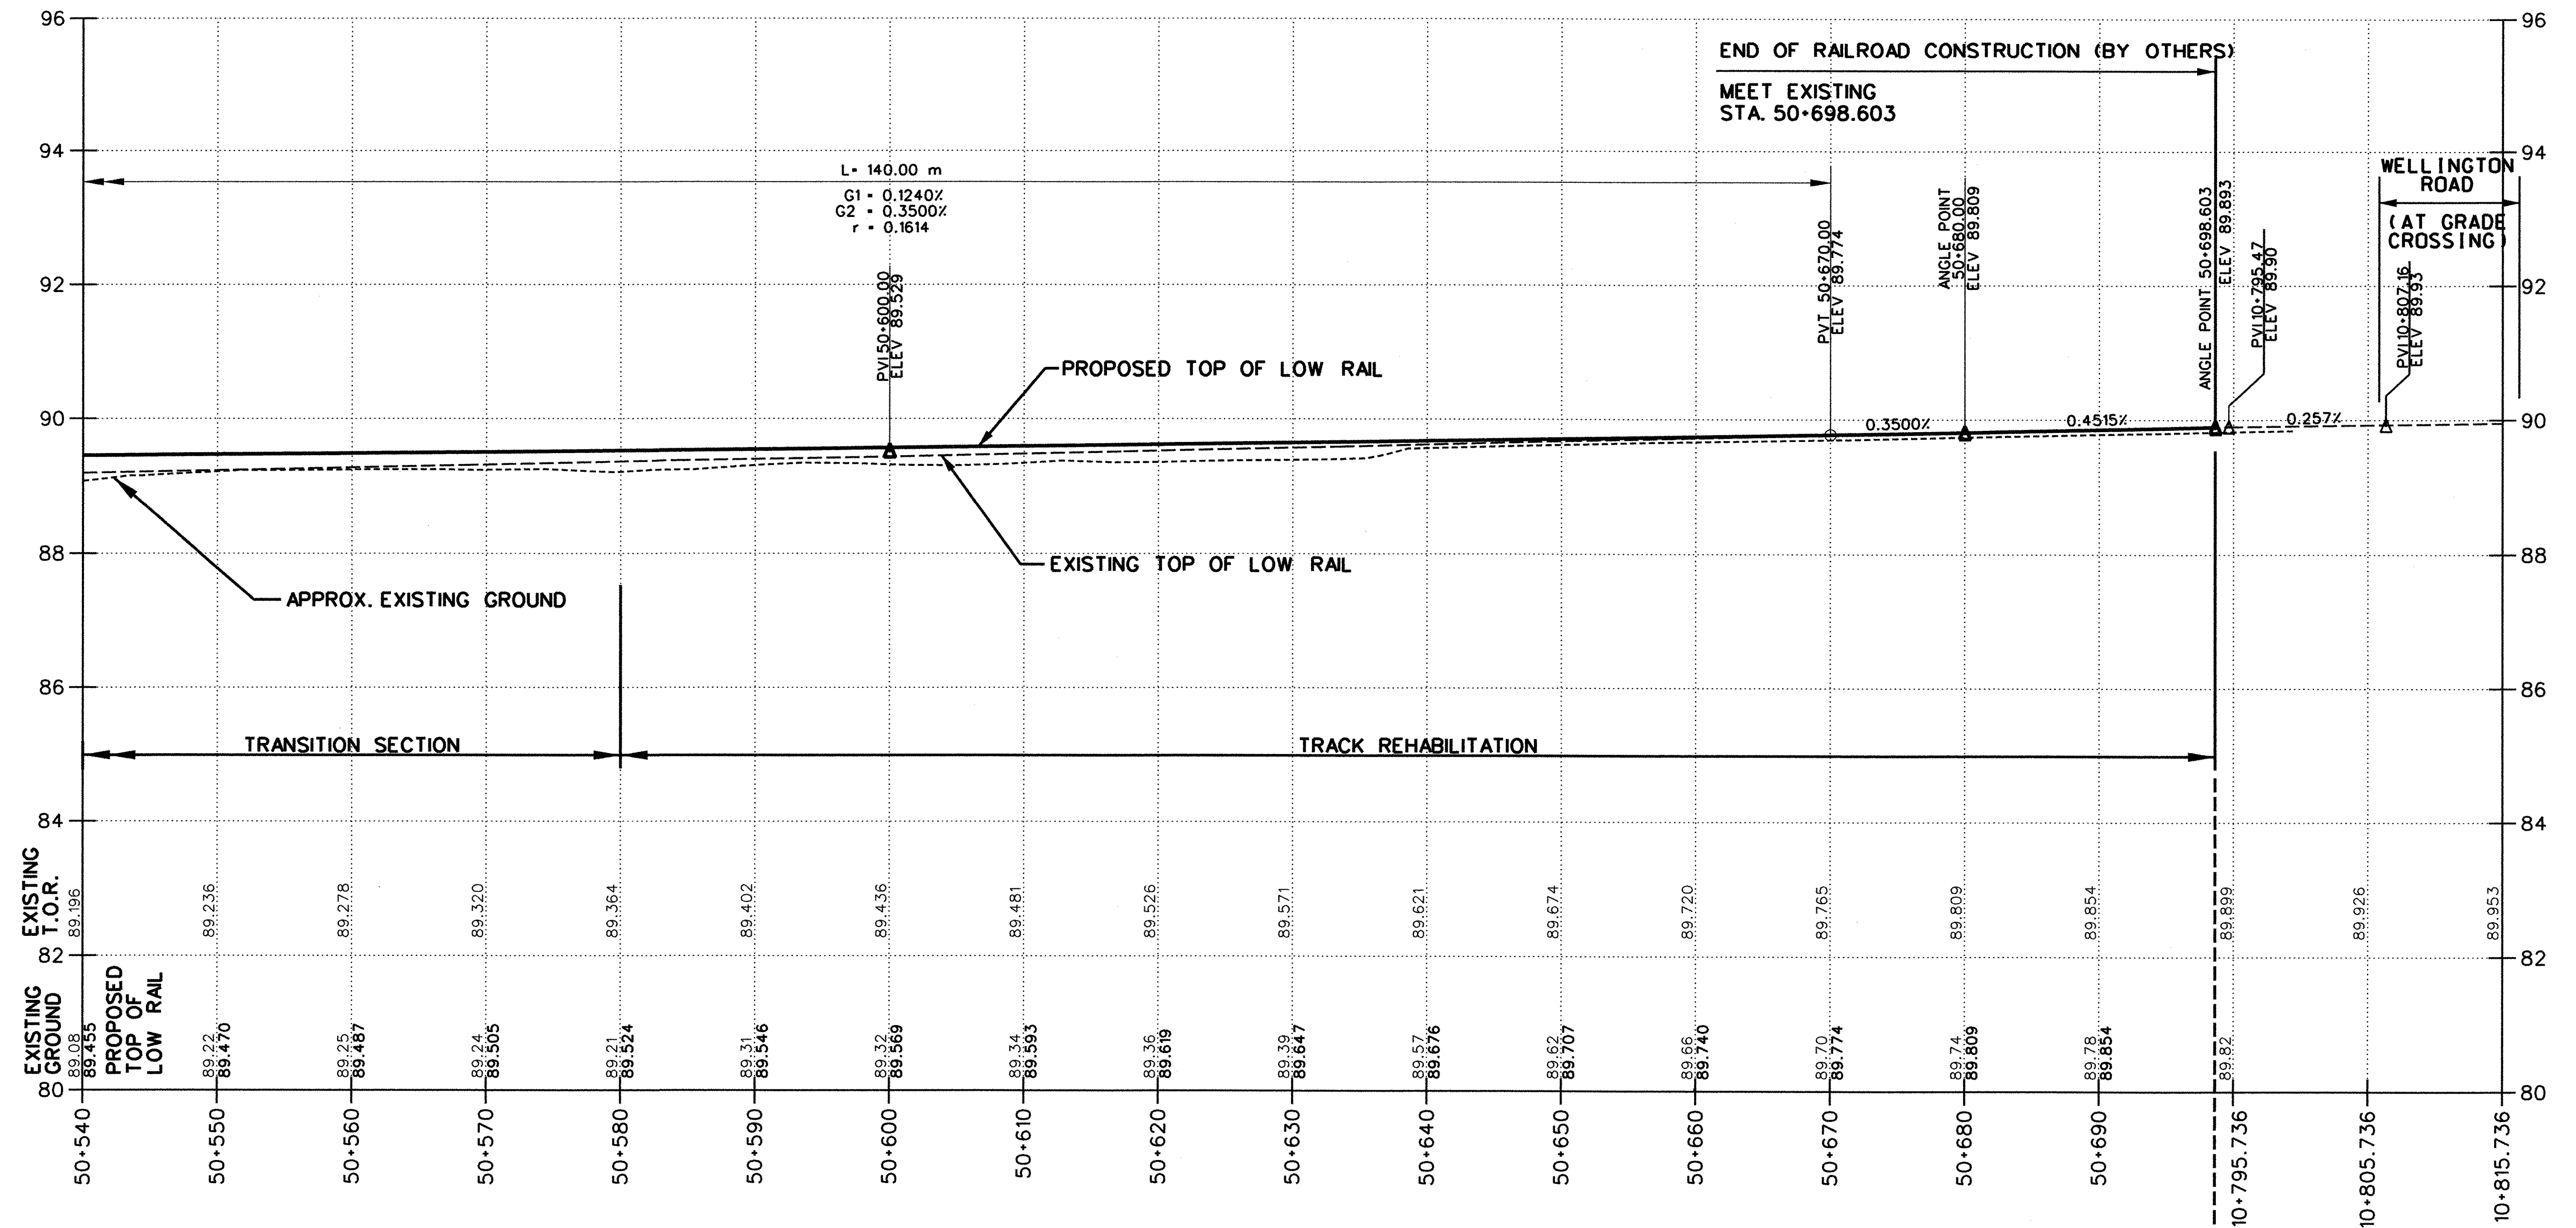

STA. 50+698.603 PROP. RR MAINLINE RELOCATION C  
 STA. 10+794.364 EXISTING RR MAINLINE C

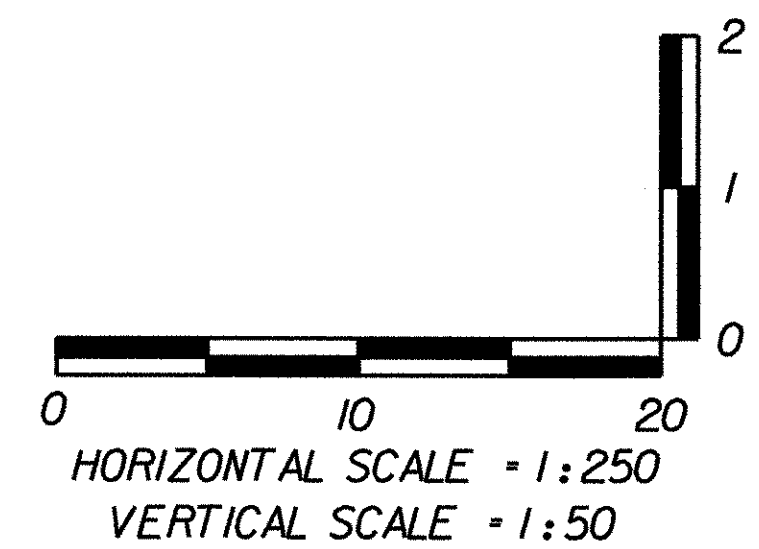

PROJECT:	BRATTLEBORO	PROJECT NO.:	NH 010-2(2)
DESIGN FILE NAME:	U:\99123-Brattleboro\dgn\zb270xs1.dgn		
IPARM FILE NAME:	PLOT DATE: 10-02-2002		
NEW ENGLAND CENTRAL RAILROAD			
FROM STA: 50-540.000 TO STA: 50-698.603 SHEET: 46 OF 145			