


# SECTION A-A

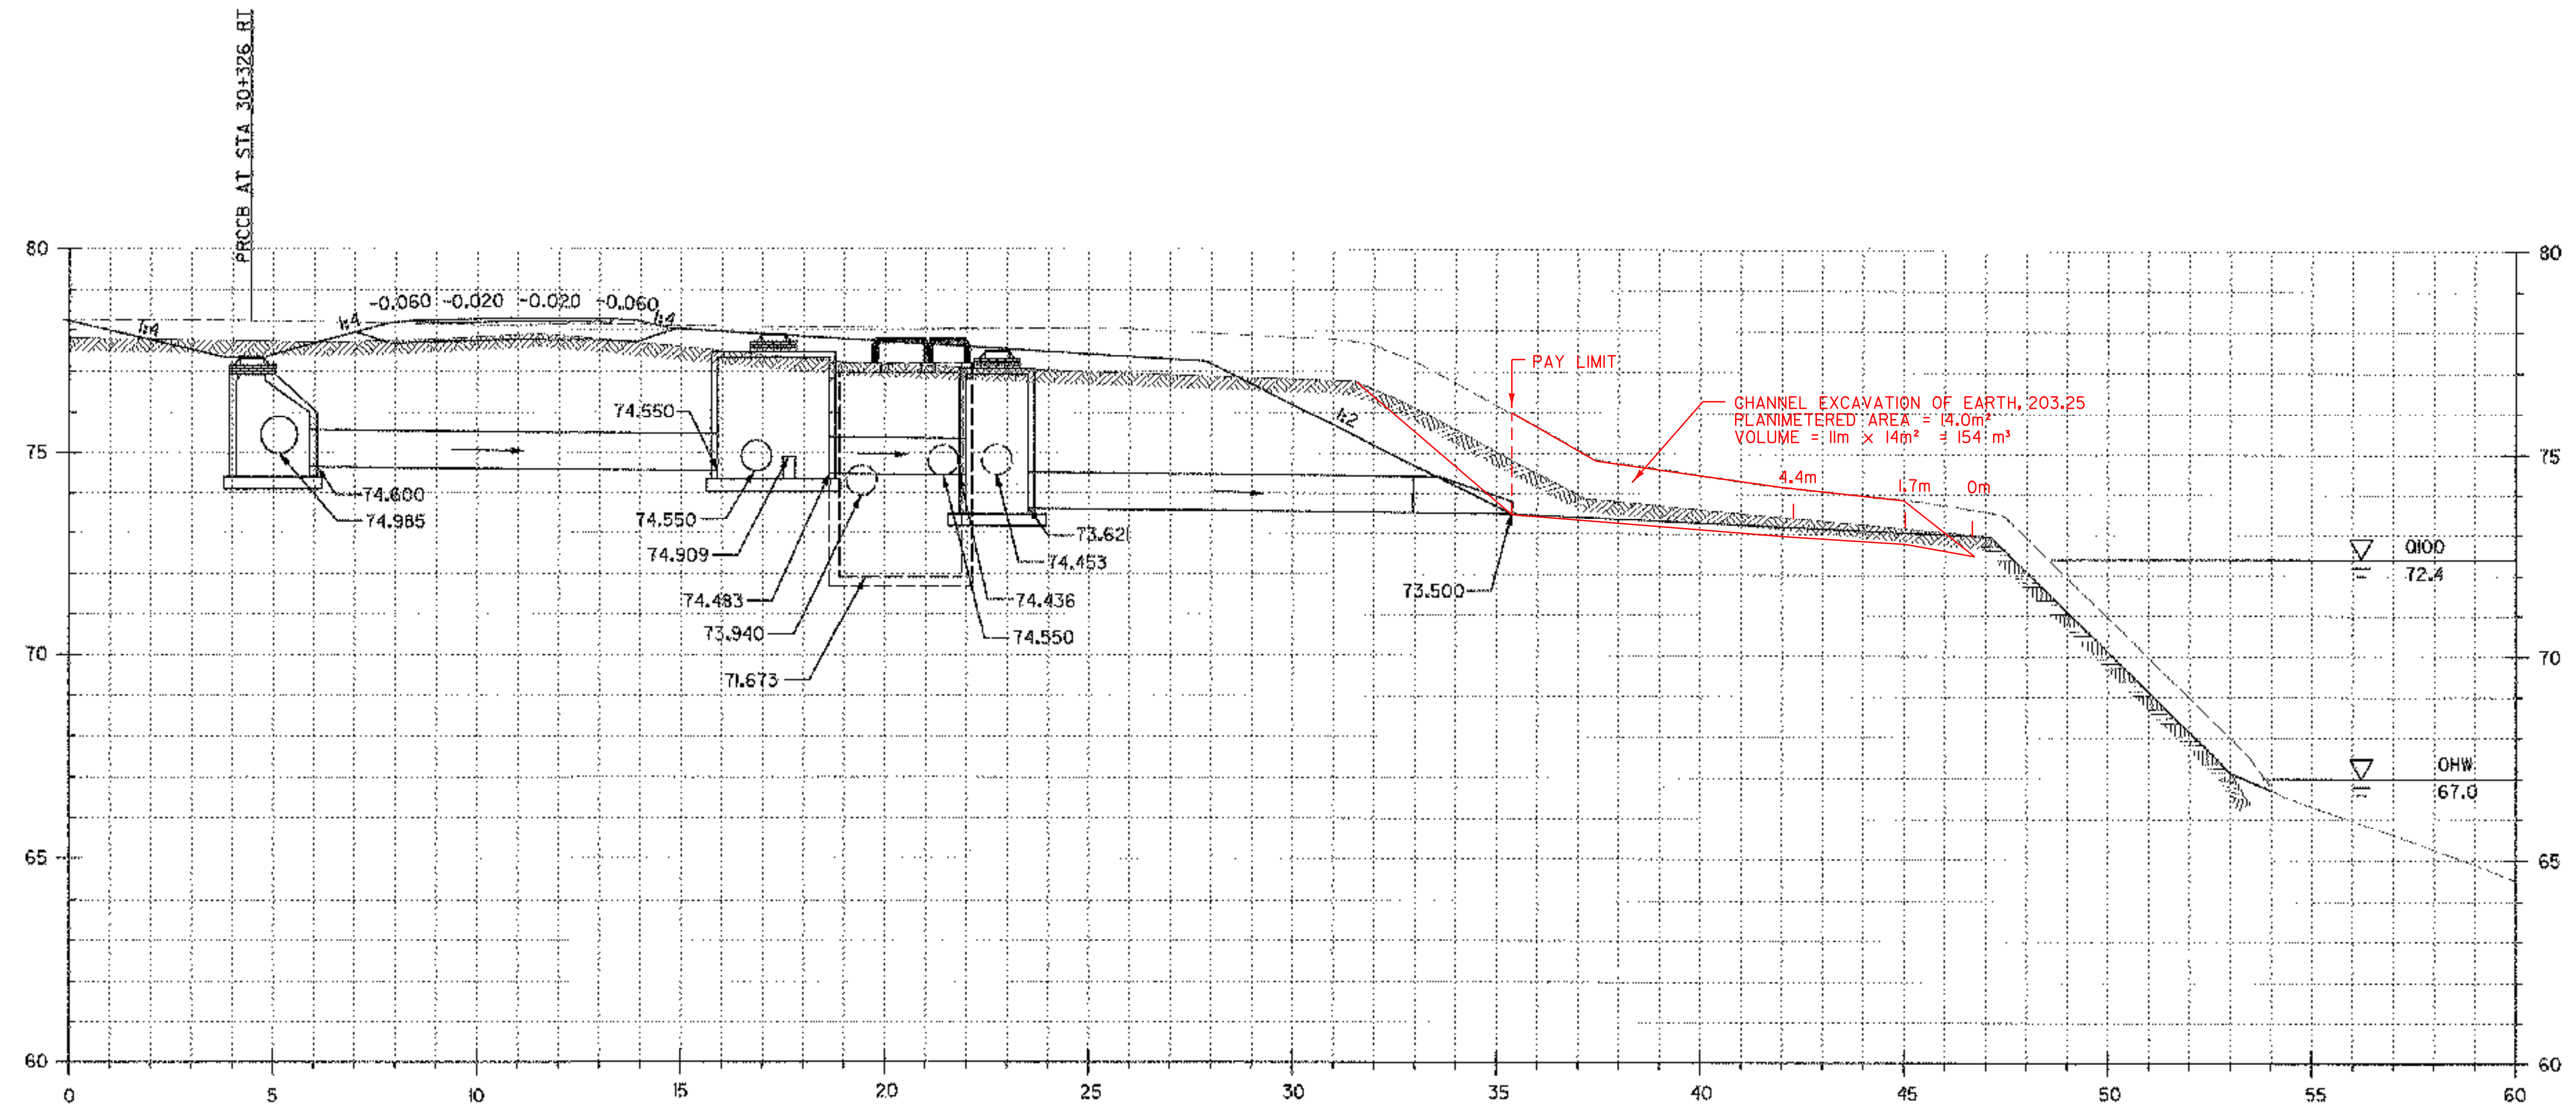

<b>DATUM</b>	
VERTICAL	NGVD 1929
HORIZONTAL	NAD 1983

PROJECT: <b>BRATTLEBORO</b>	PROJECT NO.: NH 010-2(2)
DESIGN FILE NAME: ... \zb270xs2.dgn	PLOT DATE: 09/20/2002
IPARM FILE NAME:	SURVEY DATE:
SURVEYED BY:	DRAWN BY: JAC
SQUAD LEADER: W HUSBAND	SHEET: 49 OF 145
CLD REF NO. 00-0358	