



2

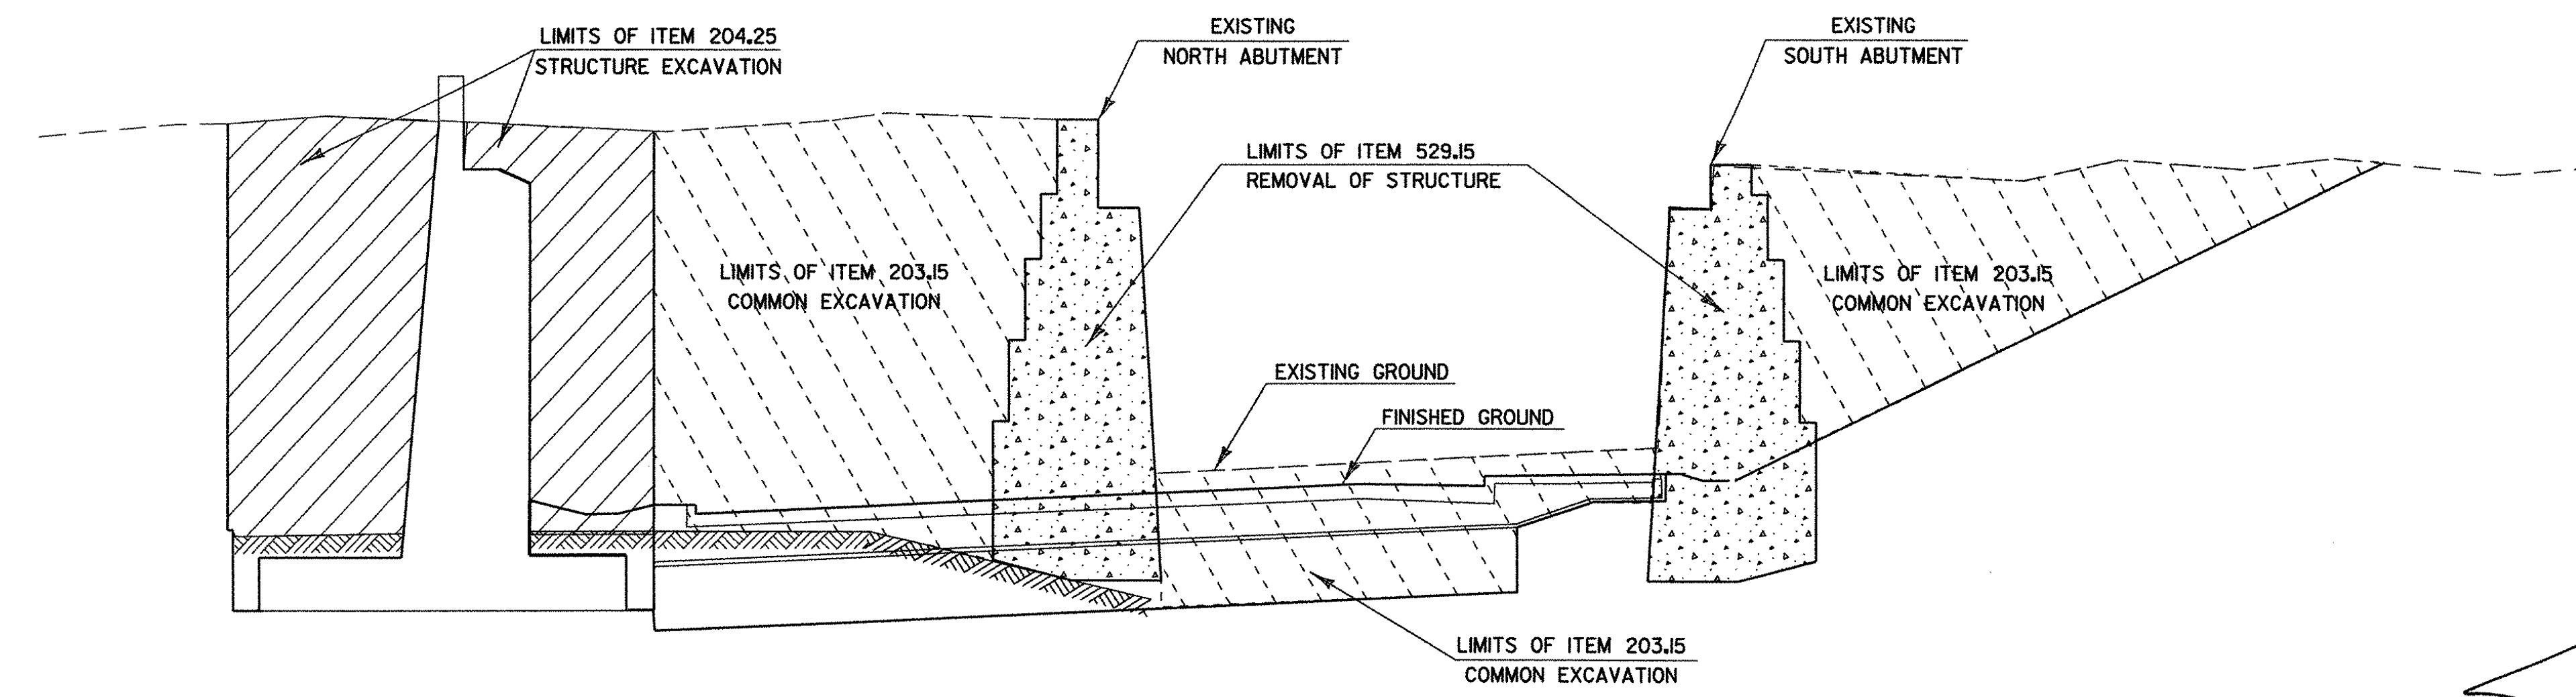

TYPICAL EXCAVATION LIMITS

NOT TO SCALE

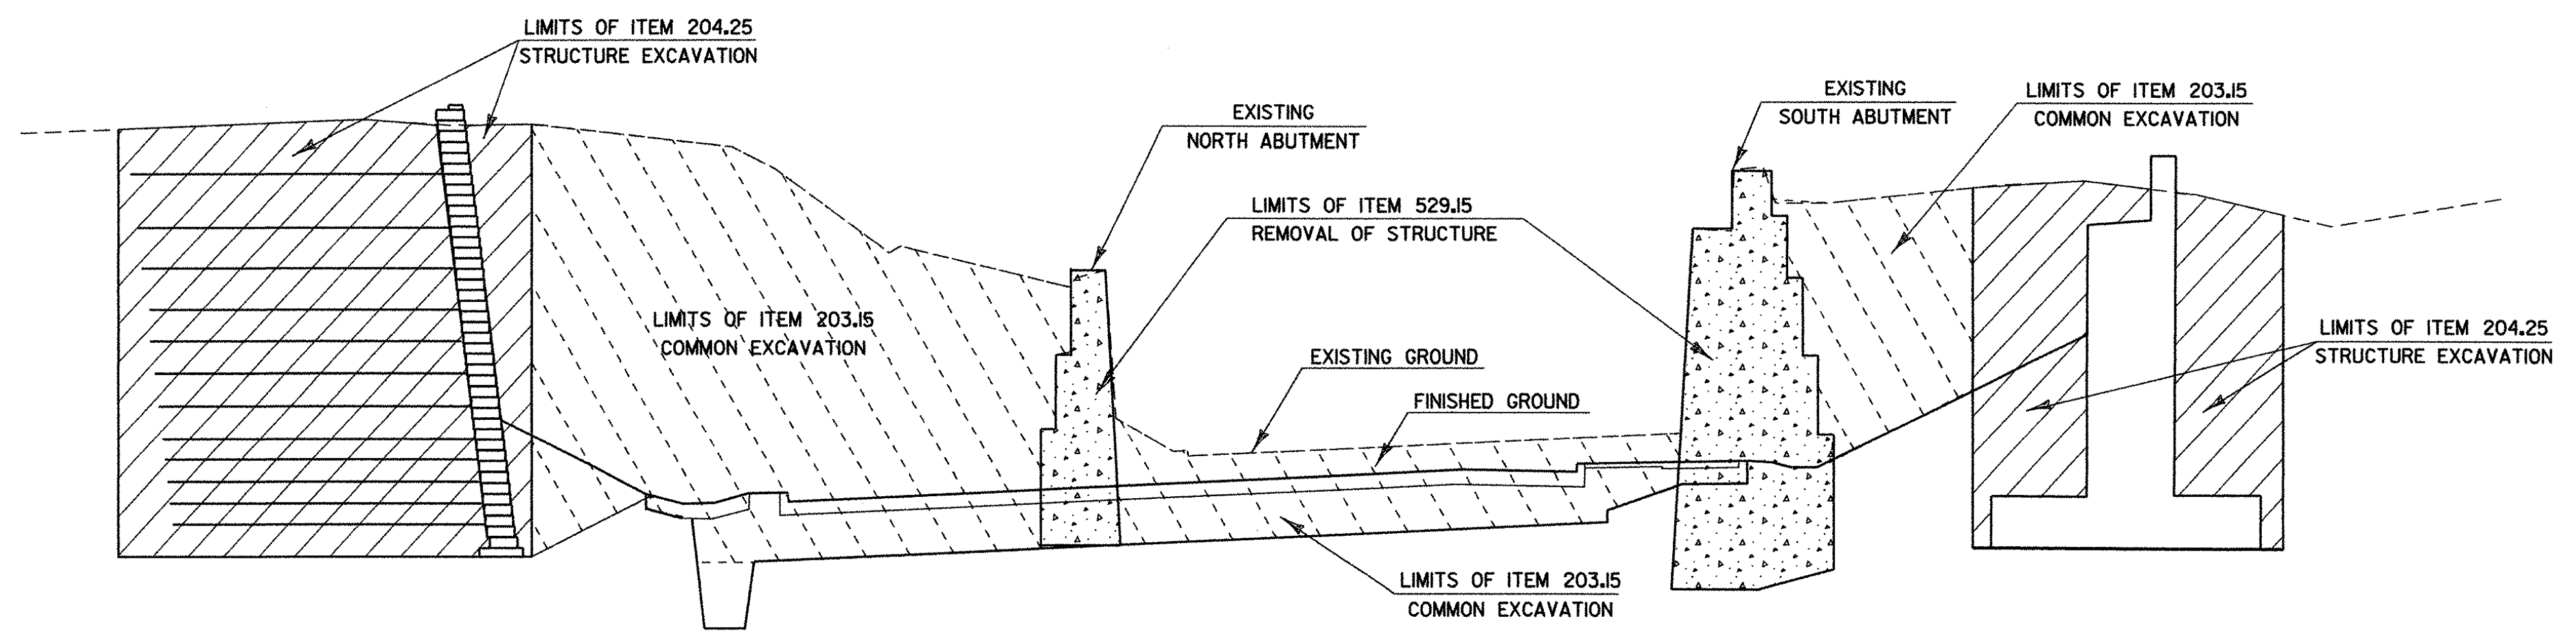

2 Addendum Two, New sheet, Removal/Excavation Limits Dec 6, 2002

PROJECT NAME:	BRATTLEBORO
PROJECT NUMBER:	NH_BRE_012-1(33)
FILE NAME:	\BBAI_CHANGES.DGN
PROJECT MANAGER:	
DESIGNED BY:	
PLOT DATE:	04-DEC-2002
DRAWN BY:	G.BOKES
CHECKED BY:	
SHEET	_53_ OF 145