


**ROUTE 9 BRIDGE  
PLAN**  
SCALE: 1:100

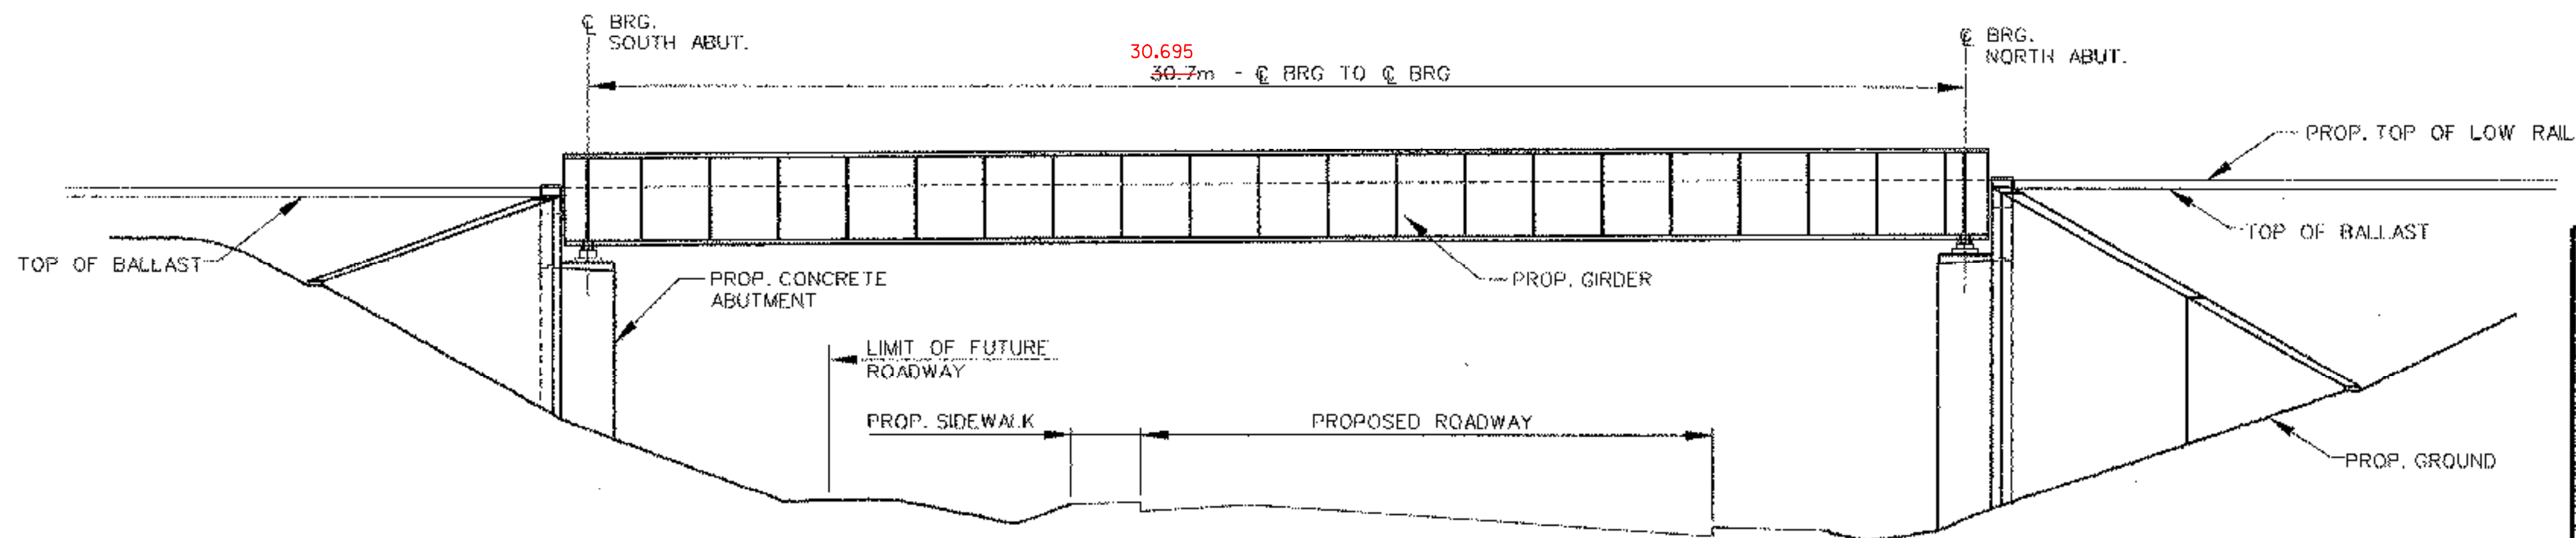

**ROUTE 9 BRIDGE  
ELEVATION**  
SCALE: 1:100

<b>STATE OF VERMONT AGENCY OF TRANSPORTATION</b>			
Town Of	BRATTLEBORO	Bridge No.	62.56
Highway No.	VT. ROUTE 9	Log Sta.	
		Surv. Sta.	
ROUTE 9 BRIDGE			
BRIDGE PLAN & ELEVATION			
Designed By	LM	Drawn By	DHL
Checked By	GJB	Bridge Design Supervisor	JHR
	Date	Date	
PROJECT	BRATTLEBORO	PROJECT NO.	NH BRF 012-1(33)
I.G.C. Info.		Bridge Sheet No. 1	
		Sheet 69 of 145	

Plot Date: 10-03-2002  
File: r19br100.dgn