



SOUTH ABUTMENT PLAN
SCALE 1:75

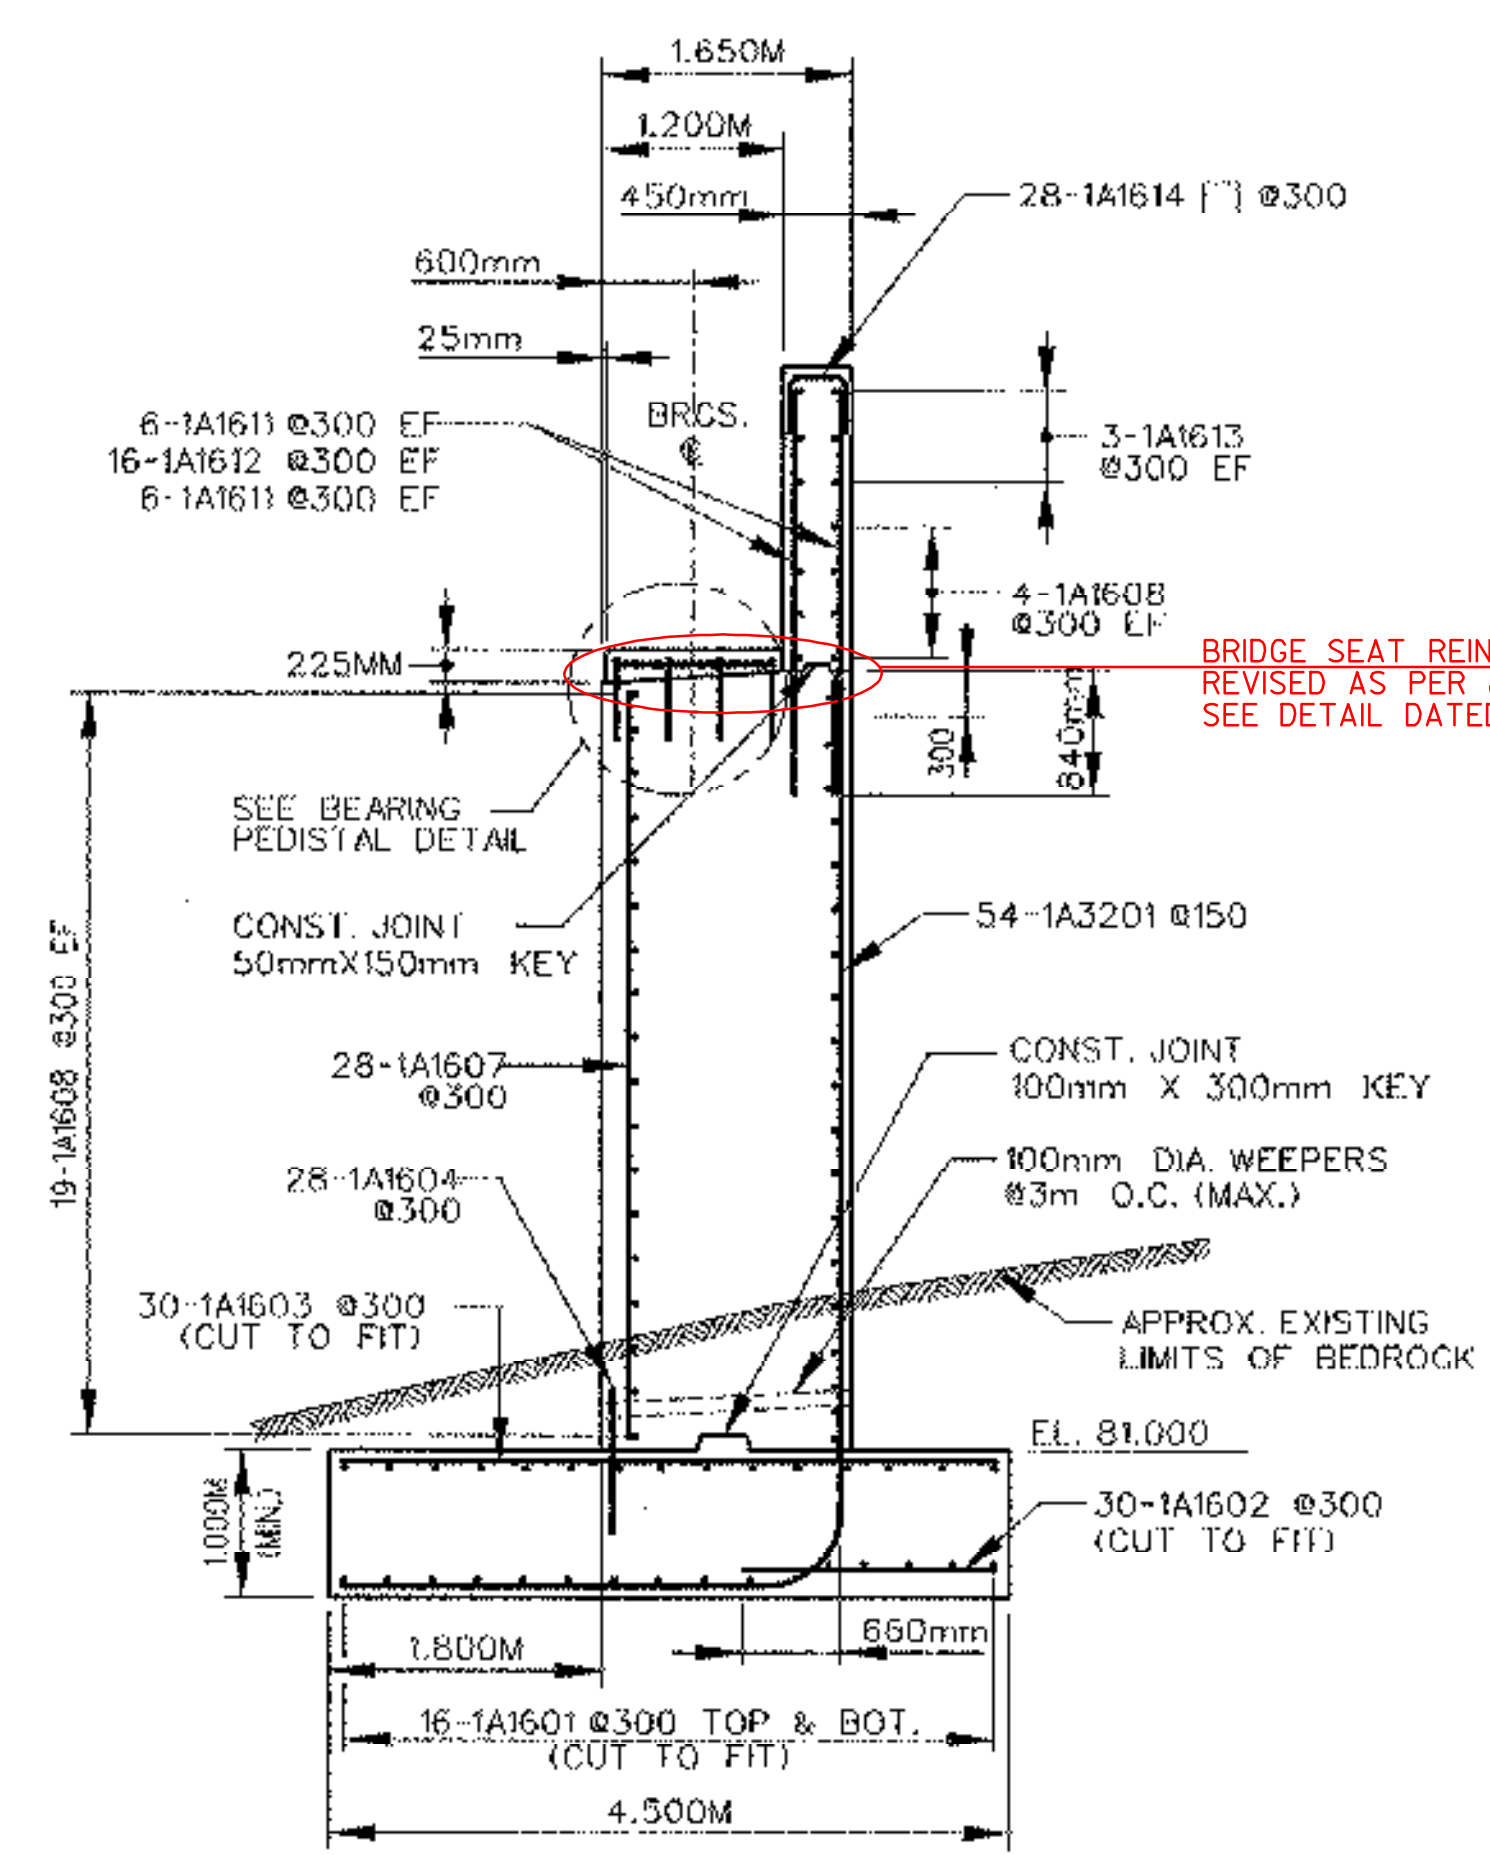

TYPICAL SOUTH ABUTMENT SECTION
SCALE 1:50

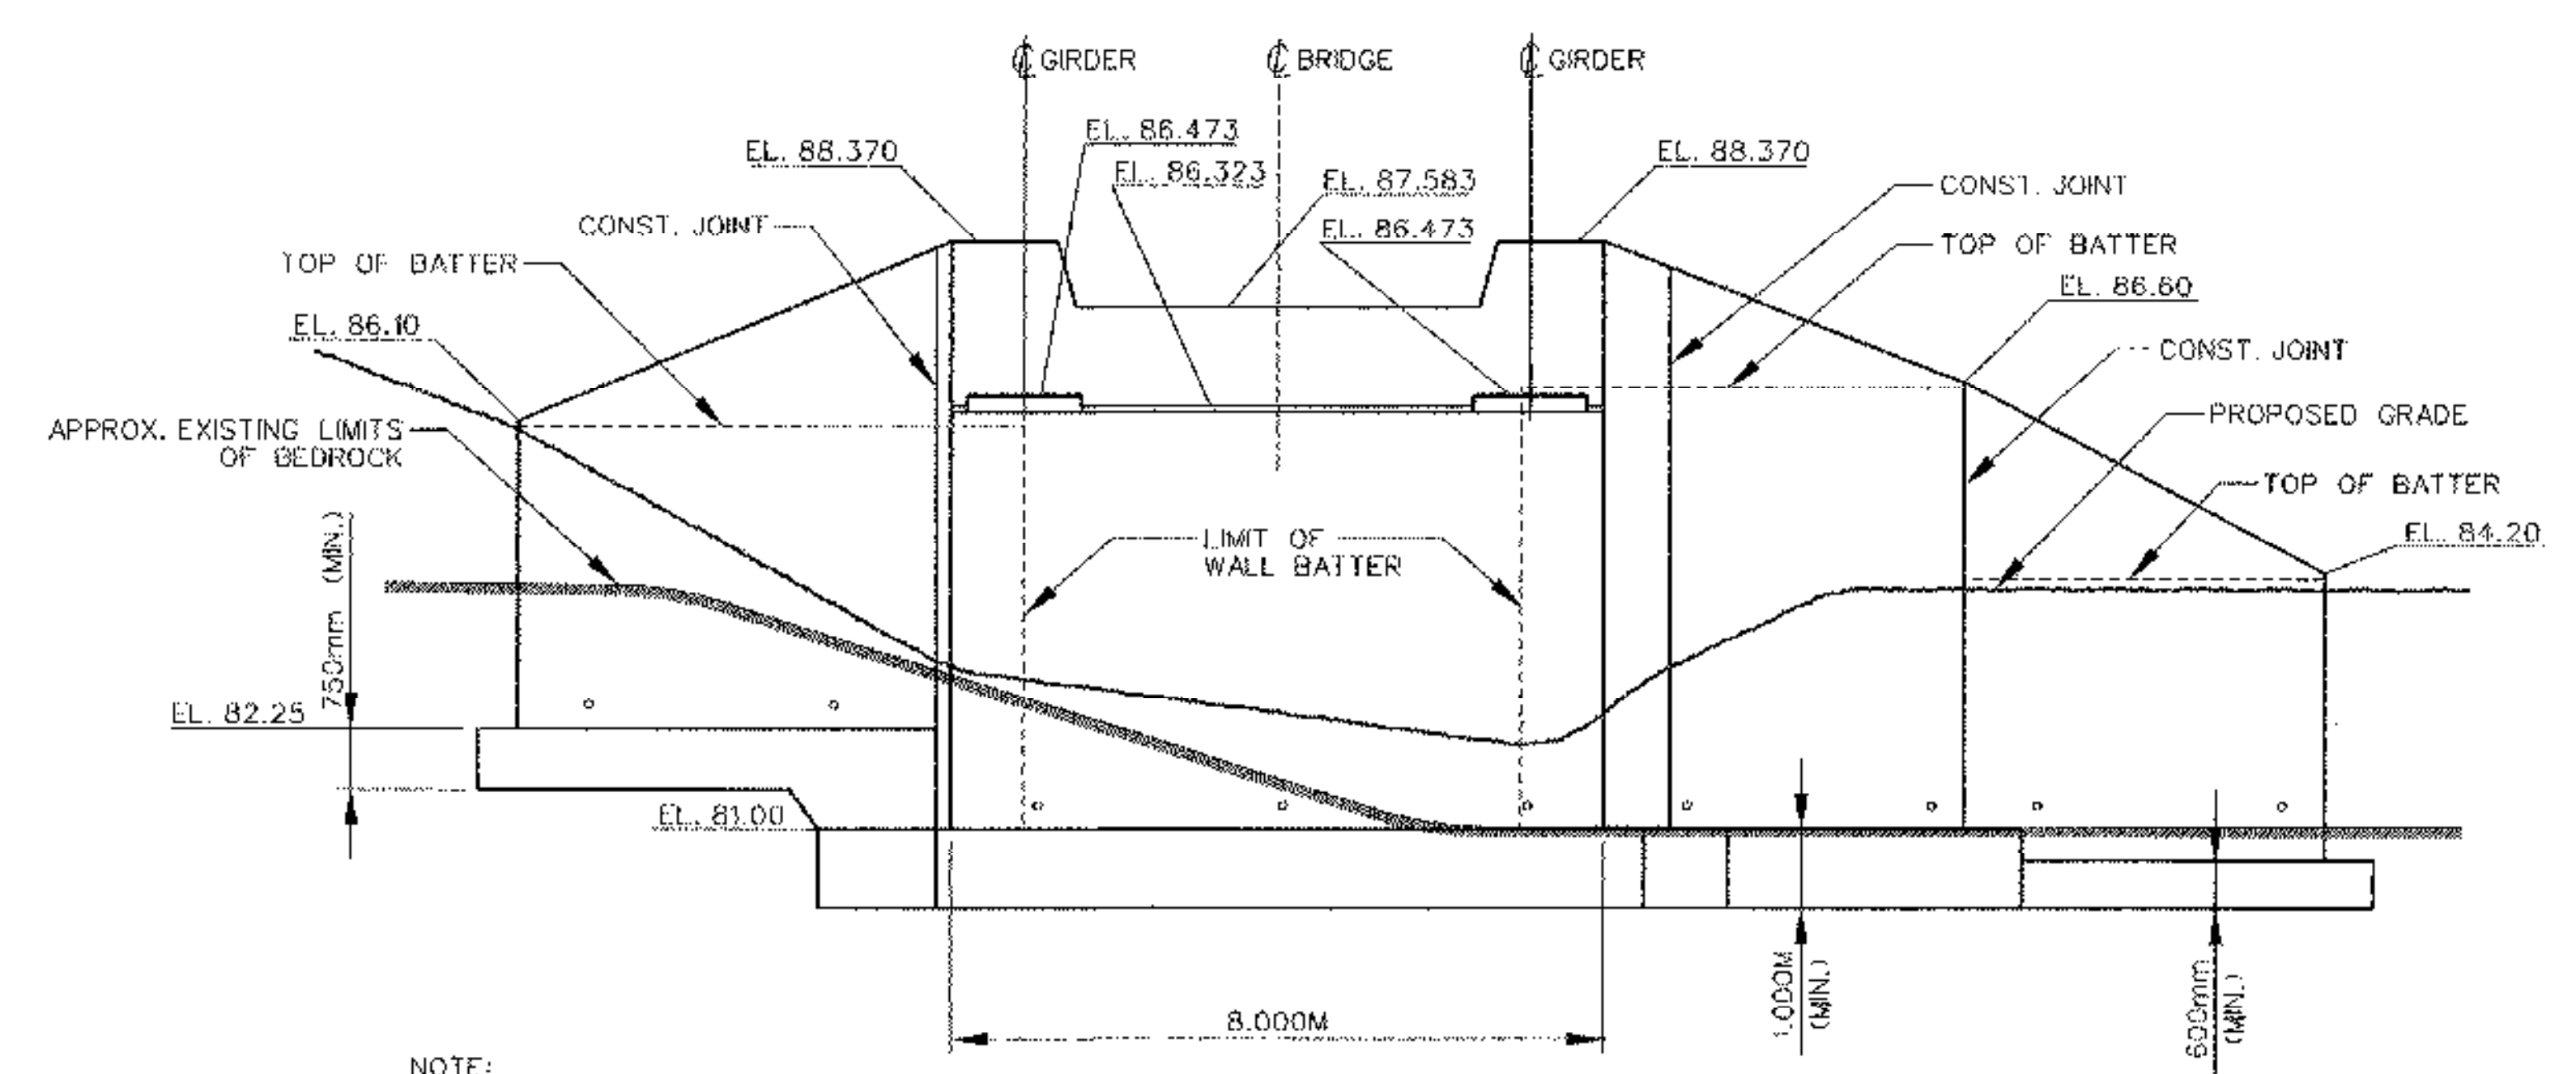

SOUTH ABUTMENT ELEVATION
SCALE 1:75

NOTE:
FOR PARAPET PLATE DETAIL
SEE SHEET 73 OF 145

**STATE OF VERMONT
AGENCY OF TRANSPORTATION**

Town Of	BRATTLEBORO	Bridge No.	62.56
Highway No.	VT. ROUTE 9	Log Sta.	
		Surv. Sta.	
ROUTE 9 BRIDGE			
SOUTH ABUTMENT PLAN, ELEVATION & SECTIONS			
Designed By	LM	Drawn By	DHL
Checked By	GJB	Bridge Design Supervisor	JHR
		Date	
PROJECT	BRATTLEBORO	PROJECT NO.	NH 010-2(2)
I.G.C. Info.		Bridge Sheet No. 8	Sheet 76 of 145

Plot Date: 10-03-2002
File: r19br154

EL. 76.7
11-23-99