




TYPICAL SOUTHEAST WINGWALL SECTION C-C
SCALE 1:50

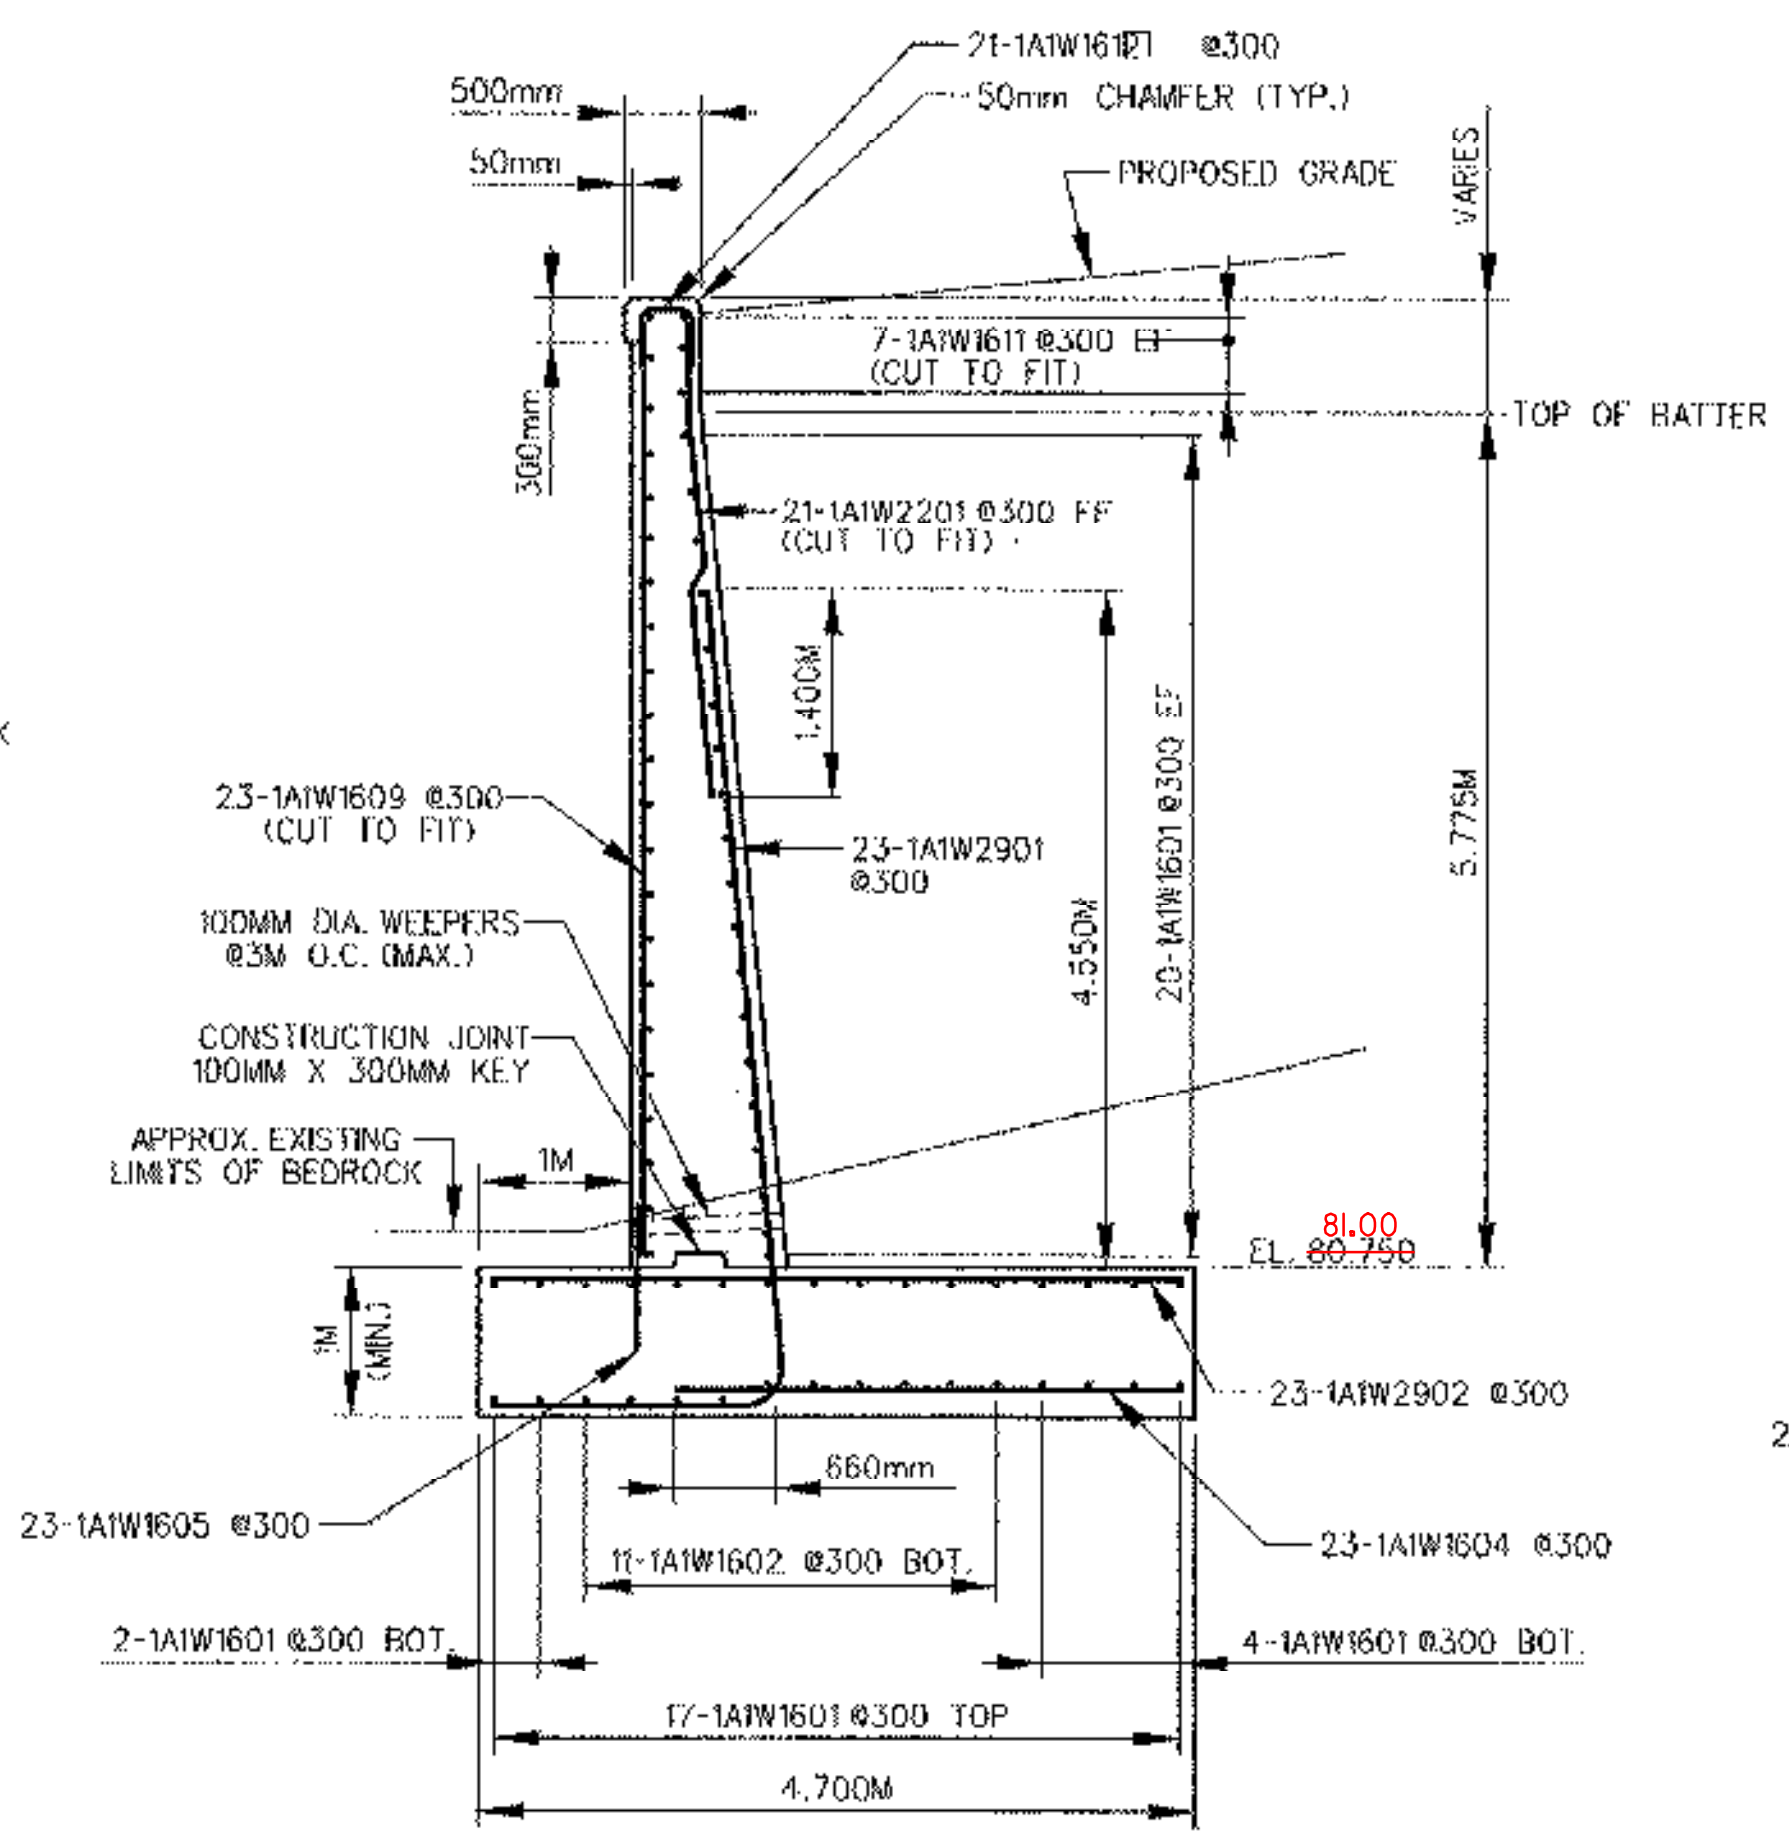


TYPICAL SOUTHWEST WINGWALL SECTION B-B
SCALE 1:50

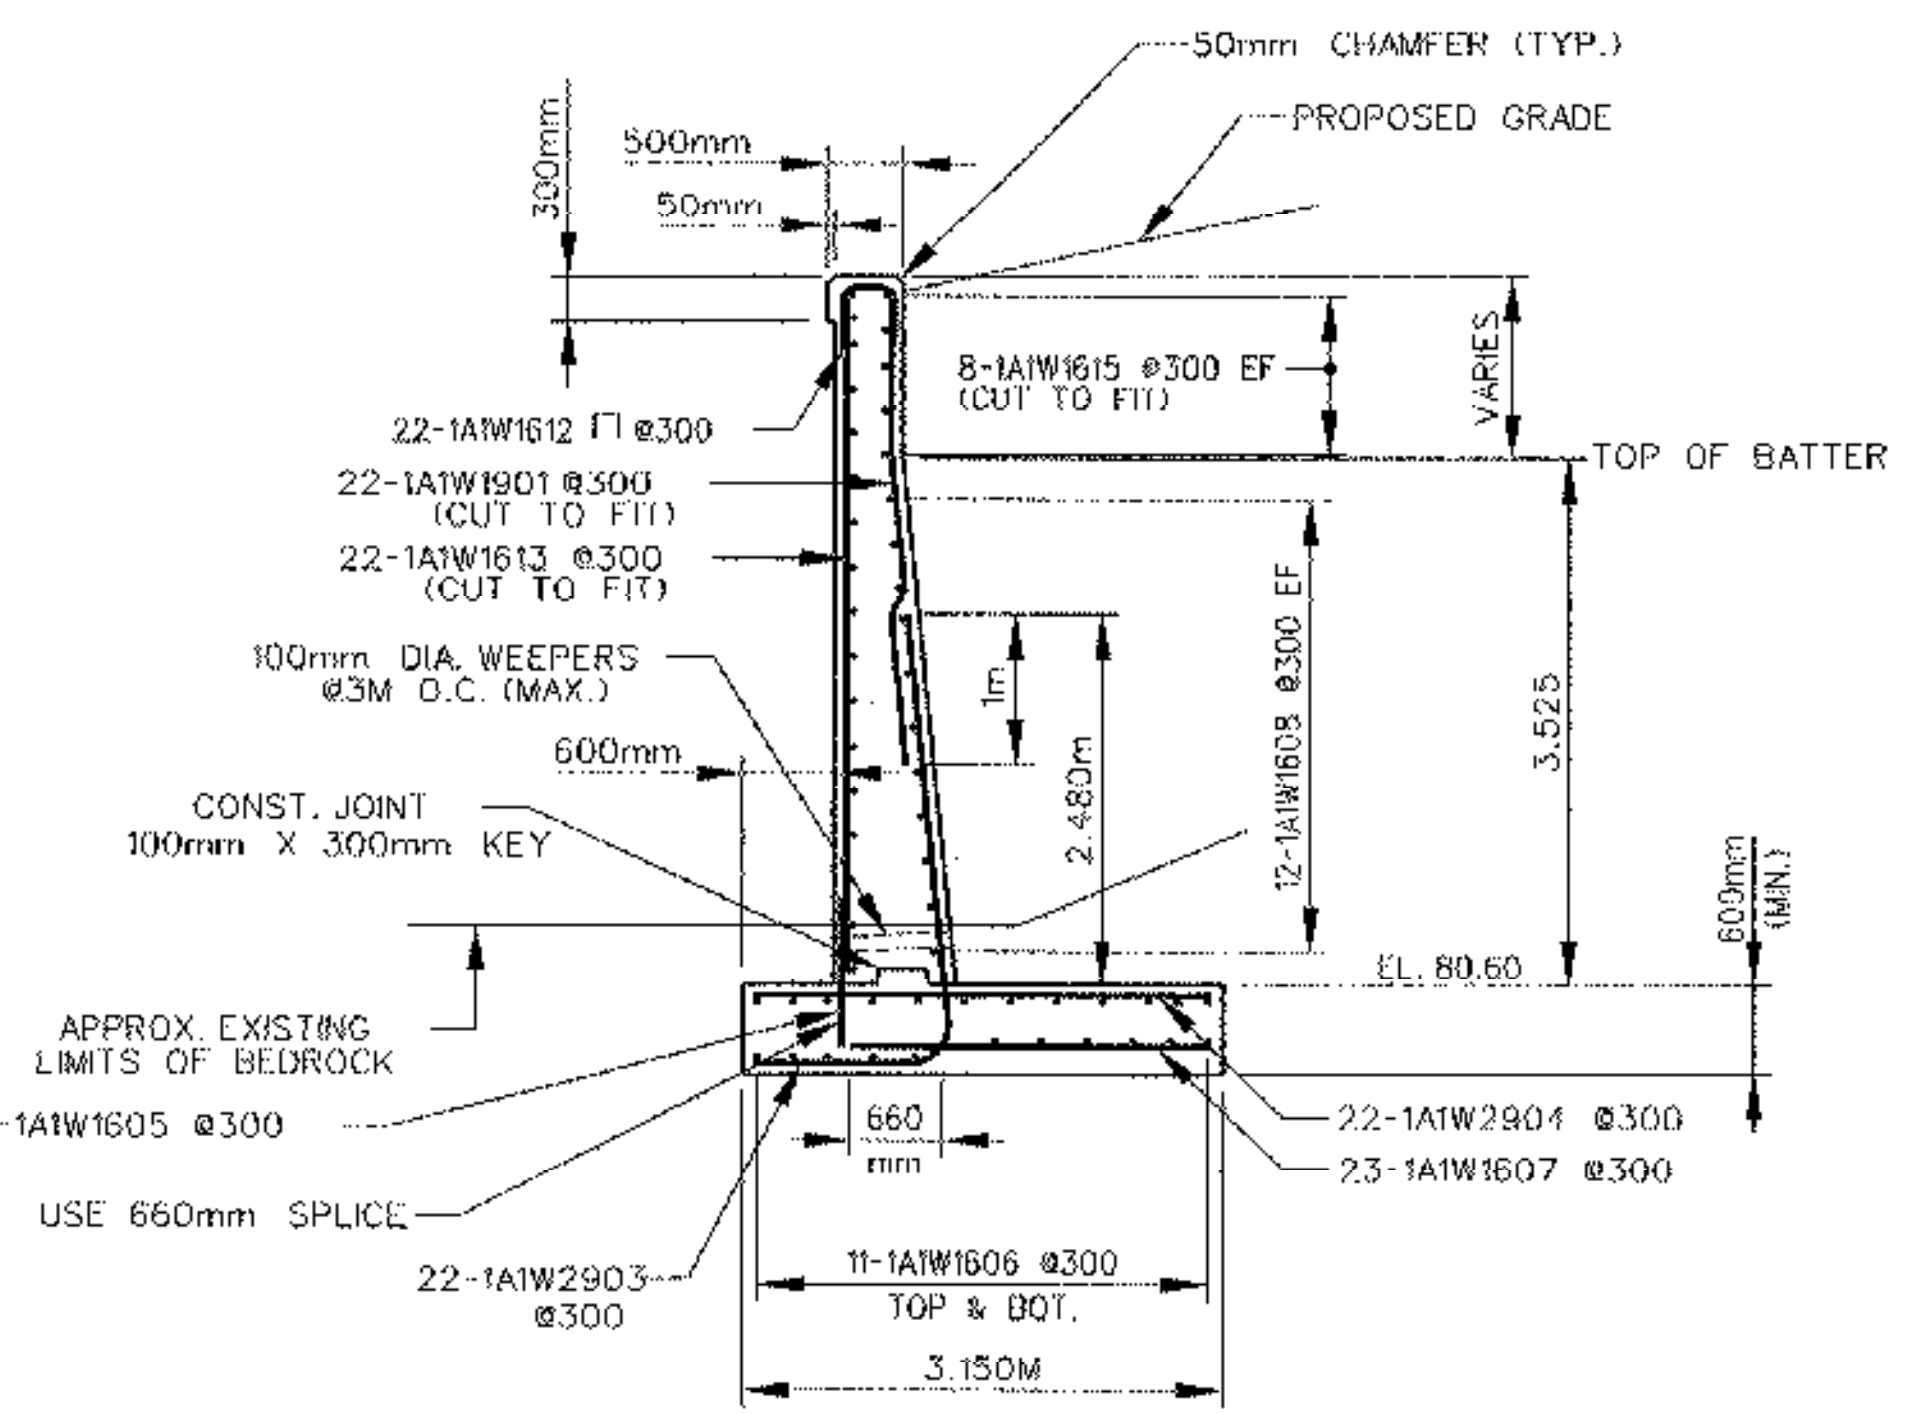

TYPICAL SOUTHWEST WINGWALL SECTION A-A
SCALE 1:50

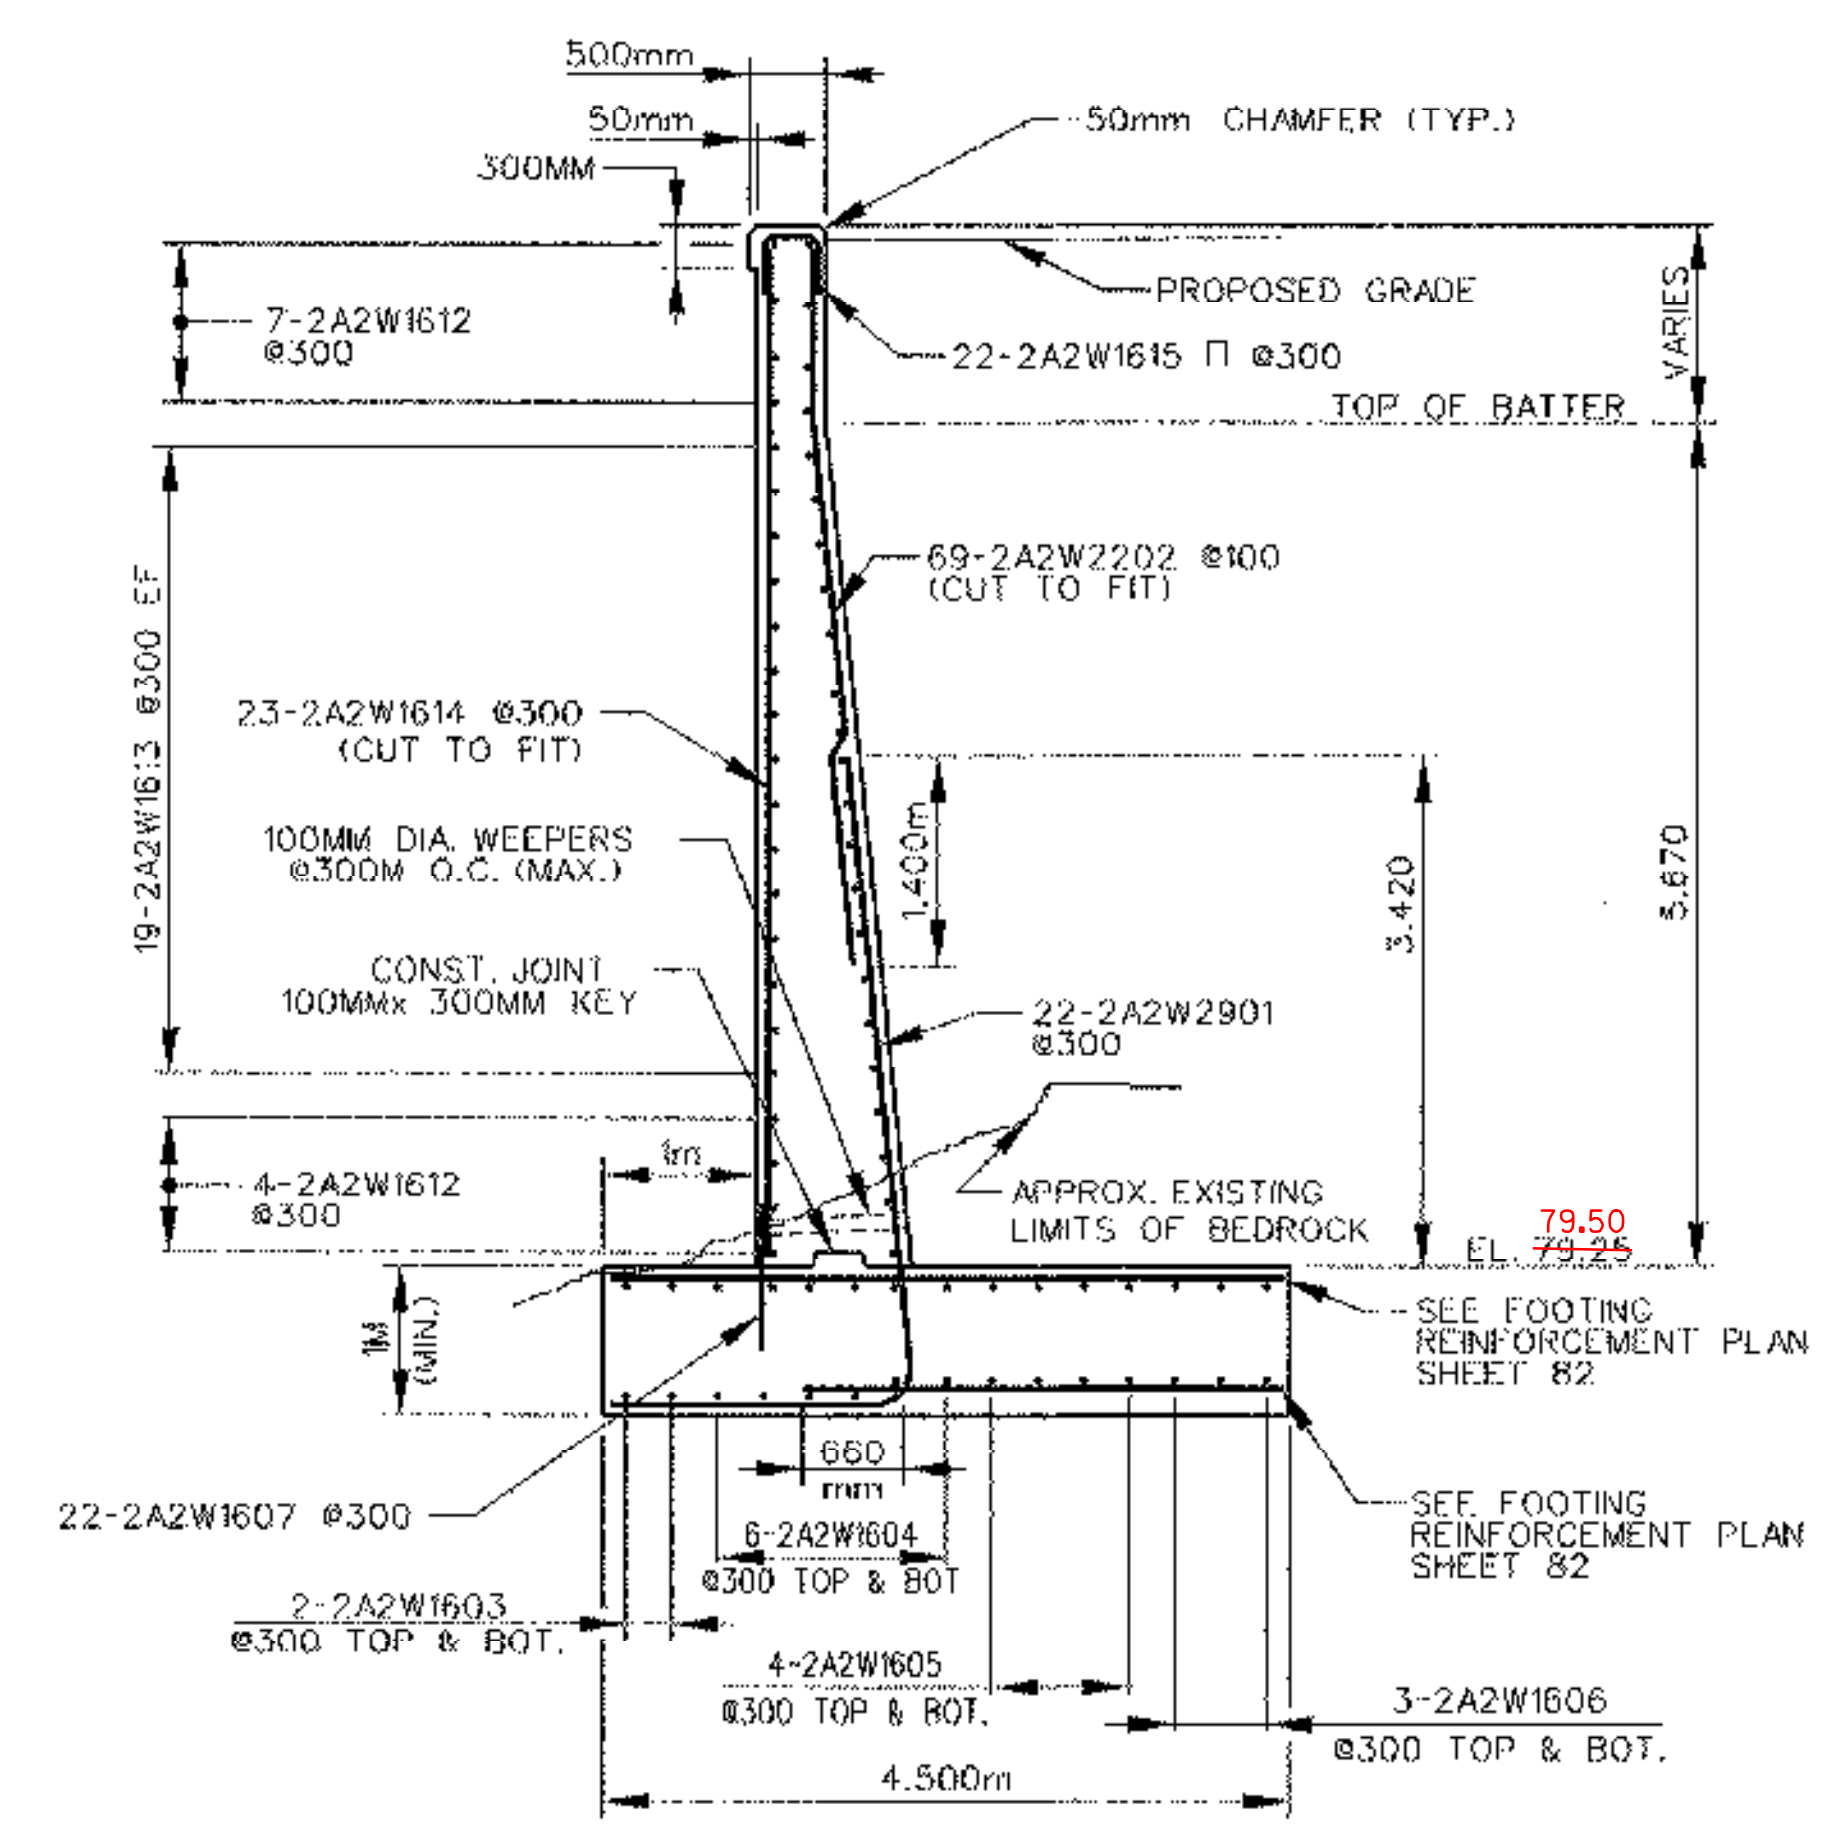

TYPICAL NORTHEAST WINGWALL SECTION B-B
SCALE 1:50

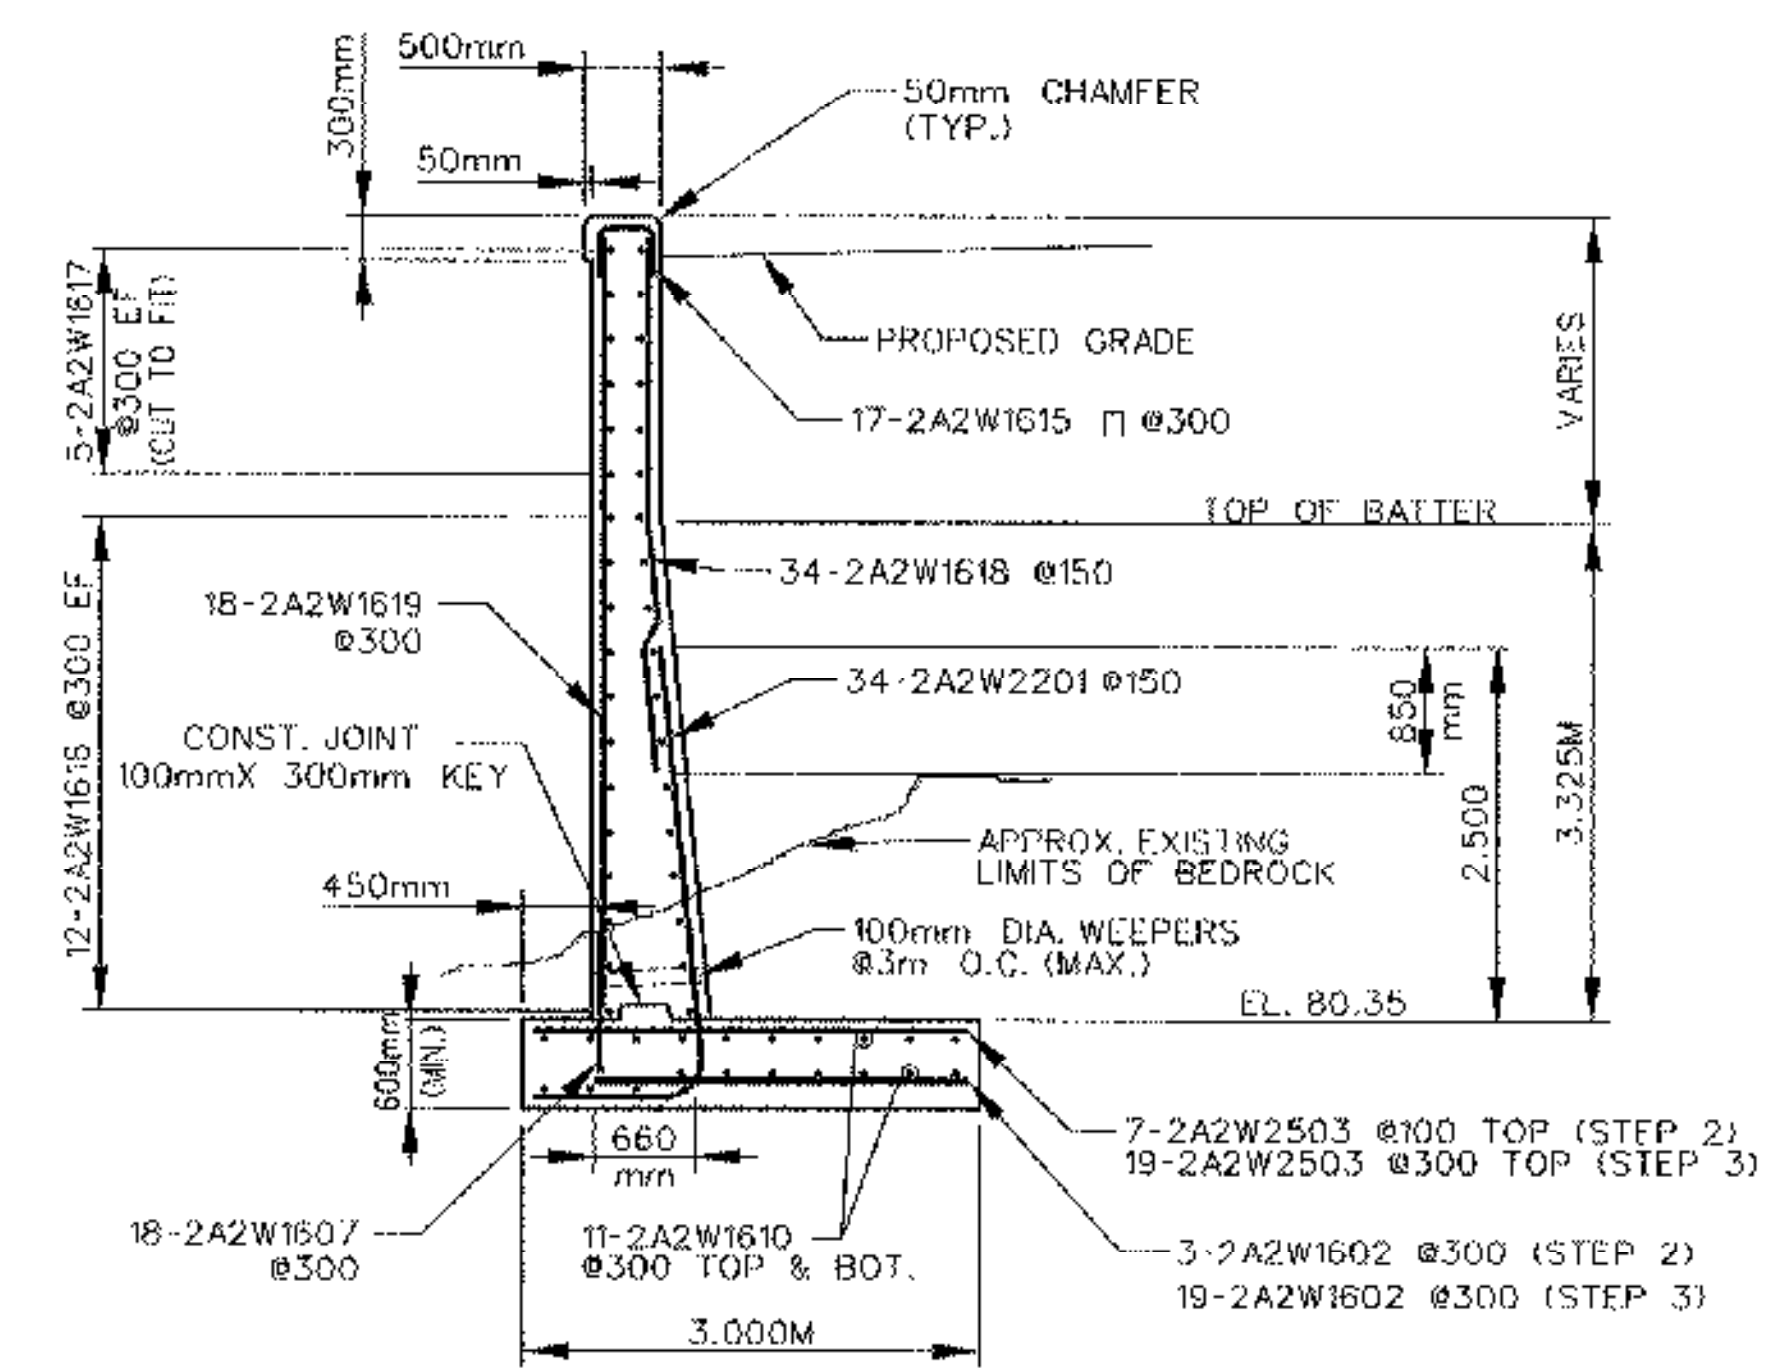

TYPICAL NORTHEAST WINGWALL SECTION A-A
SCALE 1:50

STATE OF VERMONT AGENCY OF TRANSPORTATION

Town Of	BRATTLEBORO	Bridge No.	62.56
Highway No.	VT. ROUTE 9	Log Sta.	
		Surv. Sta.	

ROUTE 9 BRIDGE CONCRETE WINGWALL SECTIONS

Designed By	TTTT	Drawn By	DHL
Checked By	GJB	Bridge Design Supervisor	JHR
		Date	

PROJECT	BRATTLEBORO	PROJECT NO.	NH 010-2(2)
---------	-------------	-------------	-------------