



SOUTH ABUTMENT FOOTING REINFORCEMENT PLAN
SCALE 1:75

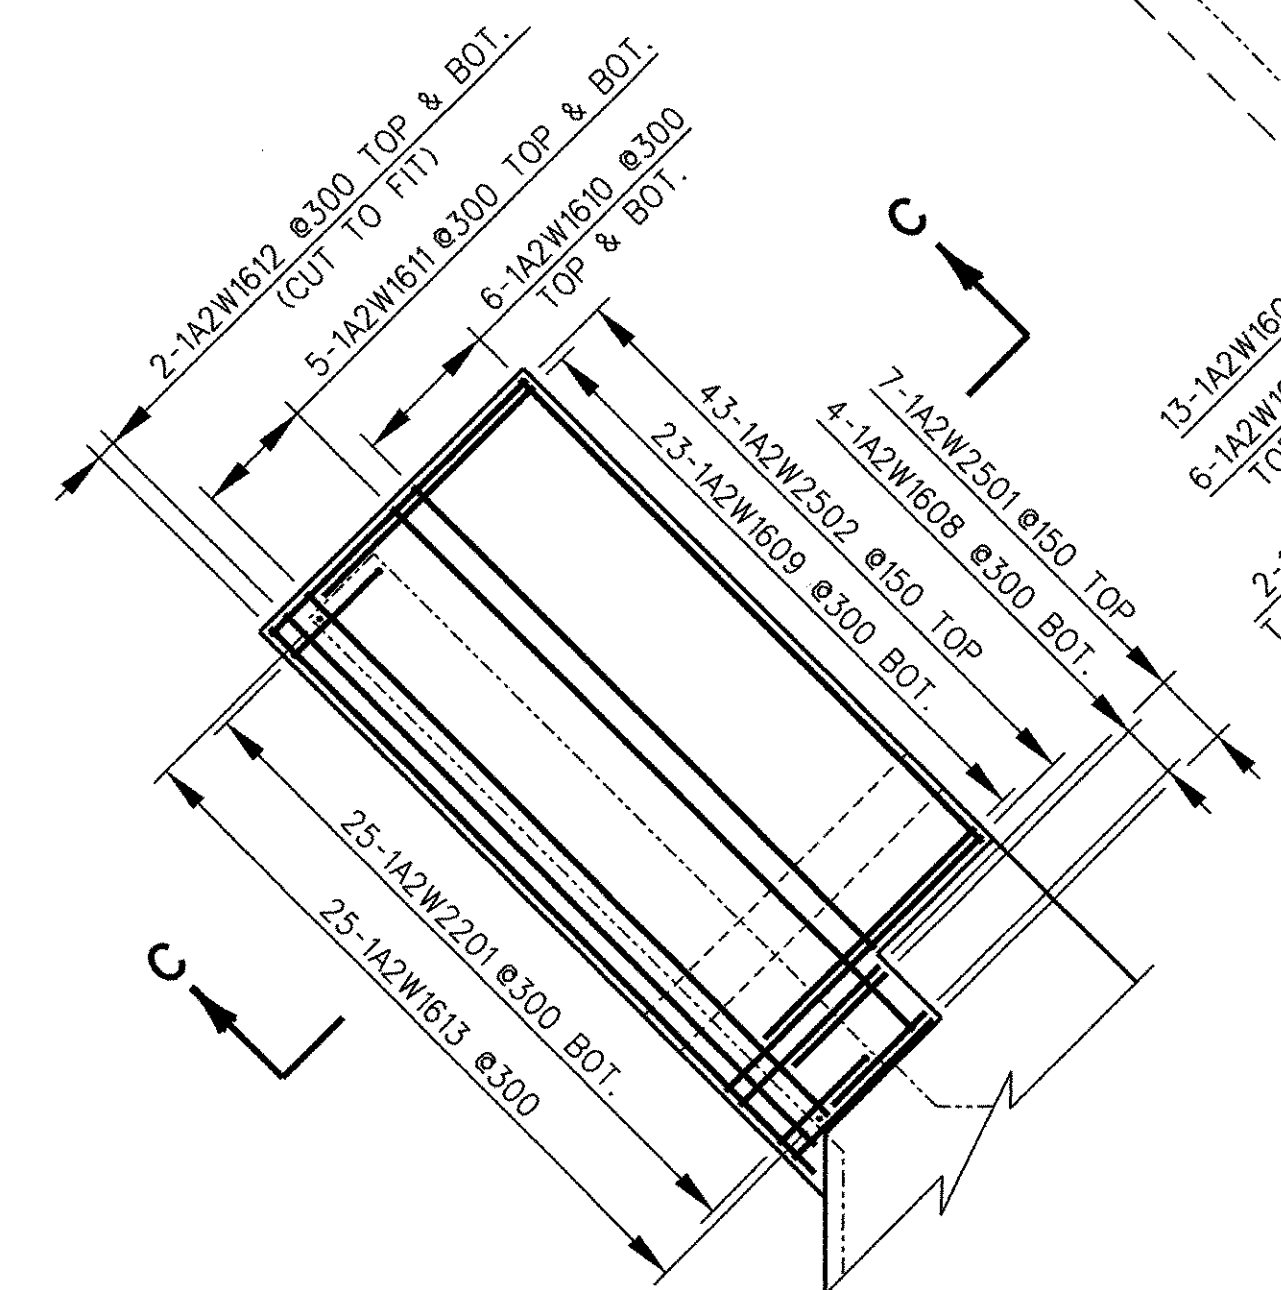

S. ABUTMENT F. WINGWALL FOOTING REINFORCEMENT PLAN (LEVEL 1)
SCALE 1:75

S. ABUTMENT F. WINGWALL FOOTING REINFORCEMENT PLAN (LEVEL 2)
SCALE 1:75

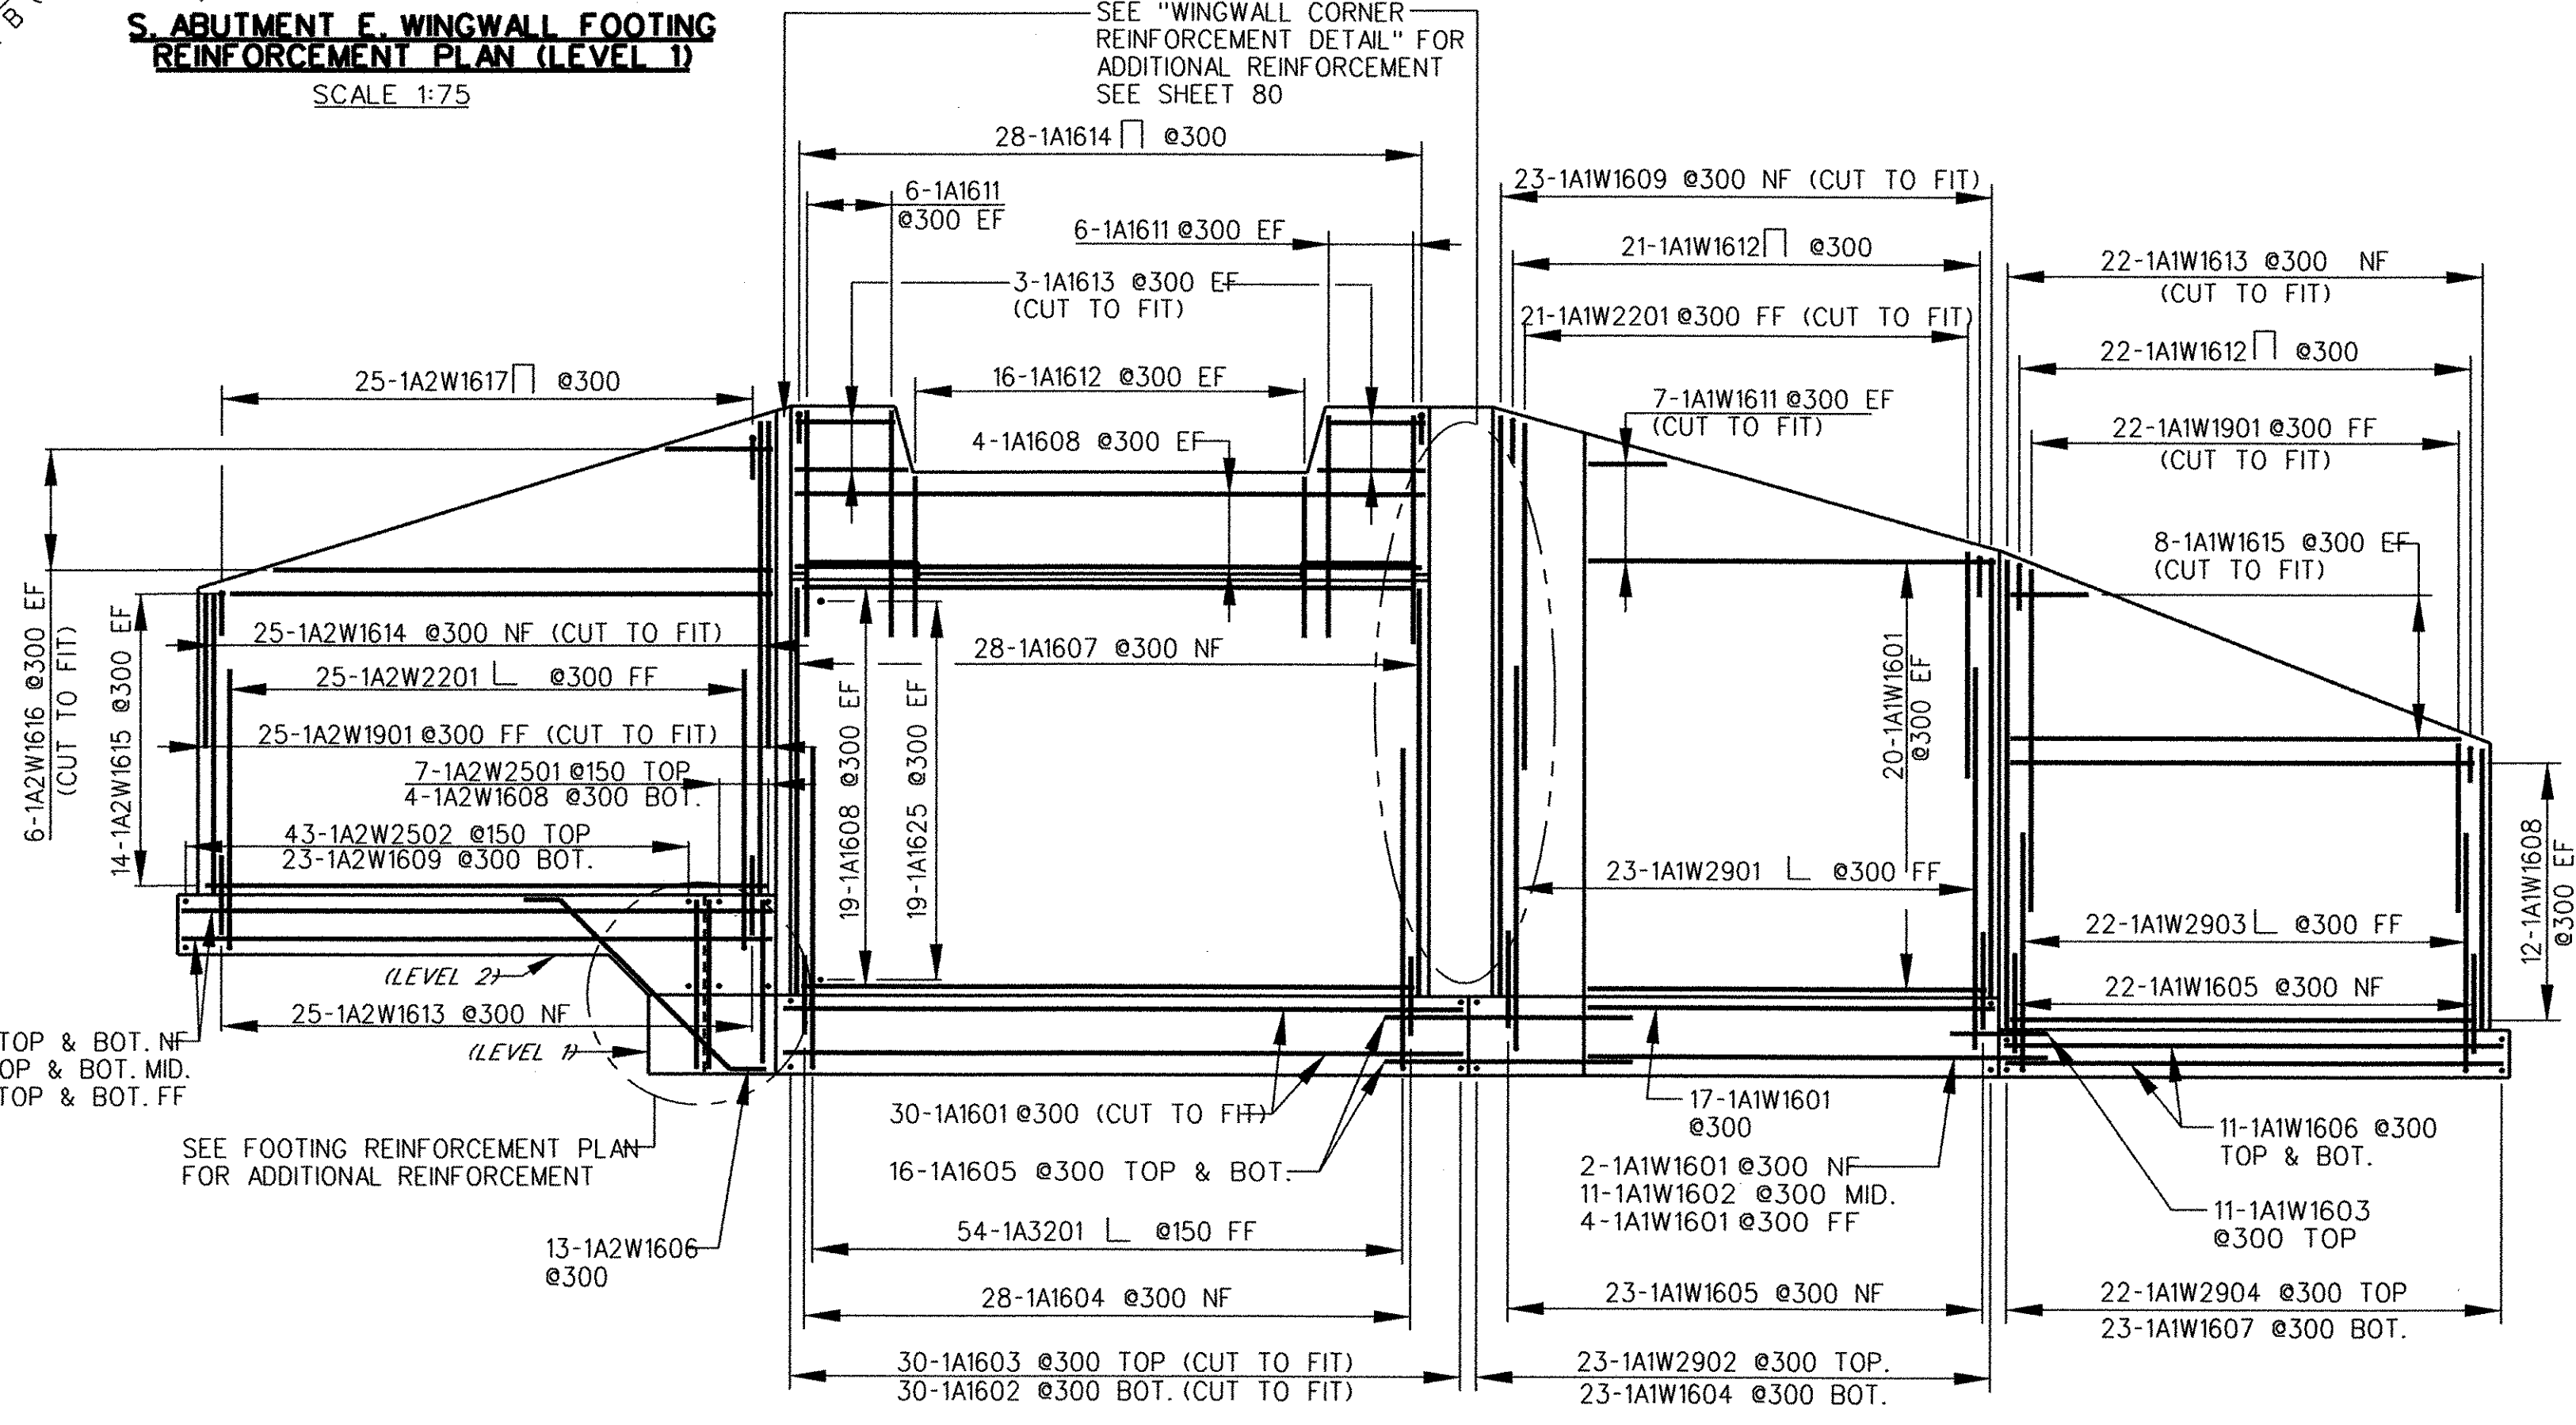

SOUTH ABUTMENT REINFORCEMENT ELEVATION
SCALE 1:75

STATE OF VERMONT AGENCY OF TRANSPORTATION			
Town Of	BRATTLEBORO	Bridge No.	62.56
Highway No.	VT. ROUTE 9	Log Sta.	
		Surv. Sta.	
ROUTE 9 BRIDGE			
SOUTH ABUTMENT REINFORCEMENT PLAN & ELEVATION			
Designed By		Drawn By	LRD
Checked By	Date	Bridge Design Supervisor	Date
PROJECT	BRATTLEBORO	PROJECT NO.	NH 010-2(2)
I.G.C. Info.			
Bridge Sheet No.	Sheet 81 of 145		

Plot Date: 10-03-2002
File: rt9br163