




NORTH ABUTMENT FOOTING REINFORCEMENT PLAN
SCALE 1:75

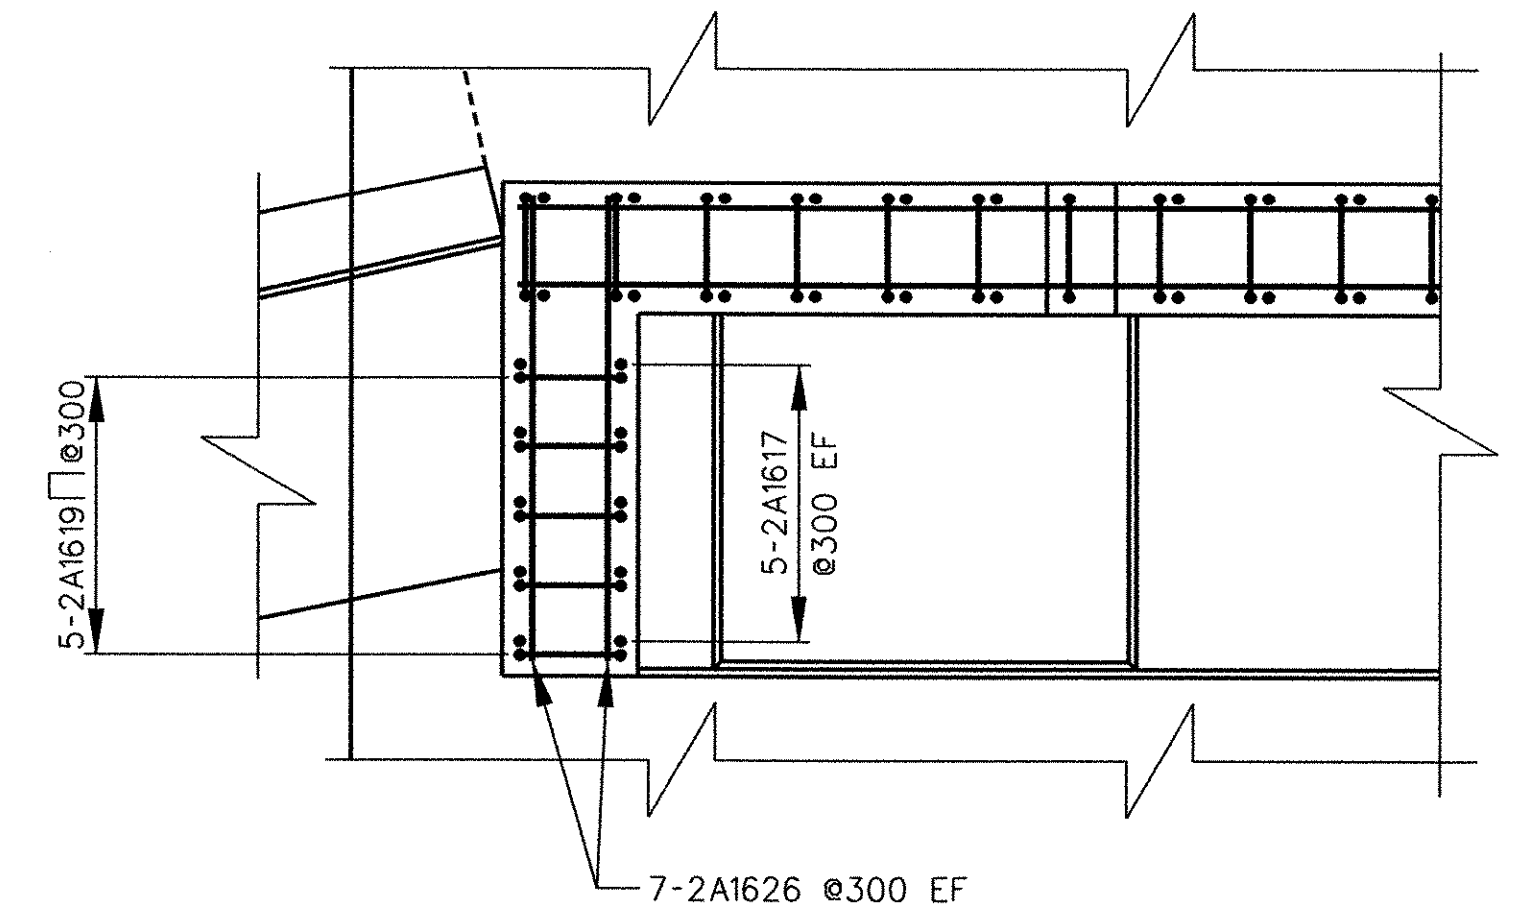

No. ABUTMENT CURTAIN WALL DETAIL
SCALE: 1:25

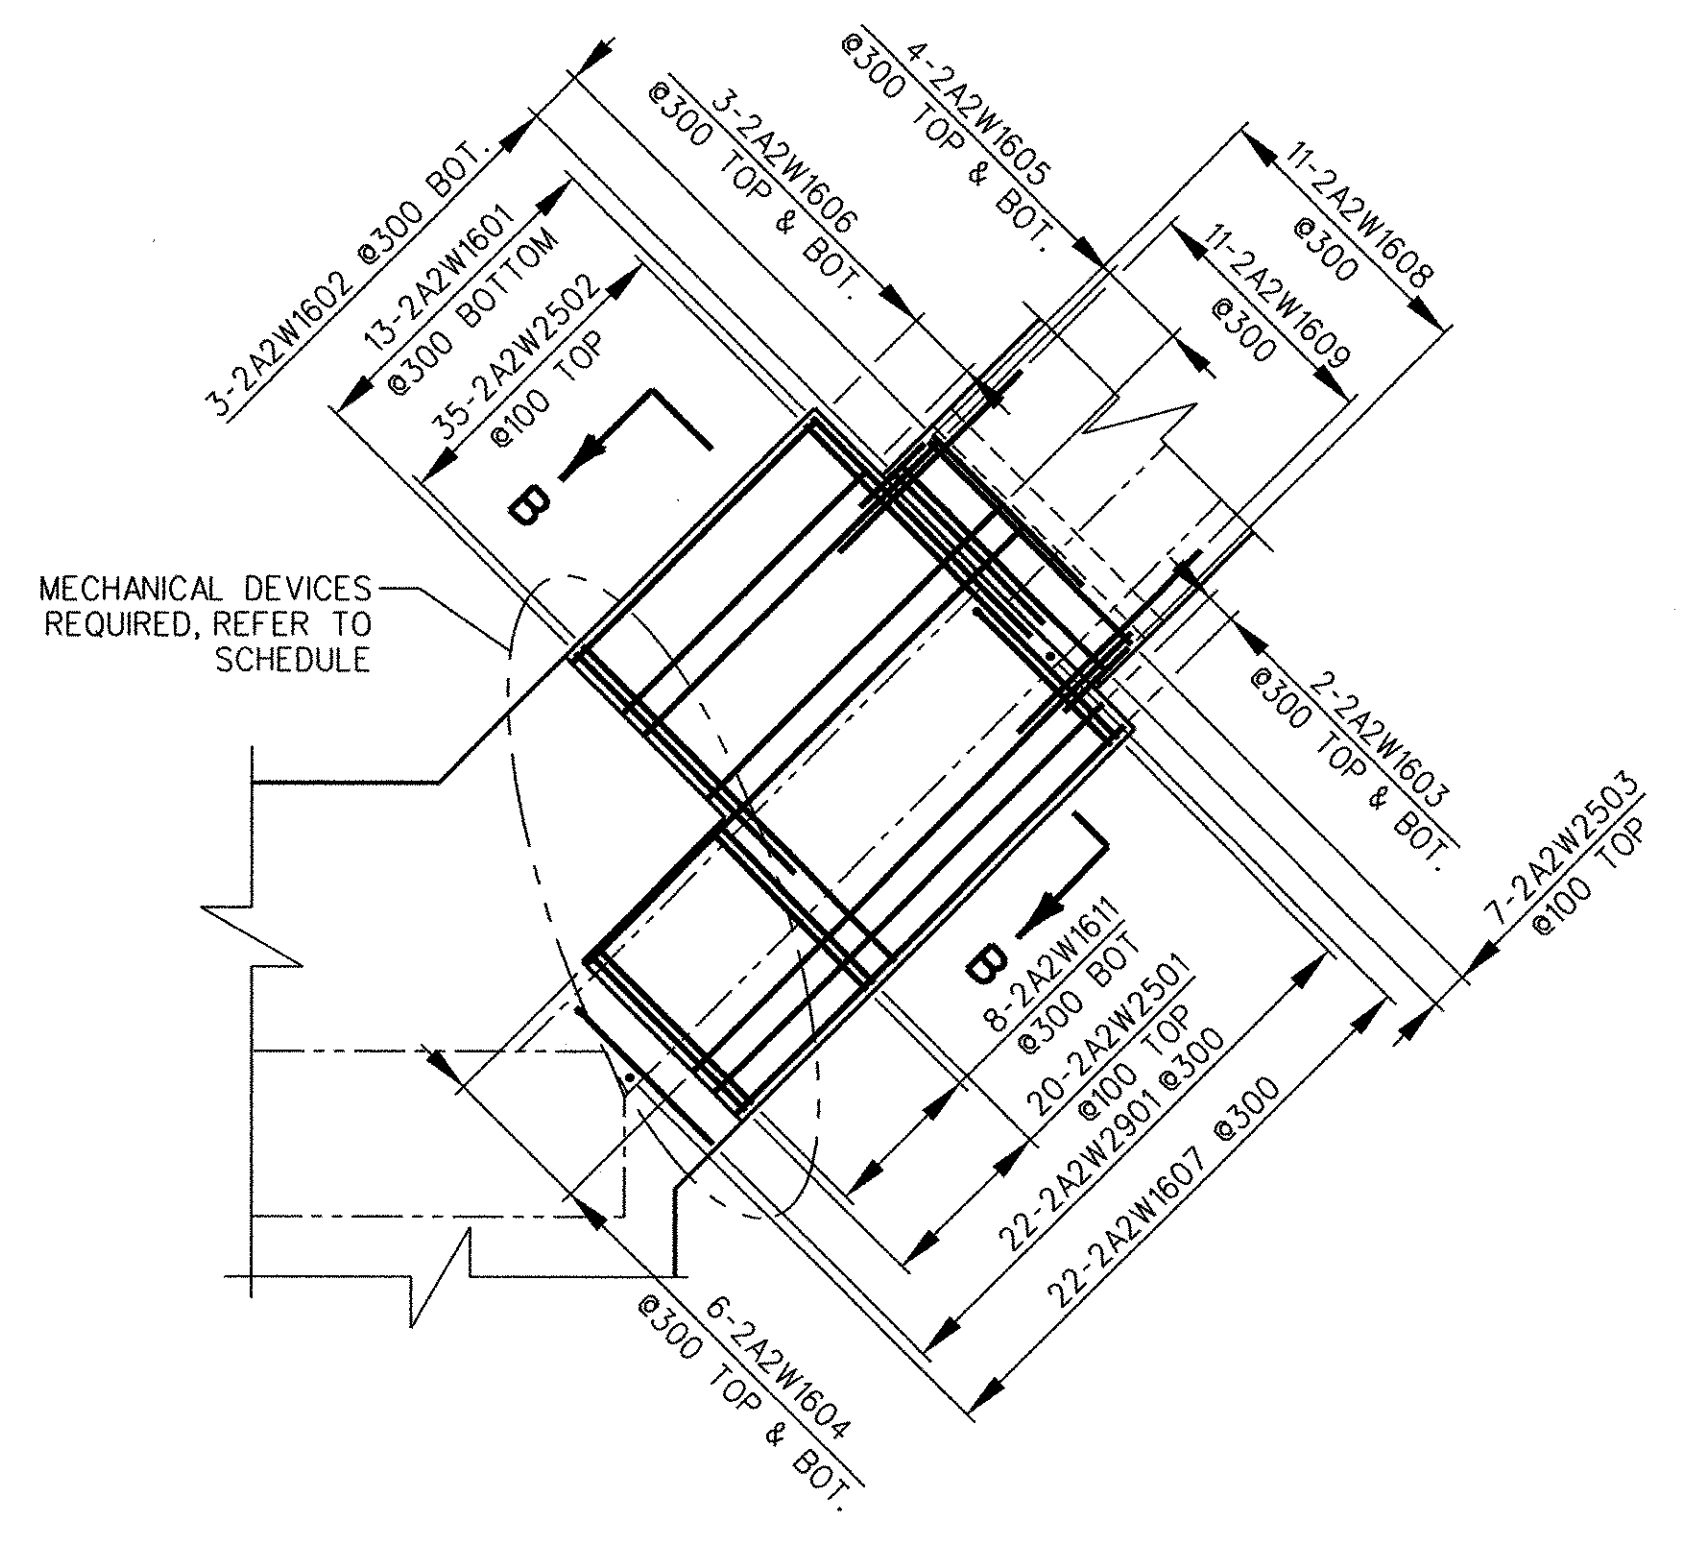

DETAIL 2A2W
SCALE 1:75

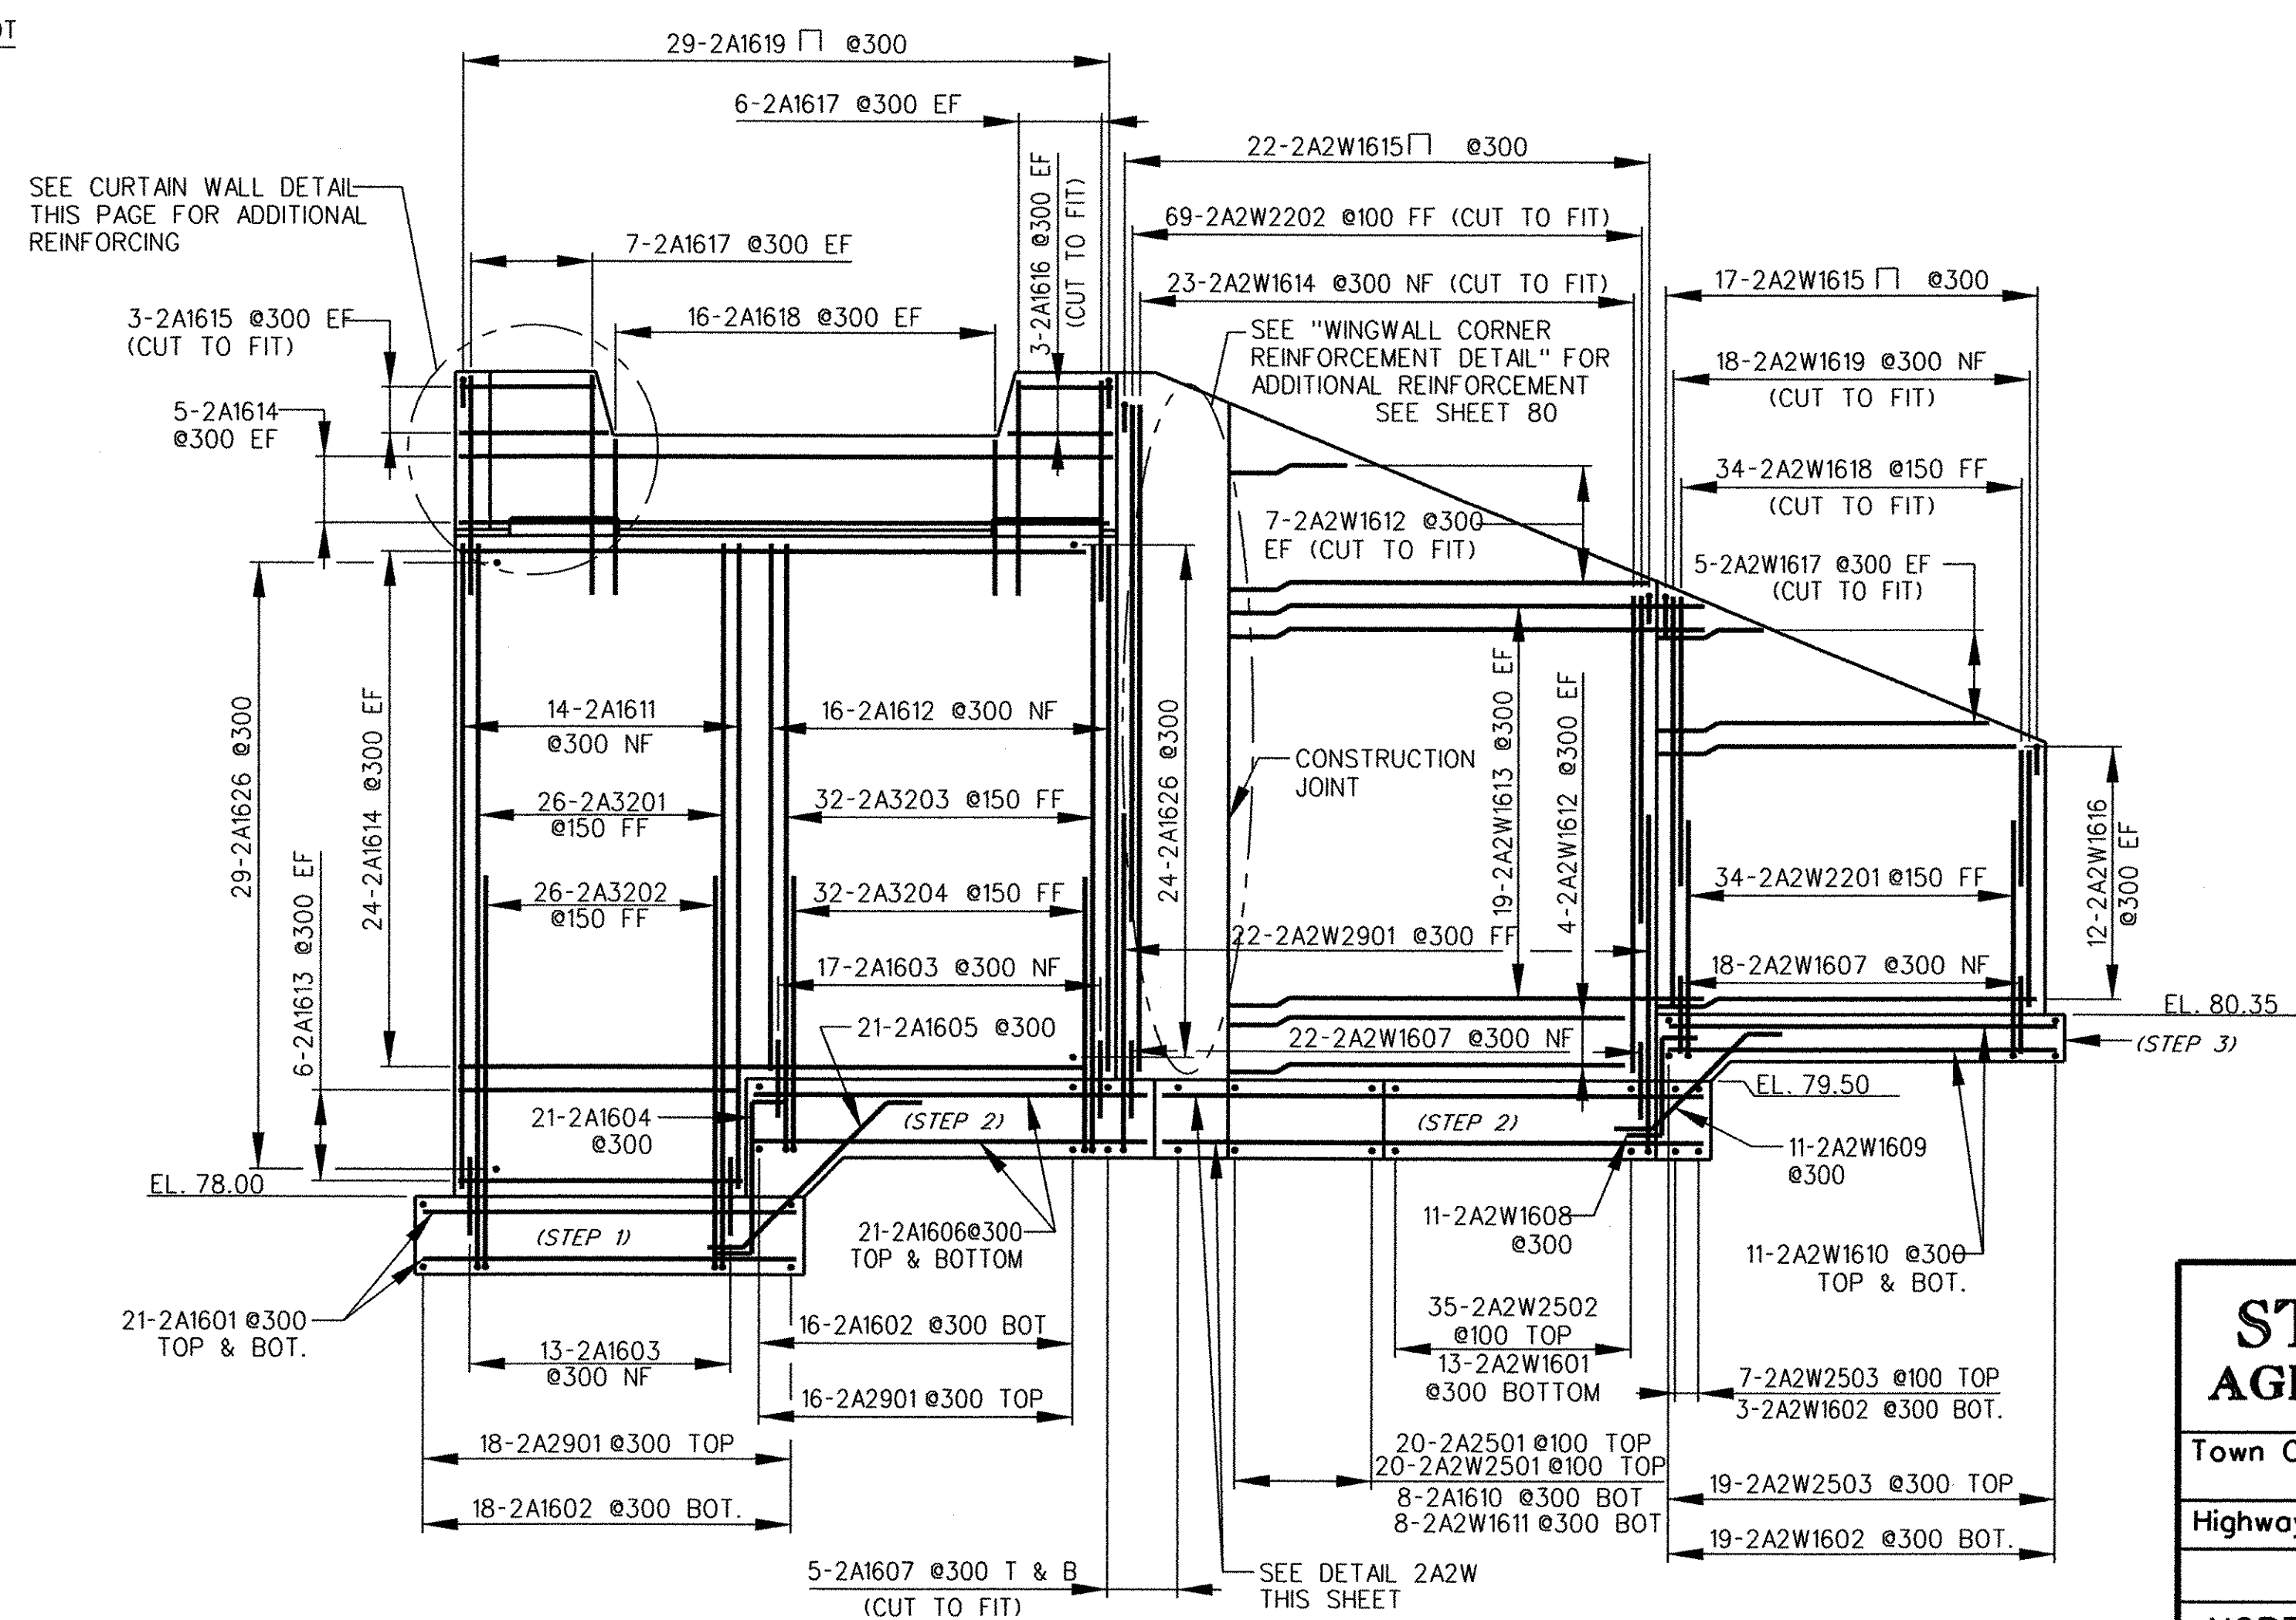

NORTH ABUTMENT REINFORCEMENT ELEVATION
SCALE 1:75

STATE OF VERMONT AGENCY OF TRANSPORTATION		
Town Of	BRATTLEBORO	Bridge No. 62.56
Highway No.	VT. ROUTE 9	Log Sta.
		Surv. Sta.
ROUTE 9 BRIDGE		
NORTH ABUTMENT FOOTING PLAN & ELEVATION		
Designed By	Date	Drawn By LRD
Checked By	Date	Bridge Design Supervisor
		Date
PROJECT	BRATTLEBORO	PROJECT NO. NH BRF 012-1(33)
I.G.C. Info.		
Bridge Sheet No. 14		Sheet 82 of 145