


FRAMING PLAN
SCALE 1:50

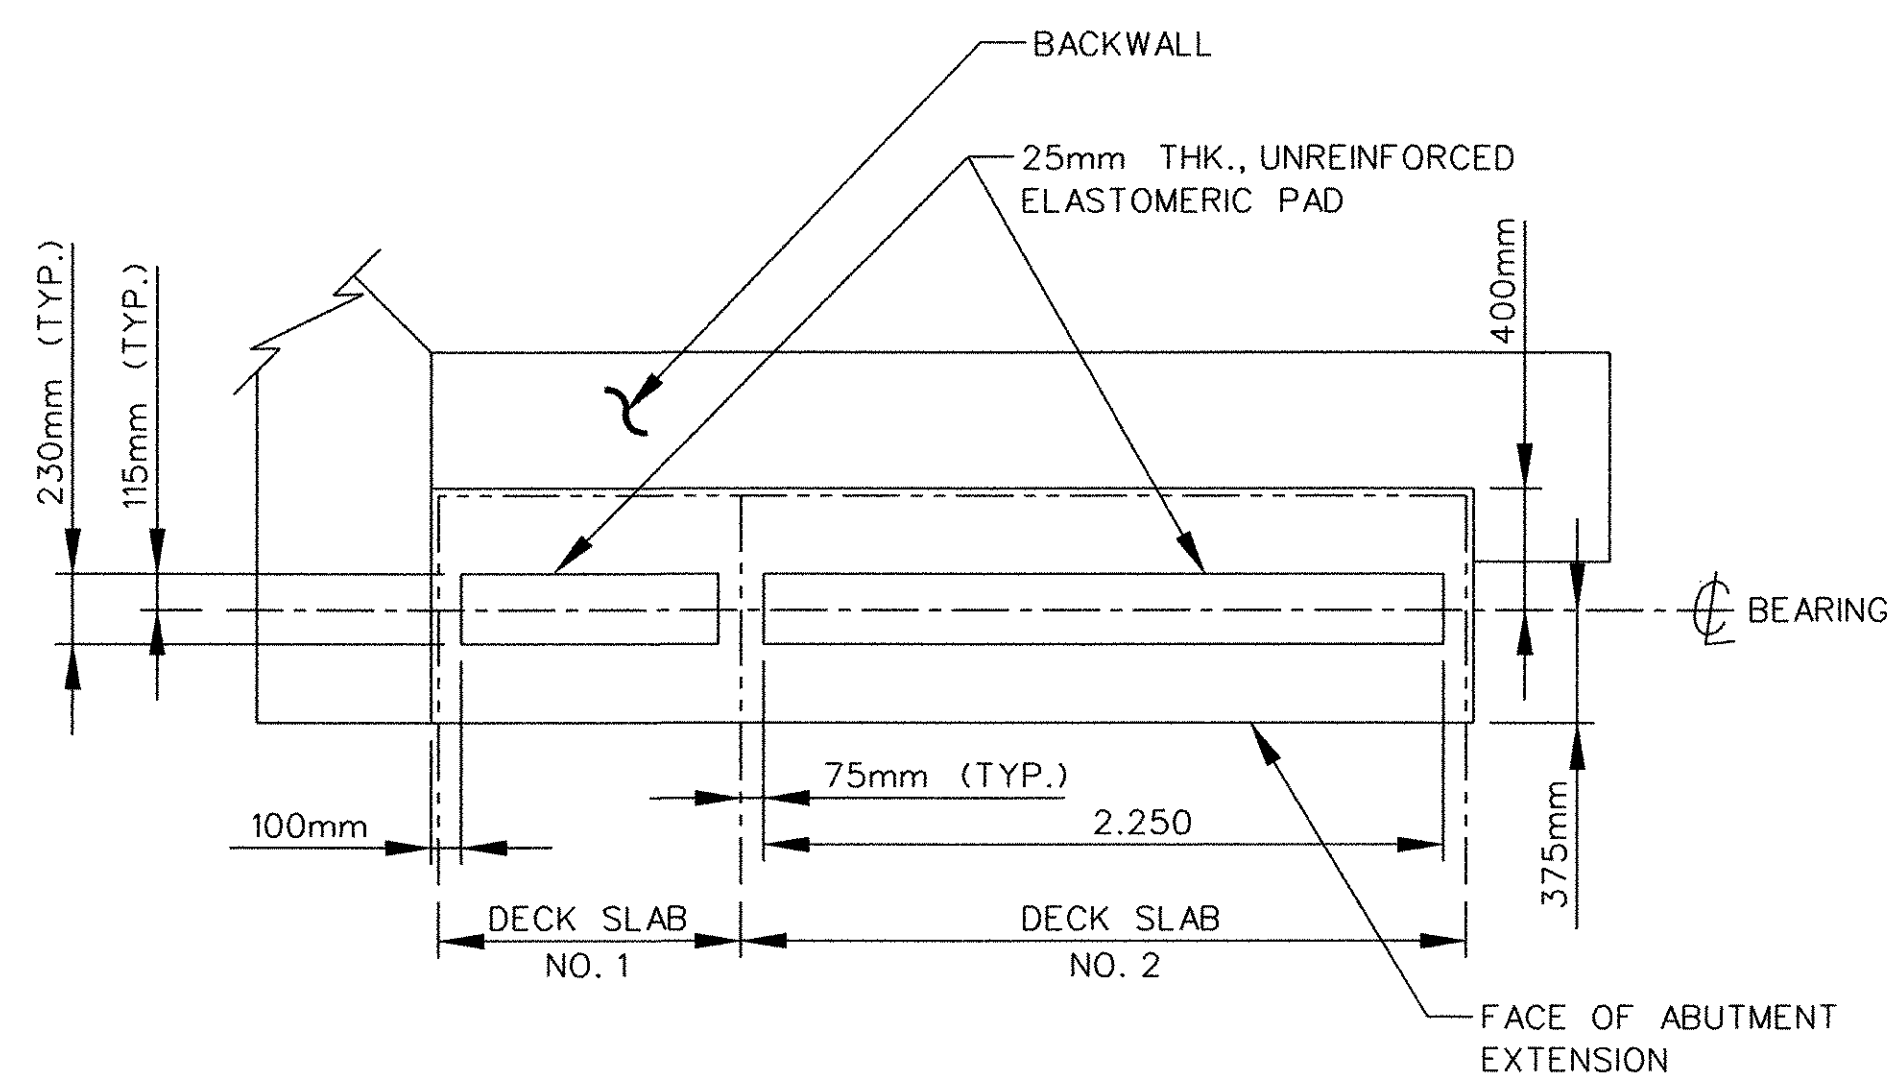

BEARING PAD LAYOUT
SCALE 1:25

**STATE OF VERMONT
AGENCY OF TRANSPORTATION**

Town Of	BRATTLEBORO	Bridge No.	62.51
Highway No.	VT. ROUTE 9	Log Sta.	
		Surv. Sta.	
SARGENT BROOK			
FRAMING PLAN & BEARING LAYOUT			
Designed By	LM	Drawn By	DHL
Checked By	GJB	Date	
		Bridge Design Supervisor	JHR
		Date	
PROJECT	BRATTLEBORO	PROJECT NO.	NH 010-2(2)
I.G.C. Info.			
Bridge Sheet No. 2		Sheet	91 of 145