


30+210.000

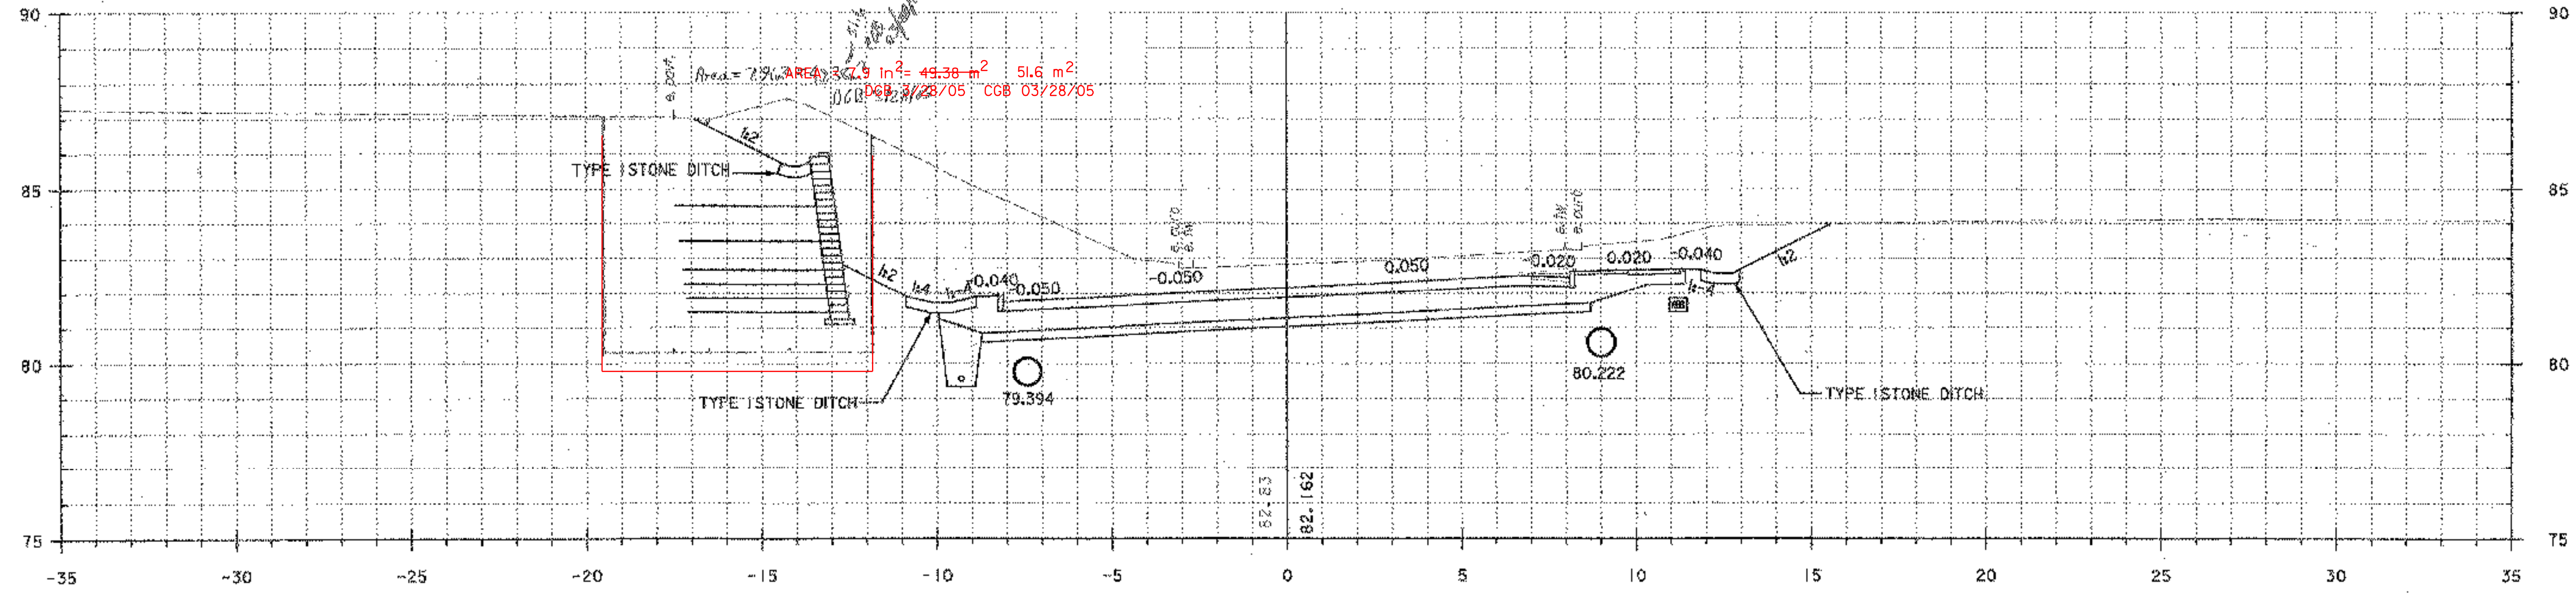

30+200.000

PROJECT: BRATTLEBORO	PROJECT NO.: NH 010-2(2)
DESIGN FILE NAME: ...zlb270x.e2.dgn	PLOT DATE: 09/23/2002
IPARM FILE NAME:	VT ROUTE 9
FROM STA: 30+200.000 TO STA: 30+210.000 SHEET: 105 OF 145	