


30+230.000

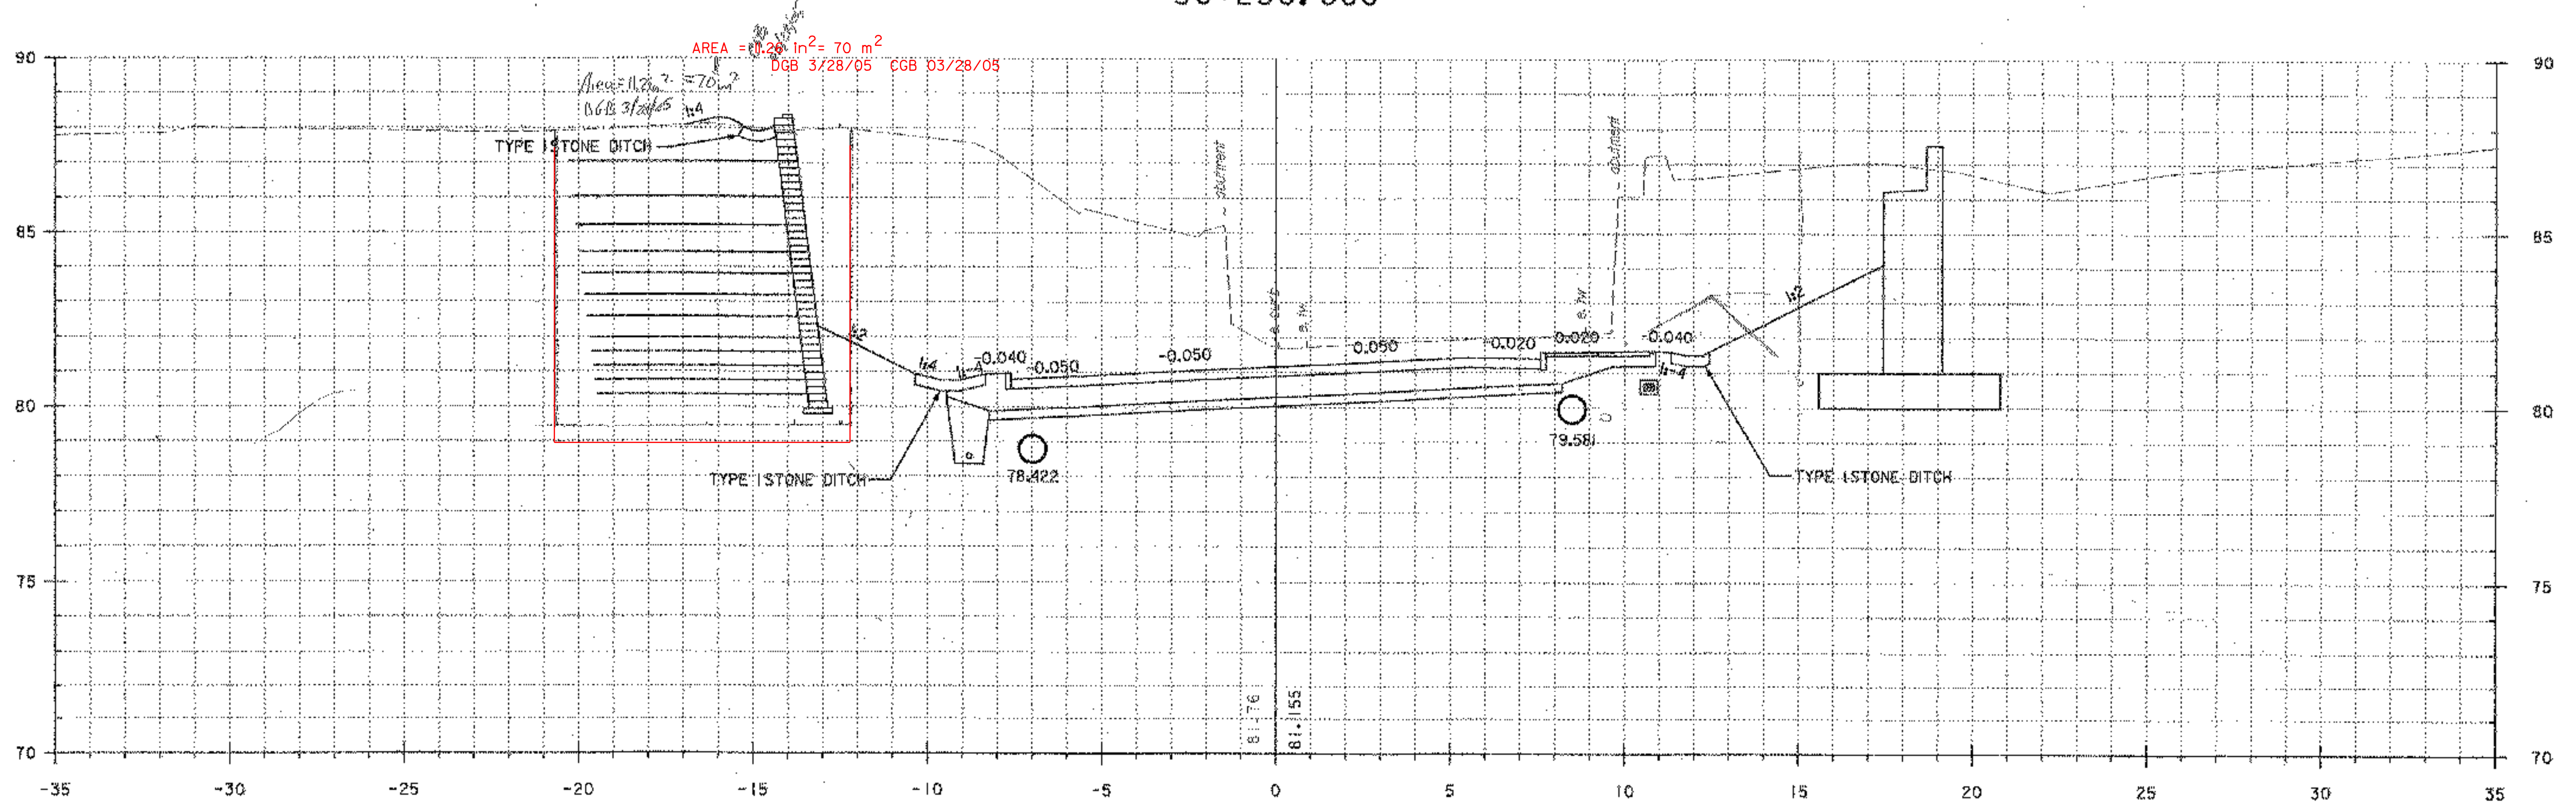

30+220.000

PROJECT:	BRATTLEBORO	PROJECT NO.:	NH 010-2(2)
DESIGN FILE NAME:	...zb270xs2.dgn	PLOT DATE:	09/23/2002
IPARM FILE NAME:			
VT ROUTE 3			
FROM STA: 30+220.000 TO STA: 30+230.000 SHEET: 106 OF 145			