



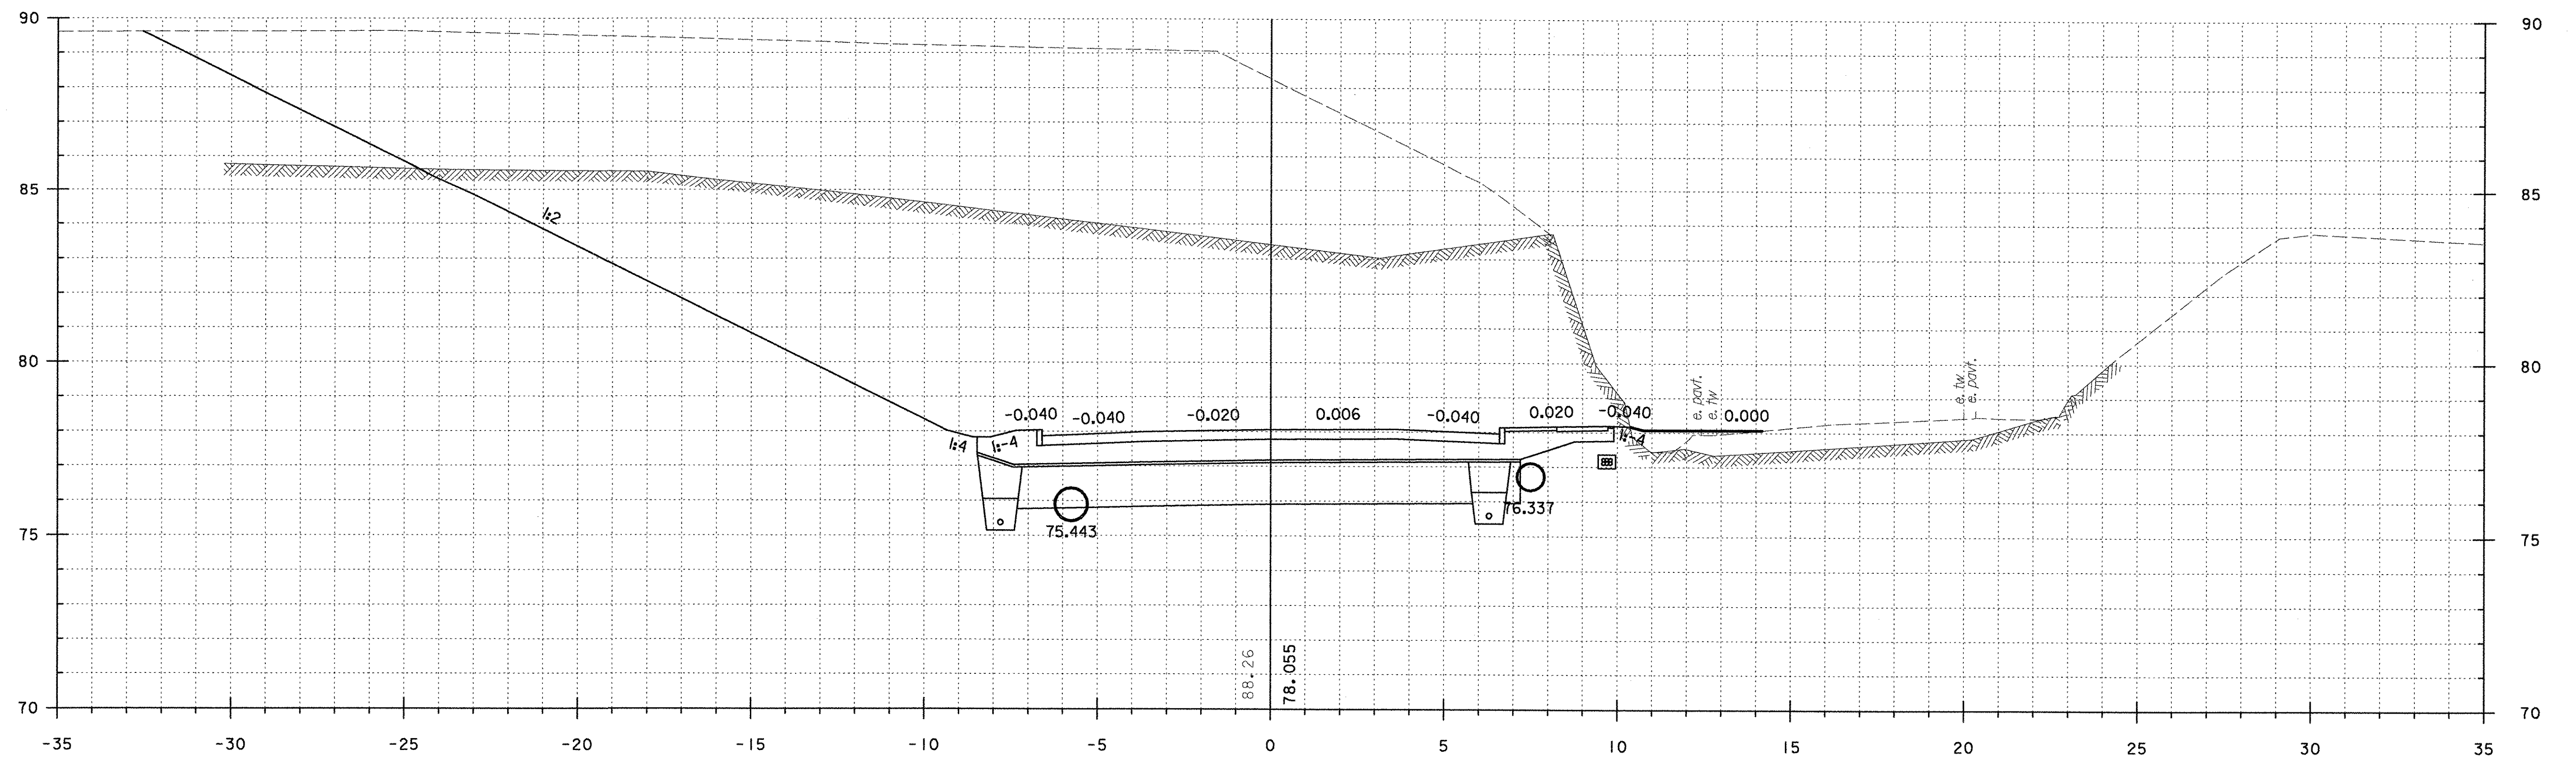

30+310.000

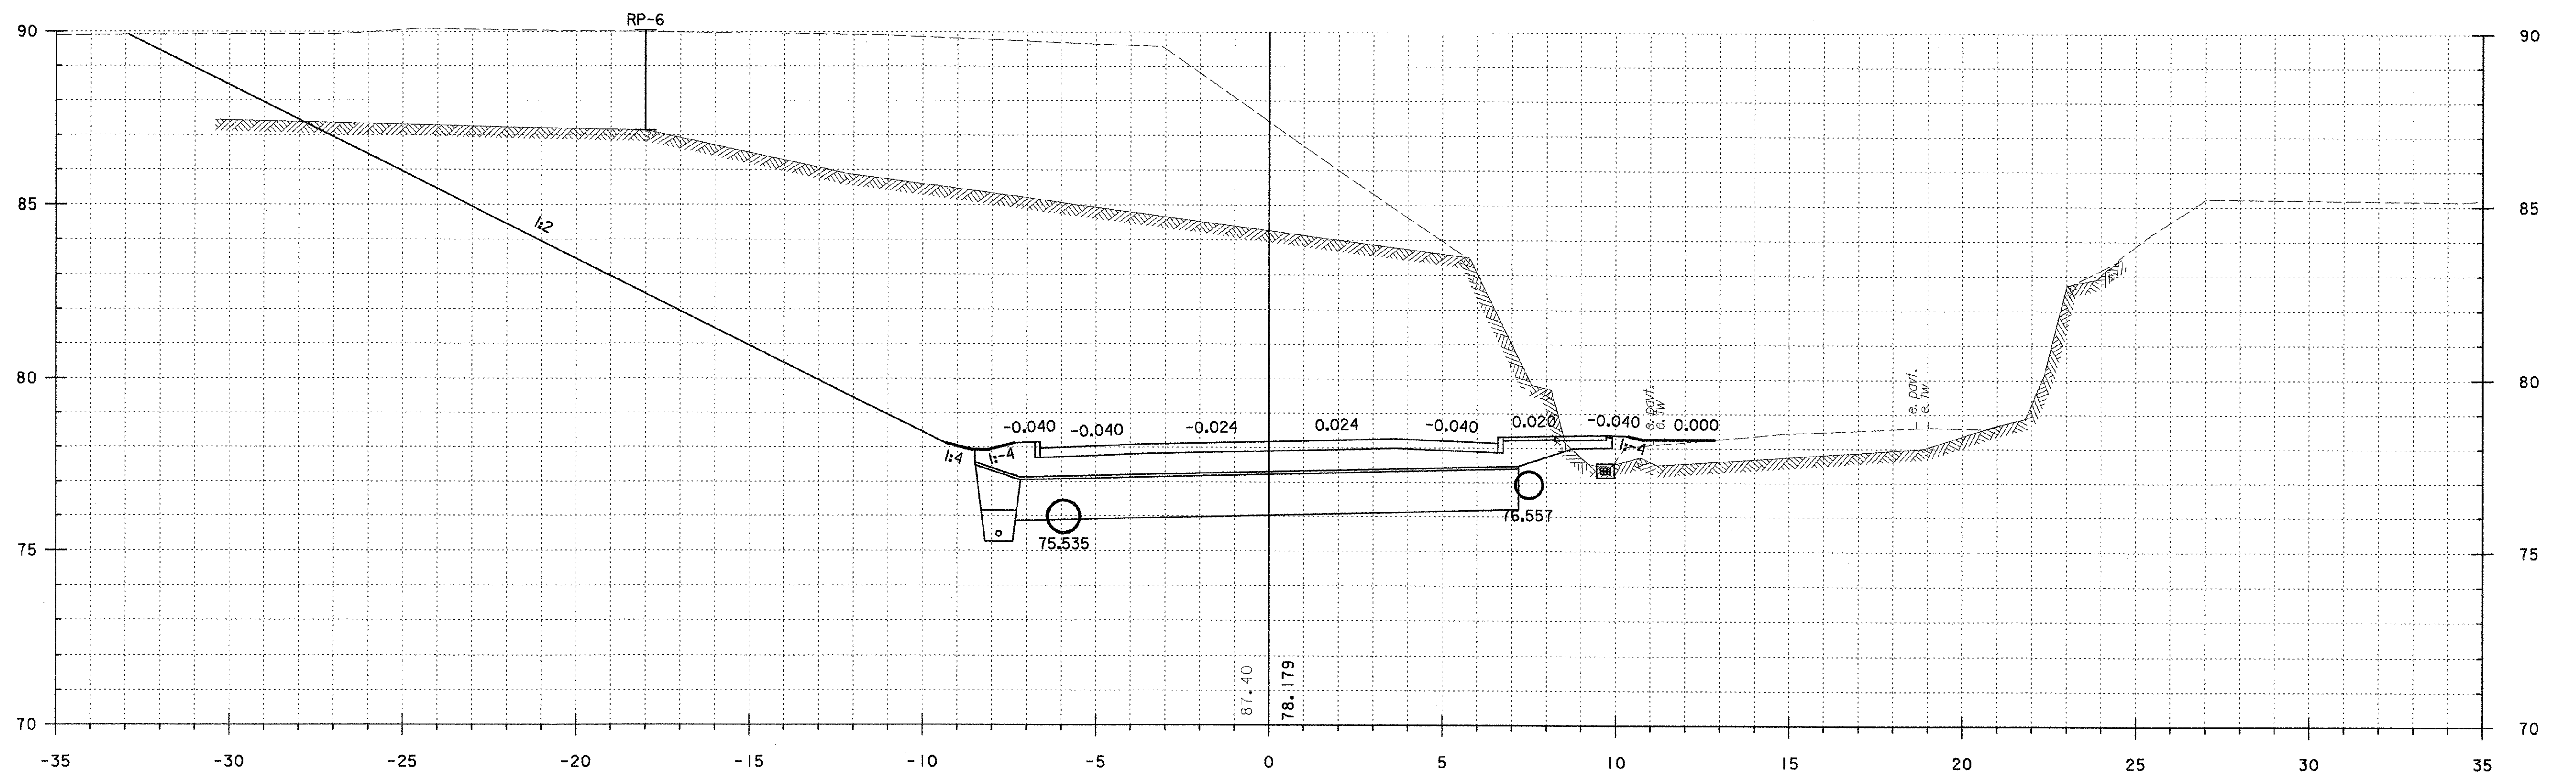

30+300.000