



A 203+50.000

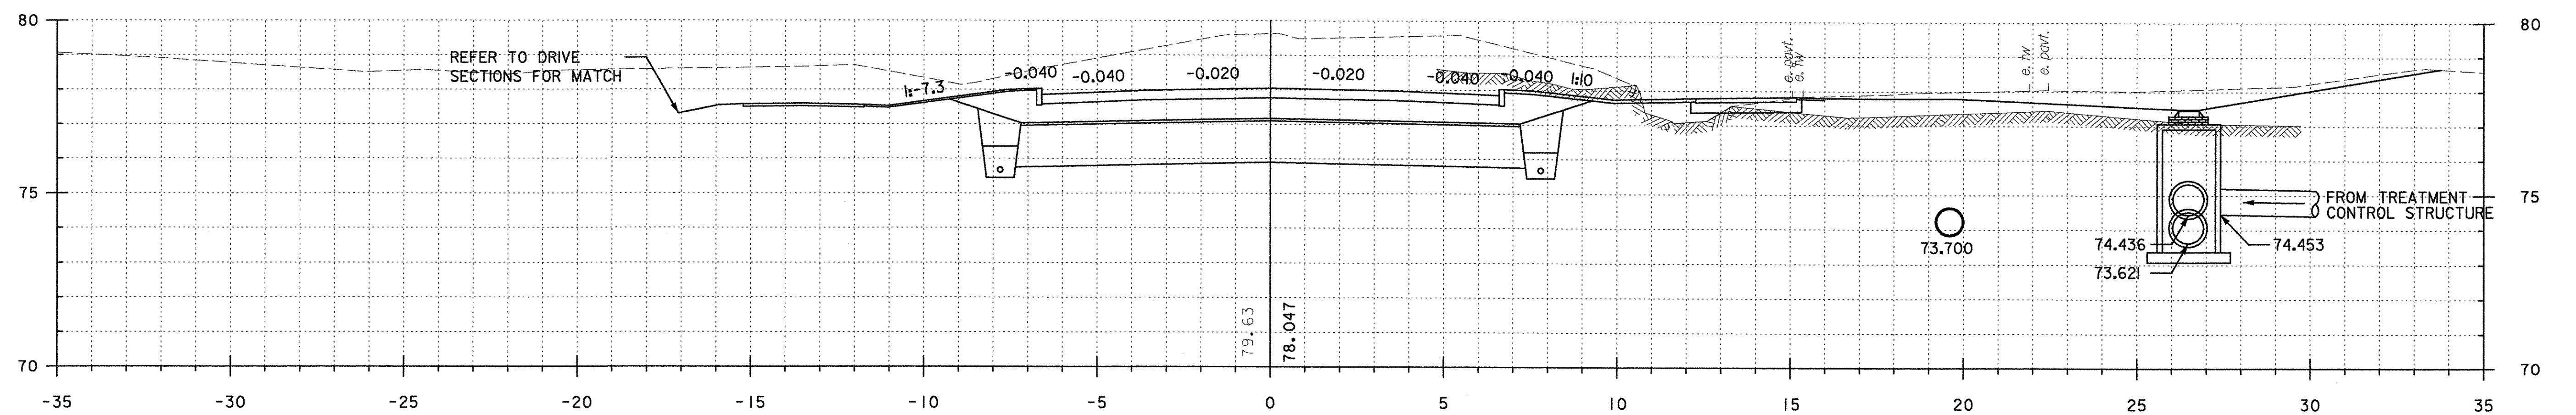

A 203+40.000

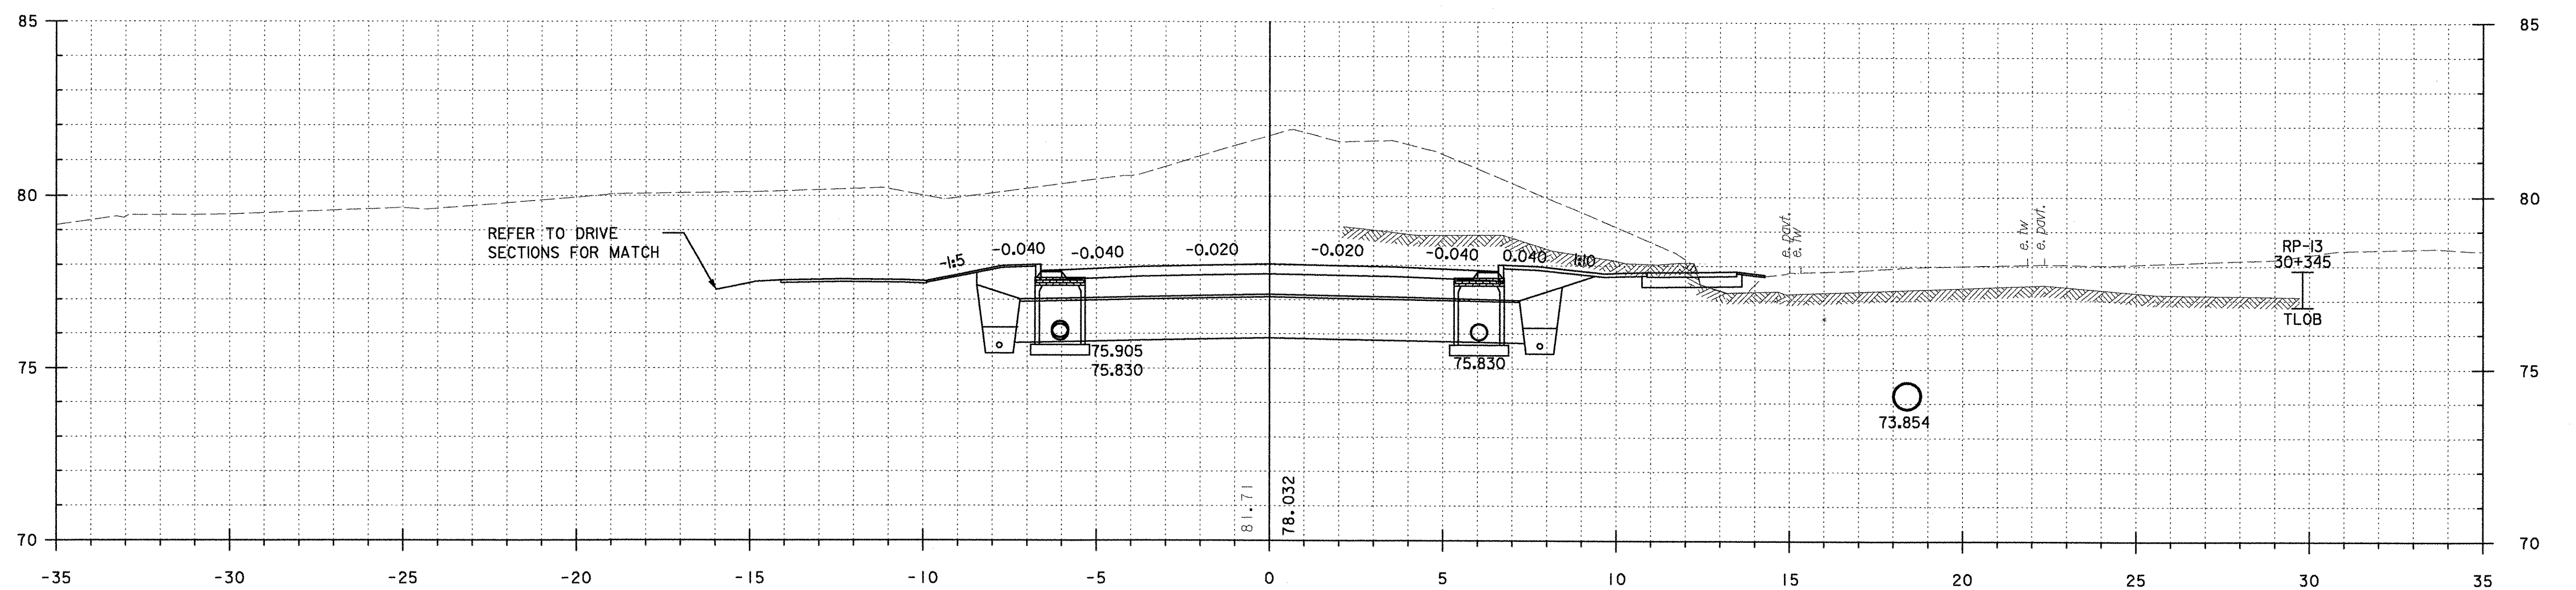

30+340.000