



RAILROAD CROSS SECTIONS

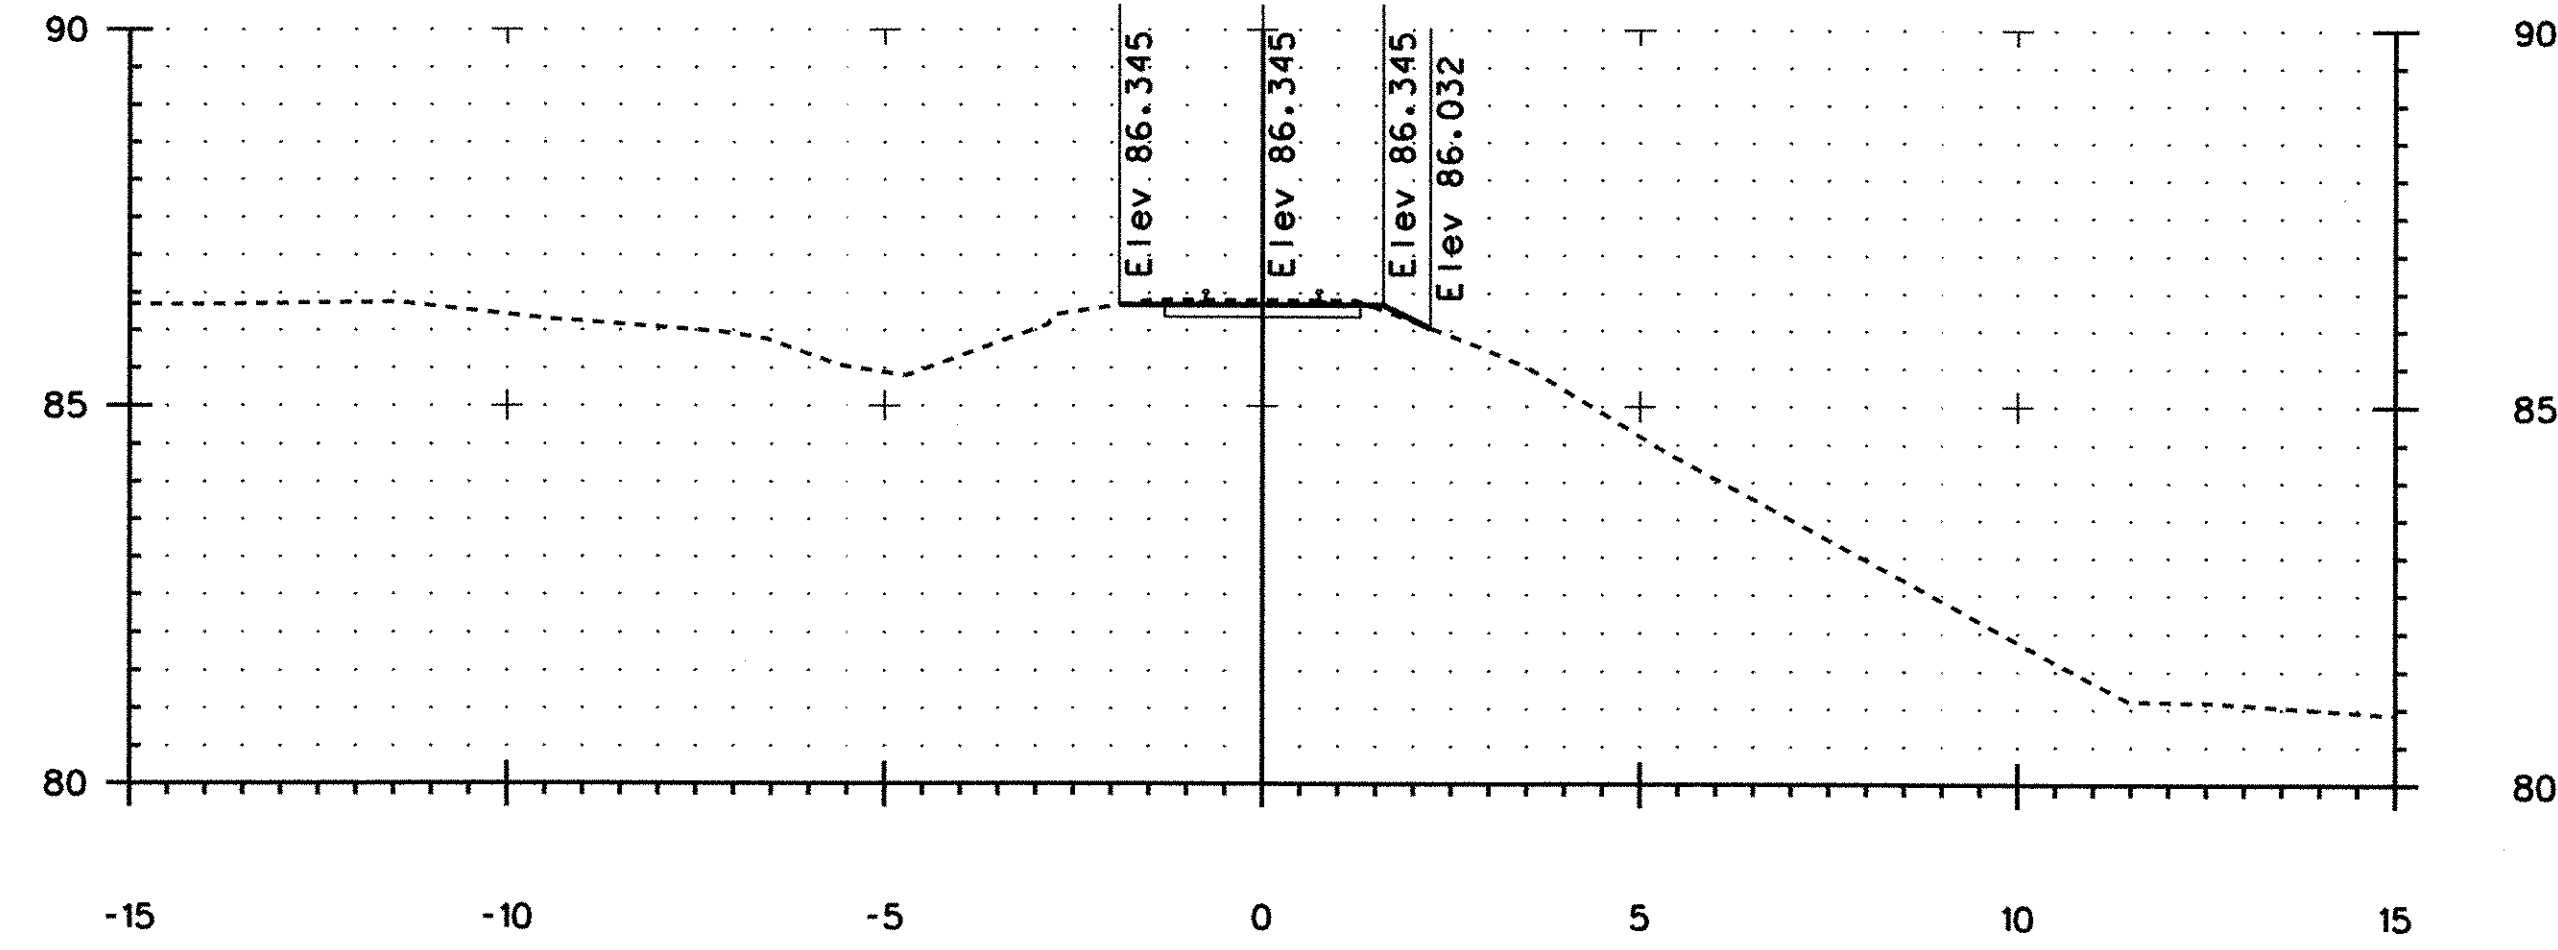


50+020.000

BEGINNING OF RAILROAD CONSTRUCTION
 MEET EXISTING AT STA. 50+020.000
 BEGIN TRACK REHABILITATION

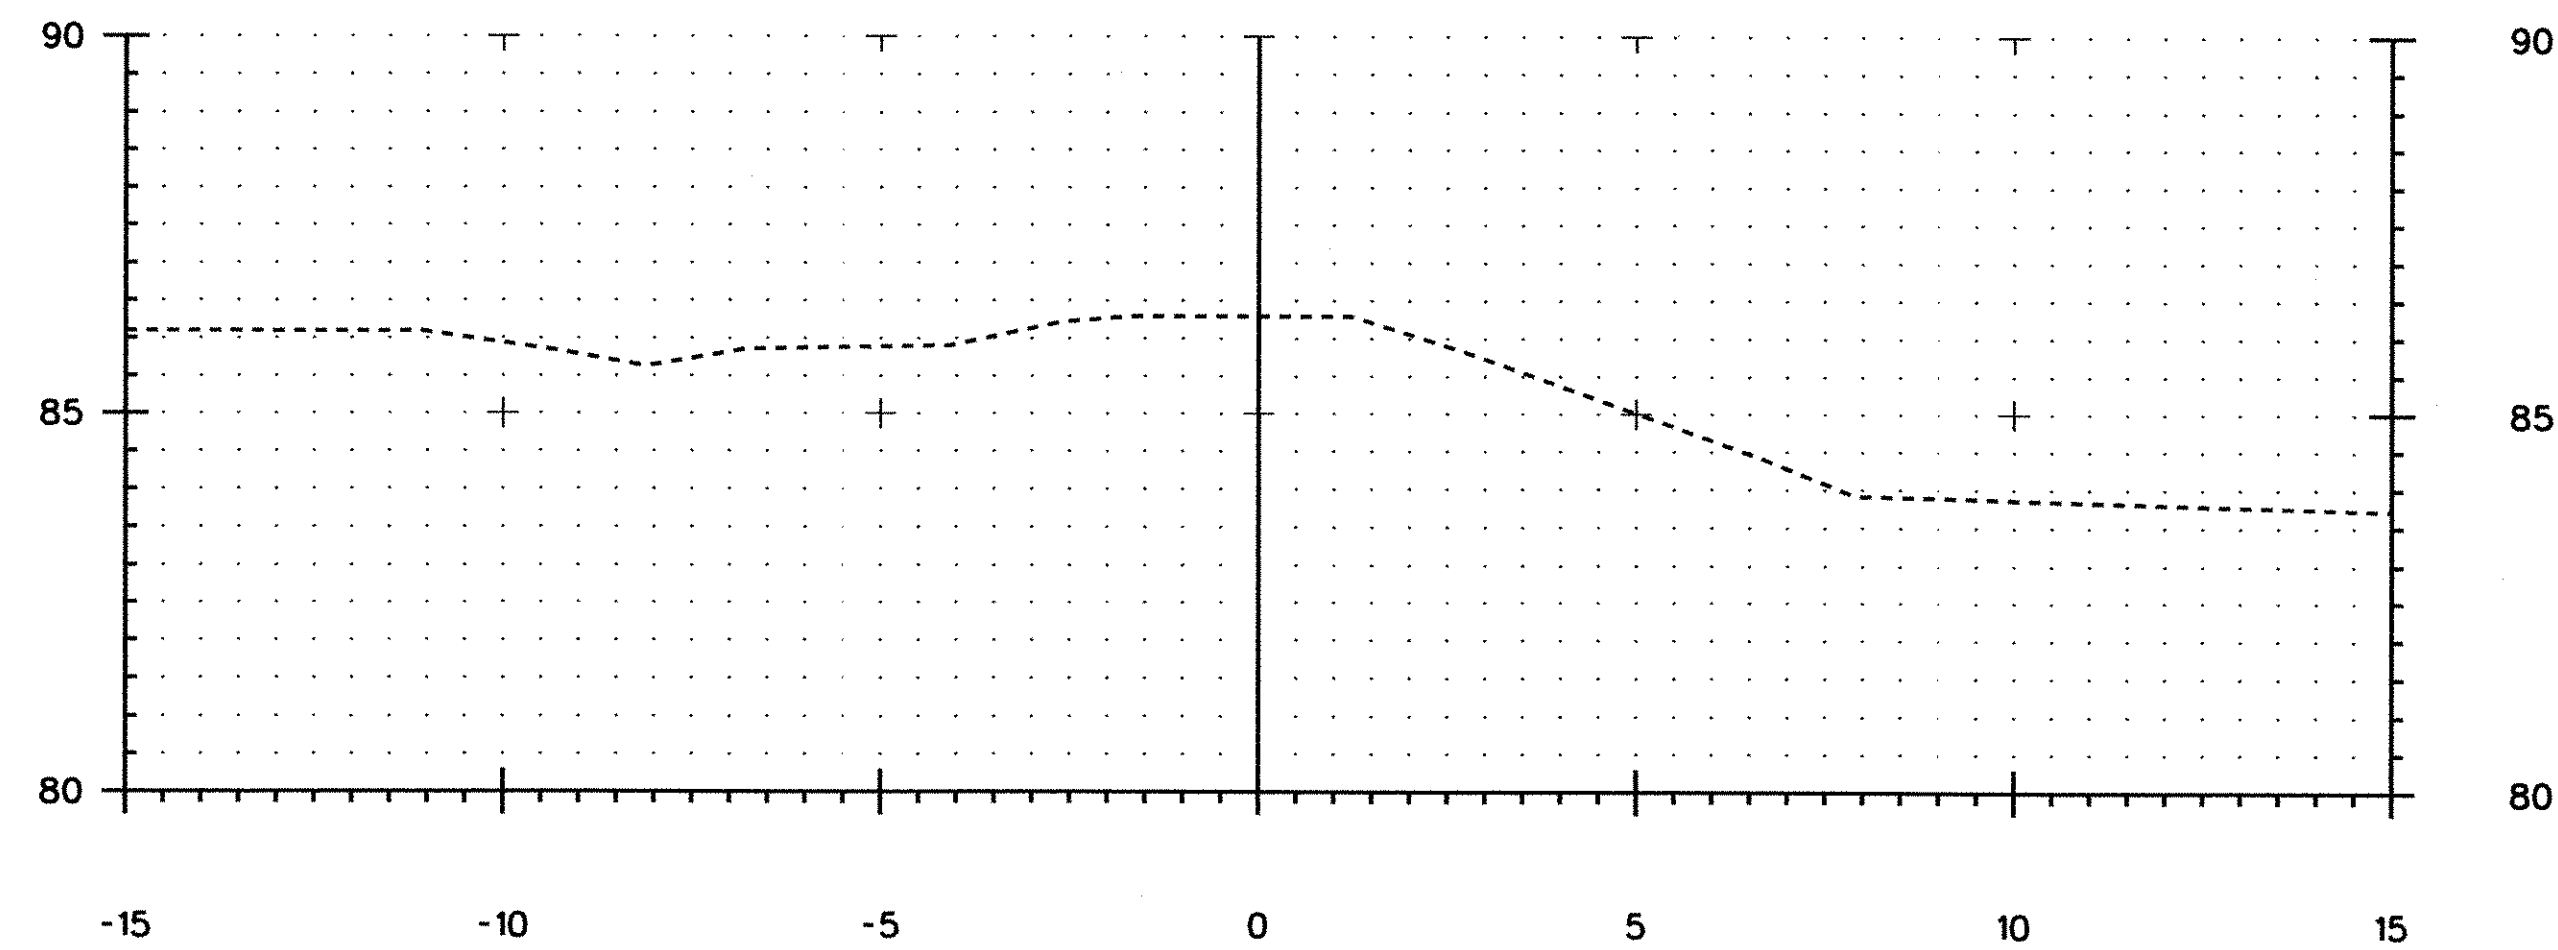

50+000.000

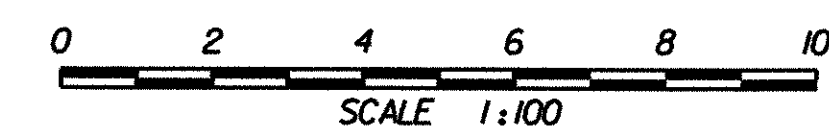

PROJECT:	BRATTLEBORO	PROJECT NO.:	NH 010-2(2)
DESIGN FILE NAME:	U:\99123-Brattleboro\dgn\zb270xs1.dgn		
IPARM FILE NAME:	PLOT DATE: 10-02-2002		
FROM STA: 50+000.000 TO STA: 50+020.000 SHEET: 116 OF 145			