



RAILROAD CROSS SECTIONS

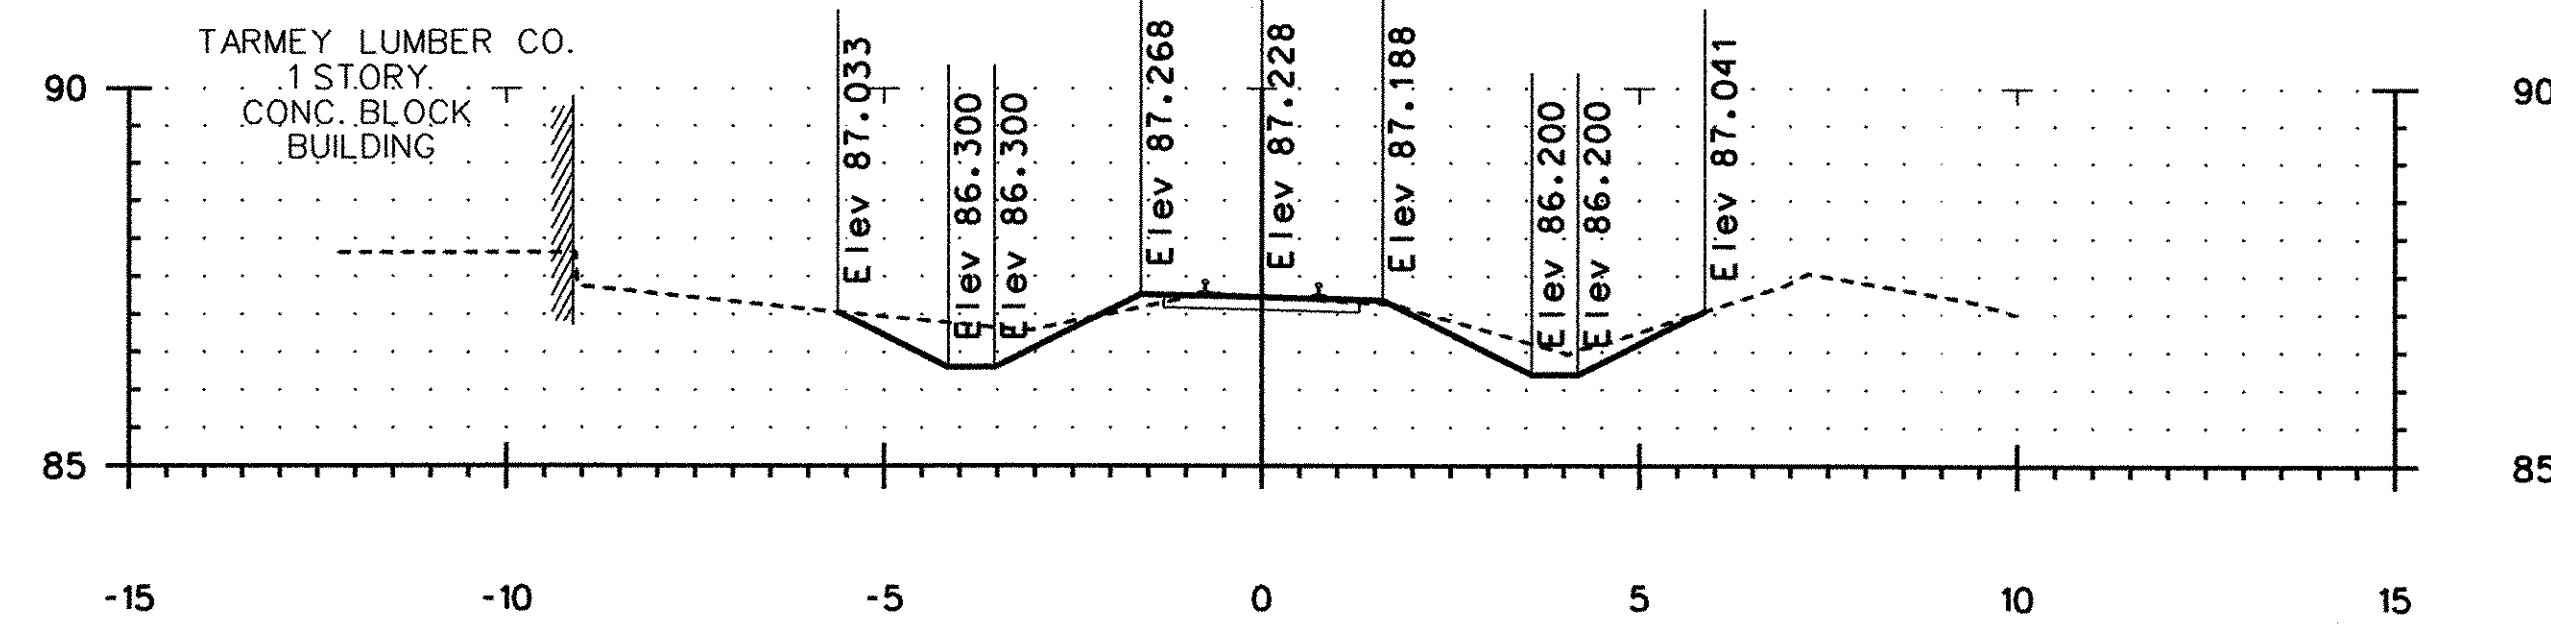


50+140.000

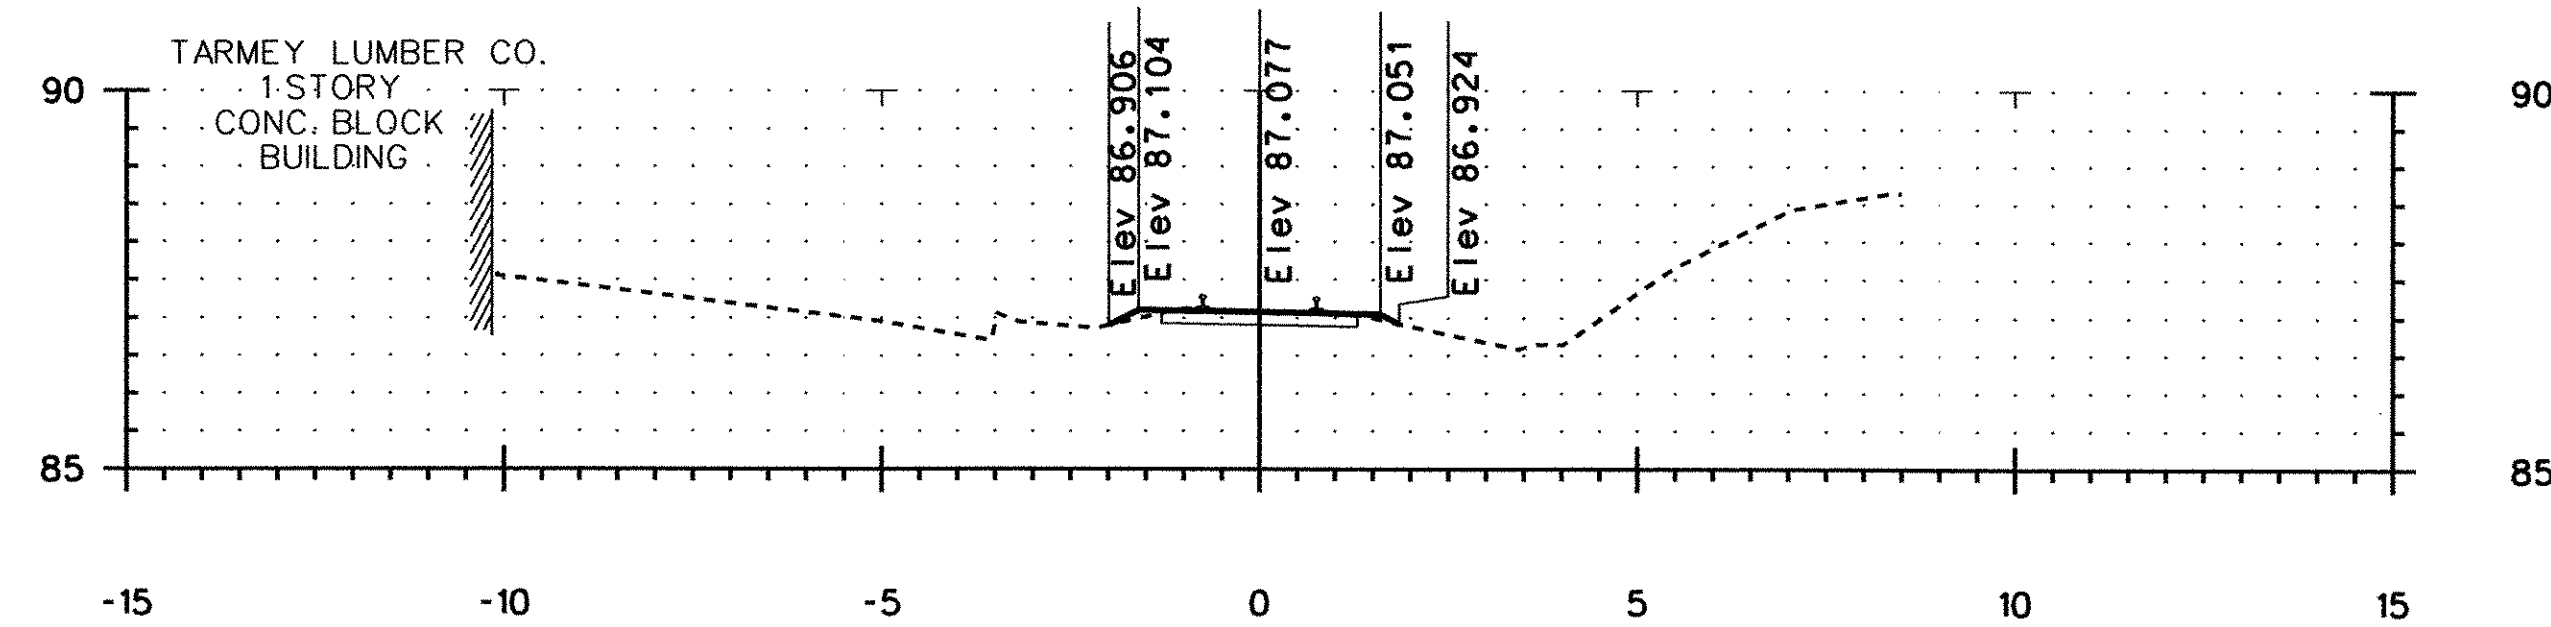

50+120.000

END TRACK REHABILITATION
BEGIN TRANSITION SECTION

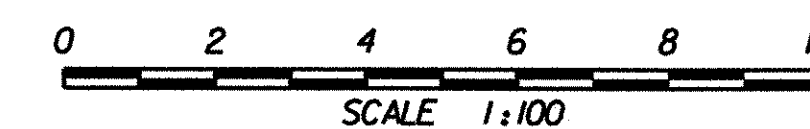

PROJECT:	BRATTLEBORO	PROJECT NO.:	NH 010-2(2)
DESIGN FILE NAME:	U:\99123-Brattleboro\dgn\zb270xs1.dgn		
IPARM FILE NAME:	PLOT DATE: 7 AUG 2000		
FROM STA: 50+120.000 TO STA: 50+140.000 SHEET: 119 OF 145			